

6/17/86
3 PM

8/1/86 - AM TIME

8-1-86
approved

PERMIT

SEWAGE DISPOSAL SYSTEM

MARYLAND STATE DEPARTMENT OF HEALTH

HOWARD COUNTY
BUREAU OF ENVIRONMENTAL HEALTH
99%
461-9933

INDEXED

PERMIT NO. P 36688
A 18125
ELLICOTT CITY
DISTRICT 4th
DATE 3/21/86

The Venture Group of Maryland, Inc.

IS PERMITTED TO INSTALL ALTER

ADDRESS 4801 Sundown Road, Laytonsville, Maryland 20879 PHONE _____

SUBDIVISION Warfield Estates ROAD 14557 MacClintock Dr. LOT 18D

PROPERTY OWNER Russell & Joan LaHayne

ADDRESS _____

IF GARBAGE GRINDER IS USED INCREASE SEPTIC TANK CAPACITY BY 50% AND ABSORPTION AREA BY 22%.

GARBAGE GRINDER? YES _____ NO

SEPTIC TANK CAPACITY 1000 GALLONS NUMBER OF BEDROOMS 3

TRENCHES - 158 sq.-ft. per bedroom. Trench to be 2 feet wide. Inlet 4 feet below original grade. Bottom maximum depth 8 feet below original grade. Effective area begins at 4 feet below original grade. 4 feet of stone below distribution pipe.

LOCATION - Start trench 20 feet from the corner of the 227.82 and 245 feet lot lines and 220 feet from the 314 ft. lot line as shown on the approved drawing. Run trenches on level ground.

NOTE - No trench to exceed 100 feet in length. If more than one trench used, a distribution box is required. Call for inspection of trench(s) before and after gravel is installed. Provide 6" - 8" diameter cleanout and cap to grade or above on septic tank.

MINIMUM 2- 80 FT. TRENCHES INCLUDE GARBAGE DISPOSAL. ON/CAW

PLANS APPROVED BY F. Frommelt

DATE 3/26/86

COVER NO WORK UNTIL INSPECTED AND APPROVED.

NEITHER THE HOWARD COUNTY COUNCIL NOR THE HEALTH DEPARTMENT IS RESPONSIBLE FOR THE SUCCESSFUL OPERATION OF ANY SYSTEM.

NOTE: IF TRENCH IS USED CALL FOR INSPECTION BEFORE AND AFTER PLACING GRAVEL IN TRENCH.

NOTE: NO DRY WELL SHALL EXCEED 15 FOOT IN DIAMETER. NO ABSORPTION TRENCH TO EXCEED 100 FEET IN LENGTH.

NOTE: ALL PIPE FROM HOUSE TO SEPTIC TANK MUST BE CAST IRON OR SCHEDULE 40 PVC OR ABS.

PERMIT VOID AFTER THREE YEARS.

NOTE: INSTALL STAND PIPE ON SEPTIC TANK AND DRY WELL. STAND PIPES MUST BE 6 INCHES IN DIAMETER. CAST IRON, CONCRETE OR TERRA COTTA OR PVC OR ABS ACCEPTED. IF TOP OF SEPTIC TANK IS DEEPER THAN 3 FEET MANHOLE TO GRADE REQUIRED.

***INSTALLER IS RESPONSIBLE FOR OBTAINING FINAL APPROVAL ON THIS PERMIT**


CALL 992-2430 FOR INSPECTION OF SEPTIC SYSTEMS.

EH - 2-1082

INVERTED

DATE SYSTEM APPROVED

A 18125

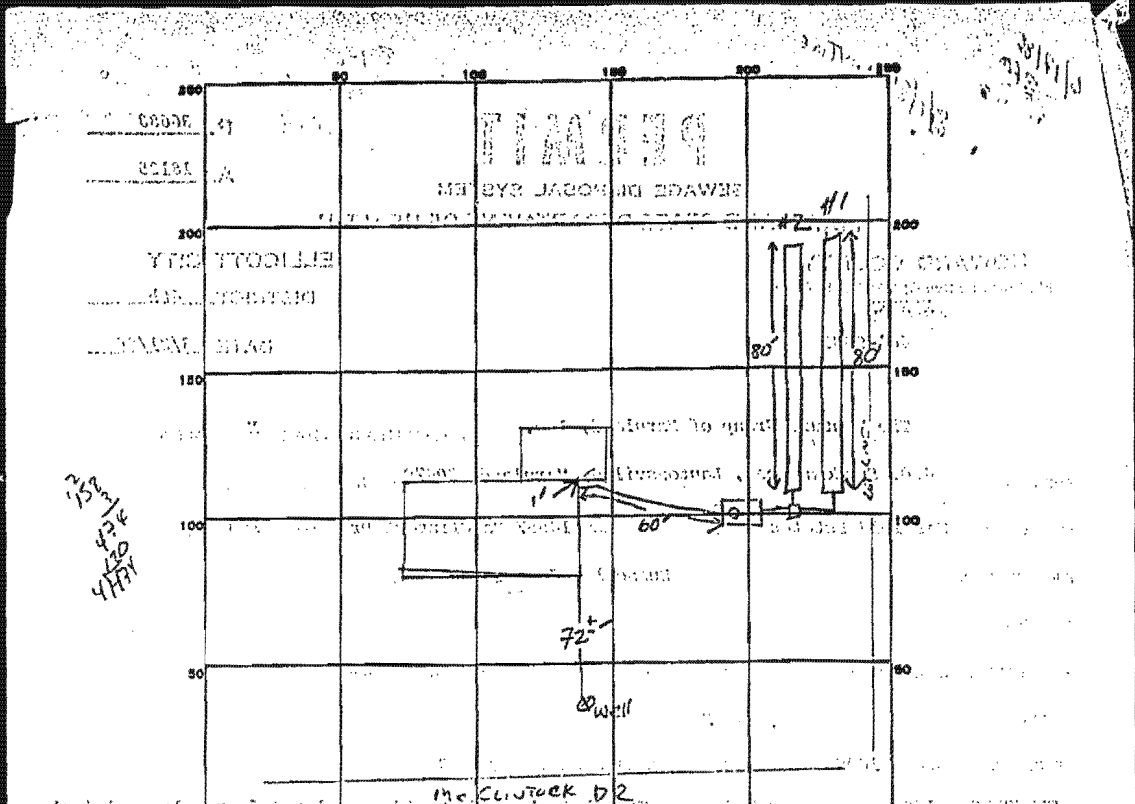

INDICATE NORTH - NAME ADJOINING ROADWAY AS BASE LINE.

PERMIT CARD. 1000 GPM CLEANOUTS

DISTRIBUTION BOX, LEVEL TRENCH WIDTH 2 FT.

TILE FIELD, DEPTH 8 FT. TRENCH WIDTH 2 FT. TOTAL LENGTH 80 80

GRAVEL DEPTH 4' 4' TOTAL LENGTH 80 80

NUMBER OF TRENCHES 2 TOTAL BOTTOM AREA 640

SEEPAGE PITS, INSIDE DIAMETER FT. DEPTH BELOW INLET FT.

ABSORBENT AREA 1640 SQ. FT.

REMARKS 6/17/86 OK TO ADD STONE TO 1ST TRENCH. CW. 6/18/86 OK TO ROCK #1 TRENCH SA.

6/19/86 MOD ST C/O BEFORE FINAL - 8-1-86 O/O TO GRADU. SA

DATE SYSTEM APPROVED 8-1-84 INSPECTOR S. Abel