

Preliminary

# APPLICATION

A 24331

4-13 ft. holes on  
10,000 sq. ft.

P \_\_\_\_\_

## SEWAGE DISPOSAL TESTING

STATE OF MARYLAND - DEPARTMENT OF HEALTH AND MENTAL HYGIENE

HOWARD COUNTY HEALTH DEPARTMENT  
ENVIRONMENTAL HEALTH SERVICES

DISTRICT 5th

P. O. BOX 476, ELLICOTT CITY, MARYLAND 21043  
TELEPHONE: 465-5000, EXT. 356

DATE 9/23/76

TO: THE COUNTY HEALTH OFFICER  
ELLICOTT CITY, MARYLAND

I, HEREBY, APPLY FOR THE NECESSARY TEST IN ORDER TO CONSTRUCT (OR RECONSTRUCT) A SEWAGE DISPOSAL SYSTEM.

PROPERTY OWNER V. L. Vinella

ADDRESS 12631 Circle Drive, Glen Hills, Rockville, Md. PHONE (8) 762-3007

PROPERTY LOCATION: Green Hill Manor Lot 17 on Final 1st E Sect. 4

SUBDIVISION Green Hill Manor LOT NO. 16E

ROAD AND DESCRIPTION Village est Drive sect 4

SIZE OF LOT 44,200 TYPE BLDG. 3 of 4  
NUMBER OF BEDROOMS

IF NOT SINGLE RESIDENCE DESCRIBE \_\_\_\_\_

THE SYSTEM INSTALLED UNDER THIS APPLICATION IS ACCEPTABLE ONLY UNTIL PUBLIC FACILITIES BECOME AVAILABLE.

SIGNATURE OF APPLICANT /s/ V. L. Vinella


APPROVED BY \_\_\_\_\_ FOR \_\_\_\_\_ DATE \_\_\_\_\_  
(KIND OF SYSTEM)

REJECTED BY \_\_\_\_\_ FOR \_\_\_\_\_ DATE \_\_\_\_\_  
(KIND OF SYSTEM)

HOLD PENDING FURTHER TESTS \_\_\_\_\_ DATE \_\_\_\_\_

REASONS FOR REJECTION OR HOLDING \_\_\_\_\_

# THIS IS NOT A PERMIT

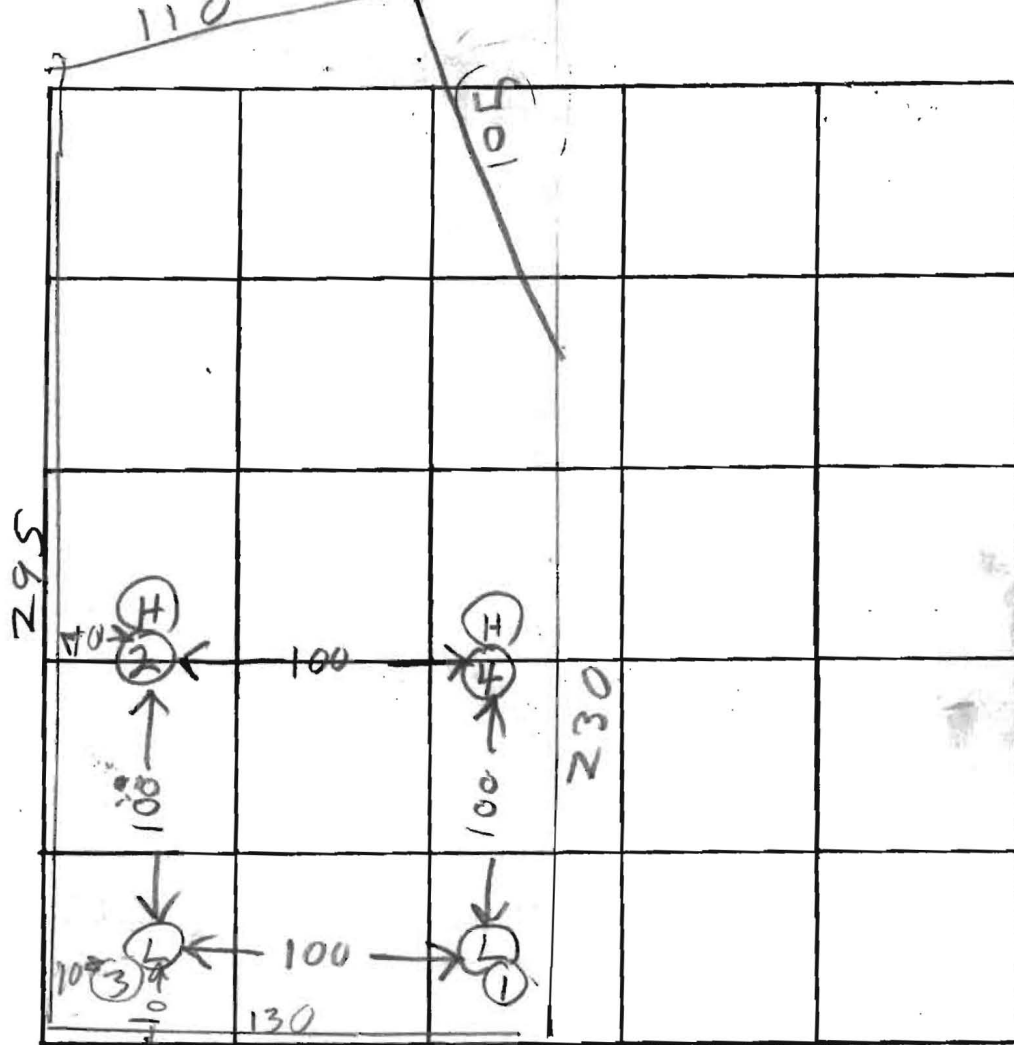

INDICATE NORTH. - NAME ADJOINING ROADWAY AS BASE LINE.

LUSTER DR

DATE	TEST NO.	DEPTH	PRE-WET		TEST - 1" DROP		TIME
			START	STOP	START	STOP	
6/21/76	1S	4 1/2	1059	1101	1101	1103	2
	1D	12 1/2	1059	1102	1102	1024	4
	2S	6 1/2	1102	1114	1114	1128	14
	2D	12	1105	1120	1110	1114	4
	3S	4 1/2	1108	1114	1114	1117	3
	3D	12 1/2	1108	1115	1115	1125	10
6/22/76	4V	12 1/2	TOP 4 FT CLAY		BOT 8 1/2 FT SAND DRY		

USE FOR 17W

REMARKS \_\_\_\_\_

TYPE OF SOIL \_\_\_\_\_

TESTED BY BIT \_\_\_\_\_

ALSO PRESENT:

IG E  
 named to your reference sheet 48

5 168