




**LEGEND**

- EXISTING 2' CONTOURS
- EXISTING 10' CONTOURS
- EXISTING TREE LINE
- SOIL LINES AND TYPES
- DENOTES PROPOSED WELL
- DENOTES FAILED PERC
- DENOTES PASSED PERC
- DENOTES AREA TO BE REMOVED

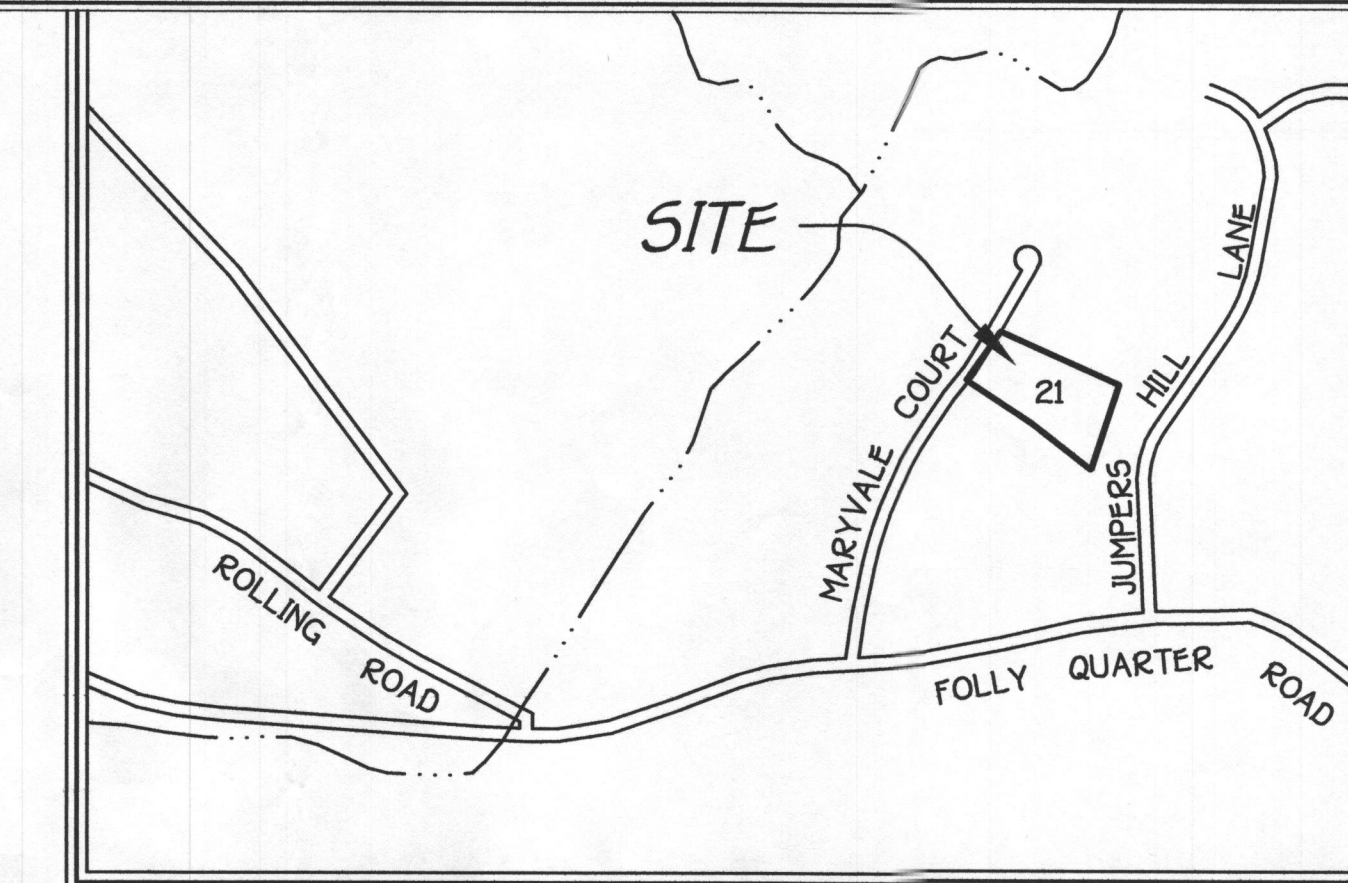

**VICINITY MAP**  
SCALE: 1" = 1200'

SOILS LEGEND		
SOIL	NAME	CLASS
GbA	Gladstone loam, 0 to 3 percent slopes	B
GbB	Gladstone loam, 3 to 8 percent slopes	B
GmC	Glenville silt loam, 8 to 15 percent slopes	C

- NOTES:**
- \* Hydric soils and/or contains hydric inclusions
  - \*\* May contain hydric inclusions
  - † Generally only within 100-year floodplain areas

LOT 3  
FOYDEN FARMS  
BLOCK "A"  
PLAT BOOK 10, FOLIO 60

**GENERAL NOTES:**

1. THIS AREA DESIGNATES A PRIVATE SEWERAGE EASEMENT OF AT LEAST 10,000 SQUARE FEET AS REQUIRED BY THE MARYLAND STATE DEPARTMENT OF THE ENVIRONMENT FOR INDIVIDUAL SEWERAGE DISPOSAL IMPROVEMENTS OF ANY NATURE IN THIS AREA ARE RESTRICTED UNTIL PUBLIC SEWERAGE IS AVAILABLE. THESE EASEMENTS SHALL BECOME NULL AND VOID UPON CONNECTION TO A PUBLIC SEWERAGE SYSTEM. THE COUNTY HEALTH OFFICER SHALL HAVE THE AUTHORITY TO GRANT ADJUSTMENTS TO THE PRIVATE SEWERAGE EASEMENT. RECORDATION OF A MODIFIED SEWERAGE EASEMENT SHALL NOT BE NECESSARY.
2. ADJUSTMENTS TO SEPTIC EASEMENT AREA IS NOT PERMITTED WITHOUT ADDITIONAL TESTING.
3. THE LOT SHOWN HEREON COMPLIES WITH THE MINIMUM OWNERSHIP WIDTH AND LOT AREA AS REQUIRED BY THE MARYLAND STATE DEPARTMENT OF THE ENVIRONMENT.
4. EXISTING WELLS AND/OR SEWERAGE EASEMENTS WITHIN 100 FEET OF THE PROPERTY HAVE BEEN SHOWN FROM ALL REASONABLE EFFORTS.
5. ALL HOUSE SITES SHOWN COMPLY WITH MINIMUM BUILDING RESTRICTION REGULATIONS.
7. TOPOGRAPHY SHOWN IS FIELD RUN BY FISHER, COLLINS AND CARTER, INC. ON OR ABOUT MAY, 2010.
8. BOUNDARY OUTLINE BASED ON A FIELD SURVEY BY FISHER, COLLINS AND CARTER, INC. ON OR ABOUT AUGUST 13, 1998.
9. ANY CHANGES TO A PRIVATE SEWERAGE EASEMENT SHALL REQUIRE A REVISED PERC CERTIFICATION PLAN.
10. PLAT REFERENCE: 14416.
11. SUBJECT PROPERTY ZONED R.
12. TOTAL AREA OF PROPERTY 5,137 AC.
13. STORMWATER MANAGEMENT IS PROVIDED BY NON-ROOFTOP DISCONNECT.
14. NO WETLANDS CURRENTLY EXIST ON THE PROPERTY.
15. TOTAL AREA OF DISTURBANCE IS 7,319 SQ.FT.


THE PURPOSE OF THIS PLAN IS TO ADJUST THE RECORDED PRIVATE SEWERAGE EASEMENT SHOWN ON LOT 21, PLAT ENTITLED "SECOND DISCOVERY", PLAT NO. 14416

**PERC RECERTIFICATION PLAN & PLOT PLAN TO ACCOMPANY BUILDING PERMIT FOR POOL HOUSE SECOND DISCOVERY LOT 21**

**OWNER**

EUGENE AND ELIZABETH MELE  
12736 MARYVALE COURT  
ELLICOTT CITY MD. 21042

TAX MAP #22 ZONED:RR-DEO PARCEL: 45  
3RD ELECTION DISTRICT HOWARD COUNTY, MARYLAND  
SCALE: 1"=30' DATE: MAY 27, 2010

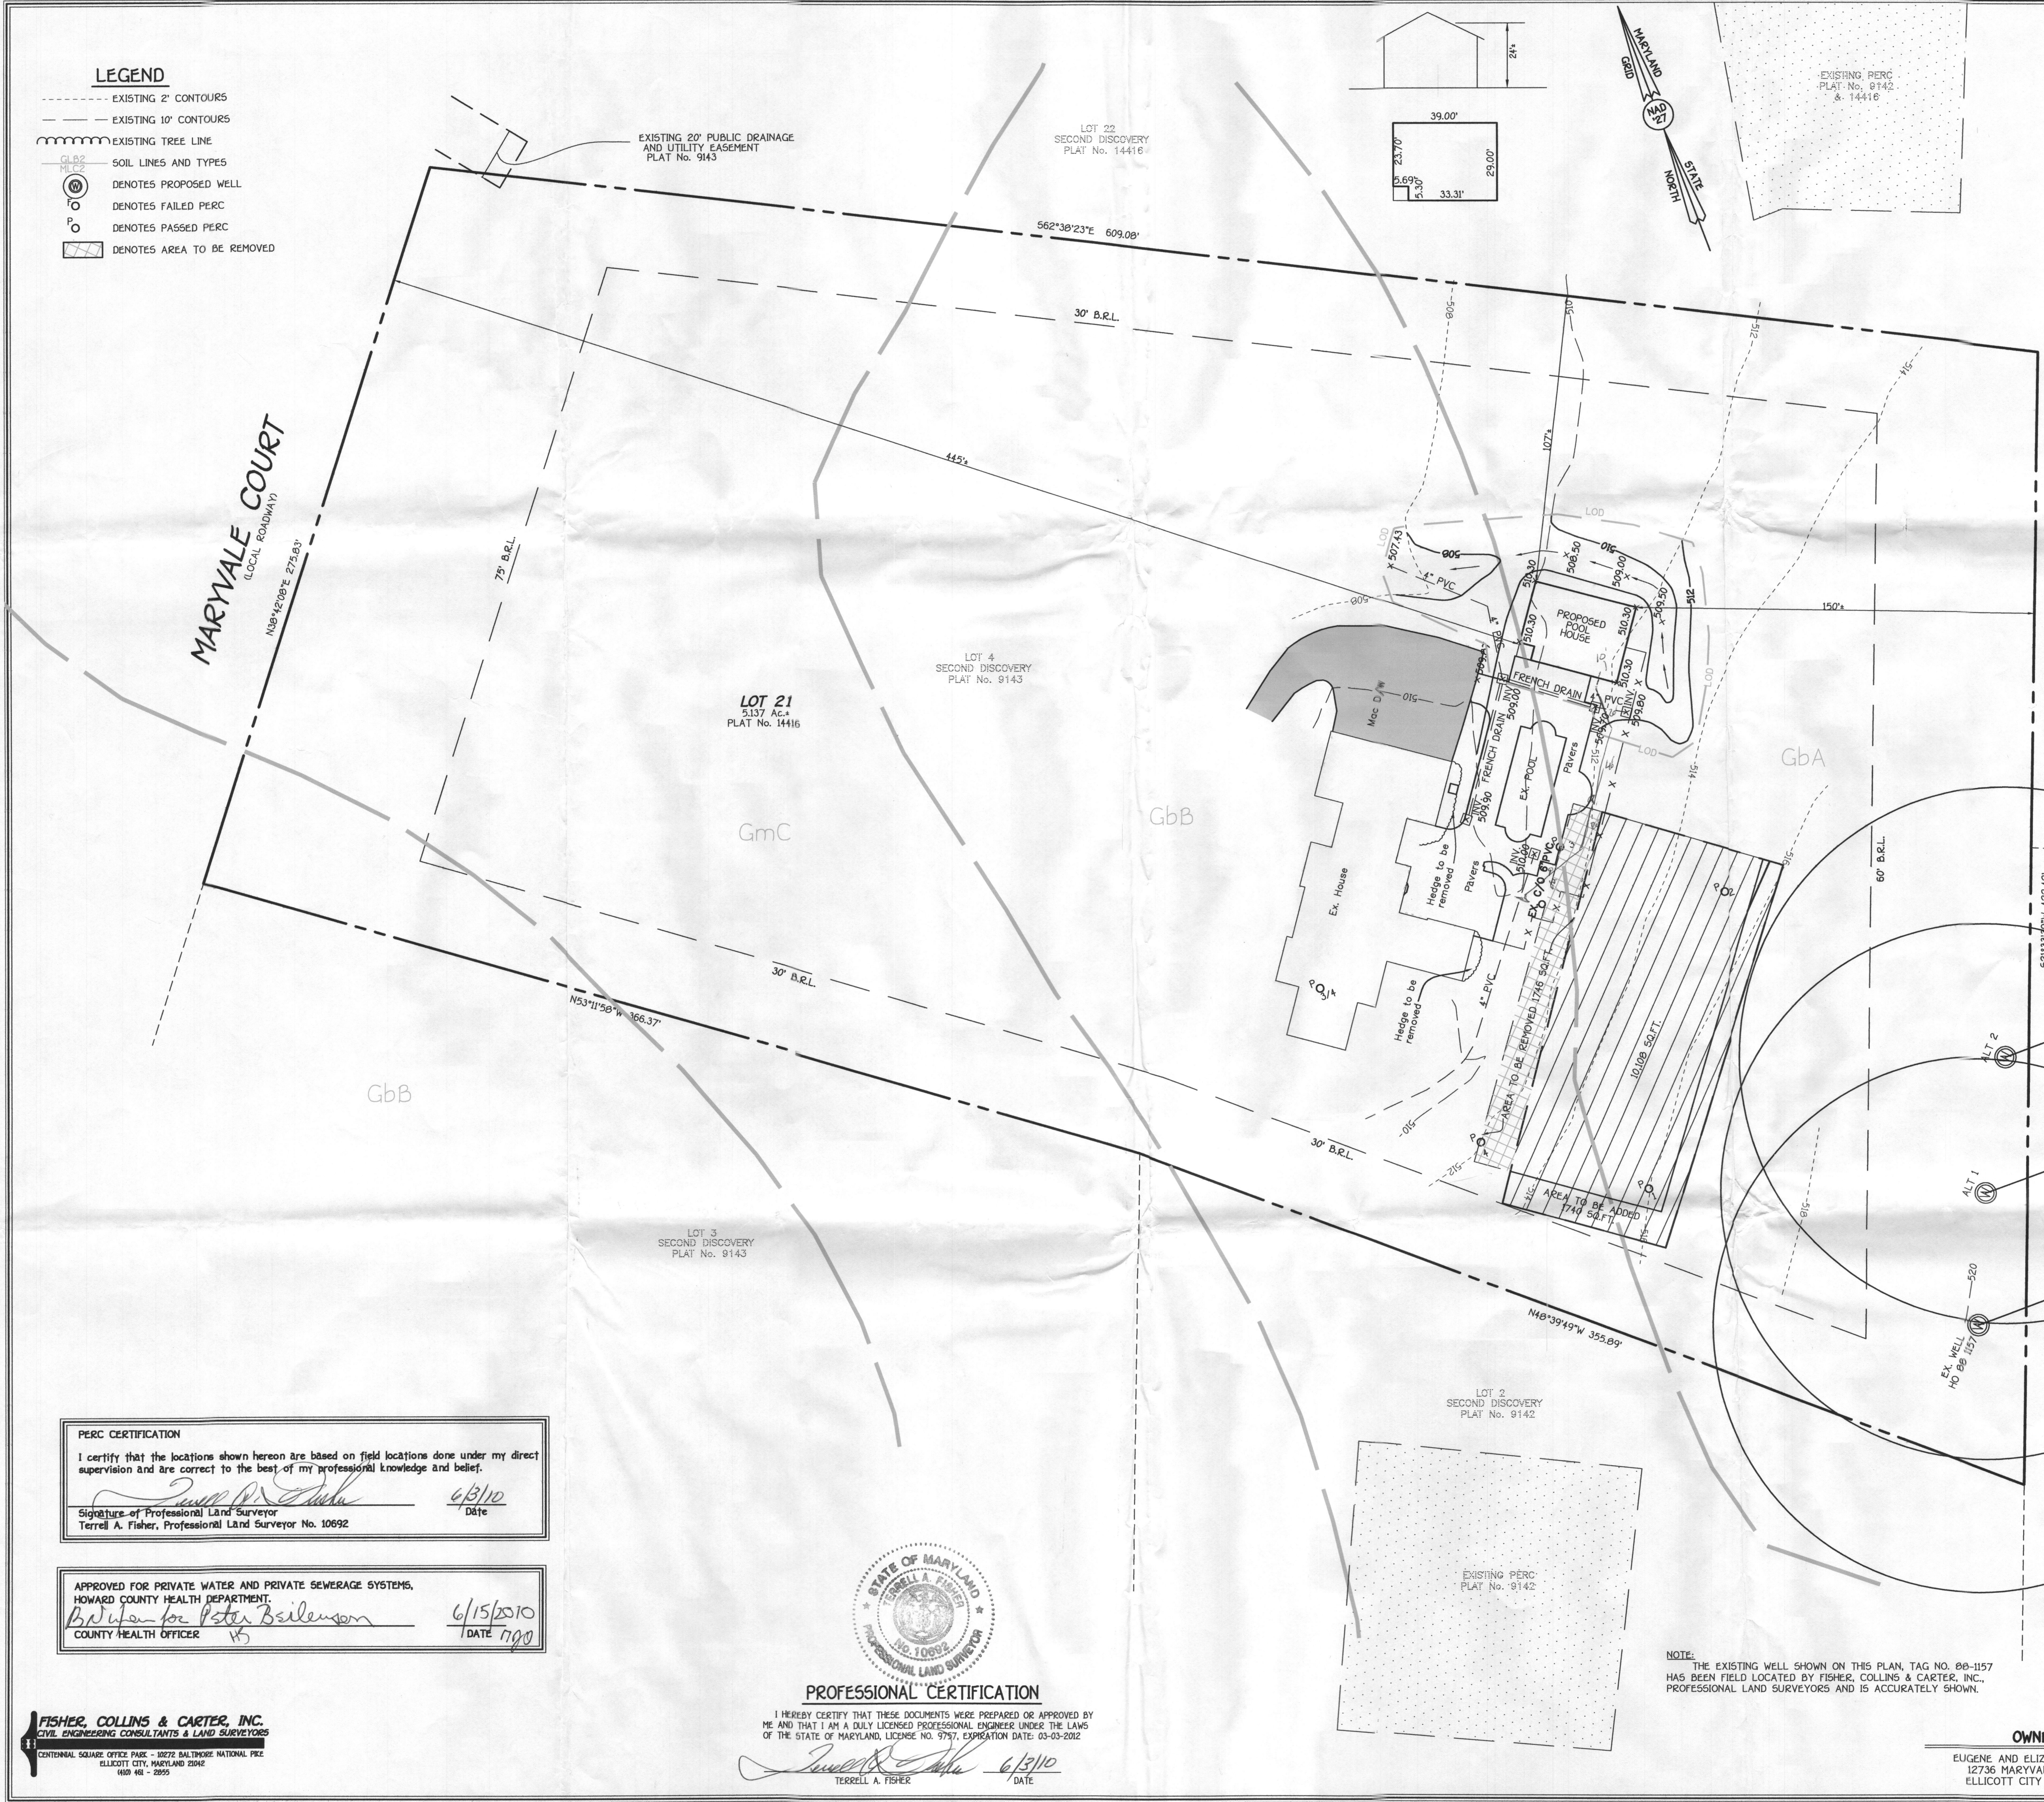

**PERC CERTIFICATION**  
I certify that the locations shown hereon are based on field locations done under my direct supervision and are correct to the best of my professional knowledge and belief.  
*Terrill A. Fisher* 6/13/10  
Signature of Professional Land Surveyor Date  
TERRILL A. FISHER, Professional Land Surveyor No. 10692

APPROVED FOR PRIVATE WATER AND PRIVATE SEWERAGE SYSTEMS,  
HOWARD COUNTY HEALTH DEPARTMENT.  
*Peter Baileenson* 6/15/2010  
COUNTY HEALTH OFFICER DATE




**PROFESSIONAL CERTIFICATION**  
I HEREBY CERTIFY THAT THESE DOCUMENTS WERE PREPARED OR APPROVED BY ME AND THAT I AM A DULY LICENSED PROFESSIONAL ENGINEER UNDER THE LAWS OF THE STATE OF MARYLAND, LICENSE NO. 9797, EXPIRATION DATE: 03-03-2012  
*Terrill A. Fisher* 6/13/10  
TERRILL A. FISHER DATE

**NOTE:**  
THE EXISTING WELL SHOWN ON THIS PLAN, TAG NO. 80-1157 HAS BEEN FIELD LOCATED BY FISHER, COLLINS & CARTER, INC., PROFESSIONAL LAND SURVEYORS AND IS ACCURATELY SHOWN.

**LEGEND**

- EXISTING 2' CONTOURS
- EXISTING 10' CONTOURS
- EXISTING TREE LINE
- SOIL LINES AND TYPES
- DENOTES PROPOSED WELL
- DENOTES FAILED PERC
- DENOTES PASSED PERC
- DENOTES AREA TO BE REMOVED

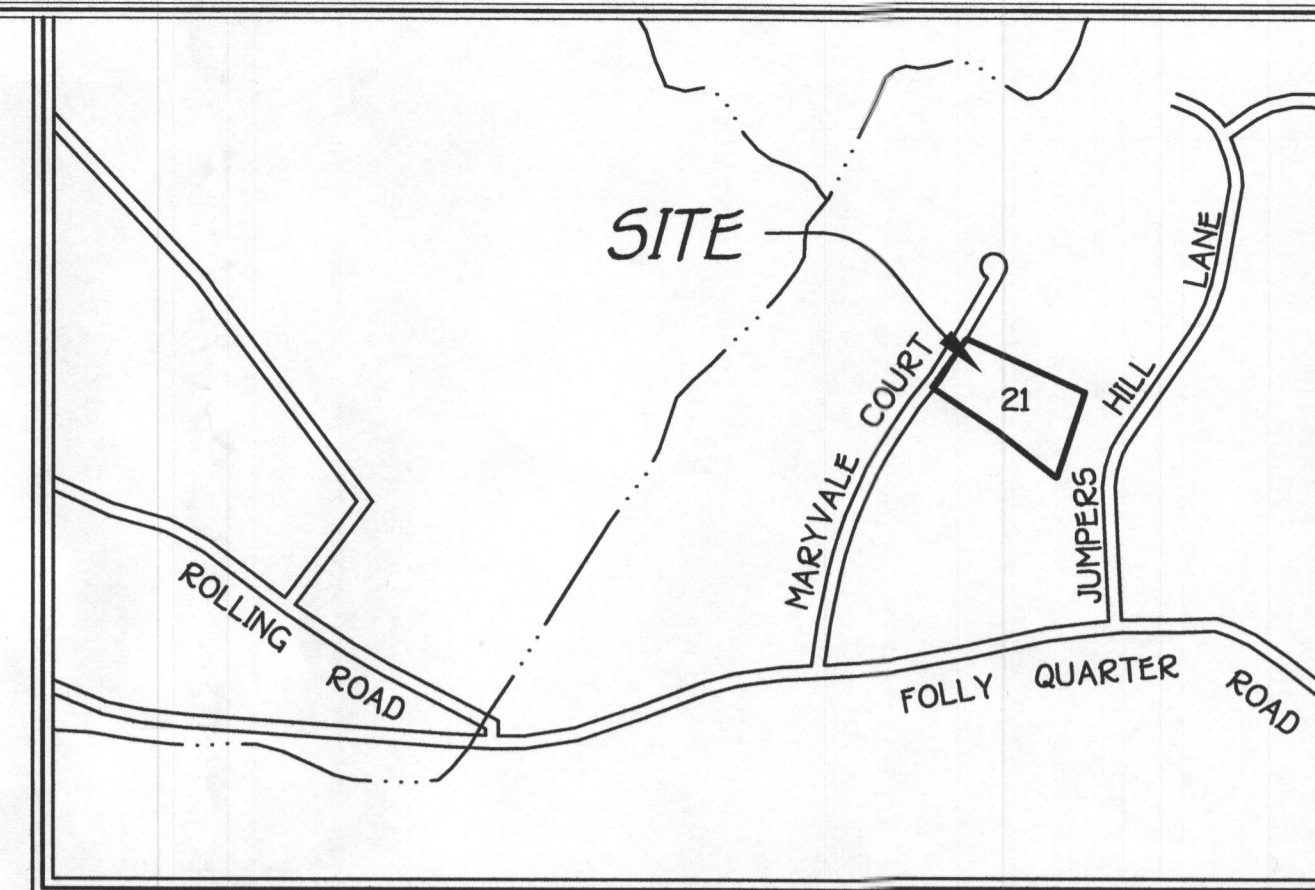

**VICINITY MAP**  
SCALE: 1" = 1200'

SOILS LEGEND		
SOIL	NAME	CLASS
GbA	Gladstone loam, 0 to 3 percent slopes	B
GbB	Gladstone loam, 3 to 8 percent slopes	B
GmC	Glenville silt loam, 8 to 15 percent slopes	C

- NOTES:**
- Hydric soils and/or contains hydric inclusions
  - May contain hydric inclusions
  - † Generally only within 100-year floodplain areas

LOT 3  
FOXDEN FARMS  
BLOCK "A"  
PLAT BOOK 10, FOLIO 60

**GENERAL NOTES:**

1. THIS AREA DESIGNATES A PRIVATE SEWERAGE EASEMENT OF AT LEAST 10,000 SQUARE FEET AS REQUIRED BY THE MARYLAND STATE DEPARTMENT OF THE ENVIRONMENT FOR INDIVIDUAL SEWERAGE DISPOSAL IMPROVEMENTS OF ANY NATURE IN THIS AREA ARE RESTRICTED UNTIL PUBLIC SEWERAGE IS AVAILABLE. THESE EASEMENTS SHALL BECOME NULL AND VOID UPON CONNECTION TO A PUBLIC SEWERAGE SYSTEM. THE COUNTY HEALTH OFFICER SHALL HAVE THE AUTHORITY TO GRANT ADJUSTMENTS TO THE PRIVATE SEWERAGE EASEMENT. RECORDATION OF A MODIFIED SEWERAGE EASEMENT SHALL NOT BE NECESSARY.
2. ADJUSTMENTS TO SEPTIC EASEMENT AREA IS NOT PERMITTED WITHOUT ADDITIONAL TESTING.
3. THE LOT SHOWN HEREON COMPLIES WITH THE MINIMUM OWNERSHIP WIDTH AND LOT AREA AS REQUIRED BY THE MARYLAND STATE DEPARTMENT OF THE ENVIRONMENT.
4. EXISTING WELLS AND/OR SEWERAGE EASEMENTS WITHIN 100 FEET OF THE PROPERTY HAVE BEEN SHOWN FROM ALL REASONABLE EFFORTS.
5. ALL HOUSE SITES SHOWN COMPLY WITH MINIMUM BUILDING RESTRICTION REGULATIONS.
7. TOPOGRAPHY SHOWN IS FIELD RUN BY FISHER, COLLINS AND CARTER, INC. ON OR ABOUT MAY, 2010.
8. BOUNDARY OUTLINE BASED ON A FIELD SURVEY BY FISHER, COLLINS AND CARTER, INC. ON OR ABOUT AUGUST 13, 1998.
9. ANY CHANGES TO A PRIVATE SEWERAGE EASEMENT SHALL REQUIRE A REVISED PERC CERTIFICATION PLAN.
10. PLAT REFERENCE 14416.
11. SUBJECT PROPERTY ZONED R
12. TOTAL AREA OF PROPERTY 5.137 AC.
13. STORMWATER MANAGEMENT IS PROVIDED BY NON-ROOFTOP DISCONNECT.
14. NO WETLANDS CURRENTLY EXIST ON THE PROPERTY.
15. TOTAL AREA OF DISTURBANCE IS 7,319 SQ.FT.

THE PURPOSE OF THIS PLAN IS TO ADJUST THE RECORDED PRIVATE SEWERAGE EASEMENT SHOWN ON LOT 21, PLAT ENTITLED "SECOND DISCOVERY", PLAT NO. 14416.

**PERC RECERTIFICATION PLAN & PLOT PLAN TO ACCOMPANY BUILDING PERMIT FOR POOL HOUSE SECOND DISCOVERY LOT 21**

**OWNER**

EUGENE AND ELIZABETH MELE  
12736 MARYVALE COURT  
ELLICOTT CITY MD. 21042

TAX MAP #22 ZONED RR-DEO PARCEL: 45  
3RD ELECTION DISTRICT HOWARD COUNTY, MARYLAND  
SCALE: 1"=30' DATE: MAY 27, 2010



**PERC CERTIFICATION**  
I certify that the locations shown hereon are based on field locations done under my direct supervision and are correct to the best of my professional knowledge and belief.  
*Terrell A. Fisher* 6/13/10  
Signature of Professional Land Surveyor Date  
Terrell A. Fisher, Professional Land Surveyor No. 10692

APPROVED FOR PRIVATE WATER AND PRIVATE SEWERAGE SYSTEMS,  
HOWARD COUNTY HEALTH DEPARTMENT.  
*Debra J. Peterson* 6/13/2010  
COUNTY HEALTH OFFICER DATE



**PROFESSIONAL CERTIFICATION**  
I HEREBY CERTIFY THAT THESE DOCUMENTS WERE PREPARED OR APPROVED BY ME AND THAT I AM A DULY LICENSED PROFESSIONAL ENGINEER UNDER THE LAWS OF THE STATE OF MARYLAND, LICENSE NO. 9757, EXPIRATION DATE: 03-03-2012.  
*Terrell A. Fisher* 6/13/10  
TERRELL A. FISHER DATE

**NOTE:**  
THE EXISTING WELL SHOWN ON THIS PLAN, TAG NO. 08-1157 HAS BEEN FIELD LOCATED BY FISHER, COLLINS & CARTER, INC., PROFESSIONAL LAND SURVEYORS AND IS ACCURATELY SHOWN.