

Hatfield Equipment & Dedication

P.O. Box 519
Annapolis Junction, MD 20701

Invoice

Date	Invoice #
3/6/2008	33430

Bill To
R.L.O. Contractors Inc. P. O. Box 57 Dayton, Maryland 21036

Prop #	P.O. No.	Terms	Project
		Net 30	

Quantity	Description	Rate	Amount
	3/4/08 7990 Martown Road Pumped septic tank and drywell, crushed and filled both tanks. Hatfields has completed the demollition of the septic system as per Howard County Health Dept. specifications	885.00	885.00
Total			\$885.00

Phone #
301-490-4289/888-490-4289

Fax #
301-490-5794


HATFIELD'S EQUIPMENT AND DEDICATION SVCS., INC.
P.O. BOX 519
ANNAPOLIS JUNCTION, MD 20701
301-490-4289


QTY.		HRS.	TOTAL		
1	FOREMAN	3		DATE	3-4-08
1	SKILLED LABOR	3		COMPANY NAME	STAN MERSON
	LABOR			JOB NAME	SEPTIC Abandonment
	LABOR			WORK ORDERED BY	
1	TRUCK & TOOLS	3		PURCHASE ORDER No.	
	2nd TRUCK & TOOLS			FOREMAN SIGNATURE	KEN HATFIELD JR
		TOTAL	225-		

MATERIALS			EQUIPMENT			
QTY.	ITEM	PRICE	QTY.	ITEM	HRS.	PRICE
			1	BACK + Del.	3	360-
			1	Pump TK 1500 gal.	3	300-
		TOTAL			TOTAL	

LOT, ADDRESS, MH #	DESCRIPTION
7990 MARBETOWN RD	<ul style="list-style-type: none"> Dug-up Septic tank + Drywell Pumped Septic tank 1500 Drywell was Empty Pumped and Crushed and Filled both <p>Hatfields has completed the demolition of Septic System As per Howard County Health Department - Specifications</p>

LOCATION OF SEPTIC SYSTEM

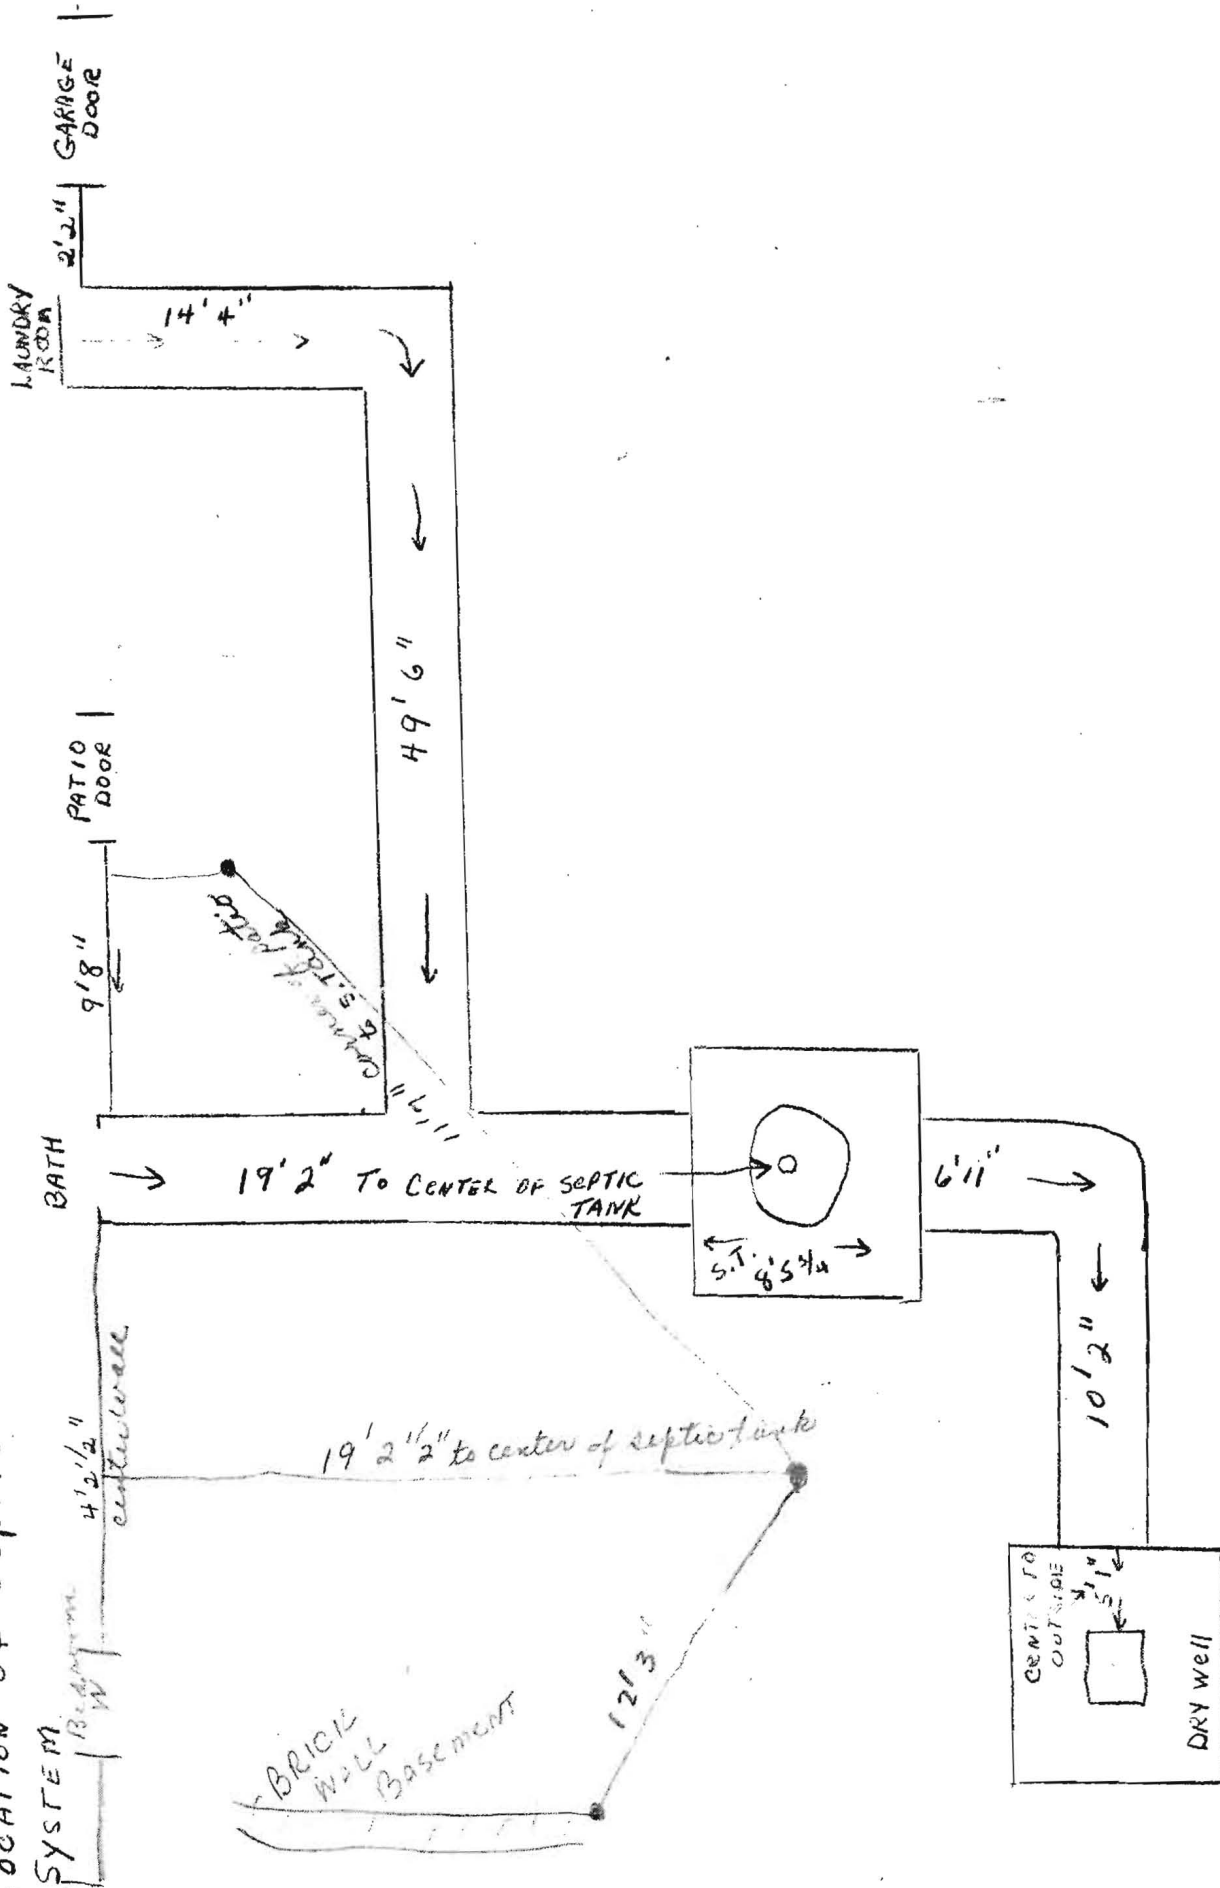

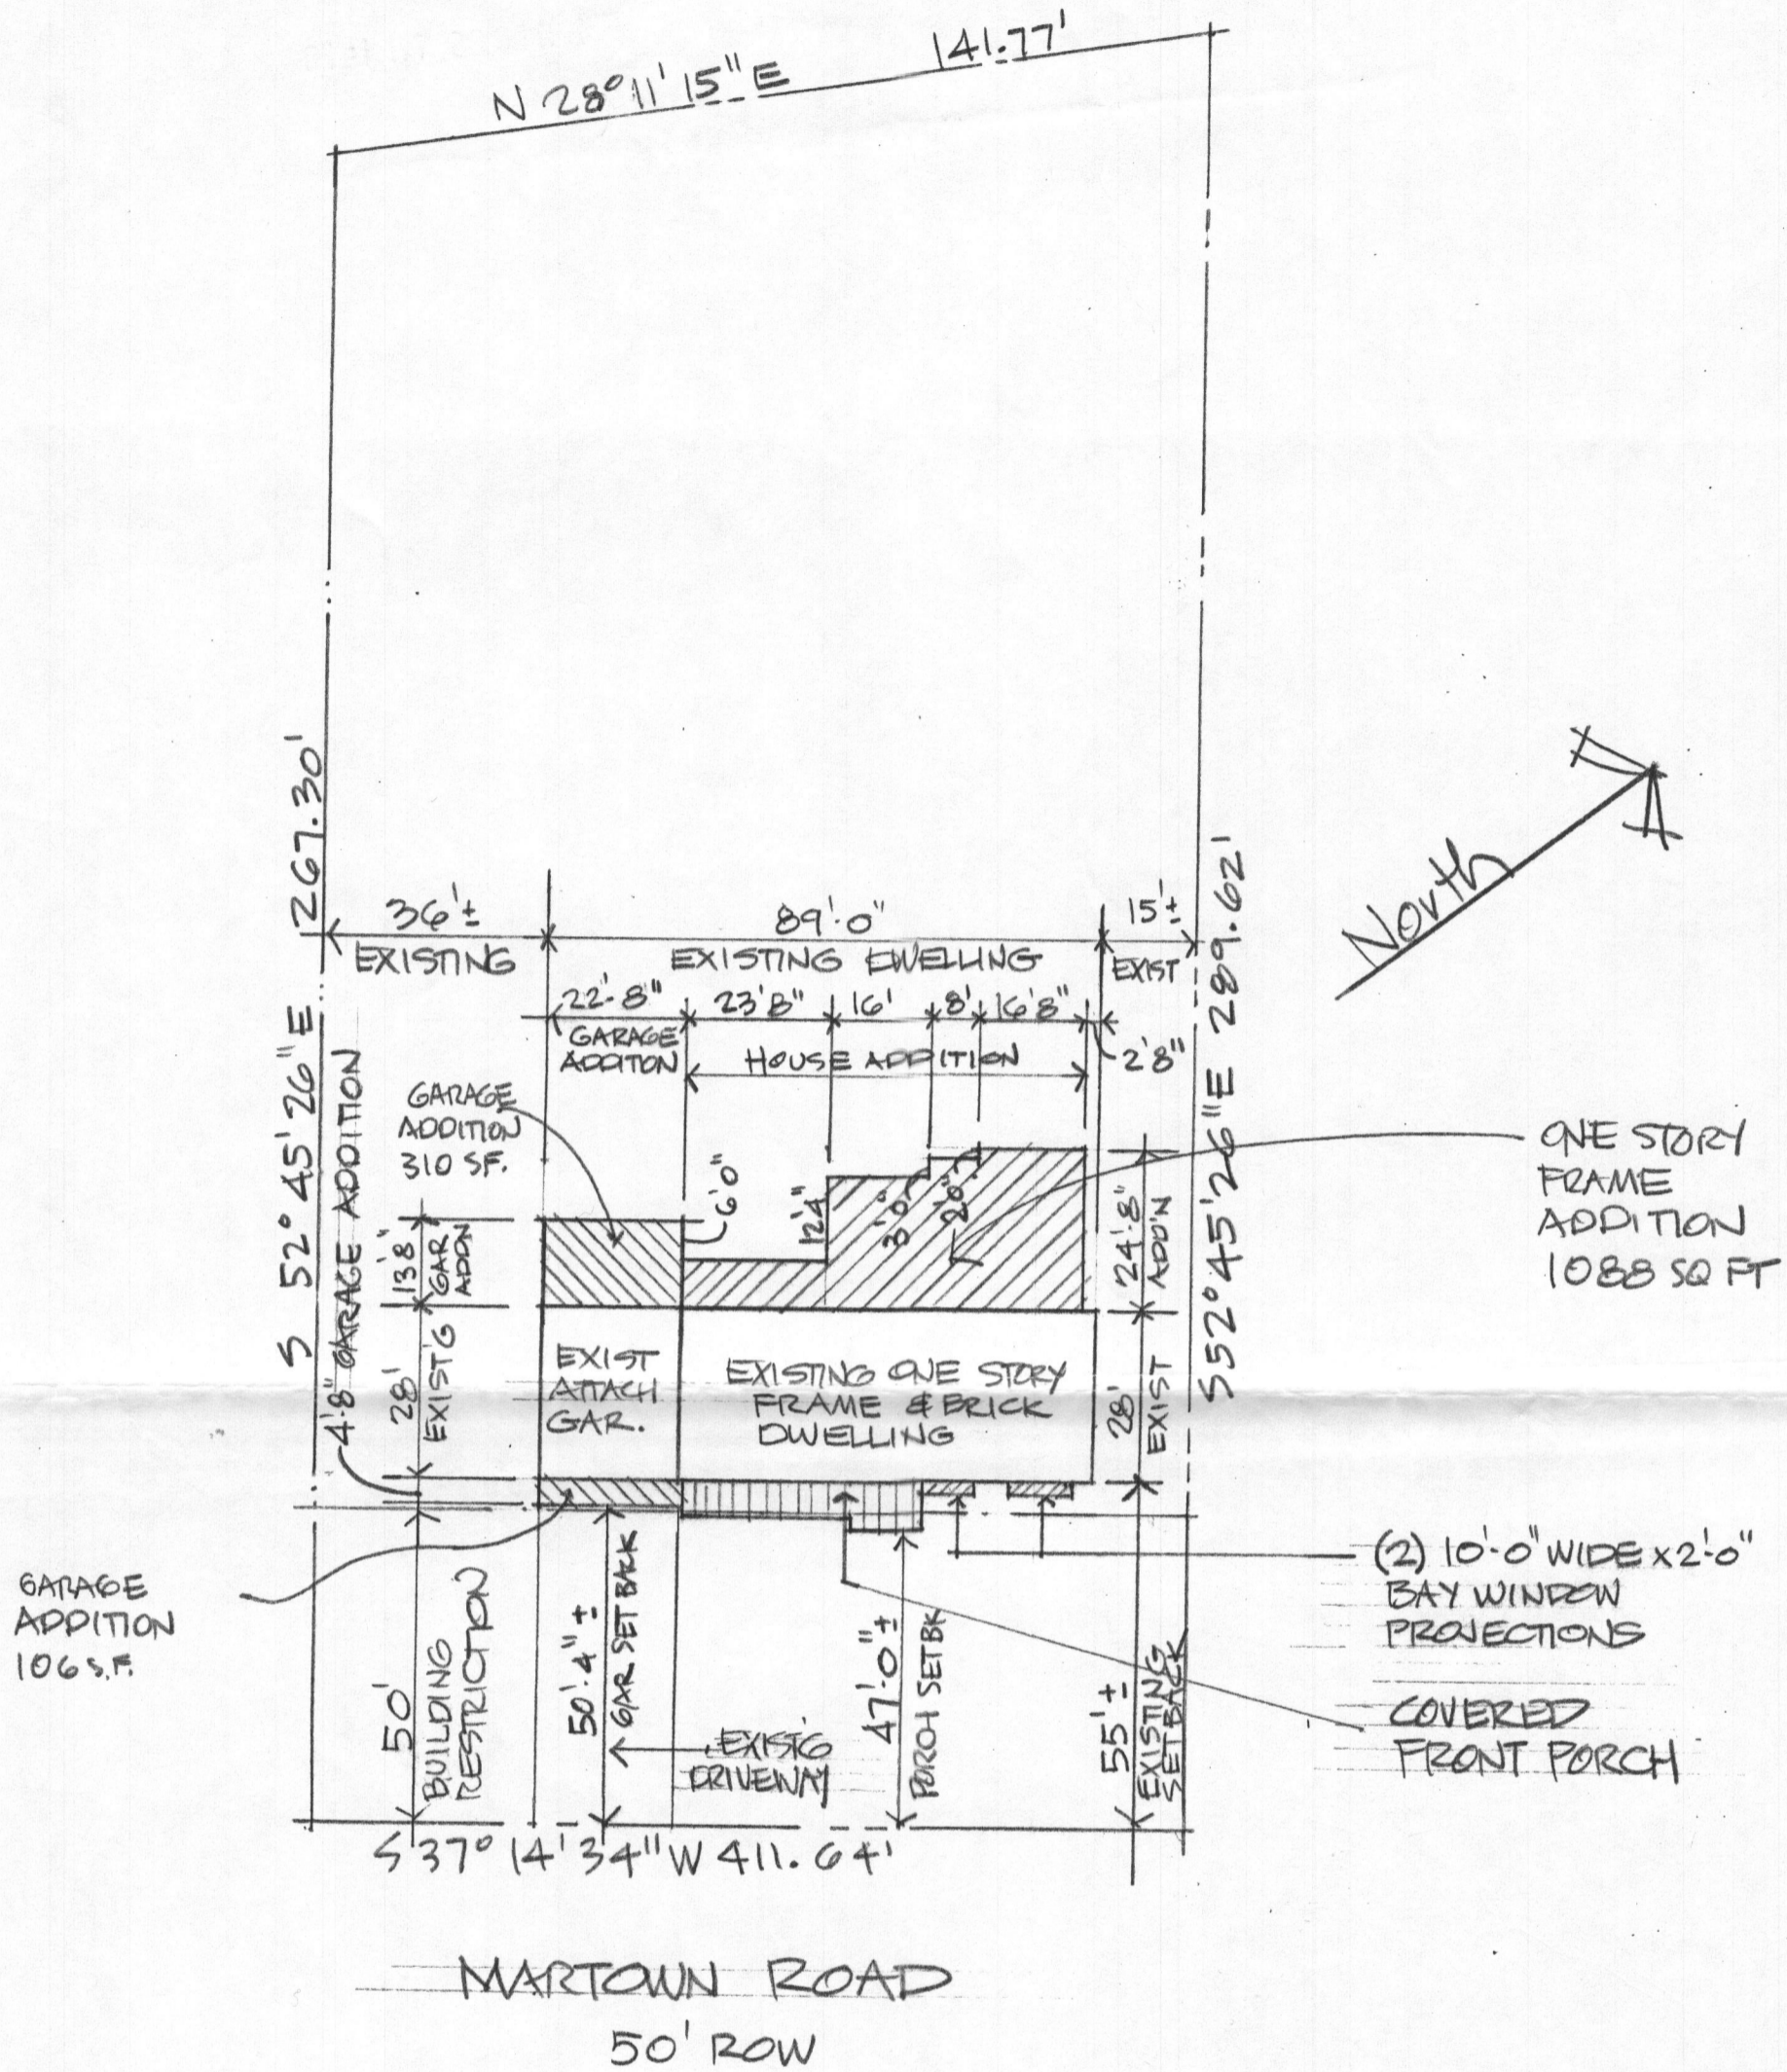

PLOT PLAN scale 1" = 30'-0"

ADDITION TO THE MERSON RESIDENCE
 7990 MARTOWN ROAD
 LAUREL, MD 20723
 LOT 8 WELLINGTON ESTATES SECT 2
 6th ELECTION DISTRICT