

N 25°49'00"E 232.34'

60' B.R.L.
30' B.R.L.

Approved Septic System Plan Howard County Health Department

3.00 AC.

Signature *Mark R. Khan* 3/29/02
Date

width of trench(es) 2 feet
Depth of trench(es) 7 1/2 feet
Depth of stone required below distribution pipe 4 feet


total linear feet of trench required 225 feet

LOT 15
SECOND DISCOVERY
ZONE RR-DEO

FOR THIS WELL, CINDY AT PATRIOT COMMITTED TO WELL PROTECTION

THIS WELL FILLED & SEALED
MR 3/29/02

MEASURES DURING GRADING

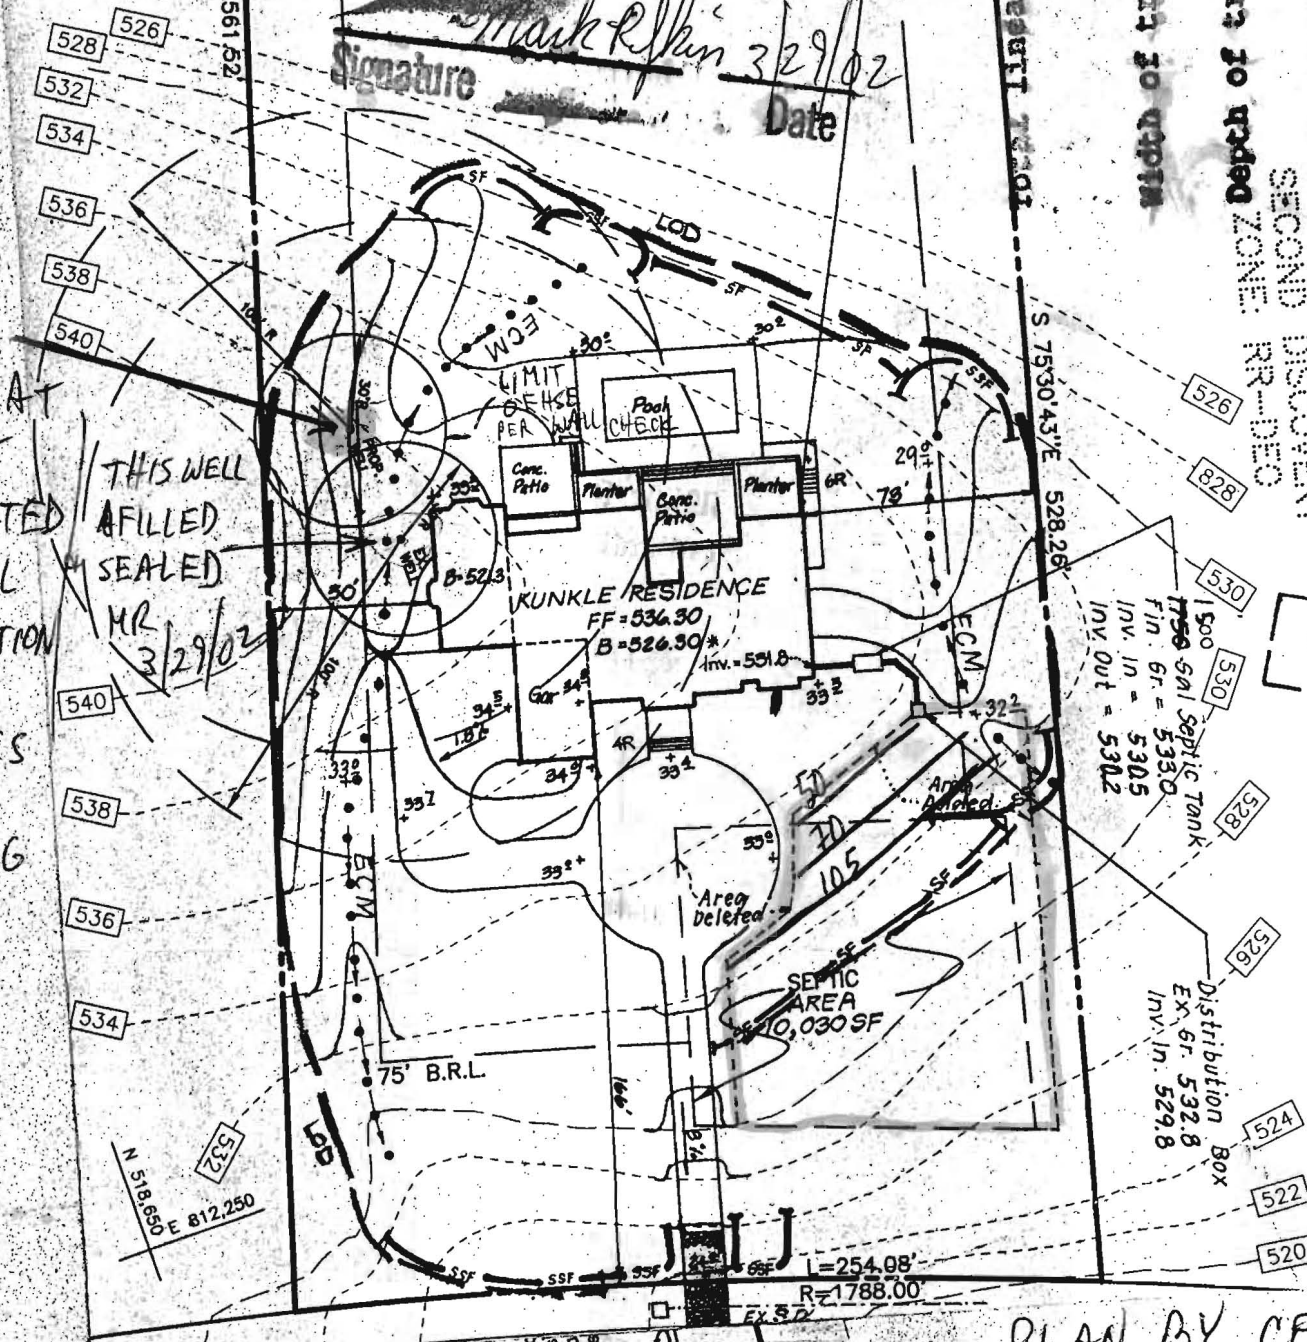

MARYVALE COURT

PLAN BY CFS
1:60

LAYOUT 8/28/02 11:00 INSP 4 _____
 INSP 2 9/6/02 11:00 INSP 5 _____
 INSP 3 _____ INSP 6 _____

ISSUE DATE: 8/15/02
 APPROVAL DATE: 9/6/02

**PERMIT
INDEXED**

P 517419
 A 42206

**ON-SITE SEWAGE DISPOSAL SYSTEM
 HOWARD COUNTY HEALTH DEPARTMENT
 BUREAU OF ENVIRONMENTAL HEALTH**

Van Sant Plumbing & Heating IS PERMITTED TO INSTALL ALTER
 ADDRESS: 3 N. Main Street PHONE NUMBER: 301-829-0444
 SUBDIVISION: Second Discovery LOT NUMBER: 16
 ADDRESS: 12707 Maryvale Court PROPERTY OWNER: Patriot Homes
 SEPTIC TANK CAPACITY (GALLONS): 1500 OUTLET BAFFLE FILTER REQUIRED
 PUMP CHAMBER CAPACITY (GALLONS): N/A COMPARTMENTED TANK REQUIRED
 NUMBER OF BEDROOMS: 5
 SQUARE FEET PER BEDROOM: 210
 LINEAR FEET OF TRENCH REQUIRED: 225 HOUSE SERVED BY PUBLIC WATER

TRENCHES:	Trench to be 2.0 feet wide. Inlet 3.5 feet below original grade. Bottom maximum depth 7.5 feet below original grade. Effective area begins at 3.5 feet below original grade. 4.0 feet of stone below distribution pipe.
LOCATION:	Place the distribution box 180' from the front lot line and 45' off the right lot line. Run trenches on contour to center of lot as shown on plan.
NOTES:	

PLANS APPROVED: MER OK 4/23/02 (SC) DATE: 3/29/02

NOTES: PERMIT VOID AFTER 2 YEARS
 CONTRACTOR IS RESPONSIBLE FOR SCHEDULING A PRE-CONSTRUCTION INSPECTION FOR ALL INSTALLATIONS
 WATERTIGHT SEPTIC TANKS REQUIRED
 ALL PARTS OF SEPTIC SYSTEM SHALL BE 100 FEET FROM ANY WATER WELL UNLESS SPECIFICALLY AUTHORIZED
 MANHOLE RISERS REQUIRED ON ALL SEPTIC TANKS AND PUMP CHAMBERS UNLESS SPECIFICALLY AUTHORIZED
 CONTRACTOR RESPONSIBLE FOR COMPLIANCE WITH APPLICABLE REGULATIONS, GUIDELINES AND THE TERMS OF THIS PERMIT


**NEITHER THE HOWARD COUNTY COUNCIL NOR THE HEALTH DEPARTMENT IS
 RESPONSIBLE FOR THE SUCCESSFUL OPERATION OF ANY SYSTEM
 PERMITTEE RESPONSIBLE FOR OBTAINING FINAL APPROVAL ON THIS PERMIT**

**BUILDING PERMIT SIGNED
 AND RETURNED**

3-12-03/ B00140651 - JG POOL
 6-2-03/ B00141597 - RETAINING WALLS
 4/7/04/ B00146963 - Rebuild after burn down

A42206

NOT TO SCALE

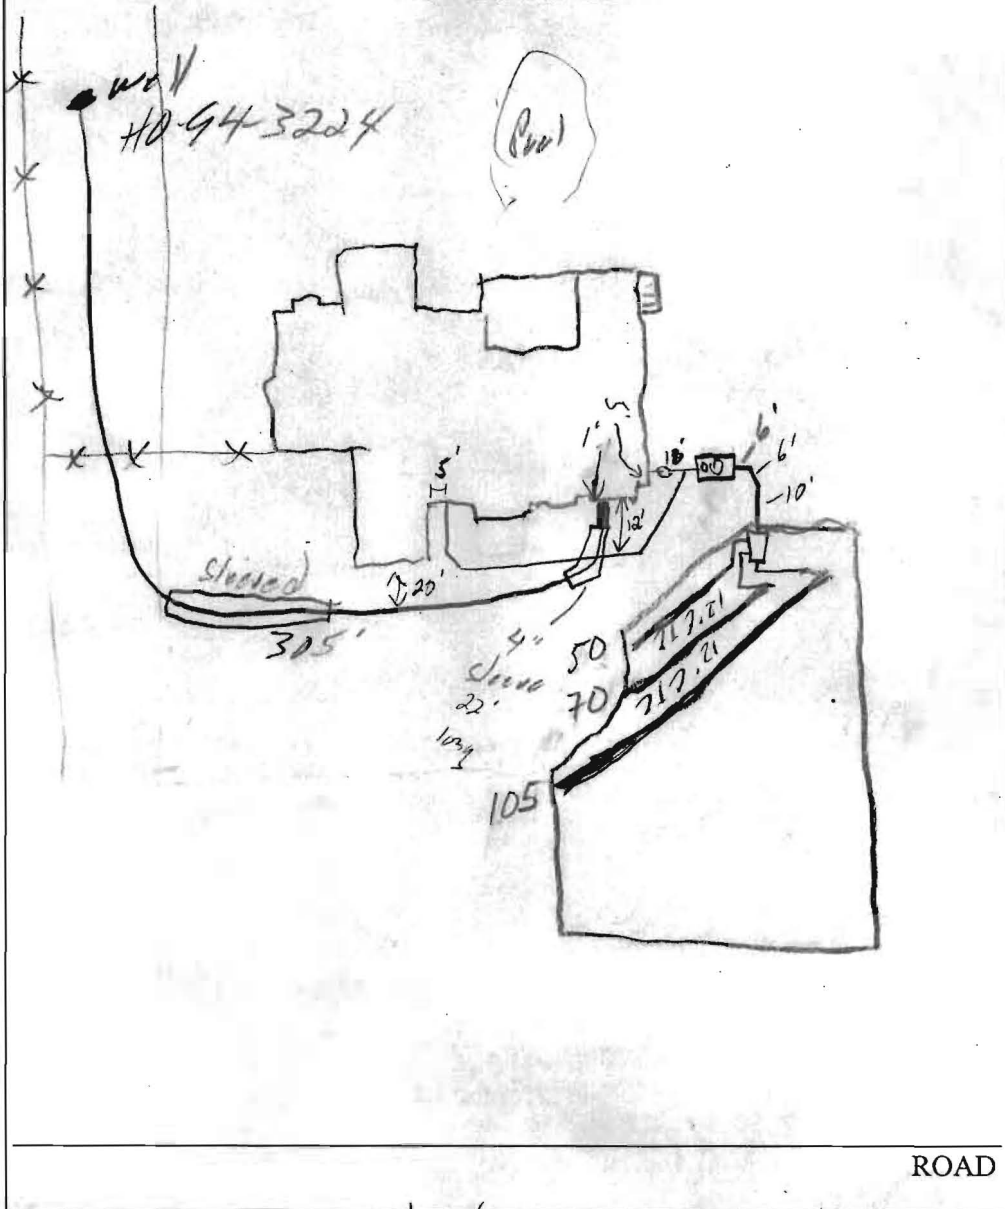

TRENCH/DRAINFIELD DATA		
WIDTH	INLET	BOTTOM
3	3.5	5.5
NUMBER OF TRENCHES		3
TOTAL LENGTH		225'
ABSORPTION AREA		6754
DISTRIBUTION BOX LEVEL		✓
DISTRIBUTION BOX BAFFLE		✓
DISTRIBUTION BOX PORT		—

SEPTIC TANK DATA	
SEPTIC TANK 1 LEVEL	✓
CAPACITY	1500 GAL
SEAM LOC	Top
TANK LID DEPTH	2'
BAFFLES	✓
BAFFLE FILTER	—
MANHOLE LOC	Center
6" PORT LOC	Front
WATERTIGHT TEST	—
SEPTIC TANK 2 LEVEL	—
CAPACITY	— GAL
SEAM LOC	—
TANK LID DEPTH	—
BAFFLES	N/A
BAFFLE FILTER	—
MANHOLE LOC	—
6" PORT LOC	—
WATERTIGHT TEST	—

PRE-CONSTRUCTION 8/28/02 Lot stated layout per R.P. (SO)

INSTALLATION 9/6/02 OK to cover all work (SO)
 House burnt down, completely demoid.


8/24/04 - Ex well & septic reconnected, noted now they have a 2nd house conn. which the well line crosses. Contr. needs to sleeve well line (SO)

8/25/04 - Well line sleeves







FINAL INSPECTOR [Signature] DATE OF APPROVAL 9/6/02
[Signature] 8/25/04

3/24/04 - sunny @ 11:00 AM

- No water observed in bsmt shell
- topo appears to be accurate
- well head & casing intact, no damage (94-3224)
- $\approx 30''$ to inlet of house... measurement not verifiable due to well being ~~kn~~ knocked out. Floor line visible from outside of well.

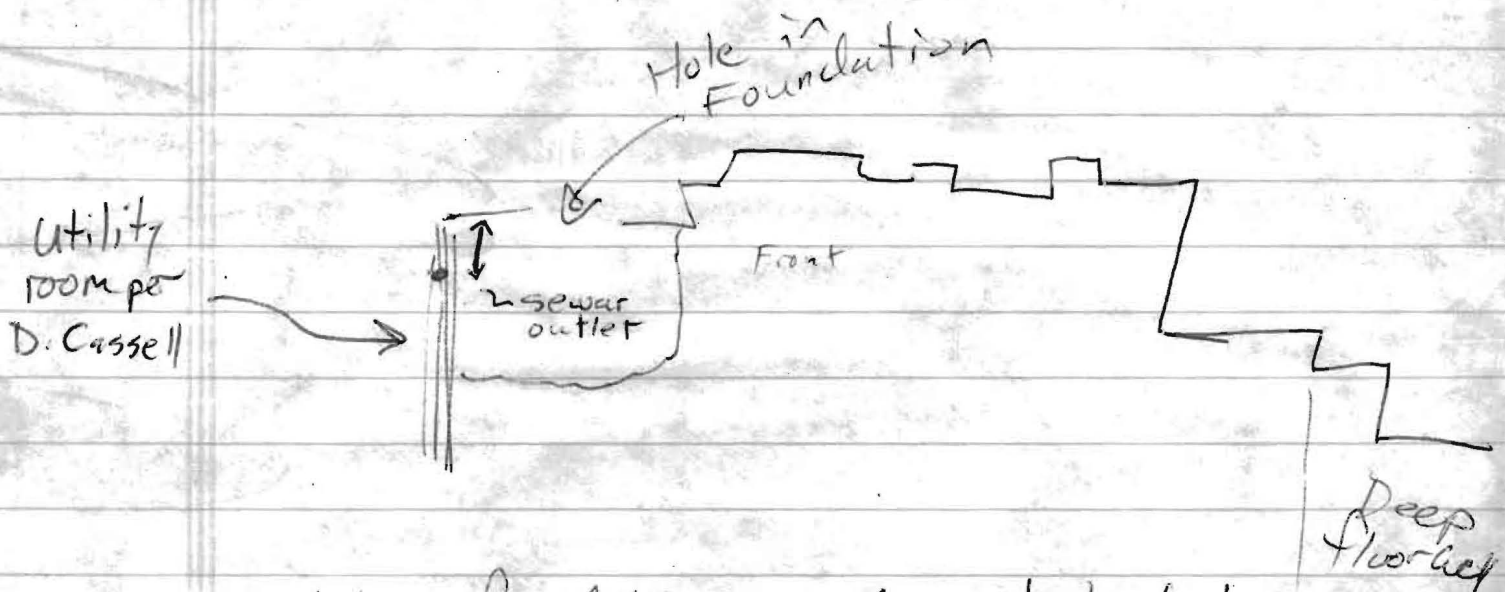

- hole in foundation & evidence of backhoe tracks
- No evidence of old well; appears to have been abandoned properly
- sewer outlet $\approx 44''$ above grade
- water level in main bsmt ~~($\approx 3'$)~~ $\approx 3'$
- all sump pumps had above grade discharge
- off site @ $\approx 11:45$

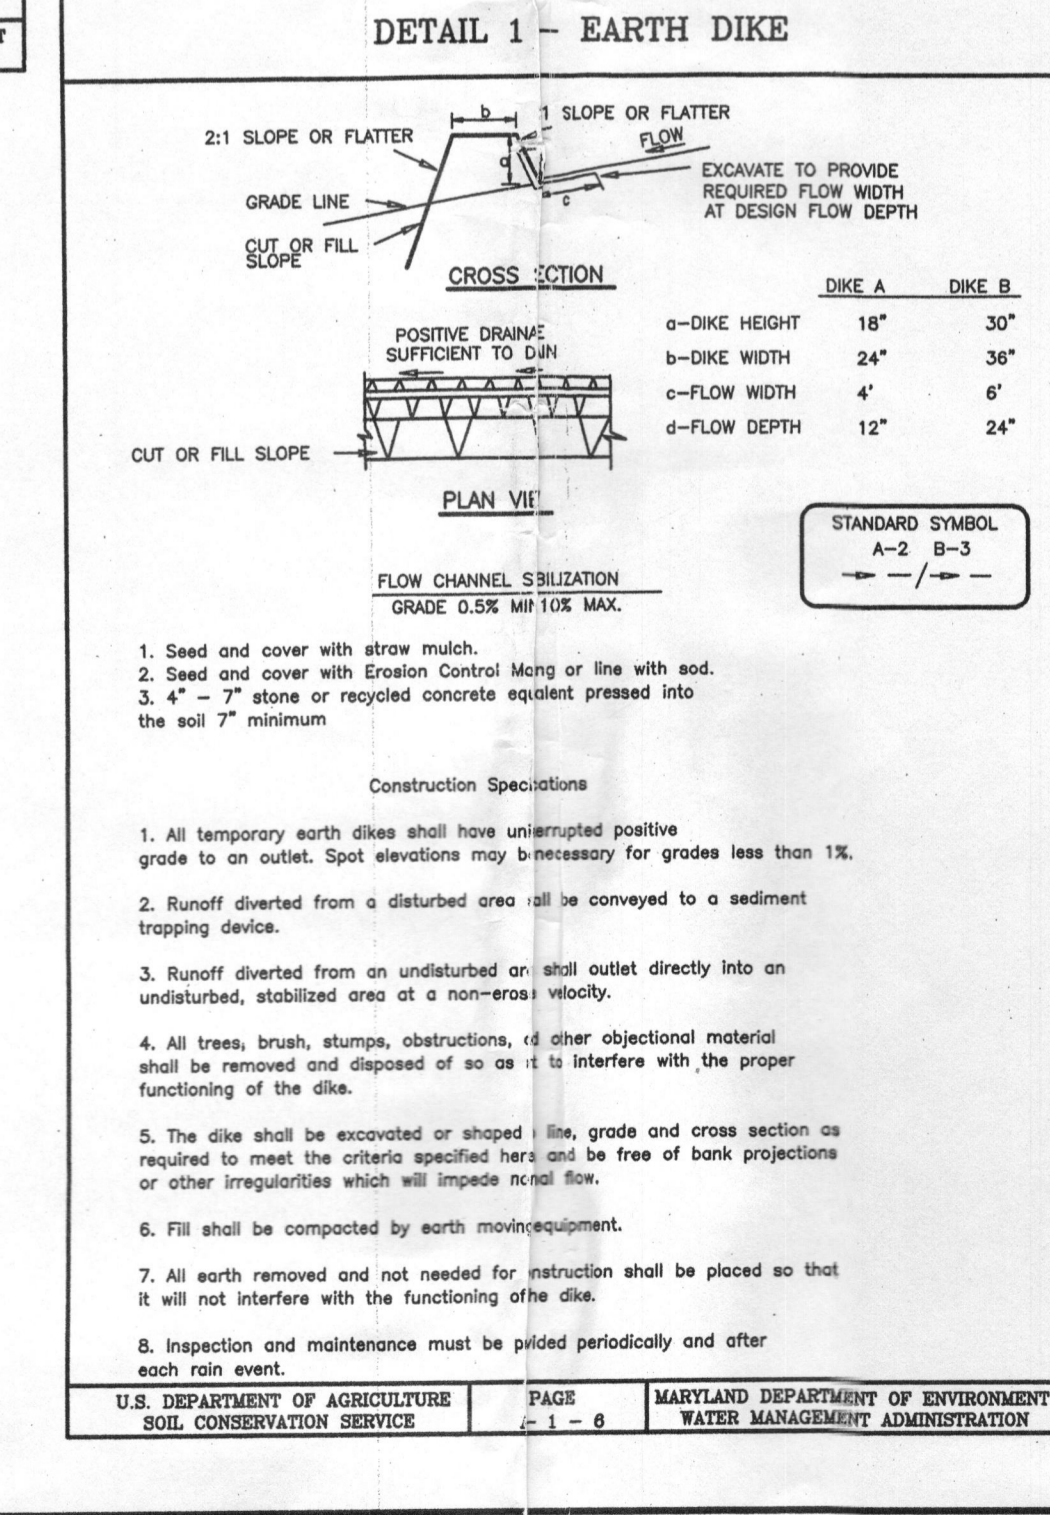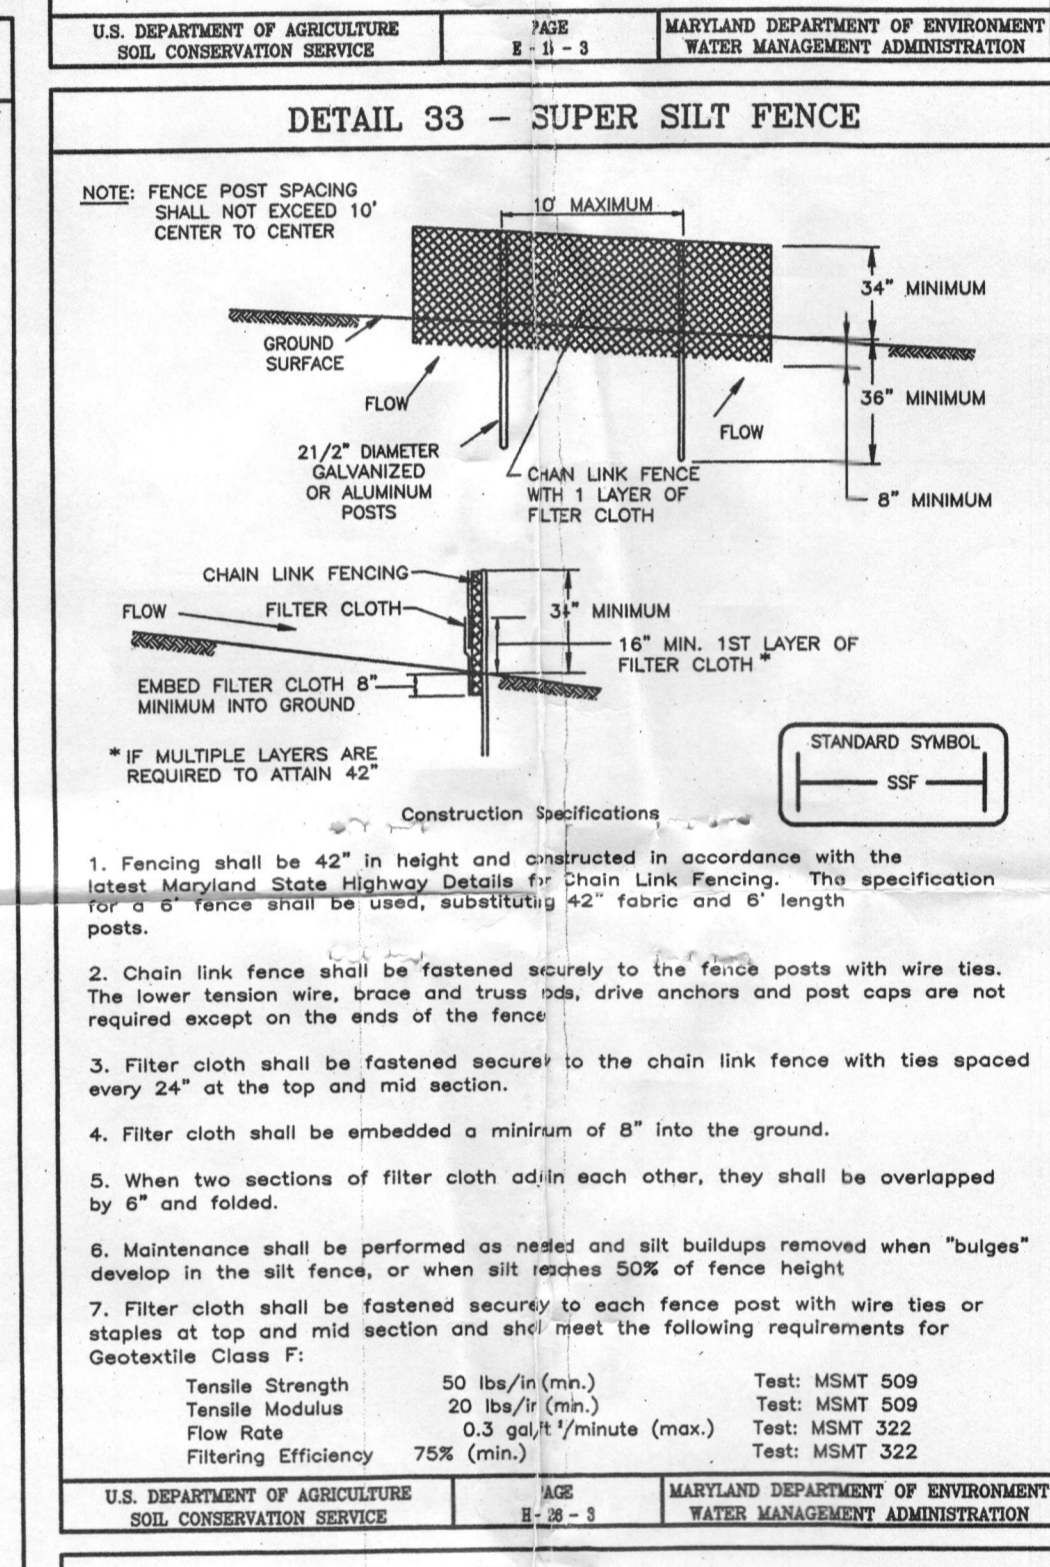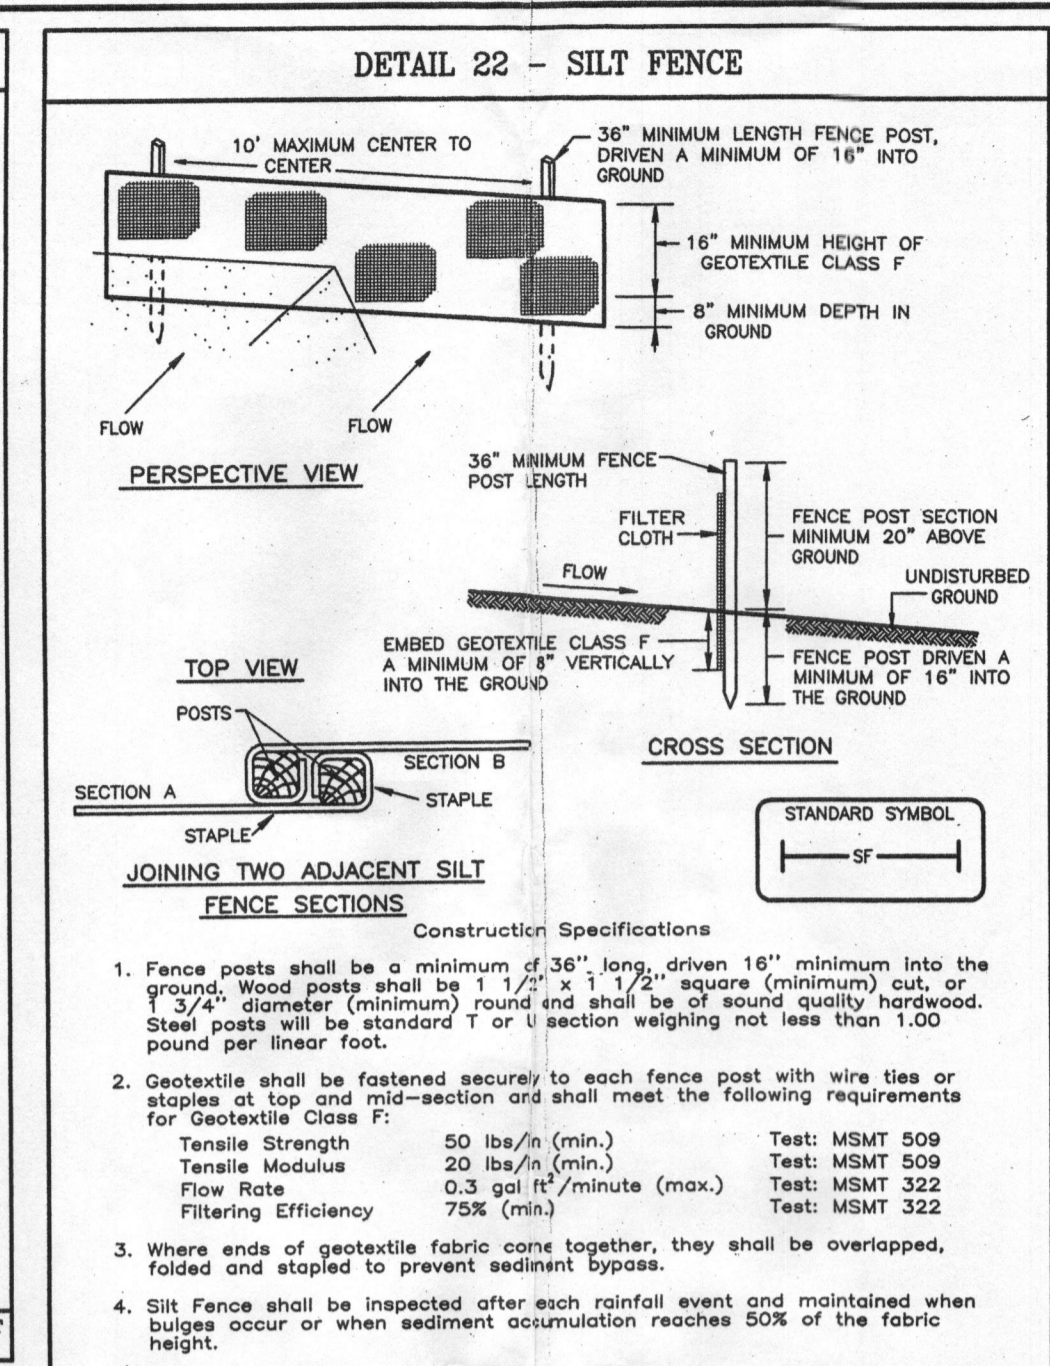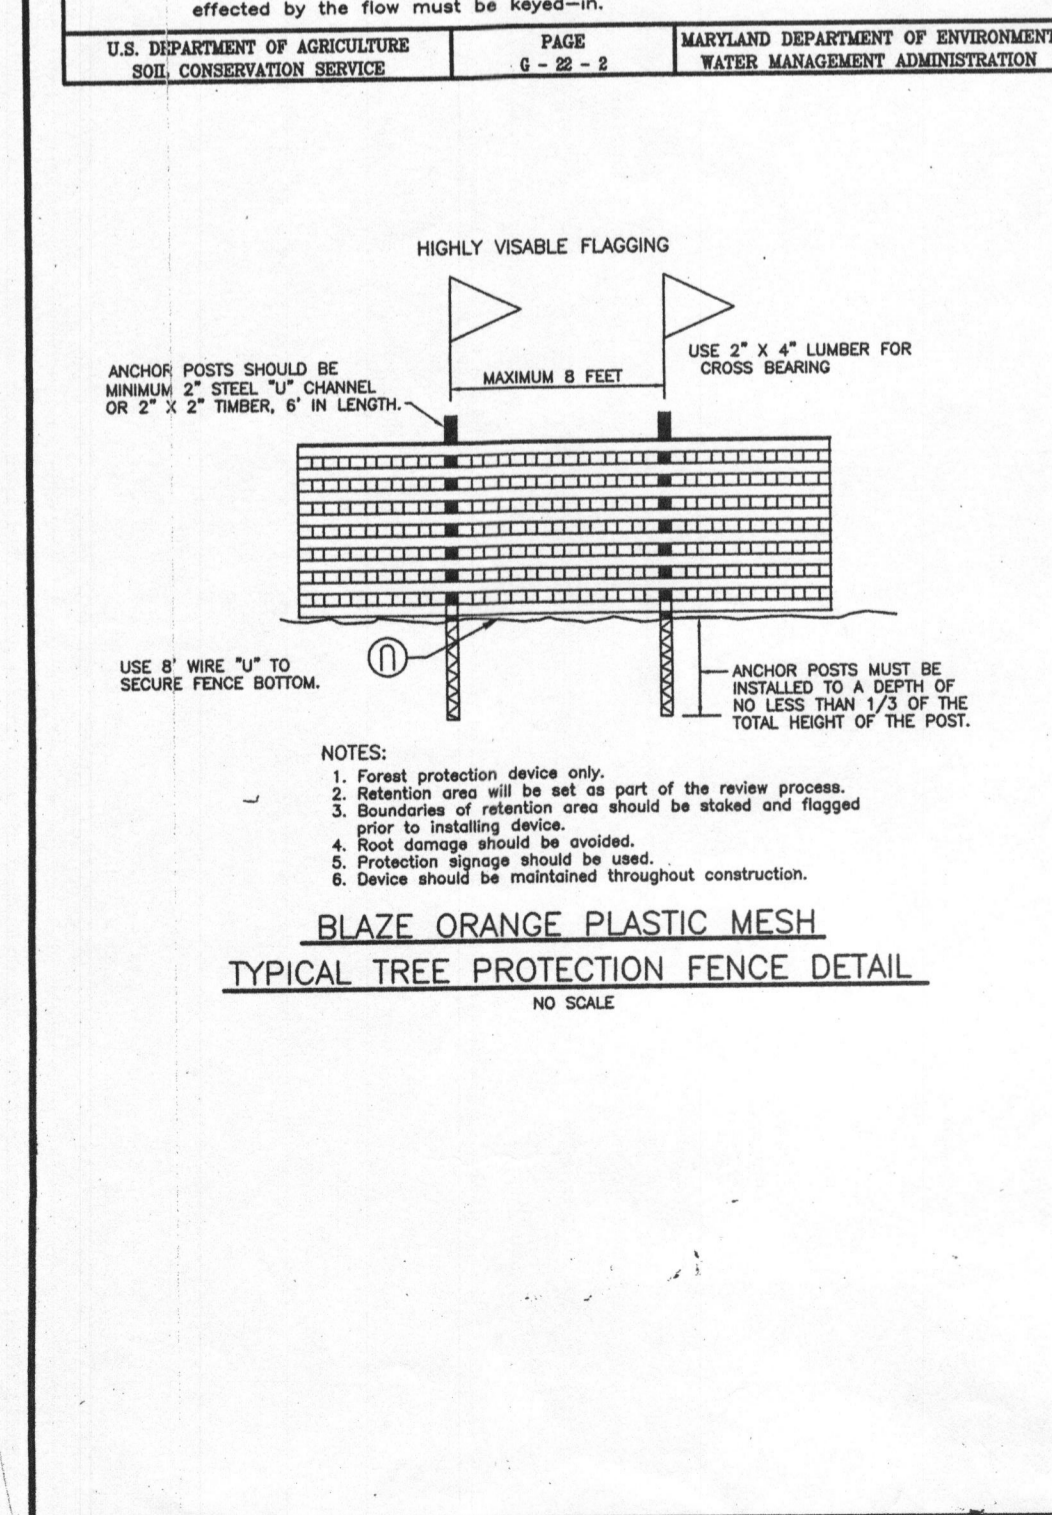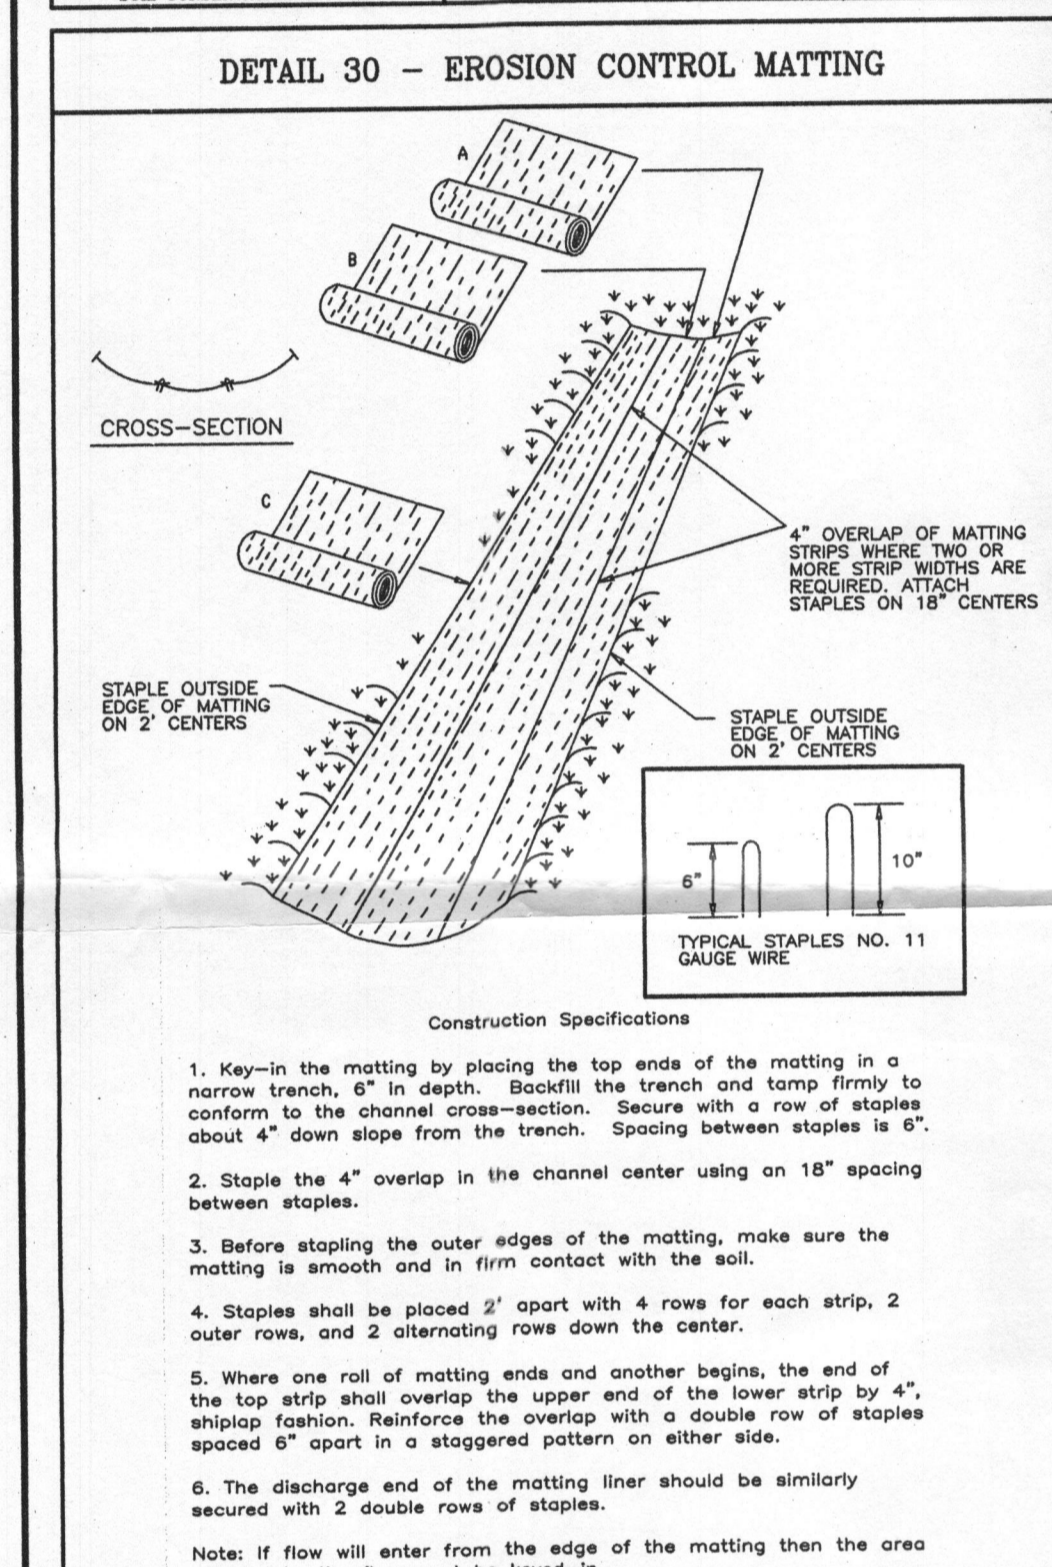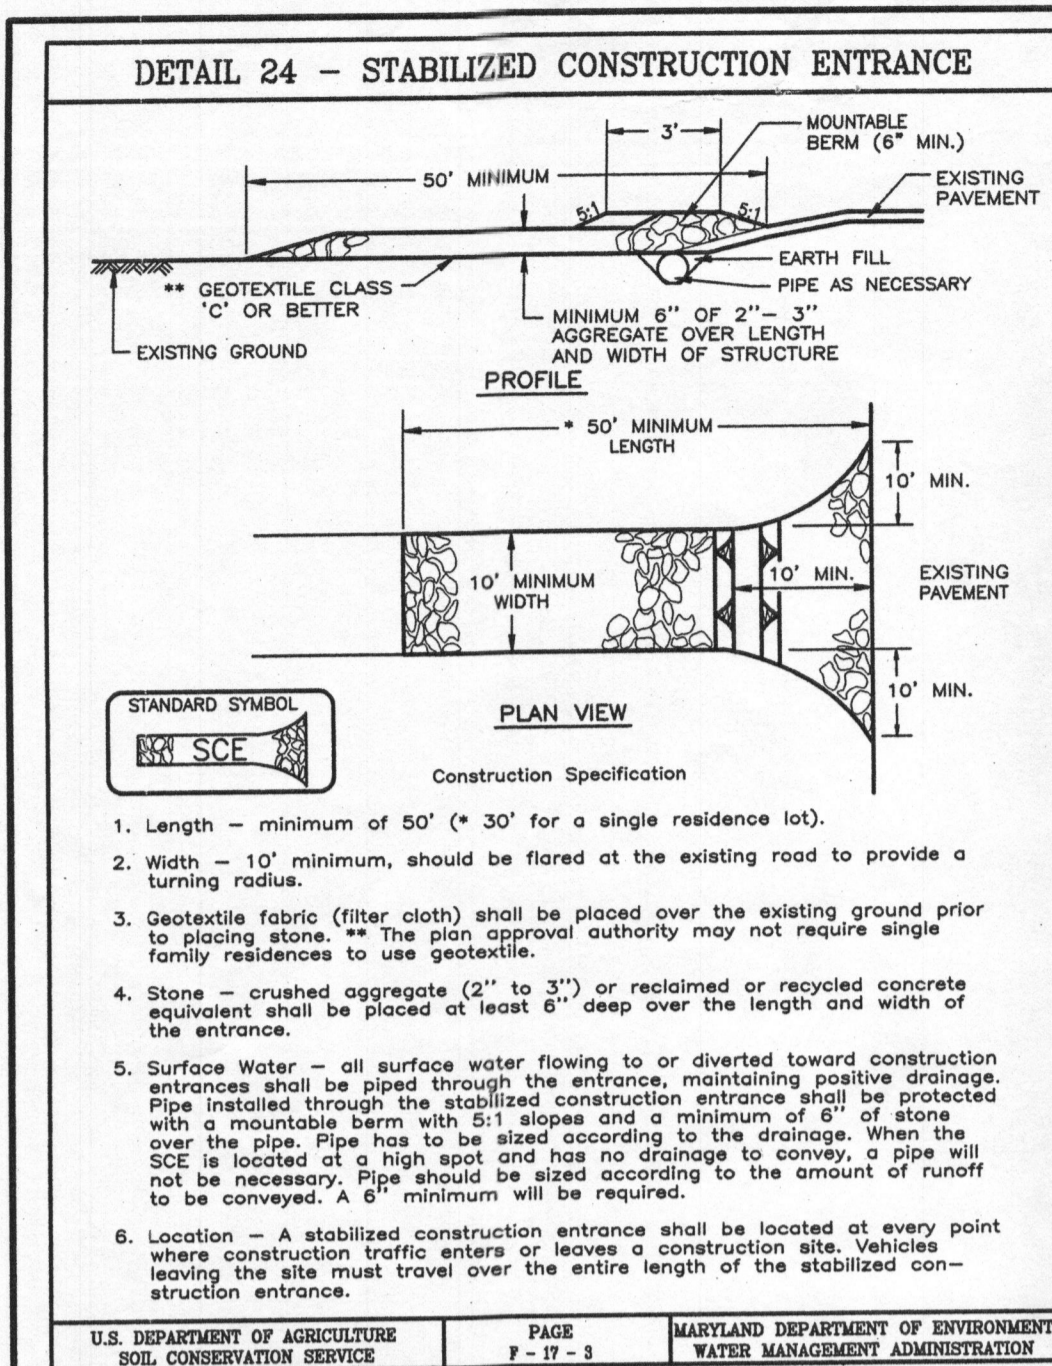

21.0 STANDARDS AND SPECIFICATIONS FOR TOPSOIL

Definition
Placement of topsoil over a prepared subsoil prior to establishment of permanent vegetation.


Purpose
To provide a suitable soil medium for vegetable growth. Soils of concern have low moisture content, low nutrient levels, pH, material toxic to plants, and/or unacceptable soil gradation.

Conditions Where Practice Applies

- This practice is limited to areas having 2:1 or flatter slopes where:
 - The texture of the exposed subsoil/parent material is not adequate to produce vegetative growth.
 - The soil material is so shallow that the rooting zone is not deep enough to support plants or furnish continuing supplies of moisture and plant nutrients.
 - The original soil to be vegetated contains material toxic to plant growth.
 - The soil is so acidic that treatment with limestone is not feasible.
- For the purpose of these Standards and Specifications, areas having slopes steeper than 2:1 require special consideration and design for adequate stabilization. Areas having slopes steeper than 2:1 shall have the appropriate stabilization shown on the plans.

Construction and Material Specifications

- Topsoil salvaged from the existing site may be used provided that it meets the standards set forth in these specifications. Typically, the depth of topsoil to be salvaged for a given soil type can be found in the representative soil profile section in the Soil Survey published by USDA-SCS in cooperation with Maryland Agricultural Experiment Station.
- Topsoil Specifications - Soil to be used as Topsoil must meet the following:
 - Topsoil shall be a loam, sandy loam, clay loam, silt loam, sandy clay loam, loamy sand. Other soils may be used if recommended by an agronomist or a soil scientist and approved by the appropriate approval authority. Regardless, topsoil shall not be a mixture of contrasting textured subsoils and shall contain less than 5% by volume of clinders, stones, slag, coarse fragments, gravel, silt, roots, trash, or other materials larger than 1 1/2" in diameter.
 - Topsoil must be free of plants or plant parts such as Bermuda grass, quackgrass, johnsongrass, nutgrass, poison ivy, thistle, or others as specified.
 - Where the subsoil is either highly acidic or composed of heavy clays, ground limestone shall be spread at the rate of 4-8 tons/acre (200-400 pounds per 1,000 square feet) prior to the placement of topsoil. Lime shall be distributed uniformly over designated areas and worked into the soil in conjunction with tillage operations as described in the following procedures.

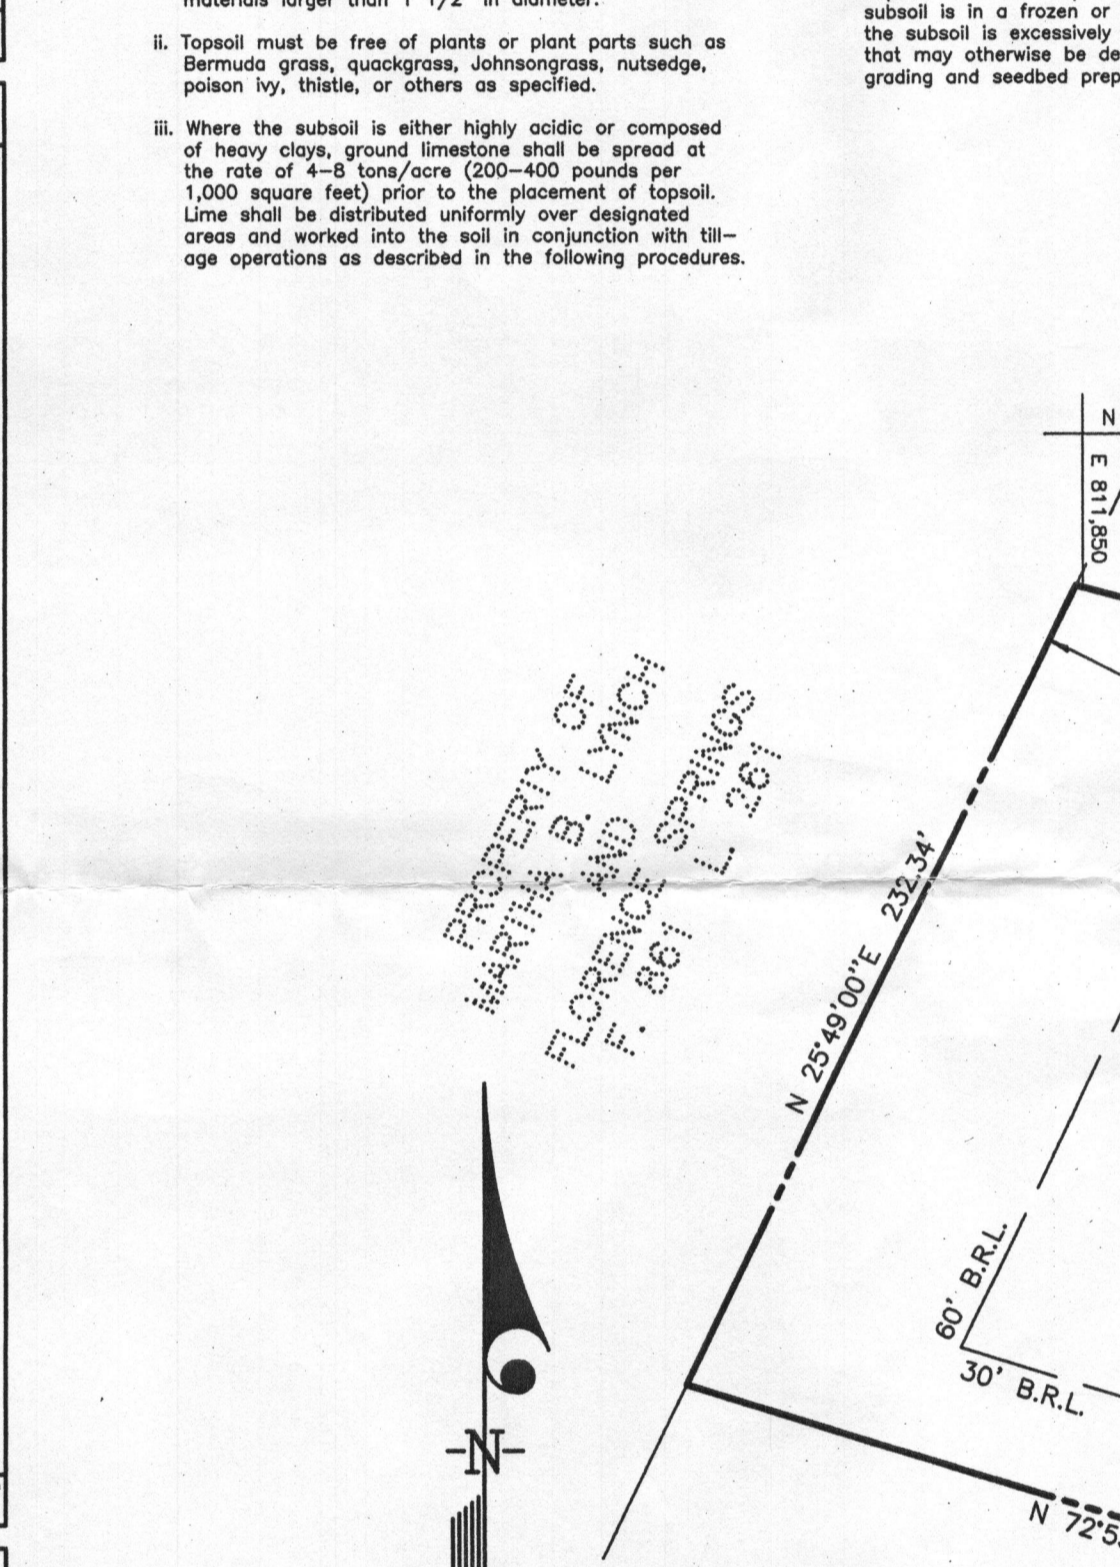

Reviewed for HOWARD S.C.D. and meets Technical Requirements
Signature: [Signature] Date: 7/14/04
U.S. Natural Resources Conservation Service

THIS DEVELOPMENT PLAN IS APPROVED FOR SOIL EROSION AND SEDIMENT CONTROL BY THE HOWARD SOIL CONSERVATION DISTRICT.

Approved: [Signature] DATE: 8-23-01

DEVELOPER'S/BUILDER'S CERTIFICATE
I/We certify that all development and construction will be done according to this plan of development and plan for sediment and erosion control and that all responsible personnel involved in the construction project will have a Certificate of Attendance at a Department of the Environment Approved Training Program for the Control of Sediment and Erosion before beginning the project. I also certify periodic on-site inspection by the Howard Soil Conservation District or their authorized agents, as are deemed necessary.

ENGINEER'S CERTIFICATE
I hereby certify that this plan for Sediment and Erosion Control represents a practical and workable plan based on my personal knowledge of the site conditions and that it was prepared in accordance with the requirements of the Howard Soil Conservation District.

G. NELSON CLARK DATE: 8-22-01

PERMANENT SEEDING NOTES

APPLY TO GRADED OR CLEARED AREAS NOT SUBJECT TO IMMEDIATE FURTHER DISTURBANCE WHERE A PERMANENT LONG-LIVED VEGETATIVE COVER IS DESIRED.

SEEDING PREPARATION: Loosen upper three inches of soil by raking, digging or other acceptable means before seeding, if not previously loosened.

SOIL AMENDMENTS: In lieu of soil test recommendations, use one of the following schedules:

- Preferred-Apply 2 tons per acre dolomitic limestone (92 lbs./1000 sq.ft.) and 800 lbs. per acre 10-10-10 fertilizer (14 lbs./1000 sq.ft.) before seeding. Harrow or disc into upper three inches of soil. At the time of seeding, apply 400 lbs. per acre 30-0-0 ureaform fertilizer (9 lbs./1000 sq.ft.).
- Acceptable-Apply 2 tons per acre dolomitic limestone (92 lbs./1000 sq.ft.) and apply 1000 lbs. per acre 10-10-10 fertilizer (23 lbs./1000 sq.ft.) before seeding. Harrow or disc into upper three inches of soil.

SEEDING: For the periods March 1 thru April 30, and August 1 thru October 15, seed with 800 lbs. per acre (1.4 lbs./1000 sq.ft.) of Kentucky 31 Tall Fescue. For the period May 1 thru July 31, seed with 80 lbs. Kentucky 31 Tall Fescue per acre and 2 lbs. per acre (0.5 lbs./1000 sq.ft.) of weeping lovegrass. During the period of October 18 thru February 28, protect site by Option (1) 2 tons per acre well anchored straw mulch and seed as soon as possible in the spring. Option (2) Use seed. Option (3) Seed with 80 lbs./acre Kentucky 31 Tall Fescue and mulch with 2 tons/acre well anchored straw.

MULCHING: Apply 1 1/2 to 2 tons per acre (70 to 90 lbs./1000 sq. ft.) of untreated small grain straw immediately after seeding. Anchor mulch immediately after application using mulch anchoring tool or 210 gallons per acre (6 gal/1000 sq.ft.) of emulsified asphalt on flat areas, on slopes 8 feet or higher, use 348 gallons per acre (8 gal/1000 sq.ft.) for anchoring.

MAINTENANCE: Inspect all seeded areas and make needed repairs, replacements and reseedings.

TEMPORARY SEEDING NOTES

SEEDING PREPARATION: Loosen upper three inches of soil by raking, digging or other acceptable means before seeding, if not previously loosened.

SOIL AMENDMENTS: Apply 800 lbs. per acre 10-10-10 fertilizer (14 lbs./1000 sq.ft.).

SEEDING: For periods March 1 thru April 30 and from August 15 thru November 15, seed with 2 1/2 bushels per acre of annual ryegrass (3.2 lbs./1000 sq.ft.) For the period May 1 thru August 14, seed with 3 lbs. per acre of weeping lovegrass (0.7 lbs./1000 sq.ft.). For the period November 1 thru February 28, protect site by applying 2 tons per acre of well anchored straw mulch and seed as soon as possible in the spring, or use seed.

MULCHING: Apply 1 1/2 to 2 tons per acre (70 to 90 lbs./1000 sq. ft.) of untreated small grain straw immediately after seeding. Anchor mulch immediately after application using mulch anchoring tool or 210 gallons per acre (6 gal/1000 sq.ft.) of emulsified asphalt on flat areas, on slopes 8 feet or higher, use 348 gallons per acre (8 gal/1000 sq.ft.) for anchoring.

REFER TO THE 1984 MARYLAND STANDARDS AND SPECIFICATIONS FOR SOIL EROSION AND SEDIMENT CONTROL FOR RATE AND METHODS NOT COVERED.

SEDIMENT AND EROSION CONTROL NOTES

1. A minimum of 48 hours notice must be given to the Howard County Department of Inspections, Licenses and Permits (313-1855) for the start of any construction.

2. All vegetative and structural practices are to be installed according to the provisions of this plan and are to be in conformance with the 1984 MARYLAND STANDARDS AND SPECS. FOR SOIL EROSION AND SEDIMENT CONTROL and revisions thereto.

3. Following initial soil disturbance or redisturbance, permanent or temporary stabilization shall be completed within:

- 7 calendar days for all perimeter sediment control structures, dikes, perimeter slopes and all slopes greater than 3:1.
- 14 days for all other disturbed or graded areas on the project site.

4. All sediment traps/basins shown must be fenced and warning signs placed around their perimeters in accordance with Vol. 1, Chapter 7, of the HOWARD COUNTY DESIGN MANUAL, Storm Drainage.

5. All disturbed areas must be stabilized within the time period specified above, in accordance with the 1984 MARYLAND STANDARDS AND SPECIFICATIONS FOR SOIL EROSION AND SEDIMENT CONTROL, permanent seedings, sod, temporary seedings and mulching (Sec. 6).

6. Temporary stabilization with mulch alone can only be done when recommended seeding rates do not allow for proper germination and establishment of grasses.

7. All sediment control structures are to remain in place and are to be maintained in operative condition until permission for their removal has been obtained from the Howard County Sediment Control Inspector.

8. Any sediment control practice which is disturbed by grading or other placement of utilities must be repaired on the same day of disturbance.

9. Additional sediment control must be provided, if deemed necessary by the Howard County DPW Sediment Control Inspector.

10. On all sites with disturbed areas in excess of 2 acres, approval of the inspection agency shall be requested upon completion of installation of perimeter erosion and sediment control, but before proceeding with any other earth disturbance or grading. Other grading or grading inspection approvals may not be authorized until this initial approval by the inspection agency is made.

11. Trenches for the construction of utilities shall be backfilled and stabilized within one working day, or is limited to three pipe lengths.

12. The total amount of earth dikes = 21 LF

13. The total amount of super silt fence = 265 LF

14. The total amount of silt fence = 265 LF

* It is the responsibility of the contractor to identify the spot/borrow site and notify and gain approval from the sediment control inspector of the site and it's grading permit number at the time of construction.

LEGEND

2 FT. = 348

348 = 2 FT.

78 = 10 FT.


10 FT. = 78

55F = SUPER SILT FENCE

CONTOUR INTERVAL
EXISTING CONTOUR
PROPOSED CONTOUR
DIRECTION OF DRAINAGE
WALK OUT BASEMENT
SPOT ELEVATION
STABILIZED CONSTRUCTION ENTRANCE
SILT FENCE
EROSION CONTROL MATTING
LIMIT OF DISTURBED AREA

CONSTRUCTION SEQUENCE:

NO.	DESCRIPTION	NO. OF DAYS
1.	Obtain grading permit.	7
2.	Install first perimeter fence.	7
3.	Install sediment and erosion control devices and stabilize.	14
4.	Excavate for foundations, rough grade and temporarily stabilize.	30
5.	Construct structures, sidewalks and driveways.	30
6.	Final grade, install Erosion Control Matting and stabilize in accordance with standards and specifications.	14
7.	Upon approval of the sediment control inspector, remove sediment and erosion control devices and stabilize.	7
	* Delay construction of houses on lots:	N/A

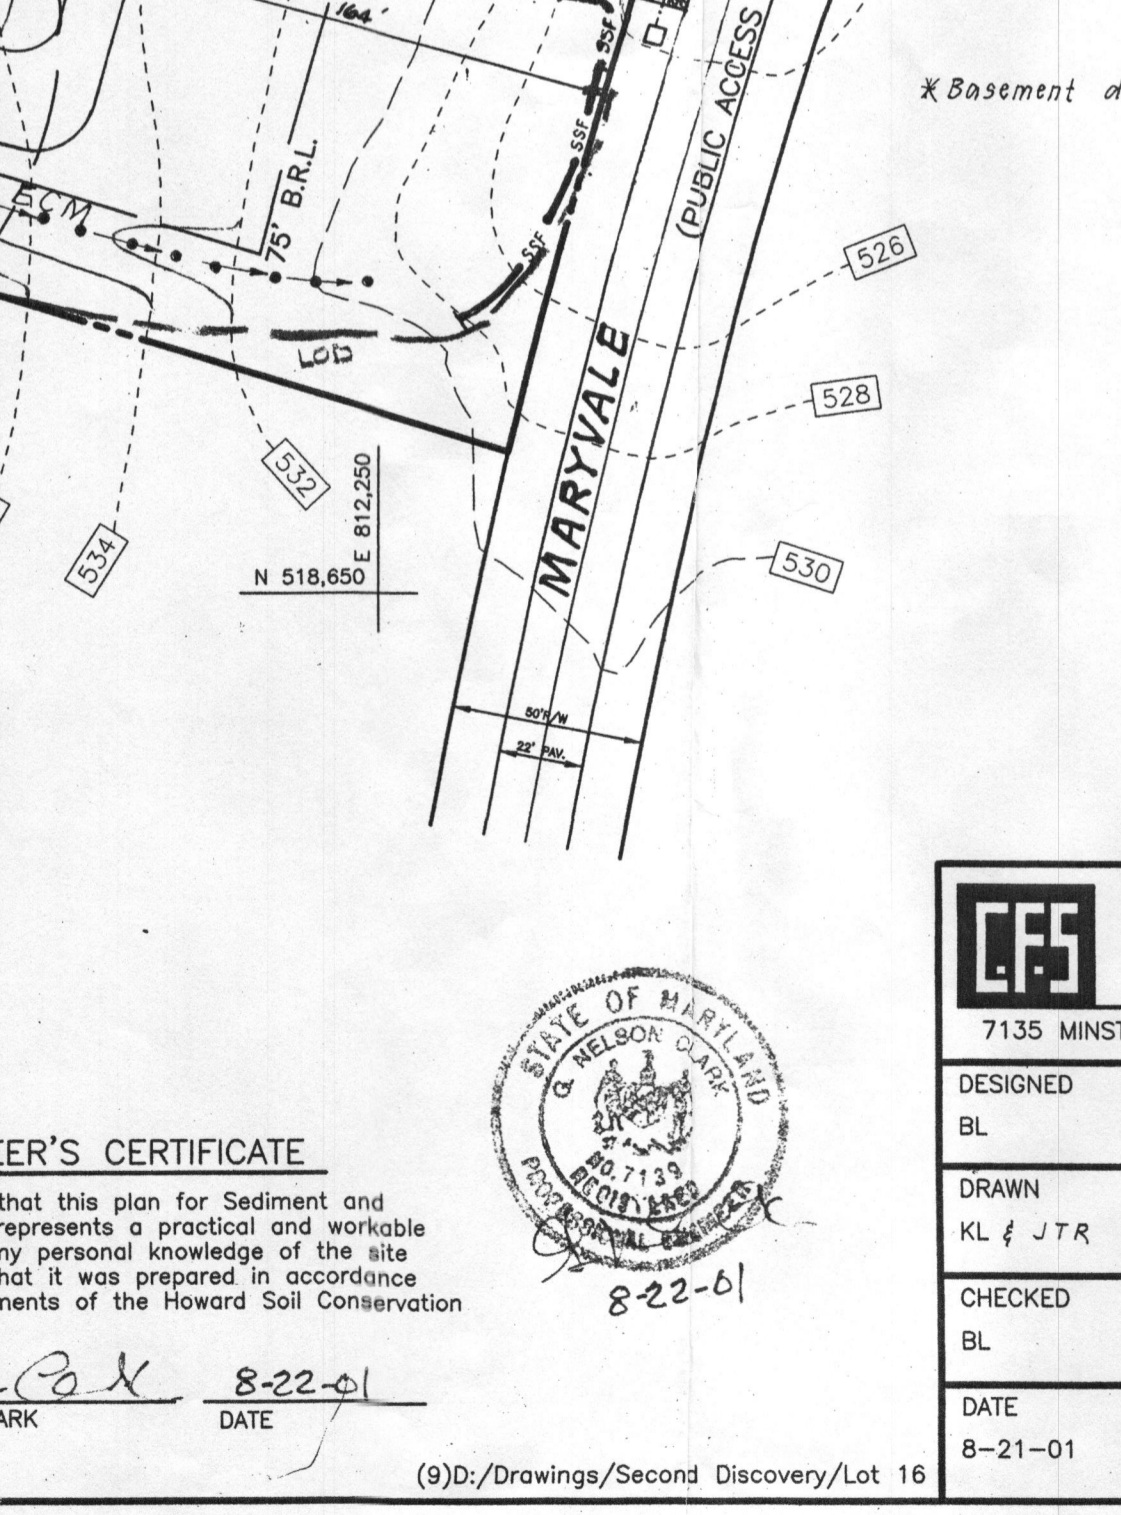

GENERAL NOTES

- TOPOGRAPHY WAS TAKEN FROM HOWARD COUNTY G.I.S. TOPOGRAPHY MAPS
- ZONE: RR-DEO
- RECORDED PLAT NO.: 9143 ON 2-5-90.

OWNER / DEVELOPER
PATRIOT HOMES
P.O. BOX 1018
COLUMBIA, MARYLAND 21044

CLARK · FINEFROCK & SACKETT, INC.
ENGINEERS · PLANNERS · SURVEYORS
7135 MINSTREL WAY · COLUMBIA, MD 21045 · (410) 381-7500 BALT. · (301) 621-8100 WASH.

DESIGNED BY: [Signature]
DRAWN BY: KL & JTR
CHECKED BY: [Signature]
DATE: 8-21-01

SCALE: 1" = 50'
DRAWING: 1 of 1
JOB NO.: 01-068
FILE NO.: 01-068

FOR: PATRIOT HOMES
P.O. BOX 1018
COLUMBIA, MARYLAND 21044

SEDIMENT AND EROSION CONTROL PLAN
LOT 16
SECOND DISCOVERY

TAX MAP 22 PARCELS 44 & 45
THIRD (3rd) ELECTION DISTRICT
HOWARD COUNTY, MARYLAND

8-22-01

(9)D:/Drawings/Second Discovery/Lot 16

G.P 02-24

NOTE: This Lot appears to lie in an area classified as Zone C, area of minimal flooding as shown on FIRM MAP of Howard County, Maryland, Community Panel Number 2400440021B, Panel 21 of 45, dated December 4, 1986


N/E PROPERTY OF MARTHA B. LYNCH AND FLORENCE SPRINGS 8611261

Wall Check: 6-21-02 Top of Wall Elev.: 535.9'

LOT 1 SECOND DISCOVERY


LOT 16 3,000 AC. ±

LOT 15

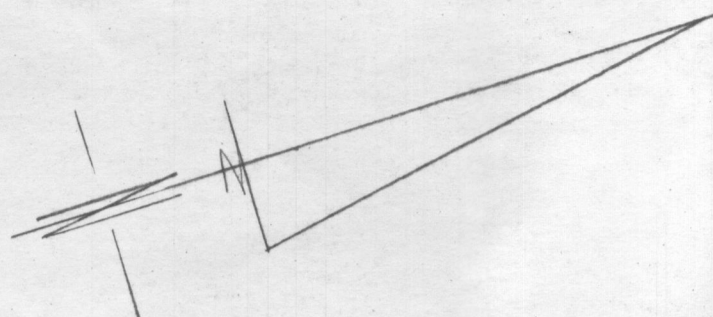

8/15/02 (M) WALL CHECK OK HOUSE SLID ~5' TO THE LEFT AND FRONT FF RAISED 0.6'±

Private Sewage Easement Modification As Accepted By The Howard County Health Depart

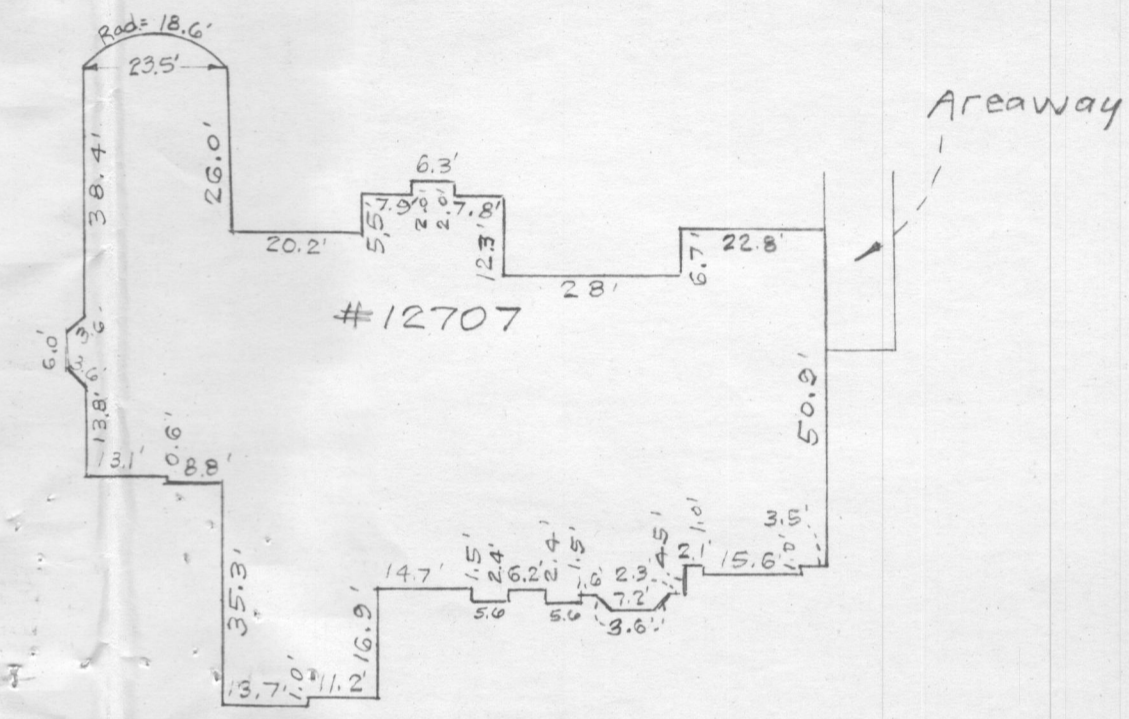

SCALE: 1" = 30'

CONSUMER INFORMATION

- 1) This plat is of benefit to the consumer insofar as it is required by a lender of a title insurance company or its agent in connection with contemplated transfer, financing or refinancing purposes;
2) This plat is not to be relied upon for the establishment or location of fences, garages, buildings or other existing or future structures;
3) This plat does not provide for the accurate identification of property boundary lines, but such identification may not be required for the transfer of title or for securing financing or refinancing.

SURVEYOR'S CERTIFICATE

I hereby certify that a field survey of this property has been made under my supervision for the purpose of locating improvements shown hereon, and that they are located as shown.

DATE

NOTES: 1. The setback distance accuracy = 1'.

Plat Reference: PLAT No. 9142

CLARK • FINEFROCK & SACKETT, INC. ENGINEERS • PLANNERS • SURVEYORS
7135 MINSTREL WAY • COLUMBIA, MD 21045 • (410) 381-7500 BALT. • (301) 621-8100 WASH.
LOCATION DRAWING 12707 MARYVALE COURT LOT 16 SECOND DISCOVERY LOTS 1-16 3RD ELECTION DISTRICT HOWARD COUNTY, MARYLAND
SCALE 1" = 50'
DESIGNED, DRAWN, CHECKED, DATE: 6-25-02
JOB NO., FILE NO.: 01-068-0