

HOWARD COUNTY PERMIT APPLICATION

PERMIT NUMBER
B00146763 JAB

Building Address 12707 Maryvle Ct.
Ellicott City, MD 21042

Suite/Apt.#: N/A SDP/WP/Petition #: _____

Census Tract 6030 Subdivision Second Discovery

Section _____ Area _____ Lot 16

Tax Map 22 Parcel 45 Grid 17

Zoning RC Map Coordinates 10C11 Lot size _____

Property Owner's Name Frederick W. Kunkle

Address 10211 Wincopin Circle

City Columbia State MD Zip Code 21044

Home Phone _____ Work Phone 410-997-7400

Applicant's Name & Mailing Address, (if other than stated hereon):
Building Permit Services, Inc. - Pat Orla
7806 Deboy Ave., Balto., MD 21222

Phone 410-477-9666 Fax 410-477-8437

Existing Use Distroyed by fire -B00134278

Proposed Use SFD

Estimated Construction Cost \$ 3,000,000.00

Description of Work Custom SFD 2 story full finished basemen
20R,6FB,3HB,5FP,screen porch,3 car gar, 6Br.

Contractor Company Owner

Contact Person Tara Nichols/ Cindy Huntzberry

Address _____

City _____ State _____ Zip Code _____

License No. MHBR# 177

Phone 410-423-0417 Fax 410-423-0459

Occupant or Tenant _____

Contact Name _____

Address _____

City _____ State _____ Zip Code _____

Phone _____ Fax _____

Engineer or Architect Company _____

Contact Person _____

Address _____

City _____ State _____ Zip Code _____

Phone _____ Fax _____

BUILDING DESCRIPTION - COMMERCIAL

BUILDING DESCRIPTION - RESIDENTIAL

Building Characteristics	Utilities
Height: _____	Water Supply: <input type="checkbox"/> Public <input type="checkbox"/> Private
No. of stories: _____	Sewage Disposal: <input type="checkbox"/> Public <input type="checkbox"/> Private
Gross area, sq. ft. per floor: _____	Electric Yes <input type="checkbox"/> No <input type="checkbox"/> Gas Yes <input type="checkbox"/> No <input type="checkbox"/>
Use group: _____	Heating System: Electric <input type="checkbox"/> Oil <input type="checkbox"/> Natural Gas <input type="checkbox"/> Propane Gas <input type="checkbox"/>
Construction type: <input type="checkbox"/> Reinforced Concrete <input type="checkbox"/> Structural Steel <input type="checkbox"/> Masonry <input type="checkbox"/> Wood Frame <input type="checkbox"/> State Certified Modular	Sprinkler system: <u>N/A</u> <input type="checkbox"/> <input type="checkbox"/> Full <input type="checkbox"/> Partial <input type="checkbox"/> Other Suppression # of Heads _____

Building Characteristics	Utilities
SF Dwelling <input checked="" type="checkbox"/> SF Townhouse <input type="checkbox"/>	Water Supply: <input type="checkbox"/> Public <input checked="" type="checkbox"/> Private
Depth: <u>118'</u> Width: <u>101'</u>	Sewage Disposal: <input type="checkbox"/> Public <input checked="" type="checkbox"/> Private
1st floor: _____	Electric Yes <input checked="" type="checkbox"/> No <input type="checkbox"/> Gas Yes <input checked="" type="checkbox"/> No <input type="checkbox"/>
2nd floor: <u>72'</u>	Heating System: Electric <input type="checkbox"/> Oil <input type="checkbox"/> Natural Gas <input checked="" type="checkbox"/> Propane Gas <input type="checkbox"/>
Basement: <u>116'</u>	Sprinkler system: <u>N/A</u> <input type="checkbox"/> <input type="checkbox"/> NFPA # 13D <input type="checkbox"/> NFPA #13R <input type="checkbox"/> Other:
Finished Basement <input checked="" type="checkbox"/> Unfinished Basement <input type="checkbox"/> Crawl space <input type="checkbox"/> Slab on Grade <input type="checkbox"/> No. of Bedrooms <u>6</u>	
Multi-family dwellings: No. of efficiency units: _____ No. of 1 BR units: _____ No. of 2 BR units: _____ No. of 3 BR units: _____	
Other Structure: _____ Dimensions: _____ Footings: <u>16"x8"</u> Roof: <u>Asp/Gable</u>	
<input type="checkbox"/> State Certified Modular <input type="checkbox"/> Manufactured Home	

I, THE UNDERSIGNED HEREBY CERTIFIES AND AGREES AS FOLLOWS: (1) THAT HE/SHE IS AUTHORIZED TO MAKE THIS APPLICATION; (2) THAT THE INFORMATION IS CORRECT; (3) THAT HE/SHE WILL COMPLY WITH ALL REGULATIONS OF HOWARD COUNTY WHICH ARE APPLICABLE HERETO; (4) THAT HE/SHE WILL PERFORM NO WORK ON THE ABOVE REFERENCED PROPERTY NOT SPECIFICALLY DESCRIBED IN THIS APPLICATION; (5) THAT HE/SHE GRANTS COUNTY OFFICIALS THE RIGHT TO ENTER ON TO THIS PROPERTY FOR THE PURPOSE OF INSPECTING THE WORK PERMITTED AND POSTING NOTICES.

Applicant's Signature _____
 Title/Company Agent

Building Permit Services, Inc. - Pat Orla
 Print Name _____
 Date 3/22/04

Checks payable to: **DIRECTOR OF FINANCE OF HOWARD COUNTY**
**** PLEASE WRITE NEATLY AND LEGIBLY. ****
FOR OFFICE USE ONLY -

AGENCY	DATE	SIGNATURE	APPROVAL
<input checked="" type="checkbox"/> Land Development DPZ			
<input checked="" type="checkbox"/> State Highways			
<input checked="" type="checkbox"/> Building Official			
<input checked="" type="checkbox"/> Dev. Engineering DPZ			
<input checked="" type="checkbox"/> Health	<u>4/7/04</u>	<u>[Signature]</u>	
<input checked="" type="checkbox"/> Fire Protection			

Is Sediment Control approval required prior to issuance?
 YES NO

CONTINGENCY CONSTRUCTION START:
 ONE STOP SHOP:

DPZ SETBACK INFORMATION	PROPERTY ID#:
Front: _____	<u>522-2</u>
Rear: _____	Filling fee \$ <u>100.00</u>
Side: _____	Permit fee \$ _____
Side St.: _____	Excise tax \$ _____
All minimum setbacks met?	Subtotal paid \$ _____
YES <input type="checkbox"/> NO <input type="checkbox"/>	Add'l permit fee \$ _____
Is Entrance Permit required?	TOTAL FEES \$ _____
YES <input type="checkbox"/> NO <input type="checkbox"/>	Balance due \$ _____
Historic District?	Check # <u>522</u>
YES <input type="checkbox"/> NO <input type="checkbox"/>	Validation # <u>42573</u>
Lot Coverage for NewTown Zone _____	
SDP/Red-line, approval date _____	Accepted by <u>[Signature]</u>

DEPARTMENT OF INSPECTIONS, LICENSES AND PERMITS
 3430 COURT HOUSE DRIVE
 ELLICOTT CITY, MD 21043
 PERMITS (410)313-2455 INSPECTIONS (410)313-1810
 AUTOMATED INFORMATION (410) 313-3800

HOWARD COUNTY PERMIT APPLICATION

PERMIT NUMBER MP
BO0141597

Building Address 12707 Maryvale Ct.
Clarksville, MD 21029

Suite /Ap t.#: _____ SDP/WP/P etition #: _____

Census Tract 603000 Subdivision Second Discovery

Section _____ Area _____ Lot 16

Tax Map 22 Parcel 45 Grid 17

Zoning RRDEO Map Coordinates 10/C11 Lot size 3.0ac

Property Owner's Name Kunkle - Frederick W. & Frances L.

Address 5125 Northern Fences Lane

City Columbia State MD Zip Code 21044

Home Phone _____ Work Phone 410-997-5522

Applicant's Name & Mailing Address, (if other than stated hereon):

Building Permit Services, Inc. - Pat Orla

7806 Deboy Ave., Balto., MD 21222

Phone 410-477-9666 Fax 410-477-8437

Existing Use SFD- under const.

Proposed Use same w/ retaining walls

Estimated Construction Cost \$ 20,000.00

Description of Work Const.three(3) landscape ret. walls

Contractor Company Patriot Homes

Contact Person Cindy Huntzberry

Address 10211 Wincopin Cir. Ste# 300

City Columbia State MD Zip Code 21044

License No. MHBR# 177

Phone 410-423-0418 Fax _____

Occupant or Tenant _____

Contact Name _____

Address _____

City _____ State _____ Zip Code _____

Phone _____ Fax _____

Engineer or Architect Company _____

Contact Person _____

Address _____

City _____ State _____ Zip Code _____

Phone _____ Fax _____

BUILDING DESCRIPTION - COMMERCIAL

BUILDING DESCRIPTION - RESIDENTIAL

Building Characteristics

Utilities

Height: _____

No. of stories: _____

Gross area, sq. ft. per floor: _____

Use group: _____

Construction type:

____ Reinforced Concrete

____ Structural Steel

____ Masonry

____ Wood Frame

____ State Certified Modular

Water Supply:

____ Public

____ Private

Sewage Disposal:

____ Public

____ Private

Electric Yes No

Gas Yes No

Heating System:

Electric Oil

Natural Gas

Propane Gas

Sprinkler system: N/A

____ Full

____ Partial

____ Other Suppression

____ # of Heads

Building Characteristics

Utilities

SF Dwelling SF Townhouse

Depth _____ Width _____

1st floor: _____

2nd floor: _____

Basement: _____

Finished Basement Unfinished Basement

Crawl space Slab on Grade

No. of Bedrooms _____

Multi-family dwellings:

No. of efficiency units: _____

No. of 1 BR units: _____

No. of 2 BR units: _____

No. of 3 BR units: _____

Other Structure: _____

Dimensions: _____

Footings: _____

Roof: _____

____ State Certified Modular

____ Manufactured Home

Water Supply:

____ Public

Private

Sewage Disposal:

____ Public

Private

Electric Yes No

Gas Yes No

Heating System:

Electric Oil

Natural Gas

Propane Gas

Sprinkler system: N/A

____ NFPA # 13D

____ NFPA#13R

____ Other:

THE UNDERSIGNED HEREBY CERTIFIES AND AGREES AS FOLLOWS: (1) THAT HE/SHE IS AUTHORIZED TO MAKE THIS APPLICATION; (2) THAT THE INFORMATION IS CORRECT; (3) THAT HE/SHE WILL COMPLY WITH ALL REGULATIONS OF HOWARD COUNTY WHICH ARE APPLICABLE HERETO; (4) THAT HE/SHE WILL PERFORM NO WORK ON THE ABOVE REFERENCED PROPERTY NOT SPECIFICALLY DESCRIBED IN THIS APPLICATION; (5) THAT HE/SHE BANTS COUNTY OFFICIALS THE RIGHT TO ENTER ONTO THIS PROPERTY FOR THE PURPOSE OF INSPECTING THE WORK PERMITTED AND POSTING NOTICES.

[Signature]
 Applicant's Signature

Agent

Title/Company

Building Permit Services, Inc. - Pat Orla

Print Name

4/30/03

Date

Checks payable to: **DIRECTOR OF FINANCE OF HOWARD COUNTY**
**** PLEASE WRITE NEATLY AND LEGIBLY. ****

- FOR OFFICE USE ONLY -

AGENCY	DATE	SIGNATURE	APPROVAL
Land Development, DPZ			
State Highways			
Building Official	<u>5/1/03</u>	<u>[Signature]</u>	
Dev. Engineering, DPZ			
Health	<u>6/2/03</u>	<u>Mark [Signature]</u>	
Fire Protection			

Is Sediment Control approval required prior to issuance?

YES NO

CONTINGENCY CONSTRUCTION START:

ONE STOP SHOP:

DPZ SETBACK INFORMATION

Front: _____

Rear: _____

Side: _____

Side St.: _____

All minimum setbacks met?

YES NO

Is Entrance Permit required?

YES NO

Historic District?

YES NO

Lot Coverage for New Town Zone _____

SDP/Red-line, approval date _____

PROPERTY ID#:

Filling fee \$ 50

Permit fee \$ _____

Excise tax \$ _____

Subtotal paid \$ 50.00

Add'l permit fee \$ _____

TOTAL FEES \$ 50.00

Balance due \$ _____

Check # 7722

Validation # _____

Accepted by [Signature]

Distribution of Copies-



White: Building Official

Green: LDD, DPZ

Yellow: DED, DPZ

Pink: Health

Gold: SHA

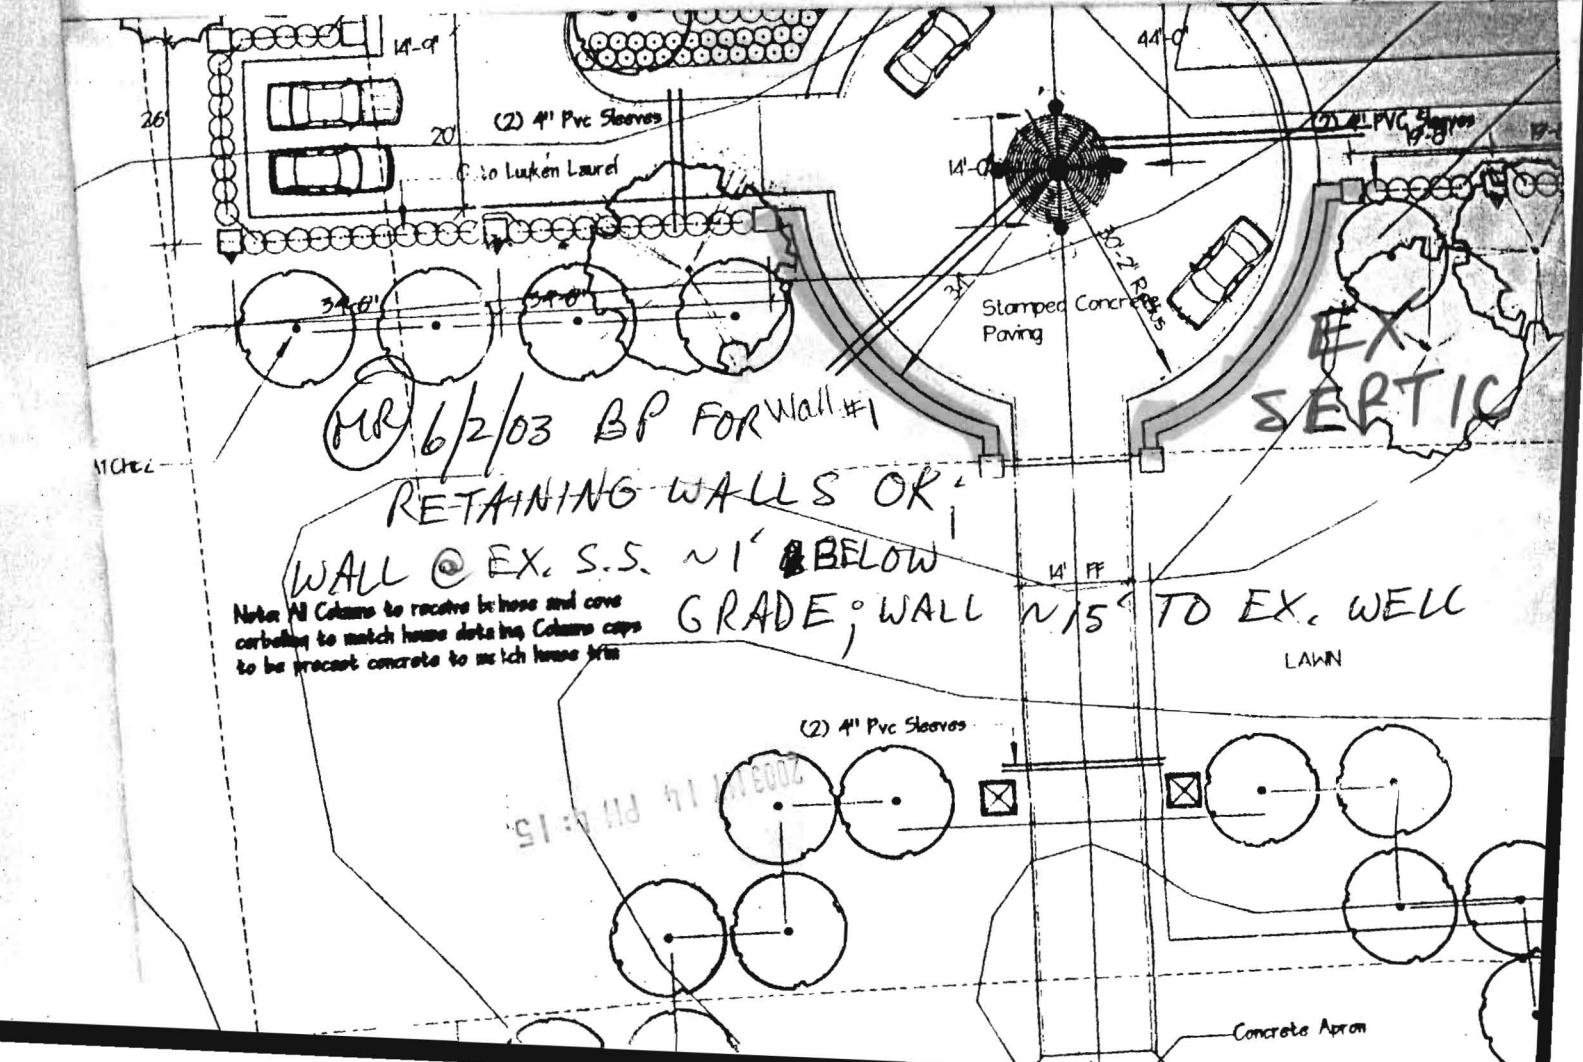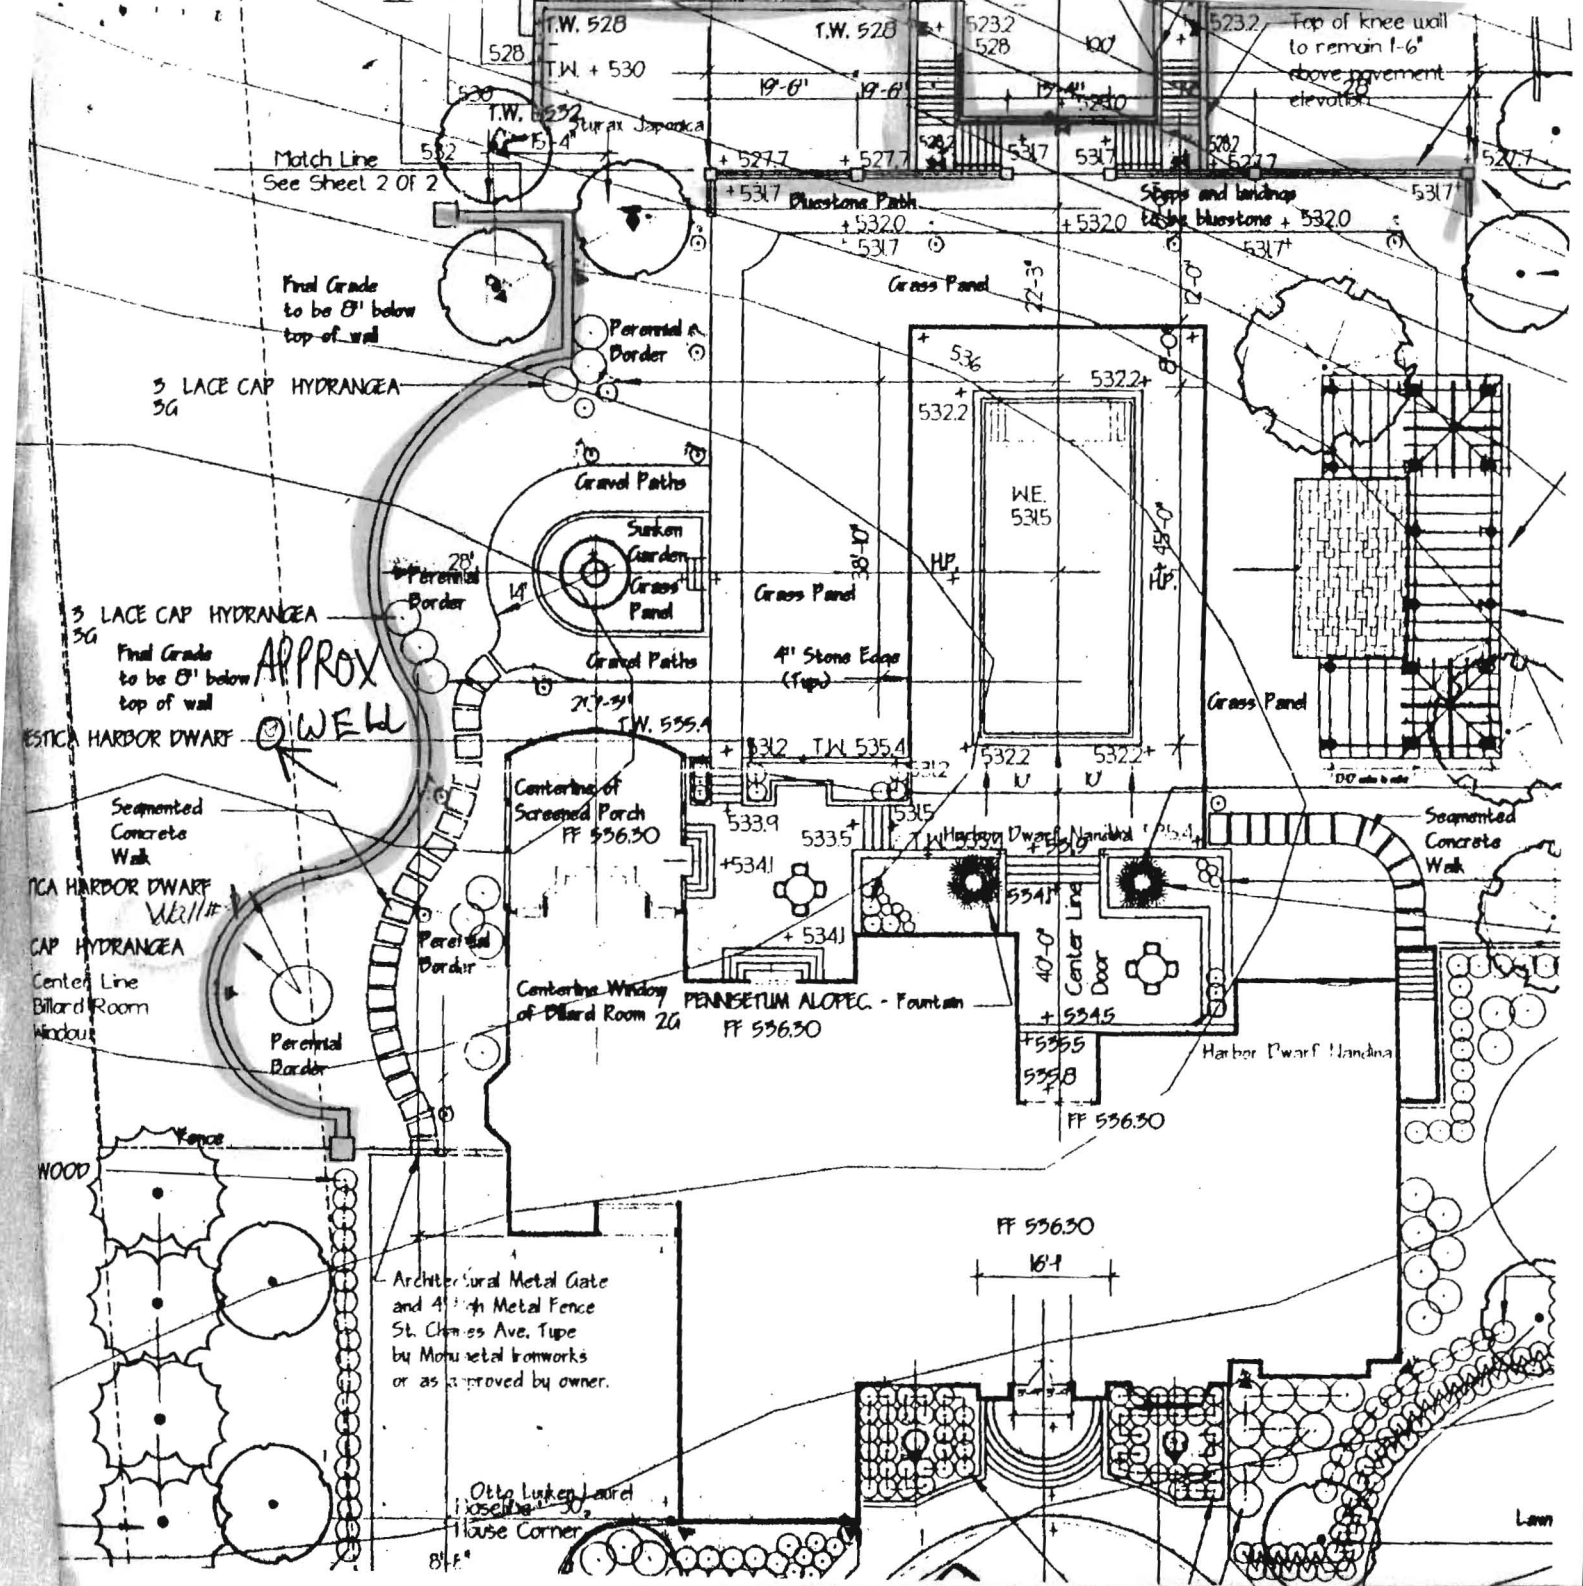

Match Line
See Sheet 2 of 2

Final Grade
to be 0' below
top of wall

3 LACE CAP HYDRANGEA
3G

APPROX
WELL

3 LACE CAP HYDRANGEA
3G
Final Grade
to be 0' below
top of wall

ESTICA HARBOR DWARF

Seamanted
Concrete
Walk

ESTICA HARBOR DWARF
Well #1

3 LACE CAP HYDRANGEA

Center Line
Billard Room
Window

WOOD

Architctural Metal Gate
and 4' High Metal Fence
St. Charles Ave. Type
by Monu metal ironworks
or as approved by owner.

WOOD

WOOD

MR 6/2/03 BP FOR Wall #1
RETAINING WALLS OK;
WALL @ EX. S.S. ~1' BELOW
GRADE; WALL ~15' TO EX. WELL

Note: All Columns to receive base and cover
corbelling to match house details; Columns caps
to be precast concrete to match house finish

EX
SERTIC

LAWN

Concrete Apron

Building Address <u>12707 Marquale Ct</u> Suite/Apt. #: _____ SDP/WP/Petition #: _____ Census Tract <u>3</u> Subdivision _____ Section _____ Area _____ Lot _____ Tax Map <u>12</u> Parcel <u>22</u> Grid <u>11</u> Zoning <u>R-1</u> Map Coordinates _____ Lot size _____	Property Owner's Name <u>Kunkle</u> Address _____ City _____ State _____ Zip Code _____ Home Phone _____ Work Phone _____ Applicant's Name & Mailing Address, (if other than stated hereon): _____ Phone _____ Fax _____
---	---

Existing Use _____ Proposed Use _____ Estimated Construction Cost \$ _____ Description of Work <u>IG POOL w/fence</u> <u>20x45 inground pool</u>	Contractor Company _____ Contact Person _____ Address _____ City _____ State _____ Zip Code _____ License No. _____ Phone _____ Fax _____
--	--

Occupant or Tenant _____ Contact Name _____ Address _____ City _____ State _____ Zip Code _____ Phone _____ Fax _____	Engineer or Architect Company _____ Contact Person _____ Address _____ City _____ State _____ Zip Code _____ Phone _____ Fax _____
---	--

BUILDING DESCRIPTION - <u>COMMERCIAL</u>		BUILDING DESCRIPTION - <u>RESIDENTIAL</u>	
Building Characteristics	Utilities	Building Characteristics	Utilities
Height: _____ No. of stories: _____ Gross area, sq. ft. per floor: _____ Use group: _____ Construction type: <input type="checkbox"/> Reinforced Concrete <input type="checkbox"/> Structural Steel <input type="checkbox"/> Masonry <input type="checkbox"/> Wood Frame <input type="checkbox"/> State Certified Modular	Water Supply: <input type="checkbox"/> Public <input type="checkbox"/> Private Sewage Disposal: <input type="checkbox"/> Public <input type="checkbox"/> Private Electric Yes <input type="checkbox"/> No <input type="checkbox"/> Gas Yes <input type="checkbox"/> No <input type="checkbox"/> Heating System: Electric <input type="checkbox"/> Oil <input type="checkbox"/> Natural Gas <input type="checkbox"/> Propane Gas <input type="checkbox"/> Sprinkler system: N/A <input type="checkbox"/> <input type="checkbox"/> Full <input type="checkbox"/> Partial <input type="checkbox"/> Other Suppression # of Heads _____	SF Dwelling <input type="checkbox"/> SF Townhouse <input type="checkbox"/> Depth _____ Width _____ 1st floor: _____ 2nd floor: _____ Basement: _____ Finished Basement <input type="checkbox"/> Unfinished Basement <input type="checkbox"/> Crawl space <input type="checkbox"/> Slab on Grade <input type="checkbox"/> No. of Bedrooms _____ Multi-family dwellings: No. of efficiency units: _____ No. of 1 BR units: _____ No. of 2 BR units: _____ No. of 3 BR units: _____ Other Structure: _____ Dimensions: _____ Footings: _____ Roof: _____ <input type="checkbox"/> State Certified Modular <input type="checkbox"/> Manufactured Home	Water Supply: <input type="checkbox"/> Public <input type="checkbox"/> Private Sewage Disposal: <input checked="" type="checkbox"/> Public <input type="checkbox"/> Private Electric Yes <input type="checkbox"/> No <input type="checkbox"/> Gas Yes <input type="checkbox"/> No <input type="checkbox"/> Heating System: Electric <input type="checkbox"/> Oil <input type="checkbox"/> Natural Gas <input type="checkbox"/> Propane Gas <input type="checkbox"/> Sprinkler system: N/A <input type="checkbox"/> <input type="checkbox"/> NFPA #13D <input type="checkbox"/> NFPA #13R <input type="checkbox"/> Other: _____

THE UNDERSIGNED HEREBY CERTIFIES AND AGREES AS FOLLOWS, (1) THAT HE/SHE IS AUTHORIZED TO MAKE THIS APPLICATION, (2) THAT THE INFORMATION IS CORRECT, (3) THAT HE/SHE WILL COMPLY WITH ALL REGULATIONS OF HOWARD COUNTY WHICH ARE APPLICABLE THERE TO, (4) THAT HE/SHE WILL PERFORM NO WORK ON THE ABOVE REFERENCED PROPERTY NOT SPECIFICALLY DESCRIBED IN THIS APPLICATION, (5) THAT HE/SHE GRANTS COUNTY OFFICIALS THE RIGHT TO ENTER ONTO THIS PROPERTY FOR THE PURPOSE OF INSPECTING THE WORK PERMITTED AND POSTING NOTICES.

Applicant's Signature _____ Print Name JK

Title/Company _____ Date _____

Checks payable to: **DIRECTOR OF FINANCE OF HOWARD COUNTY**
 ** PLEASE WRITE NEATLY AND LEGIBLY. **
 - FOR OFFICE USE ONLY -

AGENCY	DATE	SIGNATURE APPROVAL	DPZ SETBACK INFORMATION	PROPERTY ID#: <u>52702</u>
Land Development, DPZ			Front: _____	Filing fee \$ _____
State Highways			Rear: _____	Permit fee \$ _____
Building Official			Side: _____	Excise tax \$ _____
Dev. Engineering, DPZ			Side St: _____	Add'l per. fee \$ _____
Health	<u>3/12/03</u>	<u>Glatt</u>	All minimum setbacks met? YES <input type="checkbox"/> NO <input type="checkbox"/>	TOTAL FEES \$ <u>250.00</u>
Fire Protection			Is Entrance Permit required? YES <input type="checkbox"/> NO <input type="checkbox"/>	Sub-total paid \$ _____
Is Sediment Control approval required prior to issuance? YES <input type="checkbox"/> NO <input type="checkbox"/>			Historic District? YES <input type="checkbox"/> NO <input type="checkbox"/>	Balance due \$ _____
CONTINGENCY CONSTRUCTION START: <input type="checkbox"/>			Lot Coverage for New Town Zone _____	Check # <u>5743</u>
ONE STOP SHOP: <input type="checkbox"/>			SDP/Red-line approval date _____	Validation # <u>21784</u>
				Accepted by _____

SRK

DEPARTMENT OF INSPECTIONS, LICENSES AND PERMITS
 3430 COURT HOUSE DRIVE
 ELLICOTT CITY, MD 21043
 PERMITS (410)313-2455 INSPECTIONS (410)313-1810
 AUTOMATED INFORMATION (410) 313-3800

HOWARD COUNTY
PERMIT APPLICATION

PERMIT NUMBER
B00134278

Building Address 12707 Maryvale Ct.
Clarksville, MD 21029

Suite /Ap t.#: na SDP/WP/ P etition #: GP-02-24

Census Tract 6030 Subdivision Second Discovery

Section na Area na Lot 16

Tax Map 22 Parcel 45 Grid 17

Zoning RDEO Map Coordinates 11X1 Lot size _____

Property Owner's Name Patriot Homes

Address P.O.Box 1018

City Columbia State MD Zip Code 21044

Home Phone _____ Work Phone 410-977-5522

Applicant's Name & Mailing Address, (if other than stated hereon):
Building Permit Services, Inc. - Pat Orla
7806 Deboy Ave., Balto., MD 21222

Phone 410-477-9666 Fax 410-477-8437

Existing Use Vacant Lot

Proposed Use SFD

Estimated Construction Cost \$ 200,000.00

Description of Work Const.custom SFD
2sty,fin. bsmt, R,5FB,2HB,3car gar.2FP(5Br)

Contractor Company Patriot Homes

Contact Person Cindy Huntzberry/ Rick Kunkle

Address _____

City _____ State _____ Zip Code _____

License No. MHBR# 177

Phone _____ Fax _____

Occupant or Tenant _____

Engineer or Architect Company _____

Contact Name _____

Contact Person _____

Address _____

Address _____

City _____ State _____ Zip Code _____

City _____ State _____ Zip Code _____

Phone _____ Fax _____

Phone _____ Fax _____

BUILDING DESCRIPTION - COMMERCIAL **BUILDING DESCRIPTION - RESIDENTIAL**

BUILDING CHARACTERISTICS		UTILITIES	
Height: _____	Water Supply: <input type="checkbox"/> Public <input type="checkbox"/> Private	SF Dwelling <input checked="" type="checkbox"/> SF Townhouse <input type="checkbox"/>	Water Supply: <input type="checkbox"/> Public <input checked="" type="checkbox"/> Private
No. of stories: _____	Sewage Disposal: <input type="checkbox"/> Public <input type="checkbox"/> Private	Depth _____ Width _____	Sewage Disposal: <input type="checkbox"/> Public <input checked="" type="checkbox"/> Private
Gross area, sq. ft. per floor: _____	Electric Yes <input type="checkbox"/> No <input type="checkbox"/>	Basement: _____	Electric Yes <input checked="" type="checkbox"/> No <input type="checkbox"/>
Use group _____	Gas Yes <input type="checkbox"/> No <input type="checkbox"/>	Finished Basement <input checked="" type="checkbox"/> Unfinished Basement <input type="checkbox"/>	Gas Yes <input type="checkbox"/> No <input type="checkbox"/>
Construction type: <input type="checkbox"/> Reinforced Concrete <input type="checkbox"/> Structural Steel <input type="checkbox"/> Masonry <input type="checkbox"/> Wood Frame	Heating System: <input type="checkbox"/> Electric <input type="checkbox"/> Oil <input type="checkbox"/> <input type="checkbox"/> Natural Gas <input type="checkbox"/> <input type="checkbox"/> Propane Gas <input type="checkbox"/>	Crawl space <input type="checkbox"/> Slab on Grade <input type="checkbox"/>	Heating System: <input type="checkbox"/> Electric <input type="checkbox"/> Oil <input type="checkbox"/> <input checked="" type="checkbox"/> Natural Gas <input type="checkbox"/> <input type="checkbox"/> Propane Gas <input type="checkbox"/>
<input type="checkbox"/> State Certified Modular	Sprinkler system: <u>N/A</u> <input type="checkbox"/>	No. of Bedrooms <u>5</u>	Sprinkler system: <u>N/A</u> <input type="checkbox"/>
	<input type="checkbox"/> Full <input type="checkbox"/> Partial <input type="checkbox"/> Other Suppression <input type="checkbox"/> # of Heads _____	Multi-family dwellings: No. of efficiency units: _____ No. of 1 BR units: _____ No. of 2 BR units: _____ No. of 3 BR units: _____	Dimensions: _____ Footings: _____ Roof: _____
		<input type="checkbox"/> State Certified Modular <input type="checkbox"/> Manufactured Home	<input type="checkbox"/> NFA # 13D <input type="checkbox"/> NFPA # 13R <input type="checkbox"/> Other: _____

THE UNDERSIGNED HEREBY CERTIFIES AND AGREES AS FOLLOWS: (1) THAT HE/SHE IS AUTHORIZED TO MAKE THIS APPLICATION; (2) THAT THE INFORMATION IS CORRECT; (3) THAT HE/SHE WILL COMPLY WITH ALL REGULATIONS OF HOWARD COUNTY WHICH ARE APPLICABLE HERETO; (4) THAT HE/SHE WILL PERFORM NO WORK OTHER THAN THAT REFERENCED IN THIS APPLICATION; (5) THAT HE/SHE GRANTS COUNTY OFFICIALS THE RIGHT TO ENTER ONTO THIS PROPERTY FOR THE PURPOSE OF INSPECTING THE WORK PERMITTED AND POSTING NOTICES.

Applicant's Signature [Signature] Agent

Building Permit Services, Inc. - Pat Orla

Print Name Pat Orla

Date 2/11/02

Title/Company _____

Checks payable to: **DIRECTOR OF FINANCE OF HOWARD COUNTY**
 ** PLEASE WRITE NEATLY AND LEGIBLY. **
 - FOR OFFICE USE ONLY -

AGENCY	DATE	SIGNATURE APPROVAL	DPZ SETBACK INFORMATION	PROPERTY ID#:
Land Development DPZ			Front: _____	522102
State Highways			Rear: _____	
Building Official			Side: _____	
Dev. Engineering DPZ	<u>3/29/02</u>	<u>Mark Kiffin</u>	Side St.: _____	
Health			All minimum setbacks met? YES <input type="checkbox"/> NO <input type="checkbox"/>	Filling fee \$100.00
Fire Protection			Is Entrance Permit required? YES <input type="checkbox"/> NO <input type="checkbox"/>	Permit fee \$
Is Sediment Control approval required prior to issuance? YES <input type="checkbox"/> NO <input type="checkbox"/>			Historic District? YES <input type="checkbox"/> NO <input type="checkbox"/>	Excise tax \$
			Lot Coverage for New Town Zone _____	Subtotal paid \$100.00
			SDP/Red-line, approval date _____	Add'l permit fee \$
			Accepted by <u>[Signature]</u>	TOTAL FEES \$
				Balance due \$
				Check #6455
				Validation #111111

CONTINGENCY CONSTRUCTION START:

ONE STOP SHOP:

Distribution of Copies - Write: Building Official Green: LDD, DPZ Yellow: DED, DPZ Pink: Health Gold: SHA

a:\permit.frm Rev. 10/15/98

G00007673