

# APPLICATION

*Jim Carter*  
*Backhoe*  
*2-26-87*  
*9:30 AM*

*WED MARCH 4<sup>th</sup>*  
*10 AM +*

PERCOLATION TESTING

A 38444

P \_\_\_\_\_

DISTRICT 3RD

DATE 1-5-87

HOWARD COUNTY HEALTH DEPARTMENT  
BUREAU OF ENVIRONMENTAL HEALTH  
P.O. BOX 476 ELLICOTT CITY, MARYLAND 21043  
TELEPHONE: 461-9933

*All update*  
*PATRICK Schuman called*  
*w/ th dates*  
*ok to process*  
*OK*

*Check 702670*  
*LEADS FED. S.M.U.*

TO: THE COUNTY HEALTH OFFICER  
ELLICOTT CITY, MARYLAND

I, HEREBY, APPLY FOR THE NECESSARY TEST IN ORDER TO CONSTRUCT (OR RECONSTRUCT) A SEWAGE DISPOSAL SYSTEM.

DEVELOPER RON OLINGER  
PROPERTY OWNER \_\_\_\_\_

ADDRESS 4110 LEEDS AVENUE - BALTO. MD. 21229 PHONE 301-247-8158  
382-4987

PROSPECTIVE BUYER \_\_\_\_\_

ADDRESS \_\_\_\_\_ PHONE \_\_\_\_\_

PROPERTY LOCATION:

SUBDIVISION SWIFT PROPERTY LOT NO. 1, ~~1~~

ROAD AND DESCRIPTION NORTHEAST INTERSECTION - MARRIOTTSTVILLE ROAD &  
OLD FREDERICK ROAD (MD. ROUTE 99)

TAX MAP 10 PARCEL # 255

SIZE OF LOT 3 AC ± TYPE BLDG. SINGLE FAMILY - DETACHED  
(SINGLE FAMILY DWELLING OR COMMERCIAL)

THE SYSTEM INSTALLED UNDER THIS APPLICATION IS ACCEPTABLE ONLY UNTIL PUBLIC FACILITIES BECOME AVAILABLE. I FULLY UNDERSTAND THE FEE CONNECTED WITH THE FILING OF THIS PERC TEST APPLICATION IS NON-REFUNDABLE UNDER ANY CIRCUMSTANCES. I ALSO AGREE TO COMPLY WITH ALL M.O.S.H.A. REQUIREMENTS IN TESTING THIS LOT.

*Ronald W. Olinger*  
(SIGNATURE OF APPLICANT)

APPROVED BY \_\_\_\_\_ FOR \_\_\_\_\_ DATE \_\_\_\_\_

REJECTED BY \_\_\_\_\_ FOR \_\_\_\_\_ DATE \_\_\_\_\_


HOLD PENDING FURTHER TESTS \_\_\_\_\_ DATE \_\_\_\_\_

REASONS FOR REJECTION OR HOLDING 3-4-87 PERC SATISFACTORY HOLD FOR PLAT. S.M.U.

# THIS IS NOT A PERMIT

① ② ③ ④  
SOIL PROFILE

0"	AD
9"	Yellow Br silt loam 9-12% clay <10% frags
4"	Yellow Br TD tan silt loam 15-20% frags
12-0	

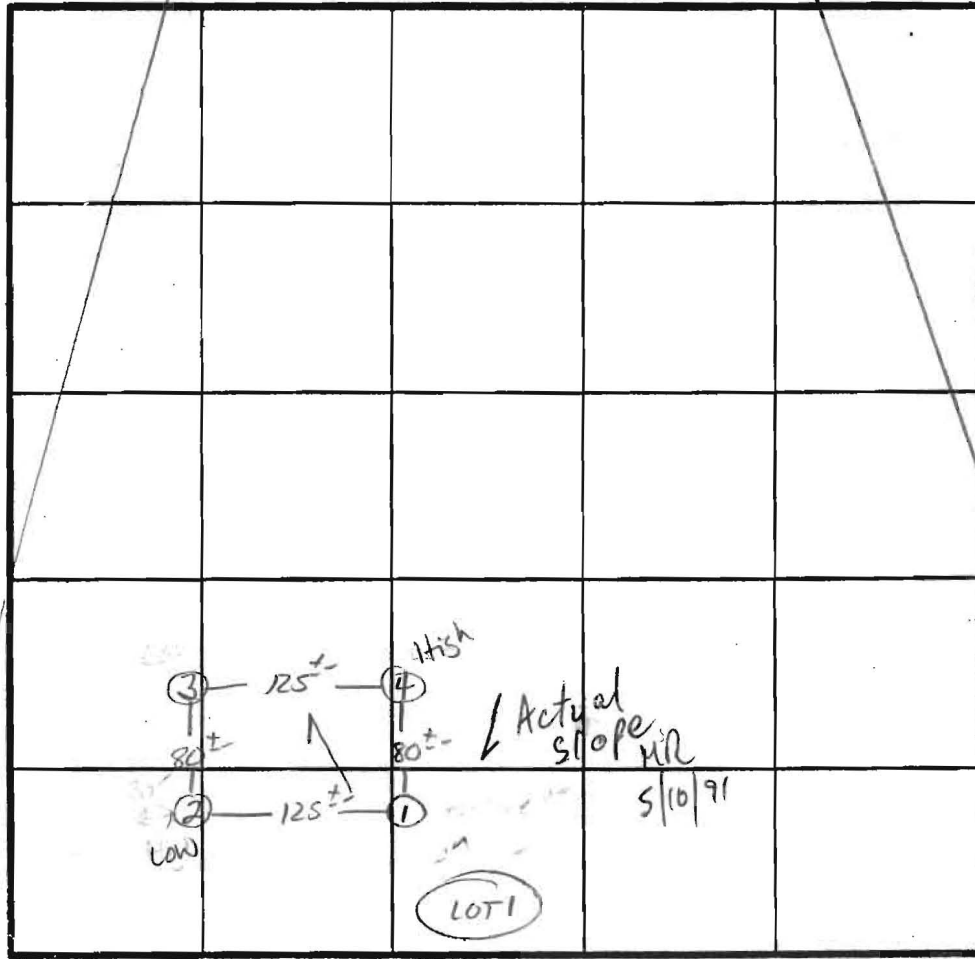

$\bar{x}$  Perc 12min

2.10  $\phi$  / BR  
Inlet 4"  
Bottom 9"  
Repairs  
Bottom 6"

INDICATE NORTH - NAME ADJOINING ROADWAY AS BASE LINE.

MARKIOTTSVILLE Rd.

DATE	TEST NO.	DEPTH	PRE-WET		TEST - 1" DROP		TIME
			START	STOP	START	STOP	
2/26/87	1 S	5"	12:42	12:45	12:45	12:55	10min
	2 S	12"	UNIFORM SOIL below 4"		4"		
	3 S	4.5"	12:59	1:04	1:04	1:17	13min
	4 S	12"	UNIFORM SOIL below 4"		4"		
	3 V	12"	UNIFORM SOIL below 4"		4"		
	4 S	5"	12:48	12:55	12:55	1:15	20min
	4 M	8.5"	12:48	12:51	12:51	12:58	7min
	4 V	13"	UNIFORM SOIL below 4"		4"		

REMARKS Holes Per Plant / Shallow Syst. Repairs  
 TYPE OF SOIL Glendy  
 TESTED BY S. Abel ALSO PRESENT J. Cantor

EH-12-1079

