

PUB. SEWER STATUS VERIFIED BY _____

ISSUE DATE: _____

APPROVAL DATE: _____

PERMIT INDEXED

P _____

A 517962-G

ON-SITE SEWAGE DISPOSAL SYSTEM HOWARD COUNTY HEALTH DEPARTMENT BUREAU OF ENVIRONMENTAL HEALTH

01-308786

IS PERMITTED TO INSTALL ALTER

ADDRESS: _____ PHONE NUMBER: _____

SUBDIVISION: _____ LOT NUMBER: _____

ADDRESS: 691 Long Corner Road PROPERTY OWNER: ^{ROBERT G.} Anderson

SEPTIC TANK CAPACITY (GALLONS): _____

PUMP CHAMBER CAPACITY (GALLONS): _____

NUMBER OF BEDROOMS: 3

SQUARE FEET PER BEDROOM: _____

LINEAR FEET OF TRENCH REQUIRED: _____

TRENCHES:	Trench to be _____ feet wide. Inlet _____ feet below original grade. Bottom maximum depth _____ feet below original grade. Effective area begins at _____ feet below original grade. _____ feet of stone below distribution pipe.
LOCATION:	
PURPOSE:	Existing septic system has failed. Call for inspection when ground is opened so sanitarian can recommend repair.

PLANS APPROVED: _____ DATE: _____

- NOTE: PERMIT VOID AFTER 2 YEARS
- NOTE: CONTRACTOR RESPONSIBLE FOR SCHEDULING A PRE-CONSTRUCTION INSPECTION FOR ALL INSTALLATIONS
- NOTE: WATERTIGHT SEPTIC TANKS REQUIRED
- NOTE: ALL PARTS OF SEPTIC SYSTEM SHALL BE 100 FEET FROM ANY WATER WELL
- NOTE: MANHOLE RISERS REQUIRED ON ALL SEPTIC TANKS AND PUMP CHAMBERS

NEITHER THE HOWARD COUNTY COUNCIL NOR THE HEALTH DEPARTMENT IS RESPONSIBLE FOR THE SUCCESSFUL OPERATION OF ANY SYSTEM PERMITTEE RESPONSIBLE FOR OBTAINING FINAL APPROVAL ON THIS PERMIT CALL 410-313-2640 FOR INSPECTION OF SEPTIC SYSTEM

BUILDING PERMIT SIGNED AND RETURNED

5/15/03 800141875 - ADD 1 BATH ROOM

4 511962G

7/24/64

PERMIT

Approved 7/20/64
WLD

P. 08312
A. 07252

SEWAGE DISPOSAL SYSTEM

MARYLAND STATE DEPARTMENT OF HEALTH

HOWARD COUNTY

ELLICOTT CITY

INDEXED

DISTRICT 4

DATE 4/23/66

Norman Sirk IS PERMITTED TO INSTALL X ALTER

ADDRESS Arundelle Rock Rd., Woodbine, Maryland PHONE EE 9-4724

A SEWAGE DISPOSAL SYSTEM LOCATED AT _____

SUBDIVISION _____ ROAD 691 Long Corner Rd LOT _____

PROPERTY OWNER Robert H. Anderson

ADDRESS Rt. 3 - Mt. Airy, Maryland N. A. 37984 Long Corner Rd 1/2 mile from Rt 144 on left.

SPECIFICATIONS 3 bedrooms

DRAIN FIELD _____ DEPTH _____ FEET, BOTTOM AREA _____ SQ. FT.

SEEPAGE PITS _____ ABSORBENT SIDE-WALL AREA _____ SQ. FT. let pipe 150' x 50'

SEPTIC TANK CAPACITY 750 GALLONS

FOR GARBAGE GRINDER, INCREASE DISPOSAL AREA 25% & TANK CAPACITY 50%.

OTHER Dry Well - 425 sq. ft. absorbent side wall area to begin below inlet pipe, ex. one dry well 14 ft. diameter tank and 10 ft. deep below the inlet pipe - 12 ft. concrete top with one ft. gravel, or 2 dry wells each to be 9 ft. diameter and 8 ft. deep below inlet pipe. Place dry wells about 45 ft. from front lot line and about 99 ft. from left side as you face from Long Corner Rd. If 2 dry wells are used place each dry well about 45 ft. from front lot line with one dry well about 84 ft. from left side line and other dry well about 114 ft. from left side. Dry wells must be at least 27 ft. apart edge to edge.


PLANS APPROVED BY Donald W. Monaghan DATE 8/9/63

FILL SEPTIC TANK AND DISTRIBUTION BOX WITH WATER BEFORE CALLING FOR AN INSPECTION. COVER NO WORK UNTIL INSPECTED AND APPROVED.

NEITHER THE HOWARD COUNTY COMMISSIONERS NOR THE HEALTH DEPARTMENT IS RESPONSIBLE FOR THE SUCCESSFUL OPERATION OF ANY SYSTEM.

A 072522

A 07252

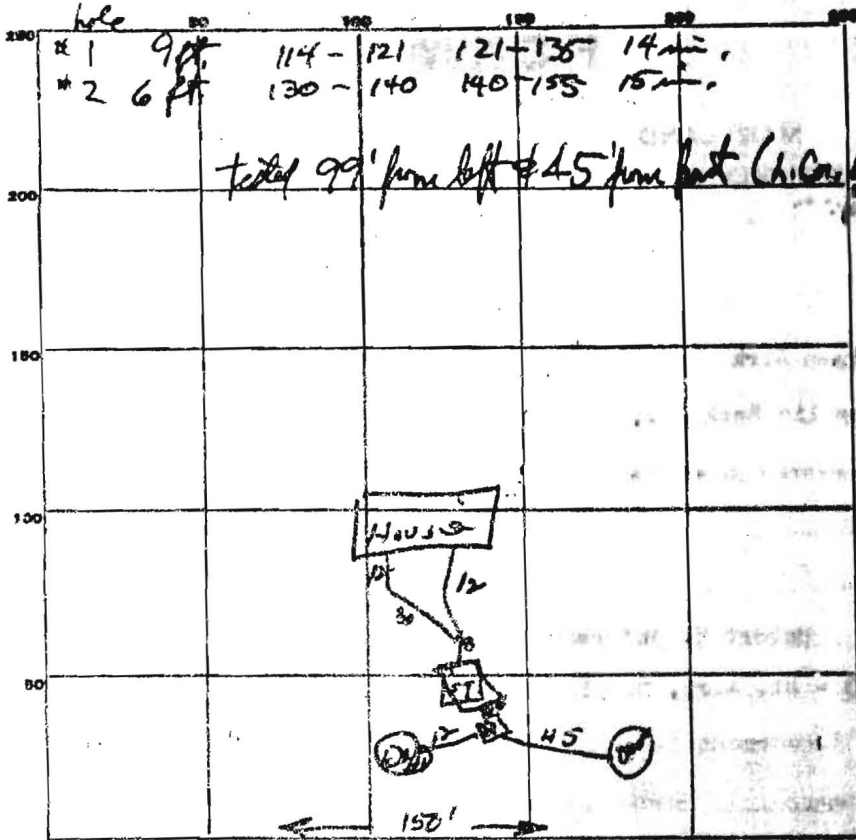

37.64
 814

 188
 3008

 319.6

3.10
 11

 314
 314

 545
 2

 2760

INDICATE NORTH. NAME ADJOINING ROADWAY AS BASE LINE.

Long Corn Road

PERMIT CARD OK

SEPTIC TANK, LEVEL OK

CLEANOUTS OK

DISTRIBUTION BOX, LEVEL OK

TILE FIELD, DEPTH _____ FT. TRENCH WIDTH _____ FT.

GRAVEL DEPTH _____ IN. TOTAL LENGTH _____ FT.

NUMBER OF TRENCHES _____ TOTAL BOTTOM AREA _____

SEEPAGE PITS, INSIDE DIAMETER _____ FT. DEPTH BELOW INLET _____ FT.

ABSORBENT AREA _____ SQ. FT.

REMARKS 7/6/64 - DW #1 Vertical to horizontal diameter is 12 ft x 8 1/2" depth = 319.6 sq ft / 1595 sq ft
 DW #2 " " " " 11 ft x 8 " - 276 sq ft / 760 sq ft

DATE SYSTEM APPROVED 7/6/64

INSPECTOR *[Signature]*