


AVP
B01
 Brown loam 1'
 Yellow Brown Silty clay loam 2'
 Red Brown Silty loam 5'
 Yellow Brown Silty loam 1 1/2'
 Silty loam 13'

B02
 Brown loam 4'
 Yellow Brown Silty clay loam 4'
 Red Brown Silty loam 10'

B01
 Brown loam 1'
 Yellow Brown Silty clay loam 3'
 Red Brown Silty loam 6'
 Silty loam 11'

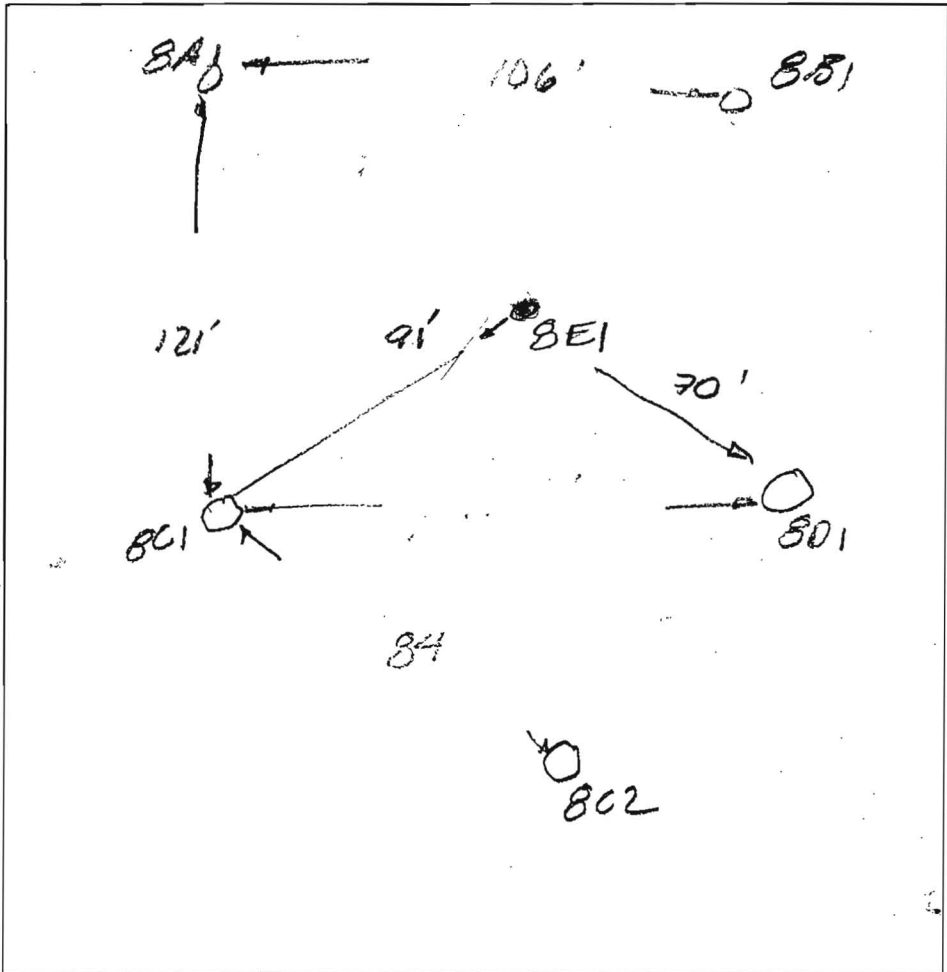

B01
 Brown loam 6"
 Yellow Brown Silty clay loam 4'
 Red Brown Silty loam 5'
 Red Brown Silty loam 13'

B04
 Brown loam 1 1/2'
 Red Brown Silty clay loam 5'
 Yellow Brown Red Brown Silty loam 11'
 platy mic 12'


B01
 Brown loam 1'
 Red Brown Silty clay loam 4 1/2'
 Red Brown Silty loam 10'

DATE	TEST #	DEPTH	START	BREAK 1" DROP	STOP 2" DROP	TIME OF 2nd INCH	P/F/H	
12/9/12	B01	6' / 13'	9:34	9:40	9:46	6min	P	
	B02	10'	NOT TESTED BECAUSE OF HIGH WATER TABLE					F
	B01	7' / 12'	8:43	9:49	9:57	8min	P	
	B01	6 1/2' / 13'	9:49	9:54	9:59	5min	P	
	B01	6 1/2' / 12'	10:10	10:14	10:19	5min	P	
	B01	5' / 10'	10:32	10:40	10:49	9min	P	

REMARKS _____
 SANITARIAN _____ BACKHOE SHOUBEN OTHERS MARK DANSON, DALE JOHNSON, BOB SWEESLEY
 TEST HOLES USED IN SDA _____ AVG. PERC TIME _____ SQ. FT/BR _____
 TRENCH WIDTH _____ INLET DEPTH _____ MAX. BOT DEPTH _____ EFFECTIVE SW _____

AP
 8D
 Brown
 loam
 1'
 Brown
 Salcom
 7'
 WATER
 COMING
 IN @
 7'
 12 1/2'

8A
 Brown
 loam
 1 1/2'
 Red
 Brown
 Salcom
 5'
 Yellow
 Brown
 Salcom
 12'
 WATER
 13'

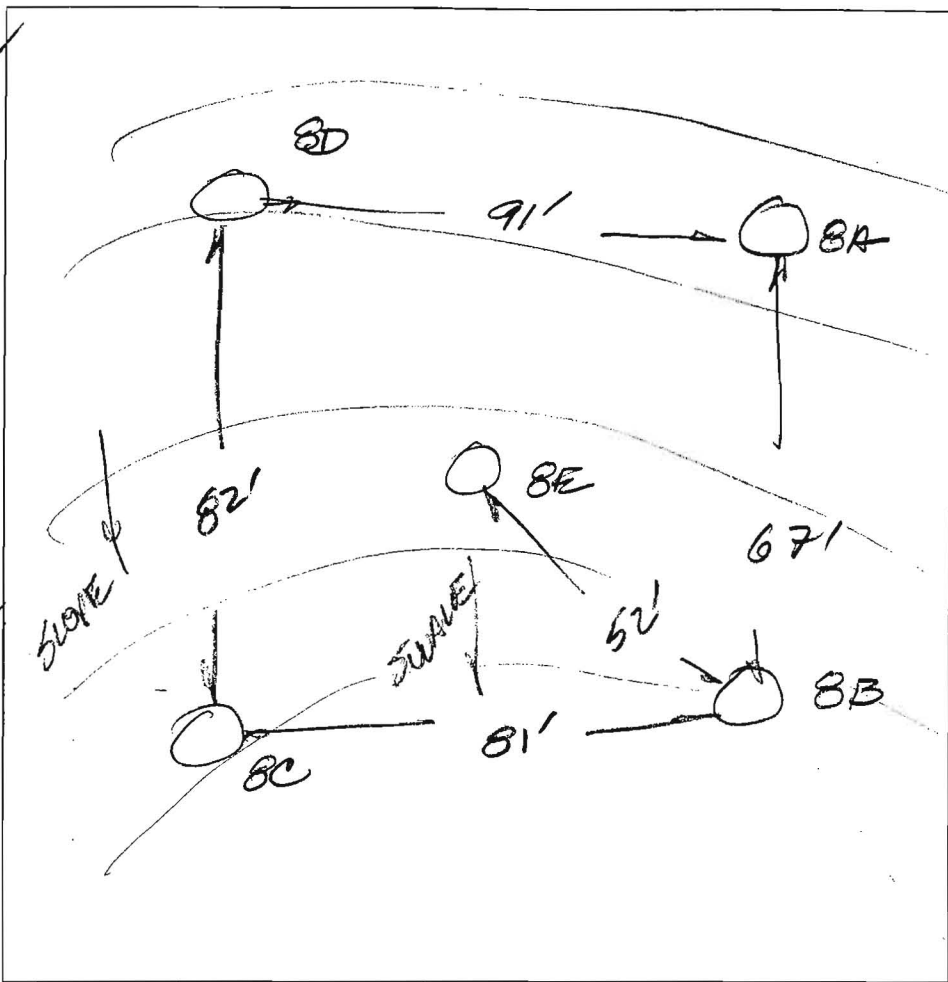

DATE	TEST #	DEPTH	START	BREAK 1" DROP	STOP 2" DROP	TIME OF 2nd INCH	P/F/H
10/22/03	8B	3' / 12 1/2'	10:49	10:51	10:53	2min	F
10/22/03	8A	5' / 13'	11:07	11:08	11:10	2min	F
	8E NOT TESTED BECAUSE OF SWALE. WATER @ 11'						
	8C	WATER @ 10'; NOT TESTED PER BS					F
	8D NOT TUG PER BS						

REMARKS _____
 SANITARIAN FA/BB BACKHOE WILLIE OTHERS Dale Johnson, Bob Shastley, Mark Johnson
 TEST HOLES USED IN SDA _____ AVG. PERC TIME _____ SQ. FT/BR _____
 TRENCH WIDTH _____ INLET DEPTH _____ MAX. BOT DEPTH _____ EFFECTIVE SW _____

