

PUB. SEWER STATUS VERIFIED BY _____

ISSUE DATE: 05/18/05

P 522483

APPROVAL DATE: 6/10/05

A 522483-REPAIR

PERMIT
INDEXED
03297497

ON-SITE SEWAGE DISPOSAL SYSTEM
HOWARD COUNTY HEALTH DEPARTMENT
BUREAU OF ENVIRONMENTAL HEALTH

Fyock Septic Service IS PERMITTED TO INSTALL ALTER

ADDRESS: PO Box 89, Glenelg PHONE NUMBER: 410-988-9270

SUBDIVISION: _____ LOT NUMBER: _____

ADDRESS: 4880 Manor Lane PROPERTY OWNER: Joe Thompson

SEPTIC TANK CAPACITY (GALLONS): 1250

PUMP CHAMBER CAPACITY (GALLONS): —

NUMBER OF BEDROOMS: 4

SQUARE FEET PER BEDROOM: 210

LINEAR FEET OF TRENCH REQUIRED: 118'

TRENCHES:	Trench to be <u>3</u> feet wide. Inlet <u>5</u> feet below original grade. Bottom maximum depth <u>9</u> feet below original grade. Effective area begins at <u>5</u> feet below original grade. <u>4</u> feet of stone below distribution pipe.
LOCATION:	
PURPOSE:	Existing septic system has failed. Call for inspection when ground is opened so sanitarian can recommend repair.


PLANS APPROVED: [Signature] DATE: 5/26/05

- NOTE: PERMIT VOID AFTER 2 YEARS
- NOTE: CONTRACTOR RESPONSIBLE FOR SCHEDULING A PRE-CONSTRUCTION INSPECTION FOR ALL INSTALLATIONS
- NOTE: WATERTIGHT SEPTIC TANKS REQUIRED
- NOTE: ALL PARTS OF SEPTIC SYSTEM SHALL BE 100 FEET FROM ANY WATER WELL
- NOTE: MANHOLE RISERS REQUIRED ON ALL SEPTIC TANKS AND PUMP CHAMBERS

NEITHER THE HOWARD COUNTY COUNCIL OR THE HEALTH DEPARTMENT IS RESPONSIBLE FOR THE SUCCESSFUL OPERATION OF ANY SYSTEM PERMITTEE RESPONSIBLE FOR OBTAINING FINAL APPROVAL ON THIS PERMIT BUILDING PERMIT SIGNED Call 410-313-2640 FOR INSPECTION OF SEPTIC SYSTEM AND RETURNED

3/1/06 BOB 157212 - 2nd STORY ADDITION
6/8/06 BOB 16085 - TREE DECK
9/18/06 BOB 004070 - CG PROpane TANK

4522483

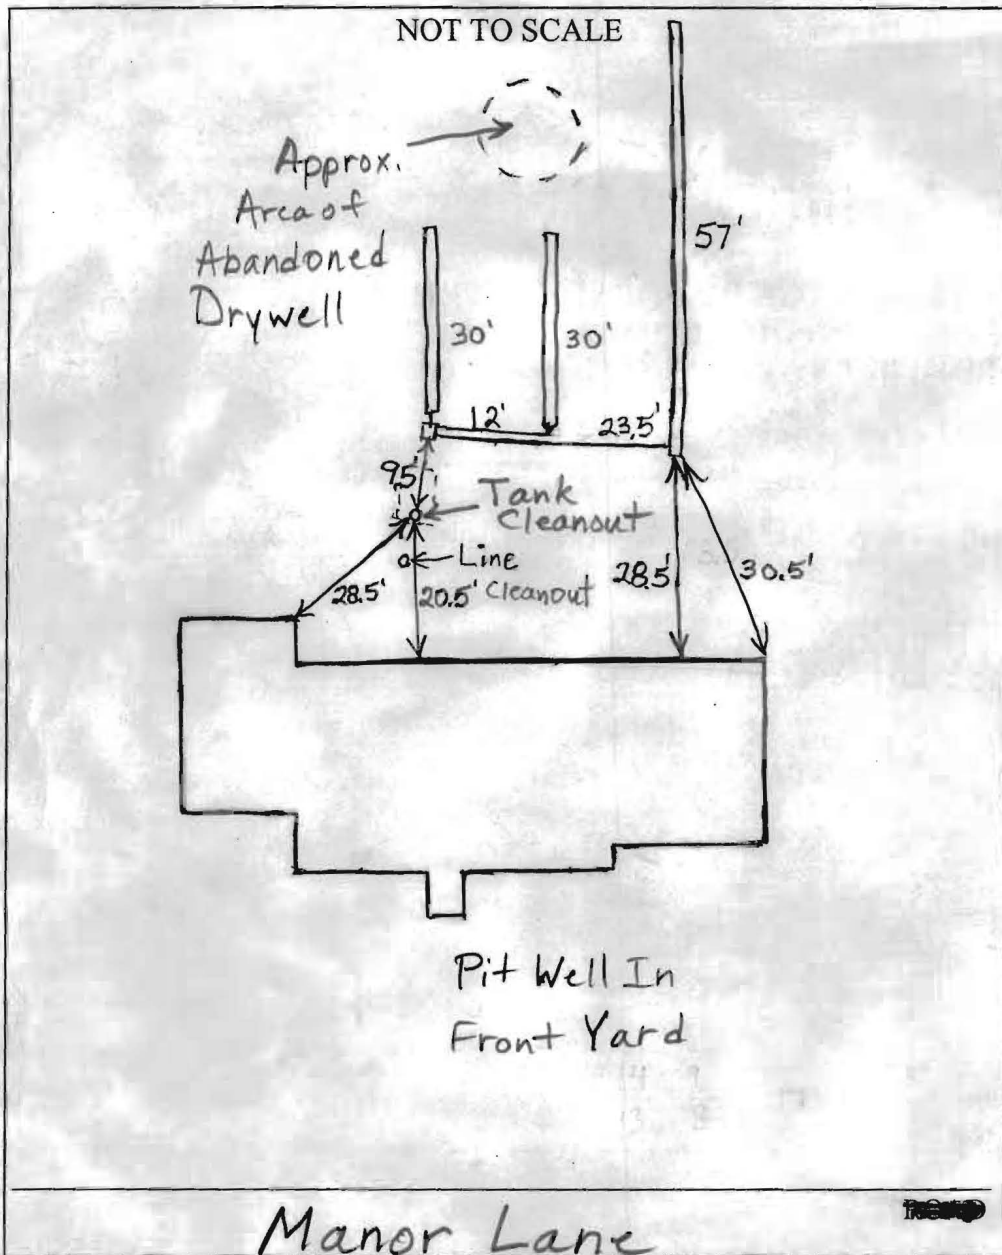

TRENCH/DRAINFIELD DATA		
WIDTH	INLET	BOTTOM
3'	5'-6'	9'-9.5'
NUMBER OF TRENCHES		3
TOTAL LENGTH		117'
ABSORPTION AREA		351 + Sidewall
DISTRIBUTION BOX LEVEL		Yes
DISTRIBUTION BOX BAFFLE		Yes
DISTRIBUTION BOX PORT		No

SEPTIC TANK DATA	
SEPTIC TANK 1 LEVEL	
CAPACITY	Existing GAL
SEAM LOC	Middle
TANK LID DEPTH	1'
BAFFLES	Yes
BAFFLE FILTER	No
MANHOLE LOC	None
6" PORT LOC	Front
WATERTIGHT TEST	No
SEPTIC TANK 2 LEVEL N/A	
CAPACITY	_____ GAL
SEAM LOC	_____
TANK LID DEPTH	_____
BAFFLES	_____
BAFFLE FILTER	_____
MANHOLE LOC	_____
6" PORT LOC	_____
WATERTIGHT TEST	_____

PRE-CONSTRUCTION 6/10/05

INSTALLATION 6/10/05 Old drywell pumped out and filled with dirt per Robert Fryock. Robert dug 57' trench too deep. Only 3.5' of buffer above water. Still new system is shallower than old drywell. O.K. to backfill. (BB)

BUILDING PERMITSIGNED AND RETURNED

FINAL INSPECTOR B. Baker

DATE OF APPROVAL 6/10/05

5/26/05 - Homeowner originally said its
a 3 bedroom house. (E)

5/27/05 - T/c from Skip, now homeowner is
saying its 4 bedrooms (E)