

PUB. SEWER STATUS VERIFIED BY _____

ISSUE DATE: 3/19/08

P 528451

PERMIT

APPROVAL DATE: _____

A REPAIR

Tax ID # 01-181718

ON-SITE SEWAGE DISPOSAL SYSTEM HOWARD COUNTY HEALTH DEPARTMENT BUREAU OF ENVIRONMENTAL HEALTH

David Errera IS PERMITTED TO INSTALL ALTER

ADDRESS: 16027 Dorset Road, Laurel MD 20707 PHONE NUMBER: 301-776-3413

SUBDIVISION: _____ LOT NUMBER: _____

ADDRESS: 6195 Lawyers Hill Road PROPERTY OWNER: David Errera

SEPTIC TANK CAPACITY (GALLONS): 1500 2 comp T.S.

PUMP CHAMBER CAPACITY (GALLONS): N/A

NUMBER OF BEDROOMS: 4 (3 existing & 1 proposed)

SQUARE FEET PER BEDROOM: 1.2

LINEAR FEET OF TRENCH REQUIRED: 138 (2/69')

TRENCHES:	Trench to be 3 feet wide. Inlet ⁴ feet below original grade. Bottom maximum depth <u>9.5</u> feet below original grade. Effective area begins at <u>8.5</u> feet below original grade. <u>5.5</u> feet of stone below distribution pipe.
LOCATION:	<u>Old Tank & Dry well to be properly abandoned</u> <u>New tank to be located 10' from proposed addition</u>
PURPOSE:	Existing septic system has failed. Call for inspection when ground is opened so sanitarian can recommend repair. <u>Lagout & Open trench insp. required prior to placing in stone</u>


PLANS APPROVED: Stuart Oster DATE: 3/19/08

- NOTE: PERMIT VOID AFTER 2 YEARS
- NOTE: CONTRACTOR RESPONSIBLE FOR SCHEDULING A PRE-CONSTRUCTION INSPECTION FOR ALL INSTALLATIONS
- NOTE: WATERTIGHT SEPTIC TANKS REQUIRED
- NOTE: ALL PARTS OF SEPTIC SYSTEM SHALL BE 100 FEET FROM ANY WATER WELL
- NOTE: MANHOLE RISERS REQUIRED ON ALL SEPTIC TANKS AND PUMP CHAMBERS

NEITHER THE HOWARD COUNTY COUNCIL OR THE HEALTH DEPARTMENT IS RESPONSIBLE FOR THE SUCCESSFUL OPERATION OF ANY SYSTEM PERMITTEE RESPONSIBLE FOR OBTAINING FINAL APPROVAL ON THIS PERMIT CALL 410-313-2640 FOR INSPECTION OF SEPTIC SYSTEM

NOT TO SCALE

Existing Tank clo → ○

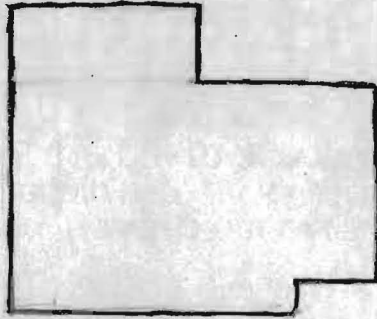

ROAD

TRENCH/DRAINFIELD DATA

WIDTH _____ INLET _____ BOTTOM _____

NUMBER OF TRENCHES _____

TOTAL LENGTH _____

ABSORPTION AREA _____

DISTRIBUTION BOX LEVEL _____

DISTRIBUTION BOX BAFFLE _____

DISTRIBUTION BOX PORT _____

SEPTIC TANK DATA

SEPTIC TANK 1 LEVEL _____

CAPACITY _____ GAL

SEAM LOC _____

TANK LID DEPTH _____

BAFFLES _____

BAFFLE FILTER _____

MANHOLE LOC _____

6" PORT LOC _____

WATERTIGHT TEST _____

SEPTIC TANK 2 LEVEL _____

CAPACITY _____ GAL

SEAM LOC _____

TANK LID DEPTH _____

BAFFLES _____

BAFFLE FILTER _____

MANHOLE LOC _____

6" PORT LOC _____

WATERTIGHT TEST _____

PRE-CONSTRUCTION 4/7/08 Install new tank 20' from house
and proposed addition. Install 2-69' trenches on
INSTALLATION contour. Trench locations staked in front
yard. (BB)

FINAL INSPECTOR _____ DATE OF APPROVAL _____