

APPLICATION

A 02511

SEWAGE DISPOSAL TESTING

F

MARYLAND STATE DEPARTMENT OF HEALTH

HOWARD COUNTY 750 Gullion Road ELLICOTT CITY

2 Dry Wells 8 ft in diameter
X 12 ft deep
DISTRICT 3
DATE 5/26/60

Place the Dry Wells about
30 ft to 70 ft from the side
of the house where the
perc test was run

TO: THE COUNTY HEALTH OFFICER
ELLICOTT CITY, MARYLAND

I HEREBY, APPLY FOR THE NECESSARY TESTS IN ORDER TO CONSTRUCT (OR RECONSTRUCT) A SEWAGE DISPOSAL SYSTEM.

PROPERTY OWNER Ways, William

ADDRESS Marriottsville PHONE Da. 82348

PROPERTY LOCATION:

SUBDIVISION _____ LOT NO. _____

ROAD AND DESCRIPTION Marriottsville Rd. 1 - 1 1/2 this side P.O. on right hand side
rd. going toward Marriottsville. White House

OCCUPANT 2nd one from post office on PHONE _____

PERSON TO CONSTRUCT SYSTEM a hill

ADDRESS _____ PHONE _____

SIZE OF LOT 4 acres TYPE BLDG. 4 NUMBER OF BEDROOMS

IF NOT SINGLE RESIDENCE DESCRIBE _____

SIGNATURE OF APPLICANT Harry P. Ways


APPROVED BY Raymond Hodges FOR Dry Well (KIND OF SYSTEM) DATE 5/1/60

REJECTED BY _____ FOR _____ (KIND OF SYSTEM) DATE _____

HOLD PENDING FURTHER TESTS _____ DATE _____

REASONS FOR REJECTION OR HOLDING _____

THIS IS NOT A PERMIT

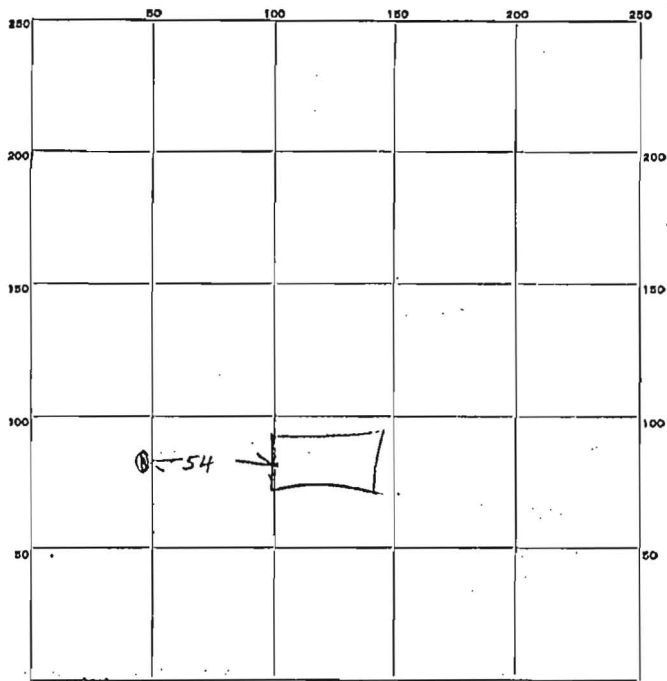

138
4
552

INDICATE NORTH. - NAME ADJOINING ROADWAY AS BASE LINE.

Marenottoville Rd

DATE	TEST NO.	DEPTH	PRE-WET		TEST - 1" DROP		TIME
			START	STOP	START	STOP	
5/1/50	1	8 1/2	122	129	129	143	14 min

SOIL AUGER FINDING. *Top 4' Clay bottom 4 1/2' sand packed sand*

TESTED BY *Raymond Hodges*

REMARKS _____

ALSO PRESENT *Harry Taylor* LOT NO. _____