

*File*

# PERMIT

SEWAGE DISPOSAL SYSTEM

MARYLAND STATE DEPARTMENT OF HEALTH

HOWARD COUNTY

INDEXED

P 02614  
A 02511

ELLICOTT CITY

DISTRICT 5

DATE 6/20/60

\_\_\_\_\_ IS PERMITTED TO INSTALL  ALTER \_\_\_\_\_  
ADDRESS Carl Williams PHONE Wm. 360-W-1  
W. Friendship

A SEWAGE DISPOSAL SYSTEM LOCATED AT \_\_\_\_\_  
1105 Maristown Rd. - 1 1/2 mi. S. of Maristown P.O.  
SUBDIVISION \_\_\_\_\_ ROAD \_\_\_\_\_ LOT \_\_\_\_\_

PROPERTY OWNER Wm. Wagon  
ADDRESS Maristown Md.

SPECIFICATIONS

DRAIN FIELD \_\_\_\_\_ DEPTH \_\_\_\_\_ FEET, BOTTOM AREA \_\_\_\_\_ SQ. FT.  
SEEPAGE PITS 2 ABSORBENT SIDE-WALL AREA 8x12 dry-wells SQ. FT.  
SEPTIC TANK CAPACITY 750 GALLONS

FOR GARBAGE GRINDER, INCREASE DISPOSAL AREA 22% & TANK CAPACITY 50%


OTHER Place dry-wells 30 to 70 ft  
from left side of house

PLANS APPROVED BY \_\_\_\_\_ DATE \_\_\_\_\_

FILL SEPTIC TANK AND DISTRIBUTION BOX WITH WATER BEFORE CALLING FOR AN INSPECTION. COVER NO WORK UNTIL INSPECTED AND APPROVED.

NEITHER THE HOWARD COUNTY COMMISSIONERS NOR THE HEALTH DEPARTMENT IS RESPONSIBLE FOR THE SUCCESSFUL OPERATION OF ANY SYSTEM.

A 02511

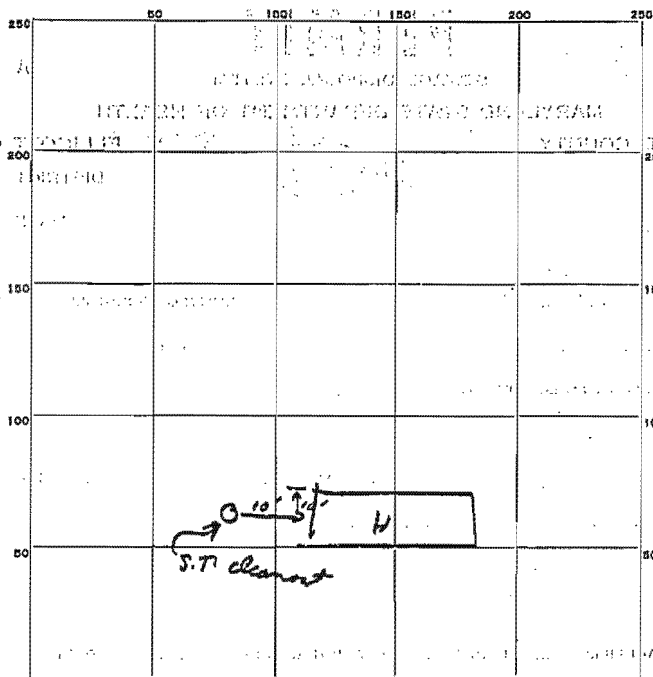

INDICATE NORTH - NAME ADJOINING ROADWAY AS BASE LINE.  
 NA Narrottsville Rd.

PERMIT CARD \_\_\_\_\_

SEPTIC TANK, LEVEL \_\_\_\_\_ CLEANOUTS \_\_\_\_\_

DISTRIBUTION BOX, LEVEL \_\_\_\_\_

TILE FIELD, DEPTH \_\_\_\_\_ FT. TRENCH WIDTH \_\_\_\_\_ FT.

GRAVEL DEPTH \_\_\_\_\_ IN. TOTAL LENGTH \_\_\_\_\_ FT.

NUMBER OF TRENCHES \_\_\_\_\_ TOTAL BOTTOM AREA \_\_\_\_\_

SEEPAGE PITS, INSIDE DIAMETER \_\_\_\_\_ FT. DEPTH BELOW INLET \_\_\_\_\_ FT.

ABSORBENT AREA \_\_\_\_\_ SQ. FT.

REMARKS: installed & in use; no

apparent problems

R.M. 1/31/79

DATE SYSTEM APPROVED \_\_\_\_\_ INSPECTOR \_\_\_\_\_