

# PERMIT

SEWAGE DISPOSAL SYSTEM

MARYLAND STATE DEPARTMENT OF HEALTH\*

HOWARD COUNTY

ELLICOTT CITY

DISTRICT 3rd

DATE 7/20/79

## INDEX

*9/16/82 approved*

*70333608*

P 30010

A 28681

*(SEE ALSO A22486)*

LAWRENCE RACHUBA

IS PERMITTED TO INSTALL  ALTER

ADDRESS 1650 Marriottville Rd, Marriottville, Md. PHONE 328-2518

SUBDIVISION \_\_\_\_\_ ROAD 1650 Marriottville Rd LOT \_\_\_\_\_

PROPERTY OWNER Lawrence Rachuba

ADDRESS same as above

### SPECIFICATIONS

SEPTIC TANK CAPACITY \_\_\_\_\_ GALLONS

DRAIN FIELD \_\_\_\_\_ DEPTH \_\_\_\_\_ FEET, BOTTOM AREA \_\_\_\_\_ SQ. FT.

DEEP TRENCH \_\_\_\_\_ DEPTH \_\_\_\_\_ FEET, BOTTOM AREA \_\_\_\_\_ SQ. FT.

SEEPAGE PITS \_\_\_\_\_ ABSORBENT SIDE-WALL AREA \_\_\_\_\_ SQ. FT.

INLET PIPE \_\_\_\_\_ FT. BELOW ORIGINAL GRADE. MAXIMUM DEPTH \_\_\_\_\_ FT. BELOW ORIGINAL GRADE

EFFECTIVE DEPTH AT \_\_\_\_\_ FT. BELOW ORIGINAL GRADE.

LOCATE DISPOSAL AREA \_\_\_\_\_ FT. FROM \_\_\_\_\_ LOT LINE AND \_\_\_\_\_ FT. FROM \_\_\_\_\_ LOT LINE AS SEEN WHEN FACING LOT FROM

BLDG. PERMIT SIGNED  
AND RETURNED 9/19/79  
*Serial No. 40935*

PLANS APPROVED BY \_\_\_\_\_ DATE \_\_\_\_\_

COVER NO WORK UNTIL INSPECTED AND APPROVED.

NEITHER THE HOWARD COUNTY COUNCIL NOR THE HEALTH DEPARTMENT IS RESPONSIBLE FOR THE SUCCESSFUL OPERATION OF ANY SYSTEM.

NOTE: IF TRENCH IS USED CALL FOR INSPECTION BEFORE PLACING GRAVEL IN TRENCH.

NOTE: NO DRY WELL SHALL EXCEED 15 FOOT IN DIAMETER.

NOTE: ALL PIPE FROM HOUSE TO DISPOSAL AREA MUST BE CAST IRON.

PERMIT VOID AFTER THREE YEARS.

NOTE: INSTALL STAND PIPE ON SEPTIC TANK AND DRY WELL. STAND PIPES MUST BE 6 INCHES IN DIAMETER. CAST IRON, CONCRETE OR TERRA COTTA ACCEPTED.


**\*INSTALLER IS RESPONSIBLE FOR OBTAINING FINAL APPROVAL ON THIS PERMIT.**

BLDG. PERMIT SIGNED  
AND RETURNED 11/15/79

*Serial # 41838*  
*(Swimming pool)*

*28681*

BLDG. PERMIT SIGNED  
AND RETURNED 7/17/87  
*to gauge #160044*

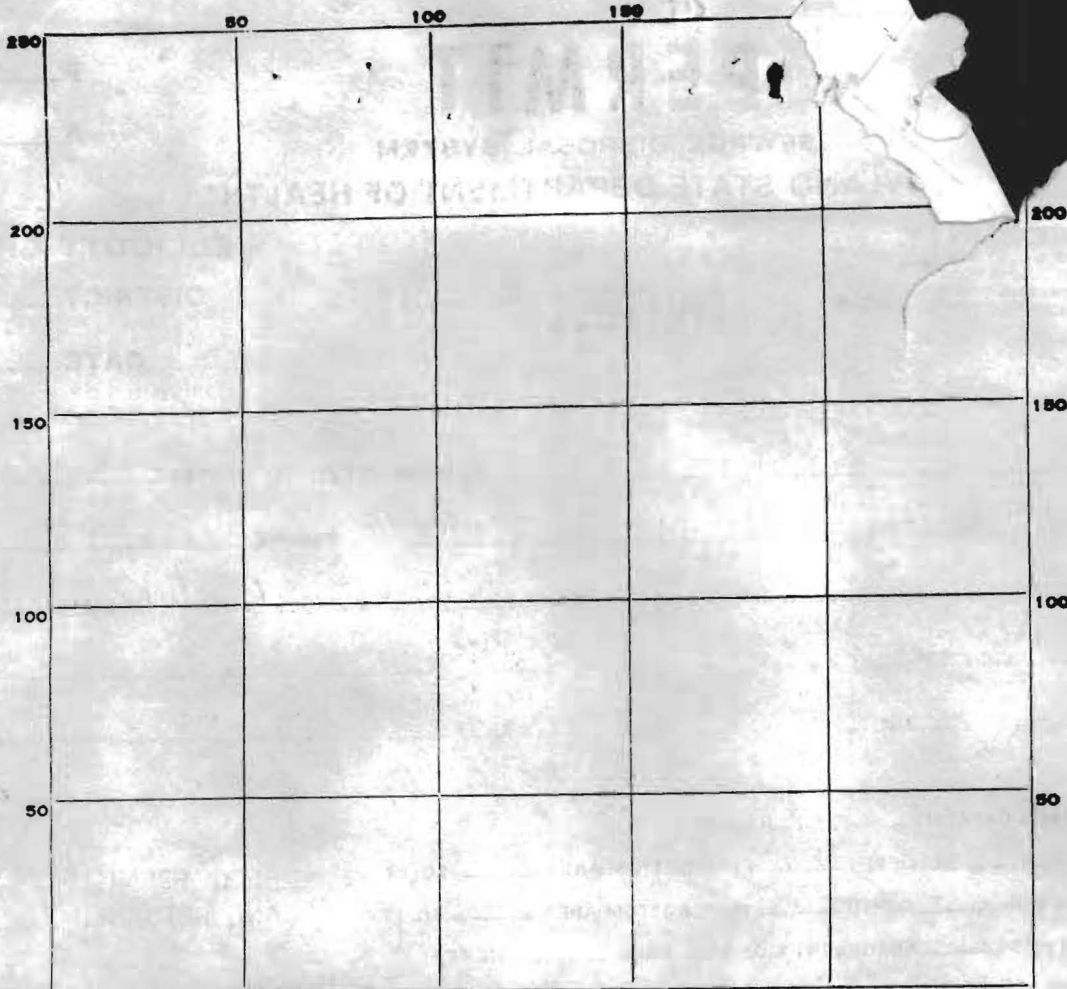

INDICATE NORTH. - NAME ADJOINING ROADWAY AS BASE LINE.

PERMIT CARD \_\_\_\_\_

SEPTIC TANK, LEVEL \_\_\_\_\_

CLEANOUTS \_\_\_\_\_

DISTRIBUTION BOX, LEVEL \_\_\_\_\_

TILE FIELD, DEPTH \_\_\_\_\_ FT. TRENCH WIDTH \_\_\_\_\_ FT.

GRAVEL DEPTH \_\_\_\_\_ IN. TOTAL LENGTH \_\_\_\_\_ FT.

NUMBER OF TRENCHES \_\_\_\_\_ TOTAL BOTTOM AREA \_\_\_\_\_

SEEPAGE PITS, INSIDE DIAMETER \_\_\_\_\_ FT. DEPTH BELOW INLET \_\_\_\_\_ FT.

ABSORBENT AREA \_\_\_\_\_ SQ. FT.

REMARKS 9/13/79 BLOCK IN DISTRIBUTION BOXES AND PIPES CEMENTED  
 OK TO COVER TO 2' OF ENDS OF PIPES COMING FROM  
 SEPTIC TANKS APPROXIMATELY 18' FROM SEPTIC TANKS,  
 10' FROM CLEANOUT CLOSEST TO HOUSE SITE  
 CALL FOR FINAL WHEN HOUSE CONNECTIONS MADE  
 TO EXISTING PIPES C.B.S.

6/5/80 HOUSE SEWER APPEARS TO BE COVERED &  
 MAN HOLES NOT TO GRADE RH

DATE SYSTEM APPROVED 9/16/82

INSPECTOR F. Shinn per ltr of 6/9/80

SEPTIC SYSTEM TO BE INSTALLED FIRST BEFORE BUILDING PERMIT CAN BE SIGNED.

MAIN HOUSE

# PERMIT

P 30010

A 28681

SEWAGE DISPOSAL SYSTEM

MARYLAND STATE DEPARTMENT OF HEALTH

HOWARD COUNTY

ELLICOTT CITY

DISTRICT 8RD

DATE 7/20/79

9/5/79  
9/10/79 first  
12

Lawrence Rachuba

IS PERMITTED TO INSTALL  ALTER

ADDRESS 1650 Marriottsville Road, Marriottsville, Md. PHONE 328-2518

SUBDIVISION ROAD 1650 Marriottsville Rd. LOT

PROPERTY OWNER Lawrence Rachuba

ADDRESS same as above

SPECIFICATIONS 6 bedrooms

SEPTIC TANK CAPACITY 2500 GALLONS

DRAIN FIELD DEPTH FEET, BOTTOM AREA SQ. FT.

DEEP TRENCH DEPTH FEET, BOTTOM AREA SQ. FT.

SEEPAGE PITS ABSORBENT SIDE-WALL AREA SQ. FT.

INLET PIPE FT. BELOW ORIGINAL GRADE. MAXIMUM DEPTH FT. BELOW ORIGINAL GRADE

EFFECTIVE DEPTH AT FT. BELOW ORIGINAL GRADE.

LOCATE DISPOSAL AREA FT. FROM LOT LINE AND FT. FROM LOT LINE AS SEEN WHEN

FACING LOT FROM

TRENCH - 180 ft. long for a total absorbent side-wall area of 1,080 sq. ft. (one side only counted). NO TRENCH IS TO EXCEED 100 FEET IN LENGTH. Inlet at 5 ft. below original grade and maximum depth 13 ft. below original grade. Begin trench at a point 215 ft. from the existing right-of-way and 400 ft. from the corner or the existing barn measured along the right-of-way. Trenches shall run with the contour toward the left property line as seen from the right-of-way. Second trench shall be 20 ft. closer to the right-of-way. 8/29/79 Checked on trenches under driveway with D.W.M. of P.D.W.M. office before inspection. C.B.S.

PLANS APPROVED BY George L. Keller & Donald W. Monaghan DATE 9/20/78

COVER NO WORK UNTIL INSPECTED AND APPROVED.

NEITHER THE HOWARD COUNTY COUNCIL NOR THE HEALTH DEPARTMENT IS RESPONSIBLE FOR THE SUCCESSFUL OPERATION OF ANY SYSTEM.

NOTE: IF TRENCH IS USED CALL FOR INSPECTION BEFORE PLACING GRAVEL IN TRENCH.


NOTE: NO DRY WELL SHALL EXCEED 15 FOOT IN DIAMETER.

NOTE: ALL PIPE FROM HOUSE TO DISPOSAL AREA MUST BE CAST IRON.

PERMIT VOID AFTER THREE YEARS.

NOTE: INSTALL STAND PIPE ON SEPTIC TANK AND DRY WELL. STAND PIPES MUST BE 6 INCHES IN DIAMETER. CAST IRON, CONCRETE OR TERRA COTTA ACCEPTED.

**\*INSTALLER IS RESPONSIBLE FOR OBTAINING FINAL APPROVAL ON THIS PERMIT.**

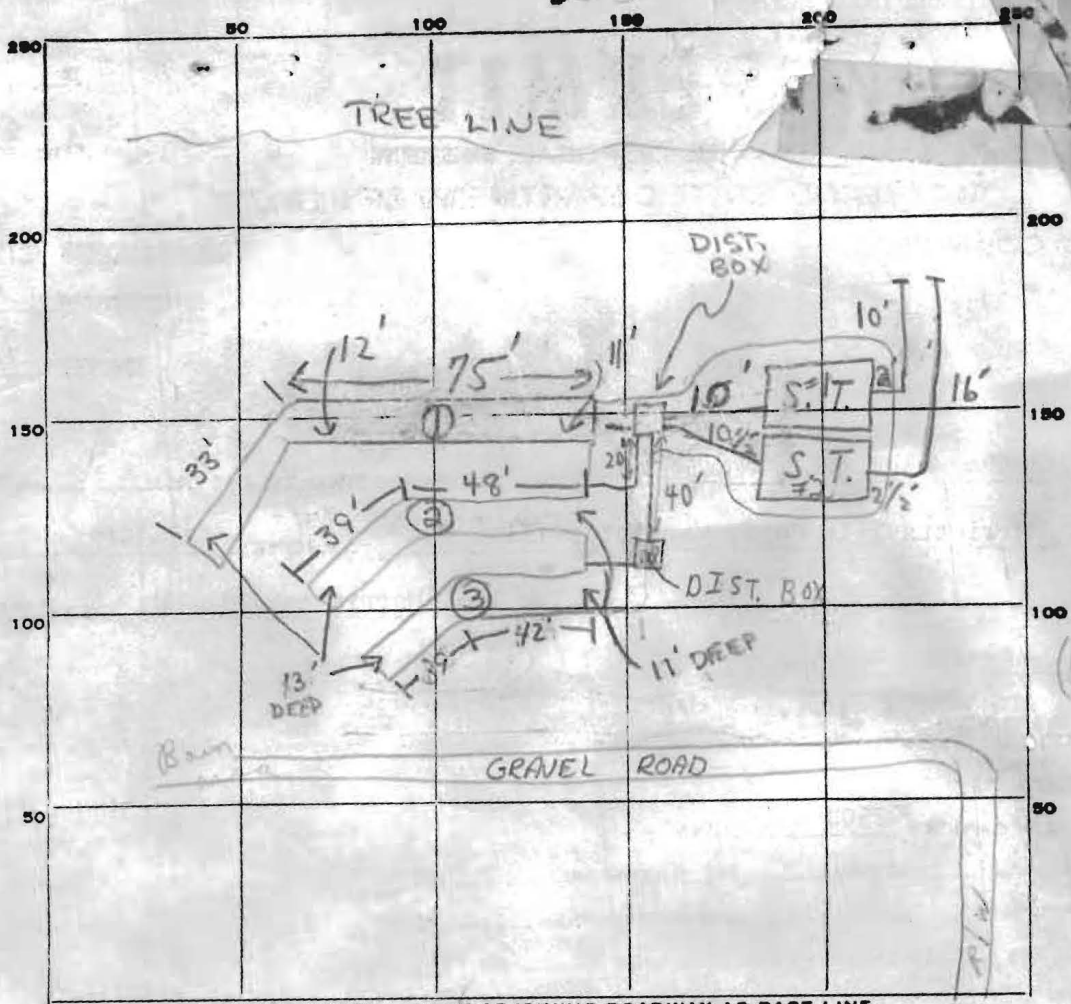

INDICATE NORTH. - NAME ADJOINING ROADWAY AS BASE LINE.

PERMIT CARD ✓✓✓ Marristeville Rd →  
 SEPTIC TANK, LEVEL (2) ok CLEANOUTS NO MANHOLE NO MANHOLE  
 DISTRIBUTION BOX, LEVEL ok  
 TILE FIELD, DEPTH 11'-12'+ FT. TRENCH WIDTH 2+ FT.  
 GRAVEL DEPTH 6.5 avg. 1'+ IN. TOTAL LENGTH 276' FT.  
 NUMBER OF TRENCHES 3 TOTAL BOTTOM AREA \_\_\_\_\_  
 SEEPAGE PITS, INSIDE DIAMETER \_\_\_\_\_ FT. DEPTH BELOW INLET \_\_\_\_\_ FT.  
 ABSORBENT AREA 1794+ SQ. FT.

REMARKS 8/29/79 - checked 1 trench 75' long - ok for stone, sept  
inspections 90' long but last 15' big cave in - to call for  
inspection ok to make trench in this spot if does not cave in  
Discussed septic tanks - 2 small ones - ok if use one  
for laundry + household wastes + one for restrooms per D.W.M., T.  
+ C.B.S.  
5-5-79 - OK TO BACKFILL TRENCH #1 (75') ADD GRAVEL TO REMAINING TRENCHES, CALL MANHOLES ON S.T.  
15' x 75' Baffle in DIST. BOX, CAST IRON FROM DIST. BOX TO TRENCHES, 2'  
1/13/79 ok to complete the work  
 SITE SYSTEM APPROVED 9/16/82 INSPECTOR F. Stearns per H-107 6/9/80