

LAYOUT 11/18/02 INSP 4 _____
INSP 2 _____ INSP 5 _____
INSP 3 _____ INSP 6 _____

MAIN HOUSE

ISSUE DATE: 11/18/02

PERMIT

P _____

APPROVAL DATE: 11/18/02

A 517998

ON-SITE SEWAGE DISPOSAL SYSTEM HOWARD COUNTY HEALTH DEPARTMENT BUREAU OF ENVIRONMENTAL HEALTH

Scott & Linda Wilson (Jenkin's Brothers) IS PERMITTED TO INSTALL ALTER

ADDRESS: 1650 Marriotsville Road PHONE NUMBER: (410) 442-5008

SUBDIVISION: Woodsford Grant II LOT NUMBER: 8

ADDRESS: 1650 Marriotsville Road PROPERTY OWNER: Scott & Linda Wilson

SEPTIC TANK CAPACITY (GALLONS): Existing OUTLET BAFFLE FILTER REQUIRED

PUMP CHAMBER CAPACITY (GALLONS): N/A COMPARTMENTED TANK REQUIRED

NUMBER OF BEDROOMS: 5

SQUARE FEET PER BEDROOM: 210

LINEAR FEET OF TRENCH REQUIRED: 193 HOUSE SERVED BY PUBLIC WATER


TRENCHES:	Trench to be 3.0 feet wide. Inlet 6.0 feet below original grade. Bottom maximum depth 10.0 10.0 feet below original grade. Effective area begins at 6.0 feet below original grade. 4.0 feet of stone below distribution pipe.
LOCATION:	Install distribution box in highest area allowable from tank by gravity or installing a 1500 gallon lift pump with a high water alarm may be required.
NOTES:	OSHA trench-boxing requirements will be required for due to depth of piping from tank. Install clean outs every 65' from tank to distribution box. It is recommended that a curtain drain be installed to divert surface water away from new system.

PLANS APPROVED: John A. Boris, Jr., R.S. DATE: 11/18/02

NOTES: PERMIT VOID AFTER 2 YEARS
CONTRACTOR IS RESPONSIBLE FOR SCHEDULING A PRE-CONSTRUCTION INSPECTION FOR ALL INSTALLATIONS
WATERTIGHT SEPTIC TANKS REQUIRED
ALL PARTS OF SEPTIC SYSTEM SHALL BE 100 FEET FROM ANY WATER WELL UNLESS SPECIFICALLY AUTHORIZED
MANHOLE RISERS REQUIRED ON ALL SEPTIC TANKS AND PUMP CHAMBERS UNLESS SPECIFICALLY AUTHORIZED
CONTRACTOR RESPONSIBLE FOR COMPLIANCE WITH APPLICABLE REGULATIONS, GUIDELINES AND THE TERMS OF THIS PERMIT

**NEITHER THE HOWARD COUNTY COUNCIL NOR THE HEALTH DEPARTMENT IS RESPONSIBLE FOR THE SUCCESSFUL OPERATION OF ANY SYSTEM
PERMITTEE RESPONSIBLE FOR OBTAINING FINAL APPROVAL ON THIS PERMIT
ALL 410-313-2640 FOR INSPECTION OF SEPTIC SYSTEM**

NOT TO SCALE

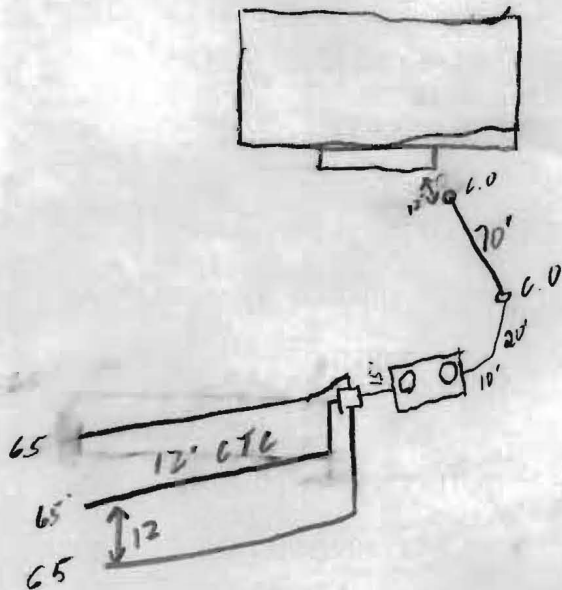

ROAD

TRENCH/DRAINFIELD DATA		
WIDTH	INLET	BOTTOM
3'	6'	10'
NUMBER OF TRENCHES		3
TOTAL LENGTH		195
ABSORPTION AREA		2340
DISTRIBUTION BOX LEVEL		<input checked="" type="checkbox"/>
DISTRIBUTION BOX BAFFLE		<input checked="" type="checkbox"/>
DISTRIBUTION BOX PORT		N/A

SEPTIC TANK DATA	
SEPTIC TANK 1 LEVEL <input checked="" type="checkbox"/>	
CAPACITY	2000 GAL
SEAM LOC	TOP
TANK LID DEPTH	3-4'
BAFFLES	<input checked="" type="checkbox"/>
BAFFLE FILTER	—
MANHOLE LOC	FEB
6" PORT LOC	—
WATERTIGHT TEST	—
SEPTIC TANK 2 LEVEL _____	
CAPACITY	_____ GAL
SEAM LOC	_____
TANK LID DEPTH	_____
BAFFLES	N/A
BAFFLE FILTER	_____
MANHOLE LOC	_____
6" PORT LOC	_____
WATERTIGHT TEST	_____

PRE-CONSTRUCTION 11/27/02 Layout cancelled; Contractor to excavate area around tanks to see if a tank has collapsed (2 on-site). Will wait for a call from owner for installation contractor to see how to proceed. 12/2/02 - 1.5 trenches installed. Tank & house conn installed (SO) 12/2/02 Inspected lowest trench (which was completed); no one on-site, left green sticker on insp port of tank O.K. to back fill

FINAL INSPECTOR

J. Kelly

DATE OF APPROVAL

12/3/02

