



Building Permit Application

Howard County Maryland
Department of Inspections, Licenses and Permits
3430 Court House Drive
Permits: 410-313-2455
www.howardcountymd.gov

Date Received: _____

Permit No.: _____

Building Address: 3837 Ivory Rd
 City: Glenely State: MD Zip Code: 21737
 Suite/Apt. #: _____ SDP/WP/BA #: _____
 Census Tract: _____ Subdivision: _____
 Section: _____ Area: _____ Lot: 6C
 Tax Map: 22 Parcel: 370 Grid: _____
 Zoning: _____ Map Coordinates: _____ Lot Size: _____

Property Owner's Name: Joe & Kimberly Bush
 Address: 3837 Ivory Rd
 City: Glenely State: MD Zip Code: 21737
 Phone: _____ Fax: _____
 Email: _____

Applicant's Name & Mailing Address (if other than stated herein)
 Applicant's Name: Michelle Cloney
 Address: P.O. Box 310
 City: Perryman State: MD Zip Code: 21088
 Phone: 410 846 1075 Fax: _____
 Email: _____

Existing Use: SDP
 Proposed Use: SDP w/ gazebo & deck
 Estimated Construction Cost: \$ 15,000
 Description of Work: Construct 10 x 12 gazebo and a 14 x 20 open deck w/ landing & stairs to grade
 Occupant/Tenant Name: Cloney
 Was tenant space previously occupied? Yes No
 Contact Name: _____
 Address: _____
 City: _____ State: _____ Zip Code: _____
 Phone: _____ Fax: _____
 Email: _____

Contractor Company: The Deck & Fence Company
 Contact Person: Richard Daniel
 Address: 412 Headwaters Dr. #6
 City: Millersville State: MD Zip Code: 21108
 License No.: 125136
 Phone: 410 846 5310 Fax: _____
 Email: _____

Engineer/Architect Company: _____
 Responsible Design Prof.: _____
 Address: _____
 City: _____ State: _____ Zip Code: _____
 Phone: _____ Fax: _____
 Email: _____

Commercial Building Characteristics	Residential Building Characteristics	
Height:	<input type="checkbox"/> SF Dwelling <input type="checkbox"/> SF Townhouse	
No. of stories:	<u>0</u> Depth	Width
Gross area, sq. ft./floor:	1 st floor:	
	2 nd floor:	
Area of construction (sq. ft.):	Basement:	
	<input type="checkbox"/> Finished Basement	
Use group:	<input type="checkbox"/> Unfinished Basement	
	<input type="checkbox"/> Crawl Space	
Construction type:	<input type="checkbox"/> Slab on Grade	
<input type="checkbox"/> Reinforced Concrete	No. of Bedrooms:	
<input type="checkbox"/> Structural Steel	Multi-family Dwelling	
<input type="checkbox"/> Masonry	No. of efficiency units:	
<input type="checkbox"/> Wood Frame	No. of 1 BR units:	
<input type="checkbox"/> State Certified Modular	No. of 2 BR units:	
	No. of 3 BR units:	
	Other Structure:	
	Dimensions:	
<input checked="" type="checkbox"/> Roadside Tree Project Permit	Footings:	
<input type="checkbox"/> Yes <input checked="" type="checkbox"/> No	Roof:	
Roadside Tree Project Permit #	<input type="checkbox"/> State Certified Modular	
	<input type="checkbox"/> Manufactured Home	

Utilities		
Electric:	<input type="checkbox"/> Yes <input checked="" type="checkbox"/> No	
Gas:	<input type="checkbox"/> Yes <input checked="" type="checkbox"/> No	
Water Supply		
<input type="checkbox"/> Public		
<input checked="" type="checkbox"/> Private		
Sewage Disposal		
<input type="checkbox"/> Public		
<input checked="" type="checkbox"/> Private		
Heating System		
<input type="checkbox"/> Electric <input type="checkbox"/> Oil		
<input type="checkbox"/> Natural Gas <input type="checkbox"/> Propane Gas		
<input type="checkbox"/> Other:		
Sprinkler System:		
<input type="checkbox"/> Yes <input checked="" type="checkbox"/> No		
Grading Permit Number:		
Building Shell Permit Number:		

THE UNDERSIGNED HEREBY CERTIFIES AND AGREES AS FOLLOWS: (1) THAT HE/SHE IS AUTHORIZED TO MAKE THIS APPLICATION; (2) THAT THE INFORMATION IS CORRECT; (3) THAT HE/SHE WILL COMPLY WITH ALL REGULATIONS OF HOWARD COUNTY WHICH ARE APPLICABLE THERETO; (4) THAT HE/SHE WILL PERFORM NO WORK ON THE ABOVE REFERENCED PROPERTY NOT SPECIFICALLY DESCRIBED IN THIS APPLICATION; (5) THAT HE/SHE GRANTS COUNTY OFFICIALS THE RIGHT TO ENTER ONTO THIS PROPERTY FOR THE PURPOSE OF INSPECTING THE WORK PERMITTED AND POSTING NOTICES.

Applicant's Signature: [Signature] Print Name: Michelle Cloney
 Email Address: Michelle@apthedondog.com Date: 8/9/17
 Title/Company: Permit

Checks Payable to: DIRECTOR OF FINANCE OF HOWARD COUNTY
PLEASE WRITE NEATLY & LEGIBLY
-FOR OFFICE USE ONLY-


AGENCY	DATE	SIGNATURE OF APPROVAL
State Highways		
Building Officials		
PSZA (Zoning)		
PSZA (Engineering)		
Health	<u>8/9/17</u>	<u>[Signature]</u>

Is Sediment Control approval required for issuance? Yes No
 CONTINGENCY CONSTRUCTION START

DPZ SETBACK INFORMATION
Front:
Rear:
Side:
Side St.:
All minimum setbacks met? <input type="checkbox"/> Yes <input type="checkbox"/> No
Is Entrance Permit Required? <input type="checkbox"/> Yes <input type="checkbox"/> No
Historic District? <input type="checkbox"/> Yes <input type="checkbox"/> No
Lot Coverage for New Town Zone:
SDP/Red-line approval date:

Filing Fee	\$
Permit Fee	\$
Tech Fee	\$
Excise Tax	\$
PSFS	\$
Guaranty Fund	\$
Add'l per Fee	\$
Total Fees	\$
Sub- Total Paid	\$
Balance Due	\$
Check	#


DEED REFERENCE LIBER 3382 FOLIO 0399

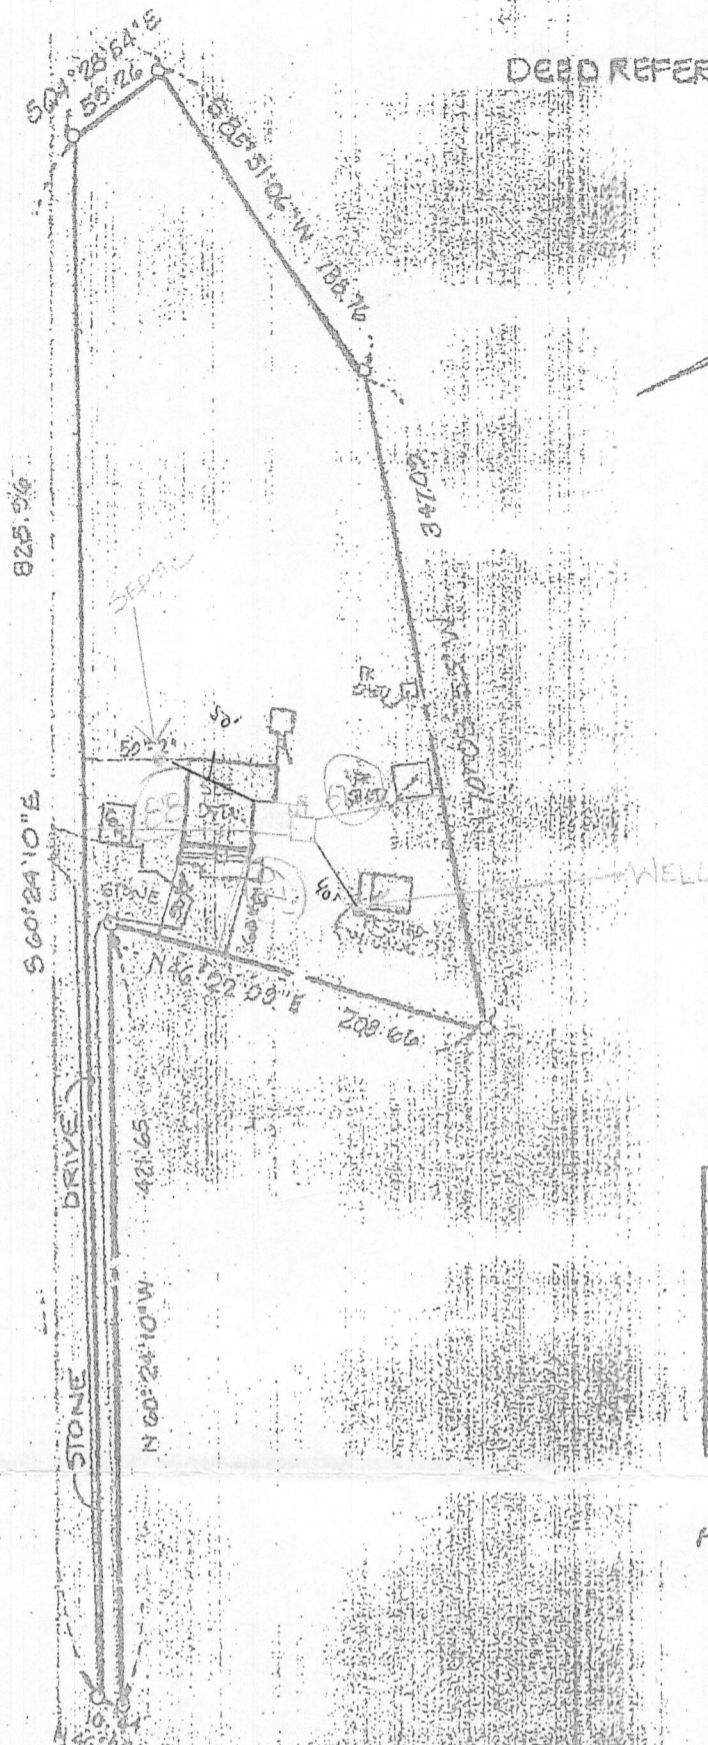

APPROVED

WALKTHRU BUILDING PERMIT

BP# _____ A# _____
 APP. SAN Robert Freeman DATE: 8/1/02
 DESC. OF WORK: Construct 10 x 12
 gazebo and a 14 x 20 open
 deck w/ 1 landing stairs to grade

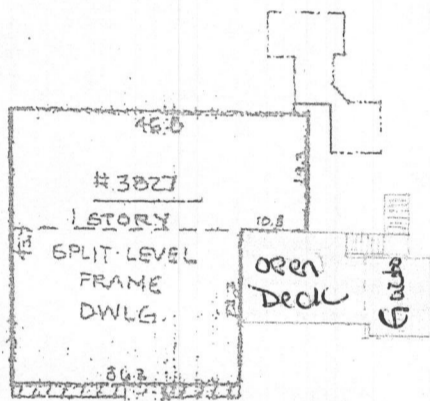

HOUSE DETAIL

1" = 30'

Recorded against the plan by _____
 on the National Flood Insurance Program
 Flood Insurance Rate Map of Howard
 County, Maryland, Panel 21 of 45
 Community Panel # 240044 00215
 Recording Date: Sep 4 1986

IVORY ROAD

CASE # 65781 LL



- 1) This plan is of benefit to a consumer only insofar as it is required by a lender or a title insurance company or its agent in connection with a mortgage transfer, financing or re-financing;
- 2) This plan is not to be relied upon for the establishment or location of fences, easements, building, or other existing or future improvements;
- 3) This plan does not provide for the accurate identification of property boundary lines, but such identification may not be required for the transfer of title or securing financing or re-financing.

3827 IVORY RD. HOWARD CO. MD.			SCALE: 1" = 100'
JOHN S. MULLEN, SR., INC. LAND SURVEYORS			DATE: 6-3-02
5409 EAST DRIVE • BALTIMORE, MARYLAND 21227 • (301) 247-7488			JOB NO: 02240