



APPLICATION

FOR PERCOLATION TESTING AND SITE EVALUATION

TEST DATE(S) _____ TEST TIME _____ AP 531979
 AGENCY REVIEW: _____ DATE 10/30/09

DO NOT WRITE ABOVE THIS LINE

I HEREBY APPLY FOR THE NECESSARY TESTING/EVALUATION PRIOR TO ISSUANCE OF SEWAGE DISPOSAL SYSTEM PERMIT(S) TO:

CHECK AS NEEDED:

- CONSTRUCT NEW SEPTIC SYSTEM(S)
- REPAIR/ADD TO AN EXISTING SEPTIC SYSTEM
- REPLACE AN EXISTING SEPTIC SYSTEM

CHECK AS NEEDED:

- NEW STRUCTURE(S)
- ADDITION TO AN EXISTING STRUCTURE
- REPLACE AN EXISTING STRUCTURE

CHECK ONE:

- CREATE NEW LOT(S)
- BUILD ON AN EXISTING LOT IN A SUBDIVISION
- BUILD ON AN EXISTING PARCEL OF RECORD

IS THE PROPERTY WITHIN 2500' OF ANY RESERVOIR?

- YES
- NO

THE TYPE OF STRUCTURE IS:

- RESIDENTIAL WITH _____ PROPOSED BEDROOMS IN THE COMPLETED STRUCTURE (NOTE *UNKNOWN* IF APPROPRIATE)
- COMMERCIAL (PROVIDE DETAIL OF NUMBERS AND TYPES OF EMPLOYEES/ CUSTOMERS ON ACCOMPANYING PLAN)
- INSTITUTIONAL/GOVERNMENT (PROVIDE DETAIL OF NUMBERS AND TYPES OF EMPLOYEES/USERS ON ACCOMPANYING PLAN)

PROPERTY OWNER(S) Panfilo Jimenez

DAYTIME PHONE 443-864-8280 CELL Same FAX _____

MAILING ADDRESS 734 Marriottsville Rd Marriottsville MD 21104
STREET CITY/TOWN STATE ZIP

APPLICANT Panfilo Jimenez

DAYTIME PHONE _____ CELL _____ FAX _____

MAILING ADDRESS _____
STREET CITY/TOWN STATE ZIP

APPLICANT'S ROLE: DEVELOPER BUILDER BUYER RELATIVE/FRIEND REALTOR CONSULTANT

PROPERTY LOCATION SUBDIVISION/PROPERTY NAME 734- Marriottsville Rd LOT NO. 734

PROPERTY ADDRESS 734 Marriottsville Rd Marriottsville MD 21104
STREET TOWN/POST OFFICE

TAX MAP PAGE(S) _____ GRID _____ PARCEL(S) _____ PROPOSED LOT SIZE _____

AS APPLICANT, I UNDERSTAND THE FOLLOWING: THE SYSTEM INSTALLED SUBSEQUENT TO THIS APPLICATION IS ACCEPTABLE ONLY UNTIL PUBLIC SEWERAGE IS AVAILABLE. THIS APPLICATION IS COMPLETE WHEN ALL APPLICABLE FEES AND A SUITABLE SITE PLAN HAVE BEEN RECEIVED. I ACCEPT THE RESPONSIBILITY FOR COMPLIANCE WITH ALL M.O.S.H.A. AND "MISS UTILITY" REQUIREMENTS. APPROVAL IS BASED UPON SATISFACTORY REVIEW OF A PERC CERTIFICATION PLAN.

TEST RESULTS WILL BE MAILED TO APPLICANT. X Panfilo Jimenez 10-30-09
SIGNATURE OF APPLICANT

HOWARD COUNTY HEALTH DEPARTMENT, BUREAU OF ENVIRONMENTAL HEALTH, WELL AND SEPTIC PROGRAM
7178 COLUMBIA GATEWAY DRIVE COLUMBIA, MARYLAND 21046 (410) 313-1771 FAX (410) 313-2648
TDD (410) 313-2323 TOLL FREE 1-877-4MD-DHMH

INFORMATION FORM - SEPTIC SYSTEM REPAIR / UPGRADE / EVALUATION

For internal office use only

Reason for Request:

Failing System (includes surface discharge or inadequate treatment zone)

Has the contractor verified through excavation/pumping evaluation, that there are no pipe blockages? No

System relocation for proposed addition for setback compliance *

Verification of adequate system per COMAR 26.04.02.02D (4)*

To replace collapsed septic tank

To replace collapsed drywell

Septic Contractor: _____

Contractor's Address: _____

Contractor's Phone #: _____

Property Address: _____

Property (Subdivision) & Lot # _____

County file number if known: _____

Owner's Name and Phone number: _____

Is public sewer available/nearby:

If public sewer may be close, mention further research will be performed to verify availability

Names of Any Previous Owners: _____

Year House Built: _____

of Existing Bedrooms: _____

of Bedrooms after completion of addition: _____

Has this request been discussed previously with another Sanitarian: _____ Name: _____

A Sanitarian will be in contact within three business days depending upon the urgency of the situation to coordinate the scheduling/review of the repair, upgrade or evaluation.

Print out copy of Real Property Data via Dept. of Taxation website _____ Indexed file found _____

***Prior to scheduling inspections, scaled plans should be submitted to clarify the nature of the addition.**

If public sewer may be nearby, verify whether the sewer is technically "available" (defined as abutting or within the property), through the Bureau of Engineering (Diane Nason x 3372 or Jean Reed x 3362).

If sewer is available, verify whether the property is within the Metropolitan District (Finance x 2061).

If sewer is available, and property is within the Metropolitan District, connection to sewer is required. If owner believes reasons for exemptions exist, owner should justify request in writing.

If soil/site conditions are limiting and sewer and/or Metro District status not conducive to connection, Sanitarian may recommend pursuit of Emergency Sewer Extension or Emergency Metro District Inclusion. Owner should contact Charlotte Dryden at x 4419 for further detail.

Environmental Sanitarian tentatively assigned per rotating index card box: Brian

Date of request: _____ (Clerical staff to update scheduling card with date of request/property address)

Septic permit to be typed by clerical staff after instruction from scheduling Sanitarian.

No permit is to be issued nor inspection to be scheduled without prior fee collection at office unless an emergency situation exists. Contractor to notify office of the emergency situation as soon as possible.



Disclaimer: Howard County, Maryland assumes no responsibility for the accuracy of this report or the information contained herein or derived therefrom. The user assumes all risks and liabilities whatsoever resulting from or arising out of the use of this information. There is no oral agreement or warranties relating to the use of this report.

-76°53'57"

-76°53'57"

Marriottsville Rd

Marriottsville Rd

39°21'3.0"

39°21'3.0"




Howard County

M A R Y L A N D

By:
Office:
Map Width: 455.00 ft.
Print Date: 10/30/2009
Scale: 1 in. = 50 ft.

red & lt grey
10R418 22.5Y7/2
clay, 0m
dk brn 7.5YR 3/2

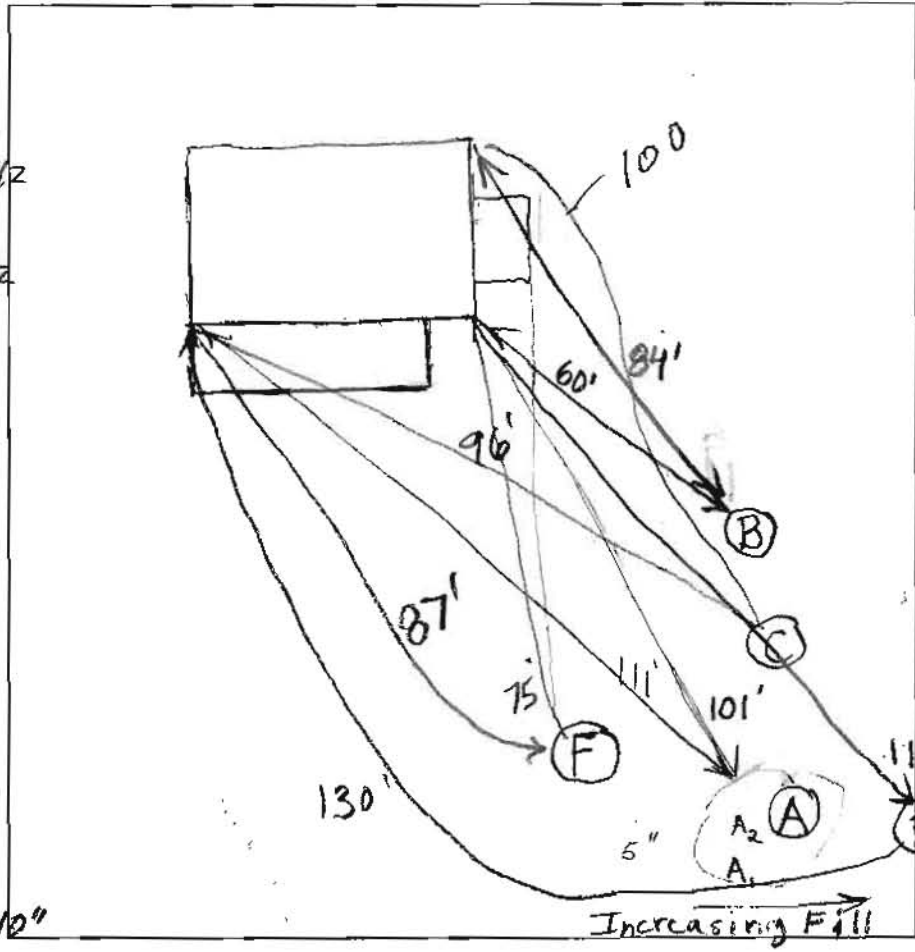

(D)
1' Fill
Br Compacted Loam 16"
Saturated Water 6'
7'
(E)
Fill 17"
Water 6'
7'


(B)
Fill With Mottling Above Next Layer 9"-10"
Dense Br Compacted Sa c/Loam 1.5-2'
Red Br Sa c/Loam 4.5
>50% Rock 5'

DATE	TEST #	DEPTH	START	BREAK 1" DROP	STOP 2" DROP	TIME OF 2ND INCH	P/F/H
11/6/09	A1	2' 10"	11:48	12:30:30	12:37:15	7	
		4" or 5" Repair	12:39	11:46:15	11:55:15	9	
	A2	14"	11:44:30	11:51	12:01:30	10 1/2	
	A	3' 9"	12:15:30	12:19:30	12:25:5 1/2		
	B						
	C						
	D						
	E	22"	2:45	Pulled Probably Slow			
		26"	2:58	3:21:30	3:53:30	32	

(C)
Fill With Mottling Above Next Layer 8"
Dense Compacted Br Sa c/Loam
Red Br Sa Loam 5.5
>50% Rock 6'

REMARKS _____
SANITARIAN B. Baker, S. Krieg BACKHOE Homeowner OTHERS _____
TEST HOLES USED IN SDA _____ AVG. PERC TIME _____ SQ. FT/BR _____
TRENCH WIDTH _____ INLET DEPTH _____ MAX. BOT DEPTH _____ EFFECTIVE S/W _____

Click here for a plain text ADA compliant screen.

 Maryland Department of Assessments and Taxation HOWARD COUNTY Real Property Data Search	Go Back View Map New Search Ground Rent
--	--

Account Identifier: District - 03 Account Number - 294293

Owner Information

Owner Name:	JIMENEZ PANFILO	Use:	RESIDENTIAL
		Principal Residence:	YES
Mailing Address:	734 MARRIOTTSVILLE RD MARRIOTTSVILLE MD 21104-1310	Deed Reference:	1) / 8575/ 357 2)

Location & Structure Information

Premises Address	Legal Description
734 MARRIOTTSVILLE RD MARRIOTTSVILLE 21104	.515 A 734 MARRIOTTSVILLE RD MARRIOTTSVILLE

Map	Grid	Parcel	Sub District	Subdivision	Section	Block	Lot	Assessment Area	Plat No: Plat Ref:
5	22	13						1	

Special Tax Areas	Town Ad Valorem Tax Class	NO A/V, NO M/P, RURAL FIRE TAX
--------------------------	----------------------------------	--------------------------------

Primary Structure Built	Enclosed Area	Property Land Area	County Use
1920	1,128 SF	22,433.00 SF	
Stories	Basement	Type	Exterior
1 1/2	NO	STANDARD UNIT	FRAME

Value Information

	Base Value	Phase-in Assessments		
		Value As Of	As Of	As Of
		01/01/2007	07/01/2006	07/01/2007
Land:	138,830	248,630		
Improvements:	34,020	50,070		
Total:	172,850	298,700	172,850	214,800
Preferential Land:	0	0	0	0

Transfer Information

Seller: BOLGER BRIAN J	Date: 08/23/2004	Price: \$230,000
Type: IMPROVED ARMS-LENGTH	Deed1: / 8575/ 357	Deed2:
Seller: BOLGER BRIAN J	Date: 07/23/2001	Price: \$0
Type: NOT ARMS-LENGTH	Deed1: / 5587/ 201	Deed2:
Seller:	Date:	Price:
Type:	Deed1:	Deed2:

Exemption Information

Partial Exempt Assessments	Class	07/01/2006	07/01/2007
County	000	0	0
State	000	0	0
Municipal	000	0	0

Tax Exempt: NO	Special Tax Recapture:
Exempt Class:	* NONE *