

APPLICATION

PERCOLATION TESTING

A 47053
P _____

HOWARD COUNTY HEALTH DEPARTMENT
BUREAU OF ENVIRONMENTAL HEALTH
PO BOX 476 ELLICOTT CITY MARYLAND 21043
TELEPHONE 461 9933

DISTRICT 4th

DATE April 16, 1991

5/7/91

TO: THE COUNTY HEALTH OFFICER
ELLICOTT CITY, MARYLAND

I HEREBY APPLY FOR THE NECESSARY TEST IN ORDER TO CONSTRUCT (OR RECONSTRUCT) A SEWAGE DISPOSAL SYSTEM

PROPERTY OWNER W. Lambert Cissel, Jr.

ADDRESS 3425 Hipsley Mill Road, Woodbine, MD 21797 PHONE 301-442-2463

PROSPECTIVE BUYER Same

ADDRESS _____ PHONE _____

PROPERTY LOCATION: Now part of Marjorie Green on
SUBDIVISION ~~Forest Green~~ Perc Cert LOT NO 45

ROAD AND DESCRIPTION 3000 ± Jennings Chapel Rd.

TAX MAP 20 PARCEL # 56

SIZE OF LOT 3.5 acres ± TYPE BLDG Single Family Dwelling
(SINGLE FAMILY DWELLING OR COMMERCIAL)

THE SYSTEM INSTALLED UNDER THIS APPLICATION IS ACCEPTABLE ONLY UNTIL PUBLIC FACILITIES BECOME AVAILABLE. I FULLY UNDERSTAND THE

FEE CONNECTED WITH THE FILING OF THIS PERC TEST APPLICATION IS NON-REFUNDABLE UNDER ANY CIRCUMSTANCES. I ALSO AGREE TO COMPLY

WITH ALL M.O.S.H.A. REQUIREMENTS IN TESTING THIS LOT Christine A. Richards 997-3815
(SIGNATURE OF APPLICANT)

APPROVED BY _____ FOR _____ DATE _____

REJECTED BY _____ FOR _____ DATE _____

HOLD PENDING FURTHER TESTS _____ DATE _____

REASONS FOR REJECTION OR HOLDING _____

THIS IS NOT A PERMIT

HD-216


Lot 2

A47053

①-④
SOIL PROFILE

0
3-4
12 1/2 - 13 1/2
org brn sandy cl loam
pink brn tan sand loam
10-15% hard shale frags

⊗ = PER PLAN NOT DUG

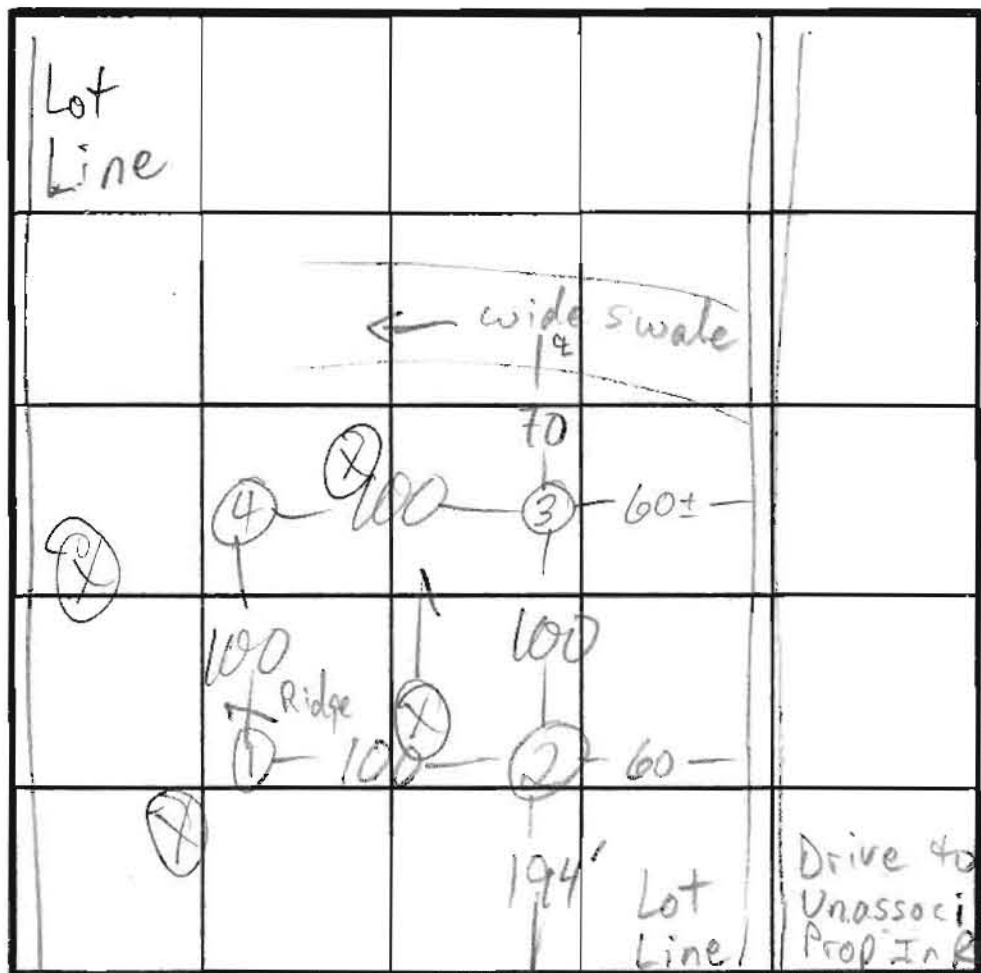

JENNINGS CHAPEL INDICATE NORTH - NAME ADJOINING ROADWAY AS BASE LINE.

DATE	TEST NO.	DEPTH	PRE-WET		TEST - 1" DROP		TIME	
			START	STOP	START	STOP		
4/26/11	1 S	5	12:21	12:26	12:26	12:31:30	5 1/2	
	1 V	12 1/2	see profile					
	2 S	4 1/2	12:23	12:27	12:27	12:32	5 EST	
	2 M	7 1/2	1:10	1:11	1:11	1:14	3	
	2 V	13	see profile					
	3 S	4	12:40	12:42	12:42	12:45	3	
	3 V	13 1/2	sim to ① more pink					
	4 S	4 1/2	1:00	1:02:30	1:02:30	1:07	4 1/2	
	4 V	12 1/2	sim to ① w/ 20% frags, some leached w/struc mottles					

REMARKS HOLES NOT EXACTLY PER PLAN

TYPE OF SOIL

TESTED BY M. Rifkin ALSO PRESENT

EH-12-1079

APPLICATION

PERCOLATION TESTING

A L17058

P _____

HOWARD COUNTY HEALTH DEPARTMENT
BUREAU OF ENVIRONMENTAL HEALTH
PO BOX 476 ELLICOTT CITY MARYLAND 21043
TELEPHONE 461 9933

DISTRICT 4th

DATE ~~April 17, 1991~~

5/7/91

TO: THE COUNTY HEALTH OFFICER
ELLICOTT CITY, MARYLAND

I HEREBY APPLY FOR THE NECESSARY TEST IN ORDER TO CONSTRUCT (OR RECONSTRUCT) A SEWAGE DISPOSAL SYSTEM

PROPERTY OWNER W. Lambert Cissel, Jr.

ADDRESS 3425 Hipsley Mill Road, Woodbine, MD 21797 PHONE 301-442-2463

PROSPECTIVE BUYER Same

ADDRESS _____ PHONE _____

PROPERTY LOCATION

SUBDIVISION Marjorie Green LOT NO. (9)?

ROAD AND DESCRIPTION 2900± Jennings Chapel Rd.

TAX MAP 20 PARCEL # 88

SIZE OF LOT 3.5 acres ± TYPE BLDG Single Family Dwelling
(SINGLE FAMILY DWELLING OR COMMERCIAL)

THE SYSTEM INSTALLED UNDER THIS APPLICATION IS ACCEPTABLE ONLY UNTIL PUBLIC FACILITIES BECOME AVAILABLE. I FULLY UNDERSTAND THE

FEE CONNECTED WITH THE FILING OF THIS PERC TEST APPLICATION IS NON-REFUNDABLE UNDER ANY CIRCUMSTANCES. I ALSO AGREE TO COMPLY

WITH ALL M.O.S.H.A. REQUIREMENTS IN TESTING THIS LOT Christine A. Richards
(SIGNATURE OF APPLICANT)

APPROVED BY _____ FOR _____ DATE _____

REJECTED BY _____ FOR _____ DATE _____

HOLD PENDING FURTHER TESTS _____ DATE _____

REASONS FOR REJECTION OR HOLDING _____

Not tested

HD-216

THIS IS NOT A PERMIT

March 17, 1992

X
 new Section 16.118(p) of the Subdivision and Land Development Regulations. Submission of final plat originals must be accomplished within 180 days of the effective date of APFO (by October 7, 1992). If this deadline is not met, your plan will be considered null and void, all previous approvals will be rescinded and this project will lose its conditional exemption to the requirements of APFO. This Department cannot entertain any extensions of time under the provisions of the APFO legislation.

5. Submission of an accurate 1" = 600' scale reduction of the subdivision plat indicating lots/parcels with lot numbers/parcel letters and rights-of-way or a 1" = 100' scale reduction for multi-family developments.

Compliance with all conditions and/or corrections is required before the original plan or plat will be accepted for signature approval. Please contact the Department of Planning and Zoning at 313-2393 for an appointment to submit originals for signature.

When recorded, the signed original plat will be retained on file in the Department of Planning and Zoning.

If you have any questions, please contact Cindy DelZoppo at 313-2354.

Sincerely,



Elmina J. Hilsenrath, Chief
 Division of Community Planning
 and Land Development

EJH/CD/cs/F92100.LTR


Enclosure

cc: Data Management
 Department of Public Works
 Department of Environmental Health
 Willis L. Cissel, Jr.
 Boender Associates
 WP-92-93

92 MAR 19 11:39 AM

RECEIVED
 DIVISION OF COMMUNITY PLANNING
 AND LAND DEVELOPMENT
 MARCH 19 1992

MARJORIE GREEN
Subdivision
(PROPERTY of LAMBERT CISSEL)
Howard County
Maryland

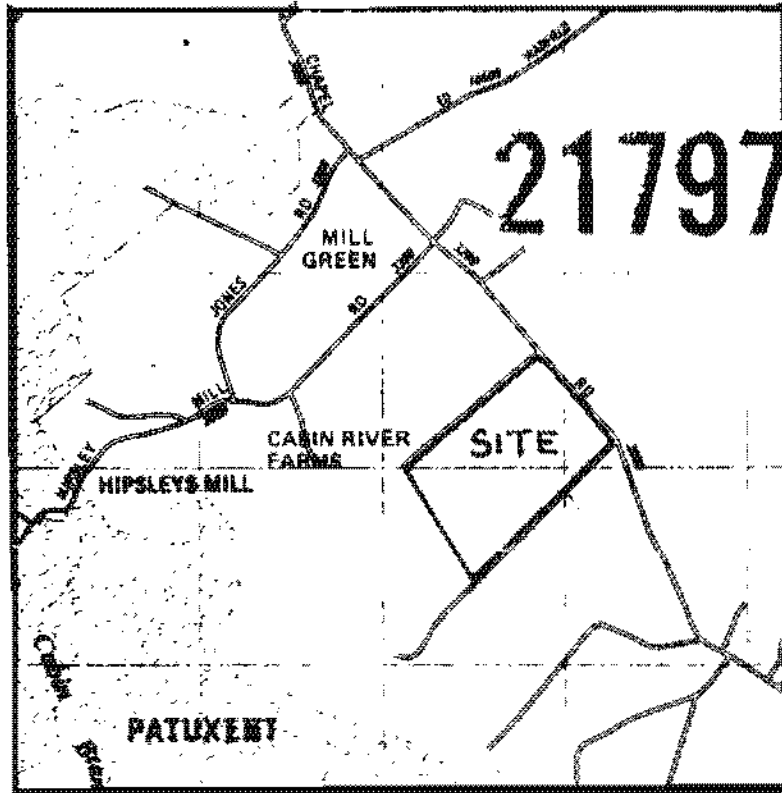



VICINITY MAP
1" = 2000'

TAX MAP NO. 20
PARCEL NO. 88

by

NEWBURN DEVELOPMENT CORPORATION
5570 STERRETT PLACE, SUITE 201
COLUMBIA, MARYLAND 21044
TELEPHONE # 301-997-3815

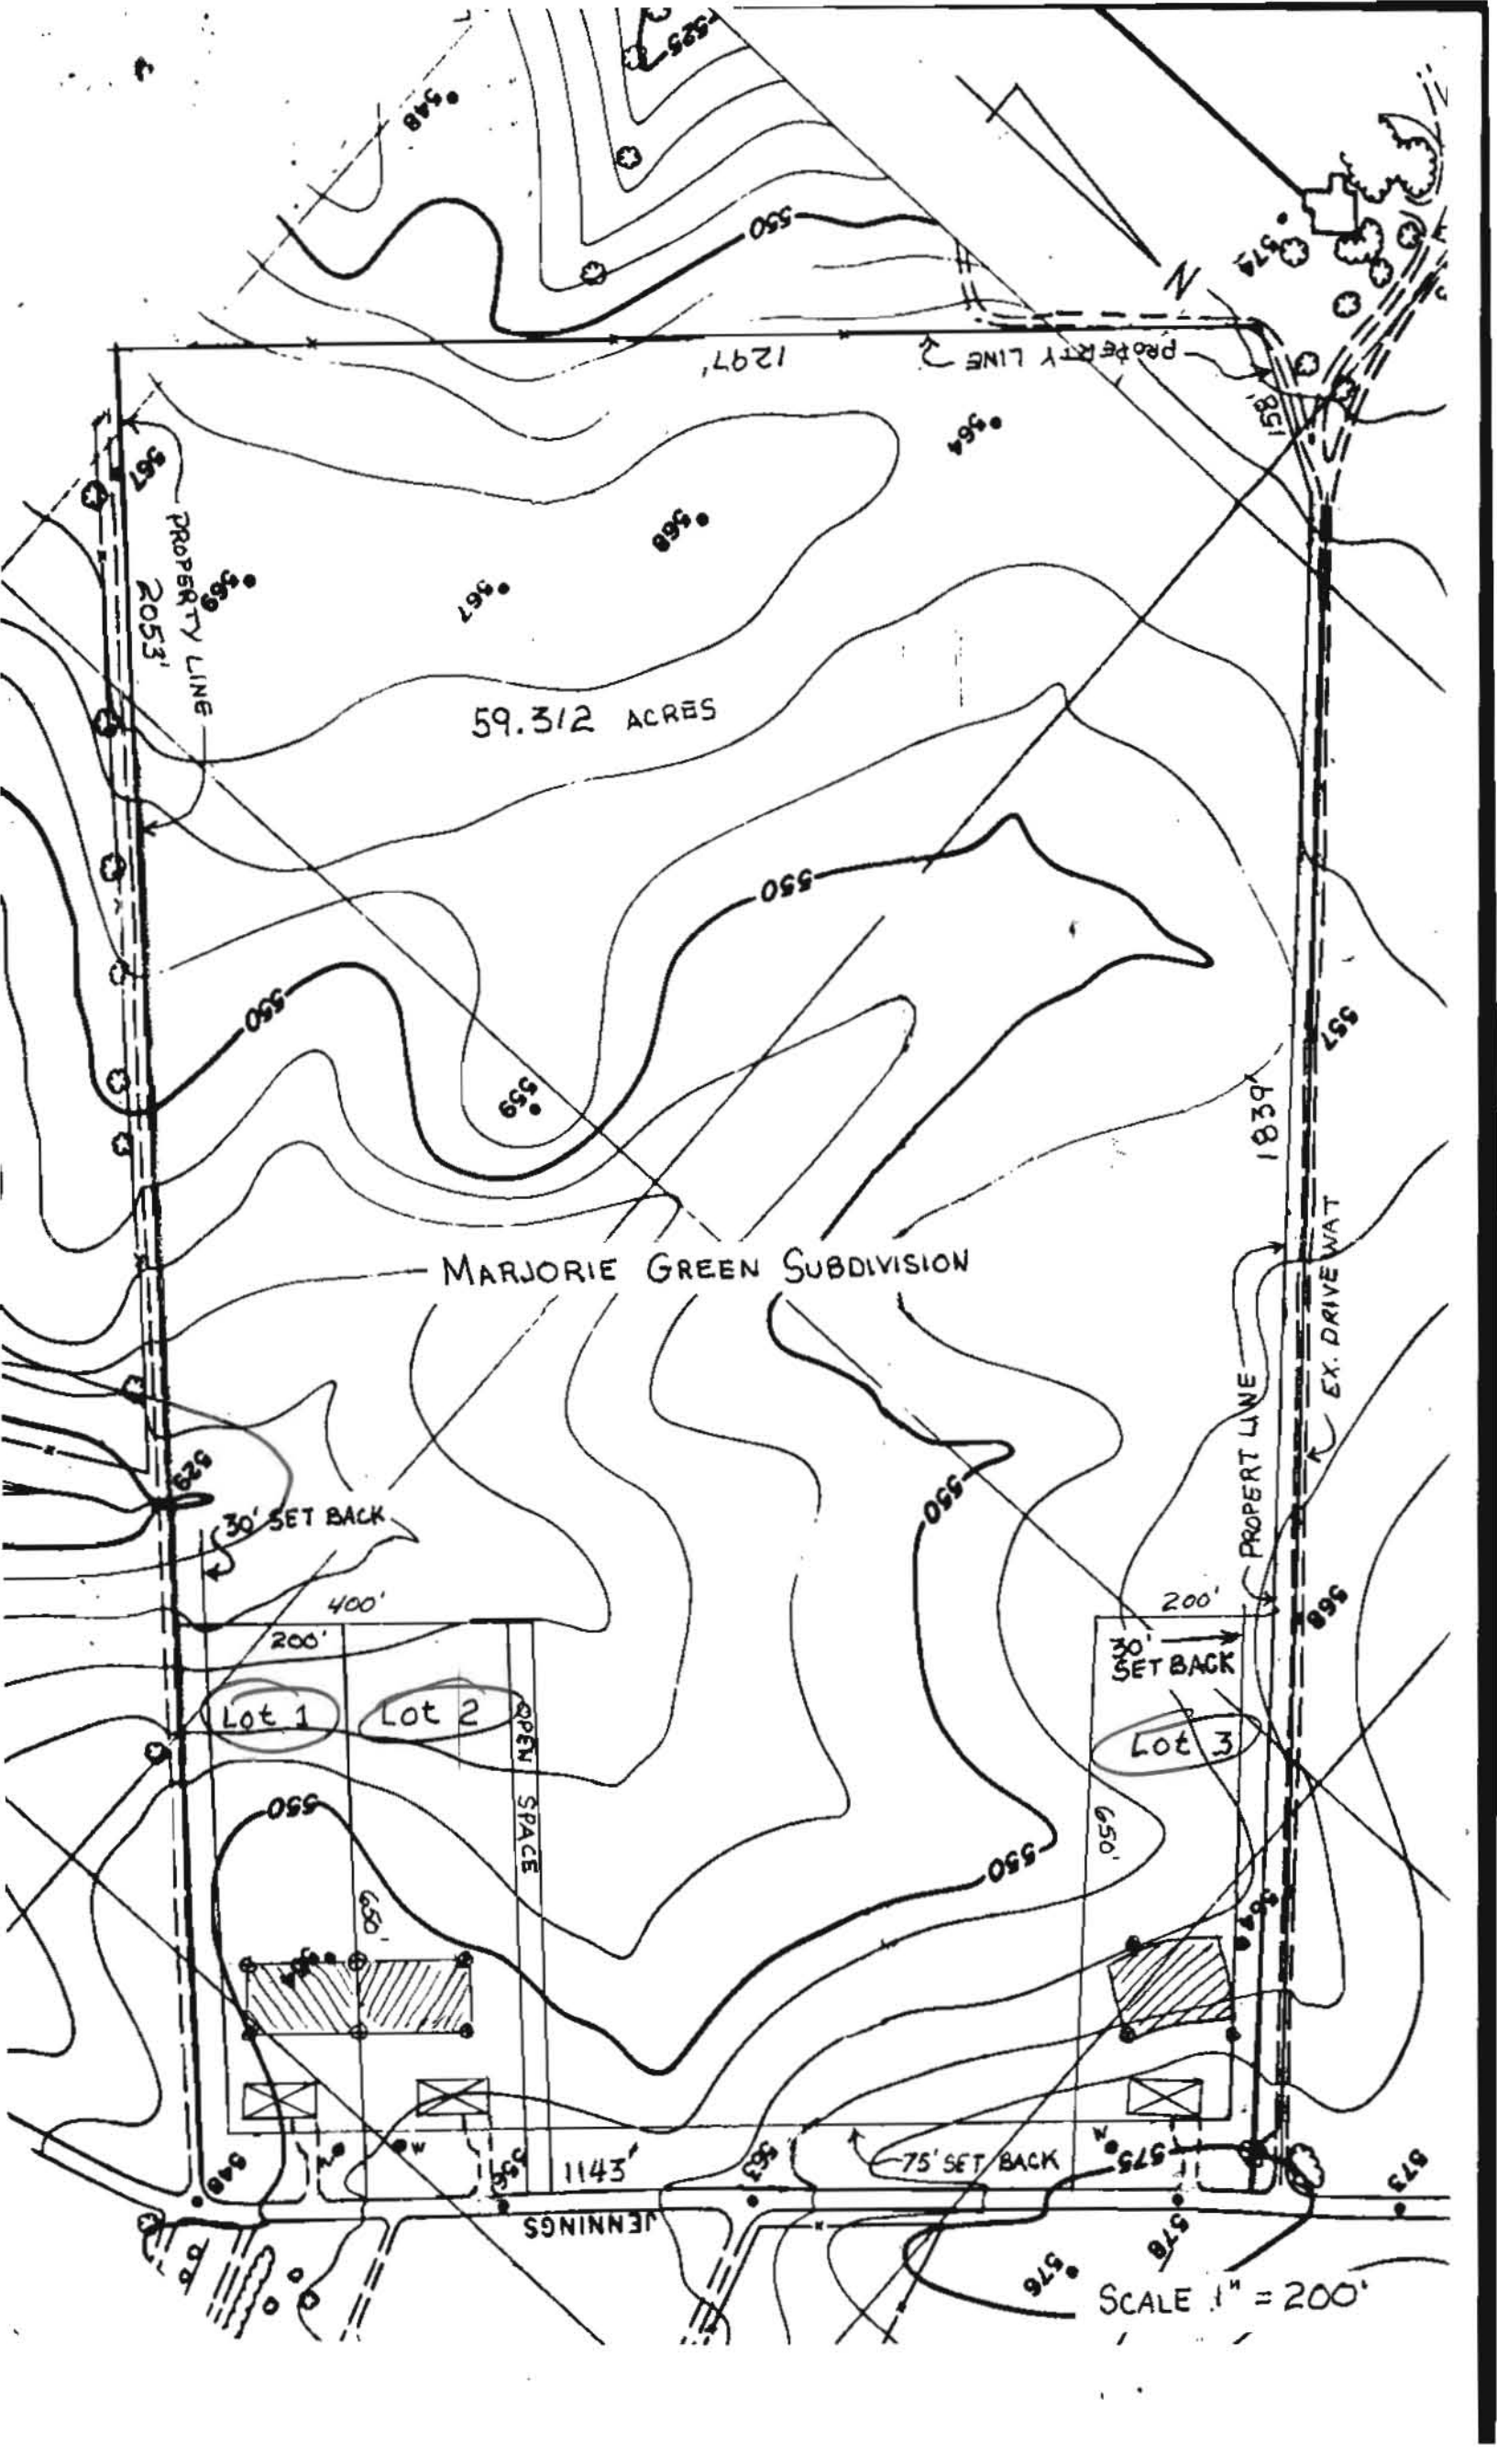

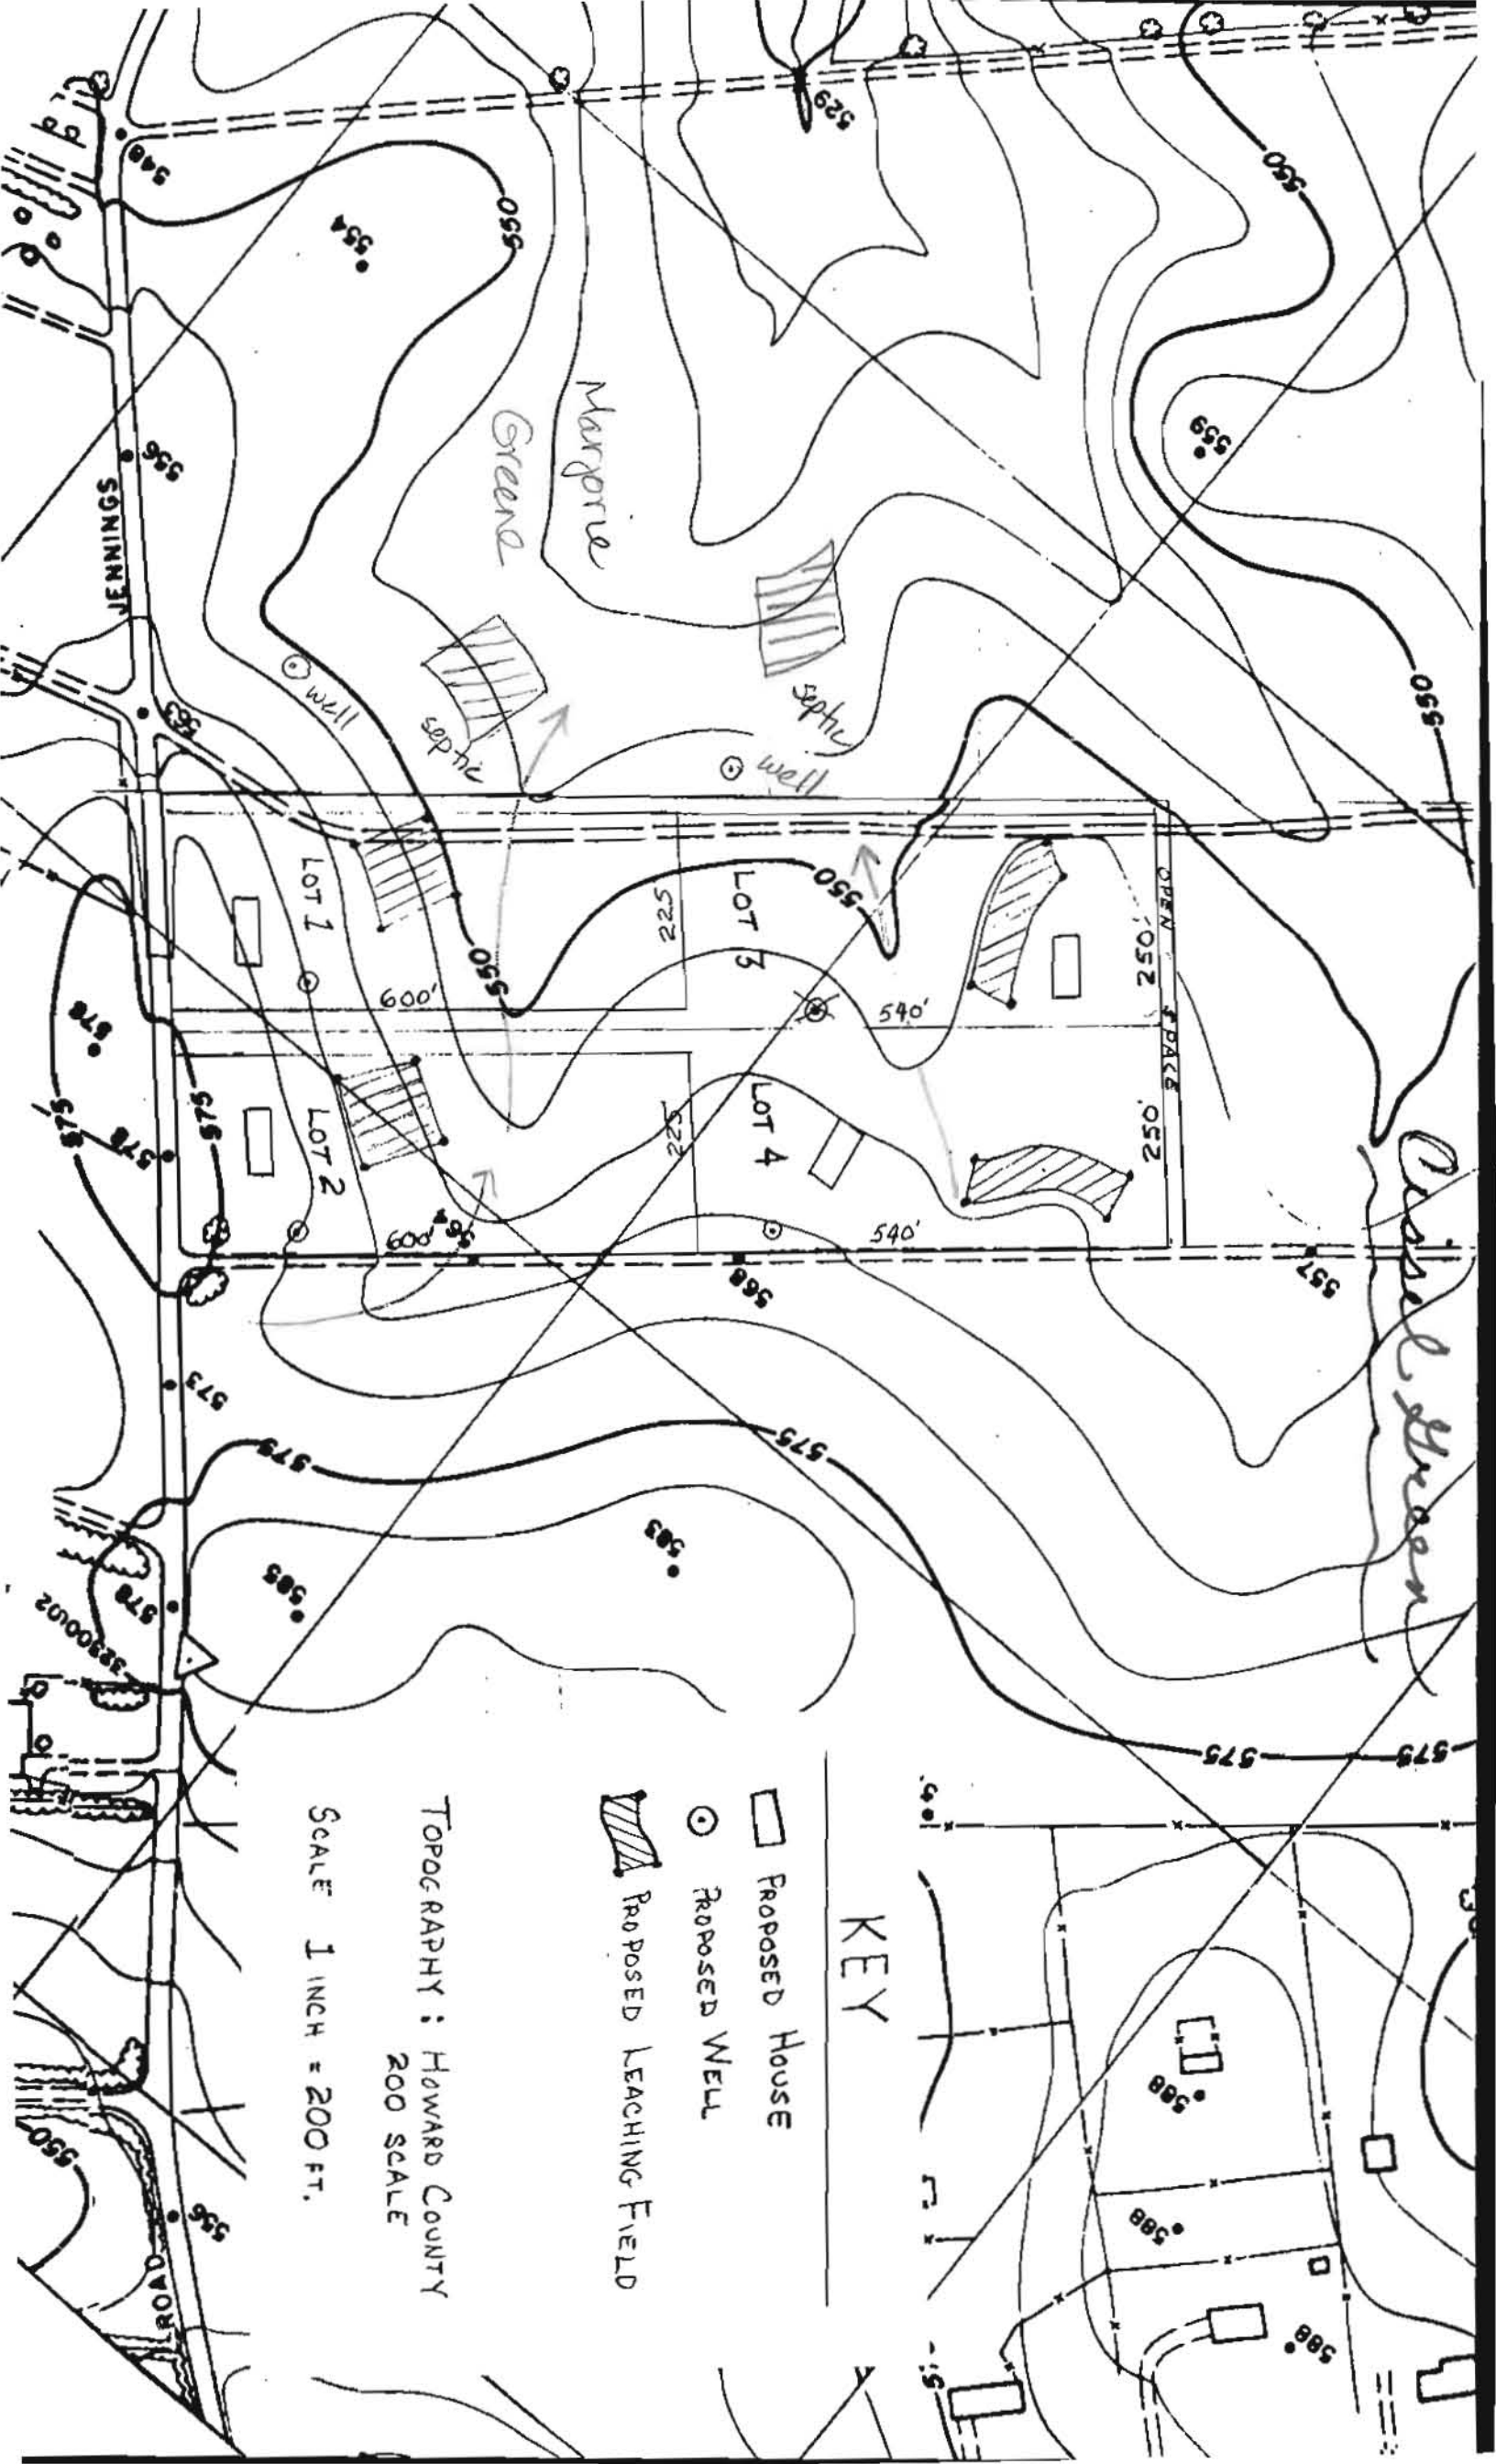

Central Street

Maryrie Greene

JENNINGS ROAD

ROAD

TOPOGRAPHY: HOWARD COUNTY
200 SCALE
SCALE 1 INCH = 200 FT.

KEY

- ▭ PROPOSED HOUSE
- PROPOSED WELL
- ▨ PROPOSED LEACHING FIELD

LOT 1

LOT 2

LOT 3

LOT 4

OPEN SPACE

536

534

539

583

585

529

550

555

522

522

540'

540'

568

557

573

579

575

575

575

588

588

588

536

540

540

Septic

Septic

17m well

well

600'

600'

250'

250'

550

550

550

540