



Building Permit Application

Howard County Maryland
Department of Inspections, Licenses and Permits
3430 Court House Drive
Permits: 410-313-2455
www.howardcountymd.gov

Date Received: _____

Permit No.: _____

Building Address: 1025 LONG CORNER RD
 City: MT. AIRY State: MD Zip Code: 21771
 Suite/Apt. # _____ SDP/WP/BA #: _____
 Census Tract: _____ Subdivision: CHESNUT HILLS
 Section: 0006 Area: _____ Lot: J
 Tax Map: 0006 Parcel: 0189 Grid: 0011
 Zoning: _____ Map Coordinates: _____ Lot Size: 5.041
04-316371 219,40956
 Existing Use: RESIDENTIAL
 Proposed Use: _____
 Estimated Construction Cost: \$ 31,000
 Description of Work: I/G Pool

Occupant/Tenant Name: ROBERT BROWNING
 Was tenant space previously occupied? Yes No
 Contact Name: _____
 Address: _____
 City: _____ State: _____ Zip Code: _____
 Phone: _____ Fax: _____
 Email: _____

Property Owner's Name: ROBERT BROWNING
 Address: 1025 LONG CORNER RD
 City: MT. AIRY State: MD Zip Code: 21771
 Phone: 301-903-5567 Fax: _____
 Email: MARILYNMSB@AOL.COM

Applicant's Name & Mailing Address, (if other than stated herein)
 Applicant's Name: AEK CONST. INC. MIKE
 Address: P.O. Box 279
 City: LIBERTY TOWN State: MD Zip Code: 21762
 Phone: 301-304-2221 Fax: 301-898-4120
 Email: MIKE@LAURELPOOLS.COM

Contractor Company: AEK CONST. INC.
 Contact Person: MIKE
 Address: P.O. Box 279
 City: LIBERTY TOWN State: MD Zip Code: 21762
 License No.: 179093
 Phone: 301-304-2221 Fax: 301-898-4120
 Email: MIKE@LAURELPOOLS.COM

Engineer/Architect Company: _____
 Responsible Design Prof.: _____
 Address: _____
 City: _____ State: _____ Zip Code: _____
 Phone: _____ Fax: _____
 Email: _____

Commercial Building Characteristics	Residential Building Characteristics	
Height:	<input type="checkbox"/> SF Dwelling	<input type="checkbox"/> SF Townhouse
No. of stories:	Depth	Width
Gross area, sq. ft./floor:	1 st floor:	
	2 nd floor:	
Area of construction (sq. ft.):	Basement:	
	<input type="checkbox"/> Finished Basement	
Use group:	<input type="checkbox"/> Unfinished Basement	
	<input type="checkbox"/> Crawl Space	
	<input type="checkbox"/> Slab on Grade	
Construction type:	No. of Bedrooms:	
<input type="checkbox"/> Reinforced Concrete	Multi-family Dwelling	
<input type="checkbox"/> Structural Steel	No. of efficiency units:	
<input type="checkbox"/> Masonry	No. of 1 BR units:	
<input type="checkbox"/> Wood Frame	No. of 2 BR units:	
<input type="checkbox"/> State Certified Modular	No. of 3 BR units:	
	Other Structure:	
	Dimensions:	
<input checked="" type="checkbox"/> Roadside Tree Project Permit	Footings:	
<input type="checkbox"/> Yes <input checked="" type="checkbox"/> No	Roof:	
Roadside Tree Project Permit #	<input type="checkbox"/> State Certified Modular	
	<input type="checkbox"/> Manufactured Home	

Utilities	
Electric:	<input type="checkbox"/> Yes <input type="checkbox"/> No
Gas:	<input type="checkbox"/> Yes <input type="checkbox"/> No
Water Supply	
<input type="checkbox"/> Public	
<input checked="" type="checkbox"/> Private	
Sewage Disposal	
<input type="checkbox"/> Public	
<input checked="" type="checkbox"/> Private	
Heating System	
<input type="checkbox"/> Electric	<input type="checkbox"/> Oil
<input type="checkbox"/> Natural Gas	<input type="checkbox"/> Propane Gas
<input type="checkbox"/> Other:	
Sprinkler System:	
<input type="checkbox"/> Yes	<input type="checkbox"/> No
Grading Permit Number:	
Building Shell Permit Number:	

THE UNDERSIGNED HEREBY CERTIFIES AND AGREES AS FOLLOWS: (1) THAT HE/SHE IS AUTHORIZED TO MAKE THIS APPLICATION; (2) THAT THE INFORMATION IS CORRECT; (3) THAT HE/SHE WILL COMPLY WITH ALL REGULATIONS OF HOWARD COUNTY WHICH ARE APPLICABLE THERETO; (4) THAT HE/SHE WILL PERFORM NO WORK ON THE ABOVE REFERENCED PROPERTY NOT SPECIFICALLY DESCRIBED IN THE APPLICATION; (5) THAT HE/SHE GRANTS COUNTY OFFICIALS THE RIGHT TO ENTER ONTO THIS PROPERTY FOR THE PURPOSE OF INSPECTING THE WORK PERMITTED AND POSTING NOTICES.

MIKE
 Applicant's Signature
MIKE@LAURELPOOLS.COM
 Email Address
PRESIDENT
 Title/Company

MICHAEL NAILL
 Print Name
2/5/18
 Date

Checks Payable to: DIRECTOR OF FINANCE OF HOWARD COUNTY

PLEASE WRITE NEATLY & LEGIBLY

-FOR OFFICE USE ONLY-

AGENCY	DATE	SIGNATURE OF APPROVAL
State Highways		
Building Officials		
PSZA (Zoning)		
PSZA (Engineering)		
Health	<u>5/17/18</u>	<u>H. Oswald</u>

Is Sediment Control approval required for issuance? Yes No
 CONTINGENCY CONSTRUCTION START

DPZ SETBACK INFORMATION	
Front:	
Rear:	
Side:	
Side St.:	
All minimum setbacks met?	<input type="checkbox"/> Yes <input type="checkbox"/> No
Is Entrance Permit Required?	<input type="checkbox"/> Yes <input type="checkbox"/> No
Historic District?	<input type="checkbox"/> Yes <input type="checkbox"/> No
Lot Coverage for New Town Zone:	
SDP/Red-line approval date:	

Filing Fee	\$
Permit Fee	\$
Tech Fee	\$
Excise Tax	\$
PSFS	\$
Guaranty Fund	\$
Add'l per Fee	\$
Total Fees	\$
Sub- Total Paid	\$
Balance Due	\$
Check	#

Distribution of Copies: White: Building Officials Green: PSZA,Zoning Yellow: PSZA,Engineering Pink: Health Gold: SHA

Lot "J", Chesnut Hills Subdivision,
Fourth District, Howard County, Maryland.



I CERTIFY THE ABOVE MEASUREMENTS AND ELEVATIONS ARE ACTUAL & CORRECT FOR THIS PROPERTY.

SIGNED:

Robert L. Brown

APPROVED
WALK-THRU BUILDING PERMIT
BP#
APP SAN H. O'Scald
DATE: 5/17/15
DESC. OF WORK: Install 16' x 32'
inground pool

968.71


924.84

63-0




400+

129

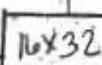

100+

75-0

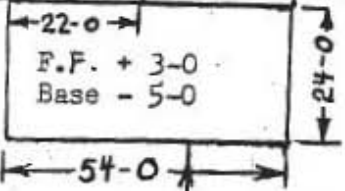

POOL SETBACKS

- FRONT - 14'+
- REAR 400'+
- LEFT 129'+
- RIGHT 100'+

D/W ACCESS

135-0

1025 LONG CORNER RD
MT. AIRY, MD 21771
LOT J CHESNUT HILLS

65-0

Water Well Exist. Elev. = +3-0

115-0

225-0