

6/1/79

01-157759

# PERMIT

SEWAGE DISPOSAL SYSTEM

MARYLAND STATE DEPARTMENT OF HEALTH

HOWARD COUNTY

*File copies*

P 29883

REPAIR

Completed,  
NOT APPROVED

6/1/79

ELLICOTT CITY

CBS/CW

DISTRICT

DATE 6/1/79

*Work NOT APPROVED AS OF 7/95*

*INDEX AS COMPLETE*

INDEXED

*(CW)*

Sadler Plumbing & Heating, Inc.

IS PERMITTED TO INSTALL ALTER X

ADDRESS 1012 Benson Avenue, Baltimore, 21227

PHONE 242-2622

SUBDIVISION ROAD 6385 Lawyers Hill Road LOT

PROPERTY OWNER Al Talbott

ADDRESS 6385 Lawyers Hill Road, ElkrIDGE, Md.

SPECIFICATIONS

SEPTIC TANK CAPACITY \_\_\_\_\_ GALLONS

DRAIN FIELD \_\_\_\_\_ DEPTH \_\_\_\_\_ FEET. BOTTOM AREA \_\_\_\_\_ SQ. FT.

DEEP TRENCH \_\_\_\_\_ DEPTH \_\_\_\_\_ FEET. BOTTOM AREA \_\_\_\_\_ SQ. FT.

SEEPAGE PITS \_\_\_\_\_ ABSORBENT SIDE-WALL AREA \_\_\_\_\_ SQ. FT.

INLET PIPE \_\_\_\_\_ FT. BELOW ORIGINAL GRADE. MAXIMUM DEPTH \_\_\_\_\_ FT. BELOW ORIGINAL GRADE

EFFECTIVE DEPTH AT \_\_\_\_\_ FT. BELOW ORIGINAL GRADE.

LOCATE DISPOSAL AREA \_\_\_\_\_ FT. FROM \_\_\_\_\_ LOT LINE AND \_\_\_\_\_ FT. FROM \_\_\_\_\_ LOT LINE AS SEEN WHEN

FACING LOT FROM *Public water*

REPAIR-CALL FOR INSPECTION WHEN GROUND IS OPENED UP SO SANITARIAN CAN RECOMMEND

REPAIR.

*dryed location - or just check pipe, gravel,  
clean out*

PLANS APPROVED BY Palmer F. Wine *C.B.C.*

DATE 6/1/79

COVER NO WORK UNTIL INSPECTED AND APPROVED.

NEITHER THE HOWARD COUNTY COUNCIL NOR THE HEALTH DEPARTMENT IS RESPONSIBLE FOR THE SUCCESSFUL OPERATION OF ANY SYSTEM.

NOTE: IF TRENCH IS USED CALL FOR INSPECTION BEFORE PLACING GRAVEL IN TRENCH.

NOTE: NO DRY WELL SHALL EXCEED 16 FOOT IN DIAMETER.


NOTE: ALL PIPE FROM HOUSE TO DISPOSAL AREA MUST BE CAST IRON.

PERMIT VOID AFTER THREE YEARS.

NOTE: INSTALL STAND PIPE ON SEPTIC TANK AND DRY WELL. STAND PIPES MUST BE 6 INCHES IN DIAMETER. CAST IRON, CONCRETE OR TERRA COTTA ACCEPTED.

\*INSTALLER IS RESPONSIBLE FOR OBTAINING FINAL APPROVAL ON THIS PERMIT.

P 29883

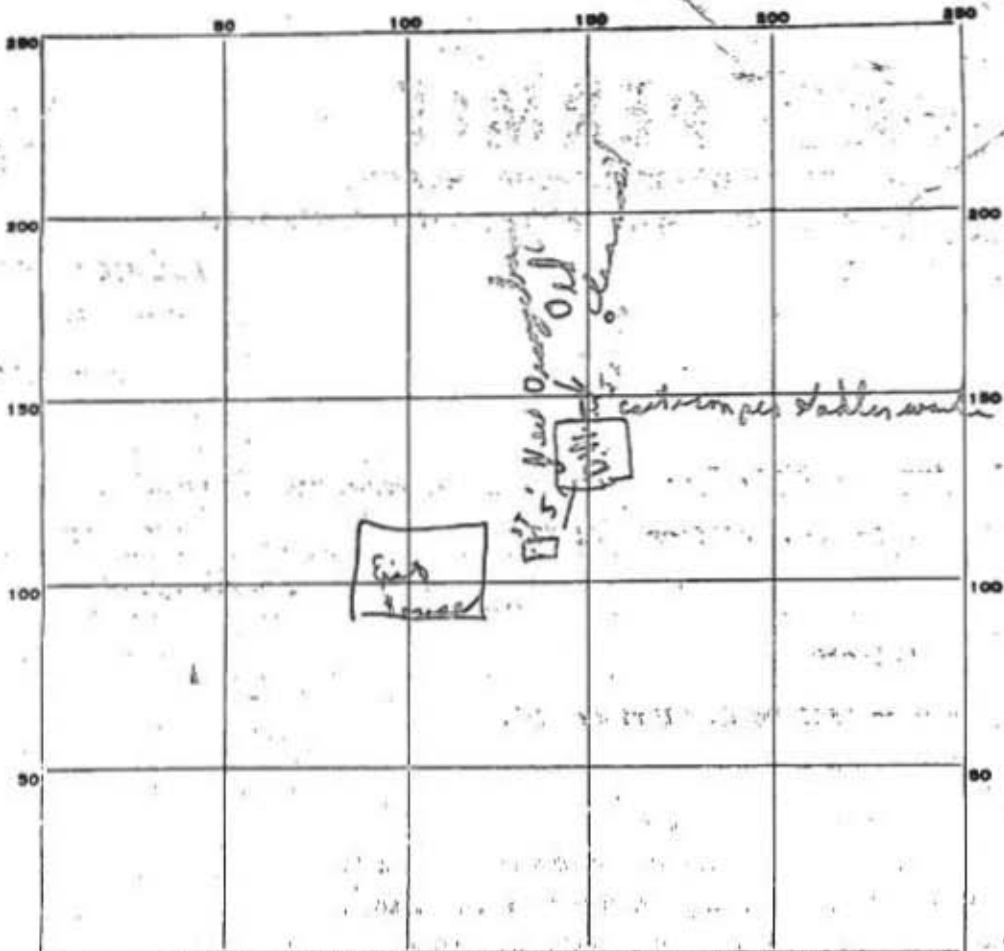

INDICATE NORTH. - NAME ADJOINING ROADWAY AS BASE LINE.

PERMIT CARD \_\_\_\_\_

SEPTIC TANK, LEVEL \_\_\_\_\_ CLEANOUTS New P.W.

DISTRIBUTION BOX, LEVEL \_\_\_\_\_

TILE FIELD, DEPTH \_\_\_\_\_ FT. - TRENCH WIDTH \_\_\_\_\_ FT.

GRAVEL DEPTH \_\_\_\_\_ IN. TOTAL LENGTH \_\_\_\_\_ FT.

NUMBER OF TRENCHES \_\_\_\_\_ TOTAL BOTTOM AREA \_\_\_\_\_

SEEPAGE PITS, INSIDE DIAMETER \_\_\_\_\_ FT. DEPTH BELOW INLET \_\_\_\_\_ FT.

ABSORBENT AREA \_\_\_\_\_ SQ. FT.

REMARKS 6/1/77 Check - paper around the well - septic  
going into dry well. Caution described connected  
on top of dry well. Checked as per F.P. discharging  
on floor. C.B.S.

DATE SYSTEM APPROVED 6/1/79 INSPECTOR CBS/cw

# Repair permit

FILE Installing Illegal Septic System DATE REPORTED 5/31/79

PROPERTY OWNER Talbott

P.O. ADDRESS 6385 Lawyers Hill Road, Elkridge, Md. TELEPHONE \_\_\_\_\_

DIRECTIONS TO PROPERTY \_\_\_\_\_

INFORMANT Man who called did not give name. Stated that he saw backhoe and couple of men which he believes are putting in an illegal system and that it is too close to the adjacent property owner's lot line. Stated this is approximately 1/8th of mile off Montgomery Road. White house behind a brick house with chipped driveway leading to property.

CONDITION FOUND 5/31/79 Saddle Company - Phone - 242-2622  
day well dug - no permit. Stopped work & told  
man to get permit for job & have job inspected. They  
said they would secure permit.

ACTION TAKEN \_\_\_\_\_

FINAL DISPOSITION \_\_\_\_\_