

APPLICATION

A 10454

SEWAGE DISPOSAL TESTING

P _____

MARYLAND STATE DEPARTMENT OF HEALTH

HOWARD COUNTY

ELLICOTT CITY

DISTRICT 6

DATE 6/30/65

*300 sq. ft. 3 bedrooms - 1,000 gal. septic Tank.
Dry well 12 ft. in dia. by 9 ft.
deep below the inlet located 38 ft.
off the front property line and 89 ft. off
the right side property line as seen
when facing the lot from Montown road.
Located inlet 3 ft. below original grade.*

TO: THE COUNTY HEALTH OFFICER
ELLICOTT CITY, MARYLAND

I, HEREBY, APPLY FOR THE NECESSARY TESTS IN ORDER TO CONSTRUCT (OR RECONSTRUCT) A SEWAGE DISPOSAL SYSTEM.

*4 bedrooms - 1,200 gal. septic Tank
Dry well 12 ft. in dia. by 11 ft. deep below
the inlet with location and other specifications
the same as for 3 bedrooms.
min. depth 9 1/2 ft. unless shown otherwise*

PROPERTY OWNER Martellini & Brown

ADDRESS RFD #1 - Montgomery Rd., R. 6. PHONE PA 5-8888

PROPERTY LOCATION:

SUBDIVISION Wellington Estates LOT NO. 7, Blk. A

ROAD AND DESCRIPTION Montown Rd.

OCCUPANT _____ PHONE _____

PERSON TO CONSTRUCT SYSTEM _____

ADDRESS _____ PHONE _____

SIZE OF LOT 34,000 sq. ft. TYPE BLDG. 3 or 4
NUMBER OF BEDROOMS

IF NOT SINGLE RESIDENCE DESCRIBE _____

SIGNATURE OF APPLICANT /s/ Joseph Martellini


APPROVED BY Hennigan FOR Dry Well DATE May 4, 1967
(KIND OF SYSTEM)

REJECTED BY _____ FOR _____ DATE _____
(KIND OF SYSTEM)

HOLD PENDING FURTHER TESTS _____ DATE _____

REASONS FOR REJECTION OR HOLDING _____

THIS IS NOT A PERMIT

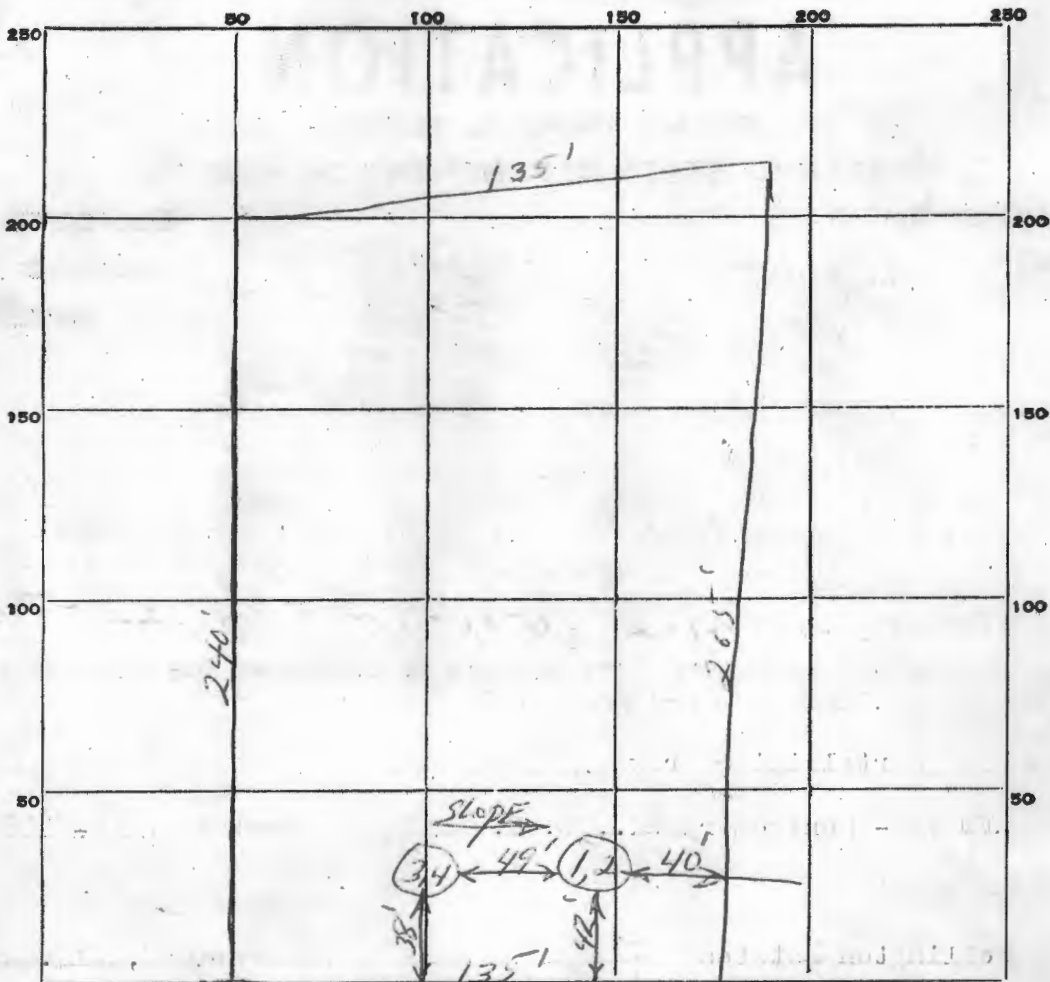

INDICATE NORTH. - NAME ADJOINING ROADWAY AS BASE LINE.

MARTOWN Rd.

DATE	TEST NO.	DEPTH	PRE-WET		TEST - 1" DROP		TIME
			START	STOP	START	STOP	
7-7-65	1 Same	9 1/2'	11:12	11:14	11:14	11:15	1 Min.
	2 Pit.	5'	11:13	11:13 1/2	11:13 1/2	11:14 1/2	1/2 Min.
	3 Same	4'	11:18	11:19	11:19	11:20	1 Min.
	4 Pit.	9'	11:18	11:19	11:19	11:20	1 Min.

as per
Test 1 Min.

SOIL AUGER FINDING Use pit (34) dry well - good all way down.

TESTED BY J.H.J.K.

REMARKS 7-7-65

Real Property Data Search (w3)

Search Result for HOWARD COUNTY

View Map		View GroundRent Redemption				View GroundRent Registration			
Tax Exempt:		Special Tax Recapture:							
Exempt Class:		NONE							
Account Identifier:		District - 06 Account Number - 409644							
Owner Information									
Owner Name:		MAGDAY JOSELITO D & WF			Use:		RESIDENTIAL		
Mailing Address:		7994 MARTOWN RD LAUREL MD 20723-1148			Principal Residence:		YES		
					Deed Reference:		/00790/ 00185		
Location & Structure Information									
Premises Address:		7994 MARTOWN RD LAUREL 20723-0000			Legal Description:		LOT 7 BL A S 2 7994 MARTOWN RD WELLINGTON ESTS		
Map:	Grid:	Parcel:	Sub District:	Subdivision:	Section:	Block:	Lot:	Assessment Year:	Plat No:
0046	0006	0264		0000			7	2017	Plat Ref:
Special Tax Areas:				Town:		NONE			
				Ad Valorem:		104			
				Tax Class:					
Primary Structure Built		Above Grade Living Area		Finished Basement Area		Property Land Area		County Use	
1977		2,592 SF				34,630 SF			
Stories	Basement	Type	Exterior	Full/Half Bath	Garage	Last Major Renovation			
2	NO	SPLIT LEVEL	1/2 BRICK FRAME	2 full/ 1 half	1 Attached				
Value Information									
		Base Value		Value		Phase-in Assessments			
				As of		As of		As of	
				01/01/2017		07/01/2018		07/01/2019	
Land:		177,200		158,800					
Improvements		306,200		263,100					
Total:		483,400		421,900		421,900		421,900	
Preferential Land:		0						0	
Transfer Information									
Seller:		Date:			Price:				
Type:		Deed1:			Deed2:				
Seller:		Date:			Price:				
Type:		Deed1:			Deed2:				
Seller:		Date:			Price:				
Type:		Deed1:			Deed2:				
Exemption Information									
Partial Exempt Assessments:		Class		07/01/2018		07/01/2019			
County:		000		0.00					
State:		000		0.00					
Municipal:		000		0.00 0.00		0.00 0.00			
Tax Exempt:		Special Tax Recapture:							
Exempt Class:		NONE							