

APPLICATION

A 26044

SEWAGE DISPOSAL TESTING

P _____

STATE OF MARYLAND - DEPARTMENT OF HEALTH AND MENTAL HYGIENE

HOWARD COUNTY HEALTH DEPARTMENT
ENVIRONMENTAL HEALTH SERVICES

DISTRICT 3rd

DATE 6/7/77

P. O. BOX 476, ELLICOTT CITY, MARYLAND 21113

S.T. : 3BR - 1000 gal, 4BR - 1250 gal

DW & Trench

The system will contain no less than 125 # of absorbant sidewall area per bedroom. Locate the D.W. _____ ft from

and _____ ft from below O.G. and the max depth of the D.W. will not exceed 10 ft below O.G.

The inv. will enter the DW @ 3 ft. Begin the trench 5 ft from the edge of the DW. and follow the contour of the land. The trench will be 2 ft wide, 10 ft deep, and contain 7 ft of stone.

2 Inspections

DISPOSAL SYSTEM.

PROPERTY OWNER William B. Ridgely

ADDRESS Spring Meadow Farm Cooksville, Md. 21728 PHONE Carol Clark

531-5115
25-26

PROPERTY LOCATION:

SUBDIVISION Ridgely Property (Friendship Manor) LOT NO. 21

ROAD AND DESCRIPTION Rte. 144 - Rte. 32

SIZE OF LOT ? TYPE BLDG. 3 or 4 bedroom
NUMBER OF BEDROOMS

IF NOT SINGLE RESIDENCE DESCRIBE _____

THE SYSTEM INSTALLED UNDER THIS APPLICATION IS ACCEPTABLE ONLY UNTIL PUBLIC FACILITIES BECOME AVAILABLE.

SIGNATURE OF APPLICANT /s/ Albert Scheel


APPROVED BY _____ FOR _____ DATE _____
(KIND OF SYSTEM)

REJECTED BY _____ FOR _____ DATE _____
(KIND OF SYSTEM)

HOLD PENDING FURTHER TESTS _____ DATE _____

REASONS FOR REJECTION OR HOLDING _____

THIS IS NOT A PERMIT

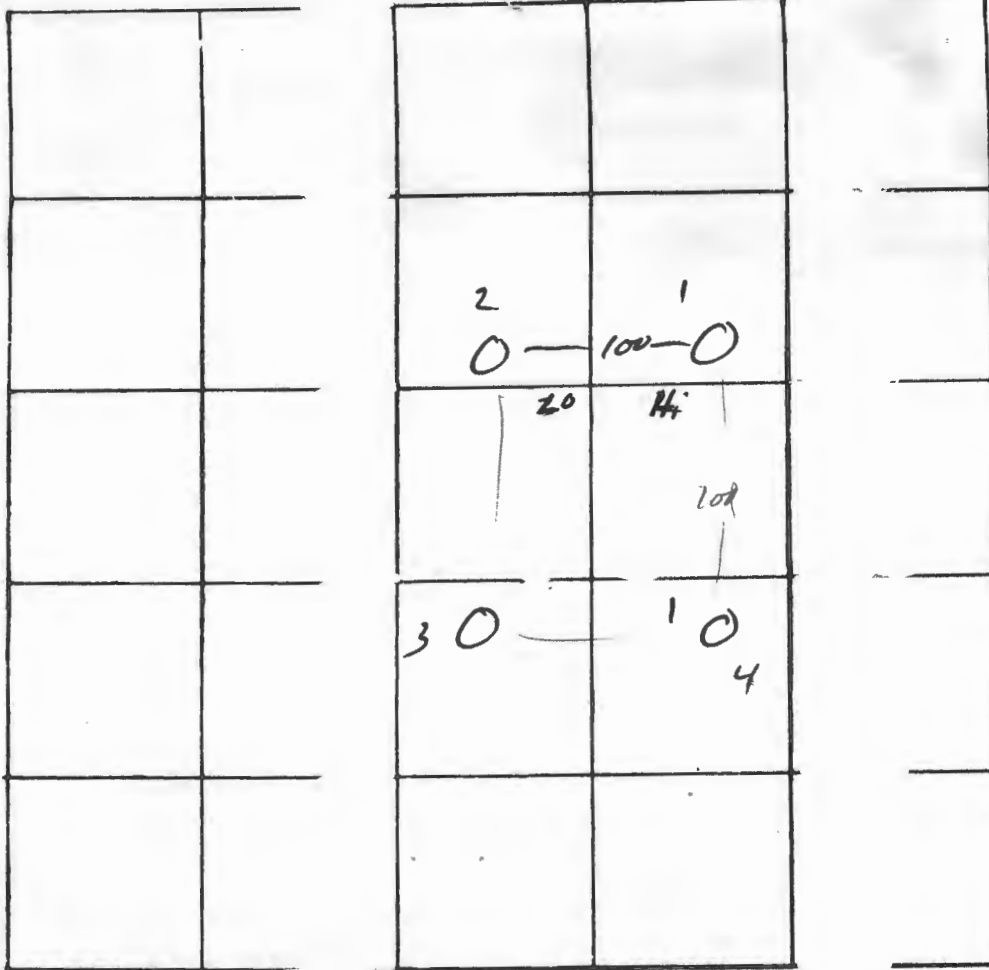

INDICATE I.

NAME ADJOINING ROADWAY AS BASE L.

← RW →

DATE	TEST NO.	DEPTH	PRE-WET		TEST - 1" DROP		TIME
			START	STOP	START	STOP	
30/6/77	1	2	2 ²⁴	2 ²⁵	2 ²⁵	2 ²⁷	2
	1A	13	2 ²⁴	2 ²⁶	2 ²⁶	2 ³¹	5
	2	2	2 ²⁴	2 ²⁷	2 ²⁷	2 ³²	5
	2A	13	2 ²⁴	2 ³⁰	2 ³⁰	2 ⁴²	12
	3	2	2 ²⁴	2 ²⁷	2 ²⁷	2 ³³	5
	3A	13	2 ²⁴	2 ²⁹	2 ²⁹	2 ³⁸	9
	4	12	vis				

REMARKS _____

TYPE OF SOIL _____

TESTED BY M ALSO PRESENT: Scheel

Real Property Data Search (w2)

Search Result for HOWARD COUNTY

View Map		View GroundRent Redemption				View GroundRent Registration			
Tax Exempt:		Special Tax Recapture:							
Exempt Class:		NONE							
Account Identifier:		District - 03 Account Number - 305767							
Owner Information									
Owner Name:		STROUD SANDRA J TRUSTEE				Use:		RESIDENTIAL	
Mailing Address:		2590 LOUANNE CT WEST FRIENDSHIP MD 21794-				Principal Residence:		YES	
						Deed Reference:		/16522/ 00357	
Location & Structure Information									
Premises Address:		2590 LOUANNE CT WEST FRIENDSHIP 21794- 0000				Legal Description:		LOT26 3.490AR S 2 2590 LOUANNE CT FRIENDSHIP MANOR	
Map:	Grid:	Parcel:	Sub District:	Subdivision:	Section:	Block:	Lot:	Assessment Year:	Plat No:
0015	0017	0235		2002			26	2019	Plat Ref:
Special Tax Areas:						Town:		NONE	
						Ad Valorem:		100	
						Tax Class:			
Primary Structure Built		Above Grade Living Area		Finished Basement Area		Property Land Area		County Use	
1988		3,026 SF				3.4900 AC			
Stories	Basement	Type	Exterior	Full/Half Bath	Garage	Last Major Renovation			
2	YES	STANDARD UNIT	FRAME	3 full/ 1 half	1Att/1Det				
Value Information									
		Base Value		Value		Phase-in Assessments			
				As of		As of		As of	
				01/01/2019		07/01/2018		07/01/2019	
Land:		224,400		263,600					
Improvements		380,300		480,100					
Total:		604,700		743,700		604,700		651,033	
Preferential Land:		0						0	
Transfer Information									
Seller: STROUD RALPH J TRUSTEE				Date: 11/02/2015			Price: \$0		
Type: NON-ARMS LENGTH OTHER				Deed1: /16522/ 00357			Deed2:		
Seller: STROUD RALPH J				Date: 09/26/2011			Price: \$0		
Type: NON-ARMS LENGTH OTHER				Deed1: /13459/ 00185			Deed2:		
Seller: MOTSKO M LUCINDA				Date: 07/06/2009			Price: \$585,000		
Type: ARMS LENGTH IMPROVED				Deed1: /11878/ 00430			Deed2:		
Exemption Information									
Partial Exempt Assessments:		Class		07/01/2018		07/01/2019			
County:		000		0.00					
State:		000		0.00					
Municipal:		000		0.00 0.00		0.00 0.00			
Tax Exempt:		Special Tax Recapture:							
Exempt Class:		NONE							