

WATER WELL ABANDONMENT-SEALING REPORT FORM

SUBMIT COPIES OF COMPLETED FORM TO:

- \* COUNTY ENVIRONMENTAL AGENCY (contact MDE, WMA if address needed)
- \* WELL OWNER
- \* MDE, WATER MANAGEMENT ADMINISTRATION, WELL PROGRAM

DATE WELL ABANDONED: 10-28-16 (month/day/year)

\* PERMIT NUMBER OF ABANDONED WELL (if any)

\* PERMIT NUMBER OF REPLACEMENT WELL:

\* PERSON ABANDONING WELL: Allyl Campbell WELL DRILLER'S LICENSE NUMBER: ---  
CIRCLE: MWD / MSD / MGD

\* OWNER'S NAME: David McAvoy

\* WELL LOCATION:  
COUNTY: Howard  
NEAREST TOWN: Zillicott City  
TAX MAP 0024 BLOCK 0008 PARCEL 0629  
SUBDIVISION: Font Hill Manor  
SECTION: 10  
STREET ADDRESS: 3437 Jay Dr.

LATITUDE 39.273178

LONGITUDE 76.854652

\* TYPE OF WELL BEING ABANDONED:

- DRILLED
- BORED
- OTHER (specify) \_\_\_\_\_
- JETTED
- HAND DUG

\* USE CODE:

- DOMESTIC
- IRRIGATION
- TEST/OBSERVATION
- MUNICIPAL/PUBLIC
- INDUSTRIAL
- GEOTHERMAL

\* TYPE OF CASING:

- STEEL
- CONCRETE
- PLASTIC
- OTHER (specify) \_\_\_\_\_

SIZE OF CASING: 6 INCHES IN DIAMETER

DEPTH OF WELL: 60' FEET DEEP

WAS ANY CASING REMOVED?  YES  NO

If yes, length removed, in feet: \_\_\_\_\_

WAS CASING RIPPED OR PERFORATED?  YES  NO

SIGNATURE-MASTER WELL DRILLER OR SUPERVISING SANITARIAN LICENSE# 009

COUNTY

MWD / MSD / MGS

CIRCLE ONE


DATE

10-28-16

APPROVED  
07/01/2016  
(Signature)

N/A  
N/A (any water)

SITE LOCATION MAP

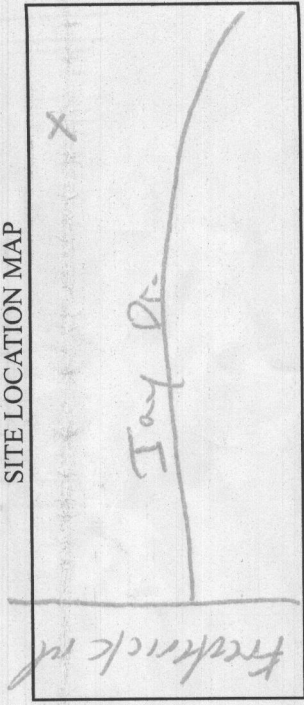

LOG OF SEALING MATERIAL

MATERIAL	FEET	
	FROM	TO
Bentonite	0-2	60
VOLUME OF MATERIAL USED		
17 bags Bentonite (Hole Plug)		

Pursuant to § 10-624 of the State Govt. Article of the Maryland Code, personal info requested on this form is used in processing this form pursuant to COMAR 26.04.04. Failure to provide the info may result in this form not being processed. You have the right to inspect, amend, or correct this form. The Maryland Department of the Environment is subject to the Maryland Public Information Act. This form may be made available on the Internet via MDE's website and is subject to inspection or copying, in whole or in part, by the public and other governmental agencies, if not protected by federal or State Law.

## Real Property Data Search

## Search Result for HOWARD COUNTY

View Map		View GroundRent Redemption		View GroundRent Registration					
<b>Tax Exempt:</b>		<b>Special Tax Recapture:</b>							
<b>Exempt Class:</b>		NONE							
<b>Account Identifier:</b>		<b>District - 02 Account Number - 233371</b>							
Owner Information									
<b>Owner Name:</b>		MCAVOY DAVID S LACY F DESALES T/E		<b>Use:</b> RESIDENTIAL					
<b>Mailing Address:</b>		3437 JAY DR ELLCOTT CITY MD 21042-3635		<b>Principal Residence:</b> YES					
				<b>Deed Reference:</b> /11494/ 00078					
Location & Structure Information									
<b>Premises Address:</b>		3437 JAY DR ELLCOTT CITY 21042-0000		<b>Legal Description:</b> LOT 10 BL A S 1 3437 JAY DR FONT HILL MANOR					
<b>Map:</b>	<b>Grid:</b>	<b>Parcel:</b>	<b>Sub District:</b>	<b>Subdivision:</b>	<b>Section:</b>	<b>Block:</b>	<b>Lot:</b>	<b>Assessment Year:</b>	<b>Plat No:</b>
0024	0008	0629		7206			10	2019	<b>Plat Ref:</b>
<b>Special Tax Areas:</b>				<b>Town:</b>		NONE			
				<b>Ad Valorem:</b>		104			
				<b>Tax Class:</b>					
<b>Primary Structure Built</b>		<b>Above Grade Living Area</b>		<b>Finished Basement Area</b>		<b>Property Land Area</b>		<b>County Use</b>	
1959		2,192 SF				24,175 SF			
<b>Stories</b>	<b>Basement</b>	<b>Type</b>	<b>Exterior</b>	<b>Full/Half Bath</b>	<b>Garage</b>	<b>Last Major Renovation</b>			
2	NO	SPLIT LEVEL	BRICK	3 full	1 Attached				
Value Information									
		<b>Base Value</b>		<b>Value</b>		<b>Phase-in Assessments</b>			
				As of		As of		As of	
				01/01/2019		07/01/2018		07/01/2019	
<b>Land:</b>		177,200		256,500					
<b>Improvements</b>		218,400		210,700					
<b>Total:</b>		395,600		467,200		395,600		419,467	
<b>Preferential Land:</b>		0						0	
Transfer Information									
<b>Seller:</b> MCAVOY DAVID S				<b>Date:</b> 01/29/2009		<b>Price:</b> \$0			
<b>Type:</b> NON-ARMS LENGTH OTHER				<b>Deed1:</b> /11494/ 00078		<b>Deed2:</b>			
<b>Seller:</b> VIA FREDERICK T				<b>Date:</b> 02/05/2002		<b>Price:</b> \$309,900			
<b>Type:</b> ARMS LENGTH IMPROVED				<b>Deed1:</b> /05970/ 00433		<b>Deed2:</b>			
<b>Seller:</b>				<b>Date:</b>		<b>Price:</b>			
<b>Type:</b>				<b>Deed1:</b>		<b>Deed2:</b>			
Exemption Information									
<b>Partial Exempt Assessments:</b>		<b>Class</b>		07/01/2018		07/01/2019			
<b>County:</b>		000		0.00					
<b>State:</b>		000		0.00					
<b>Municipal:</b>		000		0.00 0.00		0.00 0.00			
<b>Tax Exempt:</b>		<b>Special Tax Recapture:</b>							
<b>Exempt Class:</b>		NONE							
Homestead Application Information									