

4-12 holes
104ft apart
12-12, 20ft.

APPLICATION

A 17797

Hold for town, deny plat.
SEWAGE DISPOSAL TESTING

P _____

STATE OF MARYLAND - DEPARTMENT OF HEALTH AND MENTAL HYGIENE

HOWARD COUNTY HEALTH DEPARTMENT
ENVIRONMENTAL HEALTH SERVICES
P. O. BOX 476, ELLICOTT CITY, MARYLAND 21043
TELEPHONE: 465-5000, EXT. 356

DISTRICT 3

DATE 12/14/72

*12/14
1:35 PM*

*accept no more appointments
for this lot. see remarks at bottom of page*

TO: THE COUNTY HEALTH OFFICER
ELLICOTT CITY, MARYLAND

I, HEREBY, APPLY FOR THE NECESSARY TEST IN ORDER TO CONSTRUCT (OR RECONSTRUCT) A SEWAGE DISPOSAL SYSTEM.

PROPERTY OWNER Alva S. Ramsburg, Jr. & Lee Ramsburg
(Contract Purchaser - Albert & Doris Schaffner)
ADDRESS 5091 Cedar Lane, Columbia, Md. PHONE 730-8877

PROPERTY LOCATION:

SUBDIVISION _____ LOT NO. _____

ROAD AND DESCRIPTION Marriottsville Road - approx. 1/4 mile in off Route 99

SIZE OF LOT 9 acres TYPE BLDG. 3

NUMBER OF BEDROOMS
(Single Fmly. Dwlg.)

IF NOT SINGLE RESIDENCE DESCRIBE _____

THE SYSTEM INSTALLED UNDER THIS APPLICATION IS ACCEPTABLE ONLY UNTIL PUBLIC FACILITIES BECOME AVAILABLE.

SIGNATURE OF APPLICANT Doris M. Schaffner


APPROVED BY _____ FOR _____ DATE _____
(KIND OF SYSTEM)

REJECTED BY D.W. Managhan FOR Septic DATE 12-27-72
(KIND OF SYSTEM)

HOLD PENDING FURTHER TESTS _____ DATE _____

REASONS FOR REJECTION OR HOLDING 12-27-72 - no perc. - high
water table - not enough room left for
10000 sq ft perc area

THIS IS NOT A PERMIT

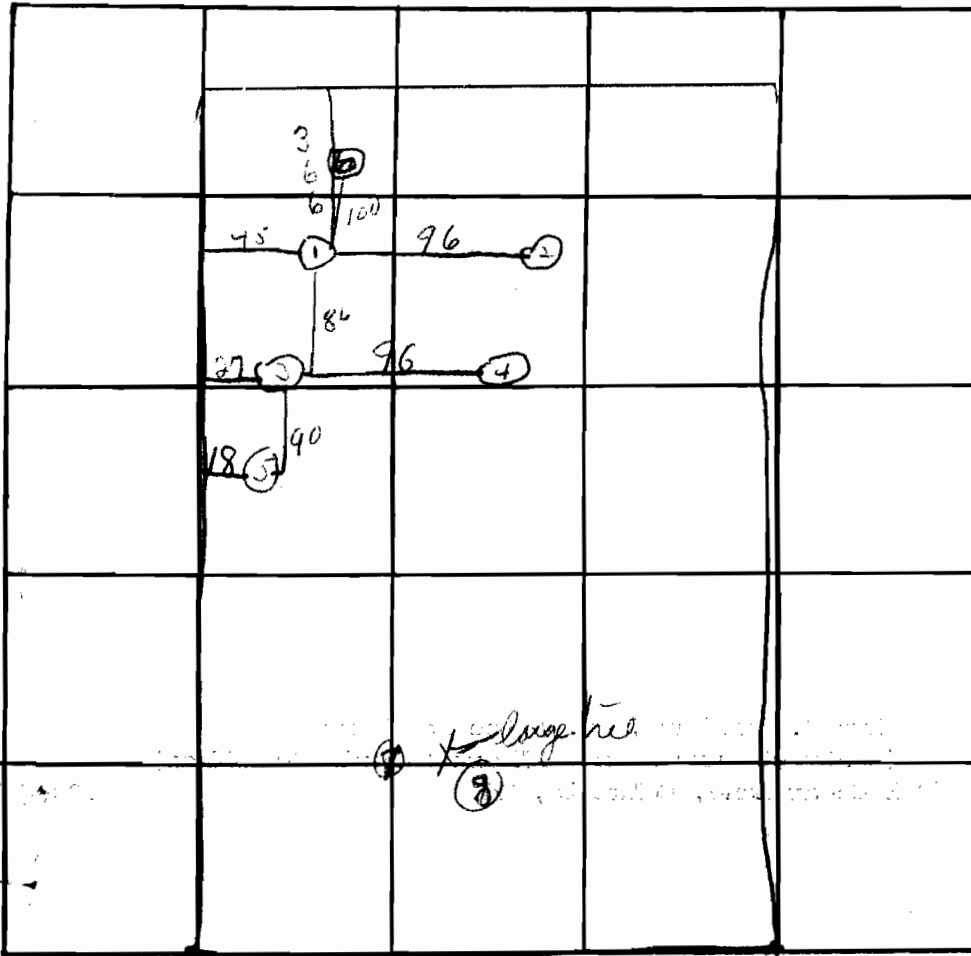

INDICATE NORTH - NAME ADJOINING ROADWAY AS BASE LINE.

Main trunk ①

DATE	TEST NO.	DEPTH	PRE-WET		TEST - 1" DROP		TIME
			START	STOP	START	STOP	
12/2/12	1	10ft	water	at 10ft			
	2		water	at 10ft			
	3	14ft	water	at 14ft	from grade		
	4		water	at 8 1/2ft	from grade		
	5		water	at 6ft	from grade		
	6	13ft	13ft	1st part of wet clay type	then clay -	the 1st 5 and 4 ft	
	7		hit	water	at 9ft	when	
	8		dig	in	ms Balth		

REMARKS _____

TYPE OF SOIL _____

TESTED BY _____ ALSO PRESENT: _____

APPLICATION

A 17797

SEWAGE DISPOSAL TESTING

P _____

STATE OF MARYLAND - DEPARTMENT OF HEALTH AND MENTAL HYGIENE

HOWARD COUNTY HEALTH DEPARTMENT
ENVIRONMENTAL HEALTH SERVICES
P. O. BOX 476, ELLICOTT CITY, MARYLAND 21043
TELEPHONE: 465-5000, EXT. 356

DISTRICT 3

DATE 12/14/72

TO: THE COUNTY HEALTH OFFICER
ELLICOTT CITY, MARYLAND

I, HEREBY, APPLY FOR THE NECESSARY TEST IN ORDER TO CONSTRUCT (OR RECONSTRUCT) A SEWAGE DISPOSAL SYSTEM.

PROPERTY OWNER Alva S. Ramsburg, Jr. & Lee Ramsburg
(Contract Purchaser - Albert & Doris Schaffner)
ADDRESS 5091 Cedar Lane, Columbia, Md. PHONE 730-8877

PROPERTY LOCATION:

SUBDIVISION _____ LOT NO. _____

ROAD AND DESCRIPTION Marriottsville Road - approx. 1/4 mile in off Route 99

SIZE OF LOT 9 acres TYPE BLDG. 3

NUMBER OF BEDROOMS
(Single Fmly. Dwlg.)

IF NOT SINGLE RESIDENCE DESCRIBE _____

THE SYSTEM INSTALLED UNDER THIS APPLICATION IS ACCEPTABLE ONLY UNTIL PUBLIC FACILITIES BECOME AVAILABLE.

SIGNATURE OF APPLICANT Doris M. Schaffner


APPROVED BY _____ FOR _____ DATE _____
(KIND OF SYSTEM)

REJECTED BY _____ FOR _____ DATE _____
(KIND OF SYSTEM)

HOLD PENDING FURTHER TESTS _____ DATE _____

REASONS FOR REJECTION OR HOLDING _____

THIS IS NOT A PERMIT

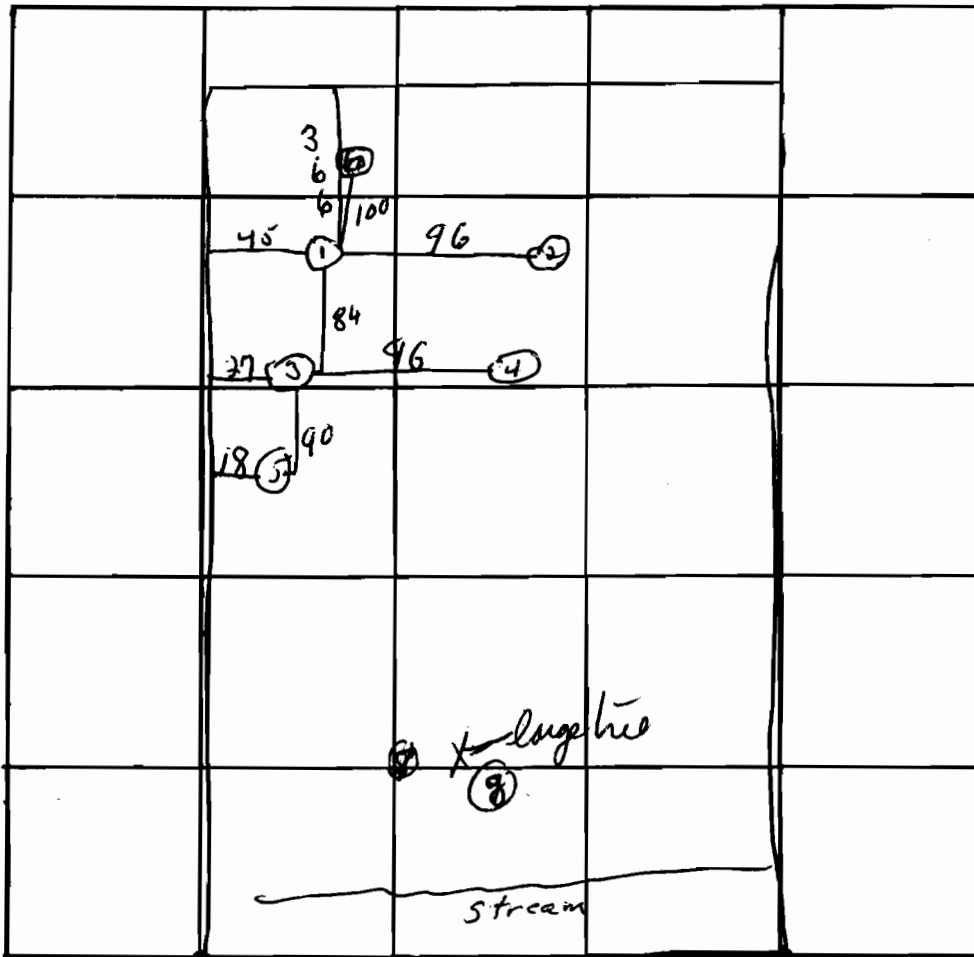

INDICATE NORTH. - NAME ADJOINING ROADWAY AS BASE LINE.

Marionville Rd

DATE	TEST NO.	DEPTH	PRE-WET		TEST - 1" DROP		TIME	
			START	STOP	START	STOP		
12/27/72	1	10ft.	water at 10 ft					
	2		water at 10 ft					
	3	14ft	water at 10 ft from grade					
	4		water at 8 1/2 ft from grade					
	5		water at 6 ft from grade					
	6	13ft	first 6ft wet plug broke		the top 6ft was 4 ft			
			then clay - very wet		no perc.			
	7		lit water at 7ft when					
	8		dup per m Booth					

REMARKS _____

TYPE OF SOIL _____

TESTED BY _____ ALSO PRESENT: _____