

FILL OUT IN TRIPLICATE.
MAKE CHECK PAYABLE TO:
HOWARD COUNTY HEALTH DEPT.-

APPLICATION

A 04785

SANITATION

SEWAGE DISPOSAL TESTING

P _____

FEE FOR APPLICATION- MARYLAND STATE DEPARTMENT OF HEALTH

\$15.00

HOWARD COUNTY

ELLICOTT CITY

300 sq. ft. of tile field located on rear of lot 1454 from the front property line. Depth of trenches 3 1/2 ft., running across slope, with fall out trench of 1 inch every 30 ft. 750 gal septic tank.

DISTRICT 3

DATE 2/8/62

TO: THE COUNTY HEALTH OFFICER
ELLICOTT CITY, MARYLAND

I, HEREBY, APPLY FOR THE NECESSARY TESTS IN ORDER TO CONSTRUCT (OR RECONSTRUCT) A SEWAGE DISPOSAL SYSTEM.

✓ PROPERTY OWNER ALLEN M. HALL + MARY N. HALL
✓ ADDRESS 1454 STEVENSON ST. BALTO 30 ✓ PHONE PL-2-1033

PROPERTY LOCATION:

✓ SUBDIVISION OF AUSTERNITZ FARM ✓ LOT NO. LOT #1

✓ ROAD AND DESCRIPTION THE LOT FRONTING AND LYING ON THE EAST SIDE OF MARIOTTSVILLE ROAD ADJOINING PROPERTY OF B. HENRY GERMAN JR

OCCUPANT _____ PHONE _____

PERSON TO CONSTRUCT SYSTEM _____

ADDRESS / PHONE _____

✓ SIZE OF LOT 102 FT X 400 FT. ✓ TYPE BLDG. 3 BEDROOMS
NUMBER OF BEDROOMS

IF NOT SINGLE RESIDENCE DESCRIBE _____

✓ SIGNATURE OF APPLICANT Allen M Hall


APPROVED BY Janet Hennigan FOR Tilefield DATE 2-20-62
(KIND OF SYSTEM)

REJECTED BY _____ FOR _____ DATE _____
(KIND OF SYSTEM)

HOLD PENDING FURTHER TESTS _____ DATE _____

REASONS FOR REJECTION OR HOLDING _____

THIS IS NOT A PERMIT

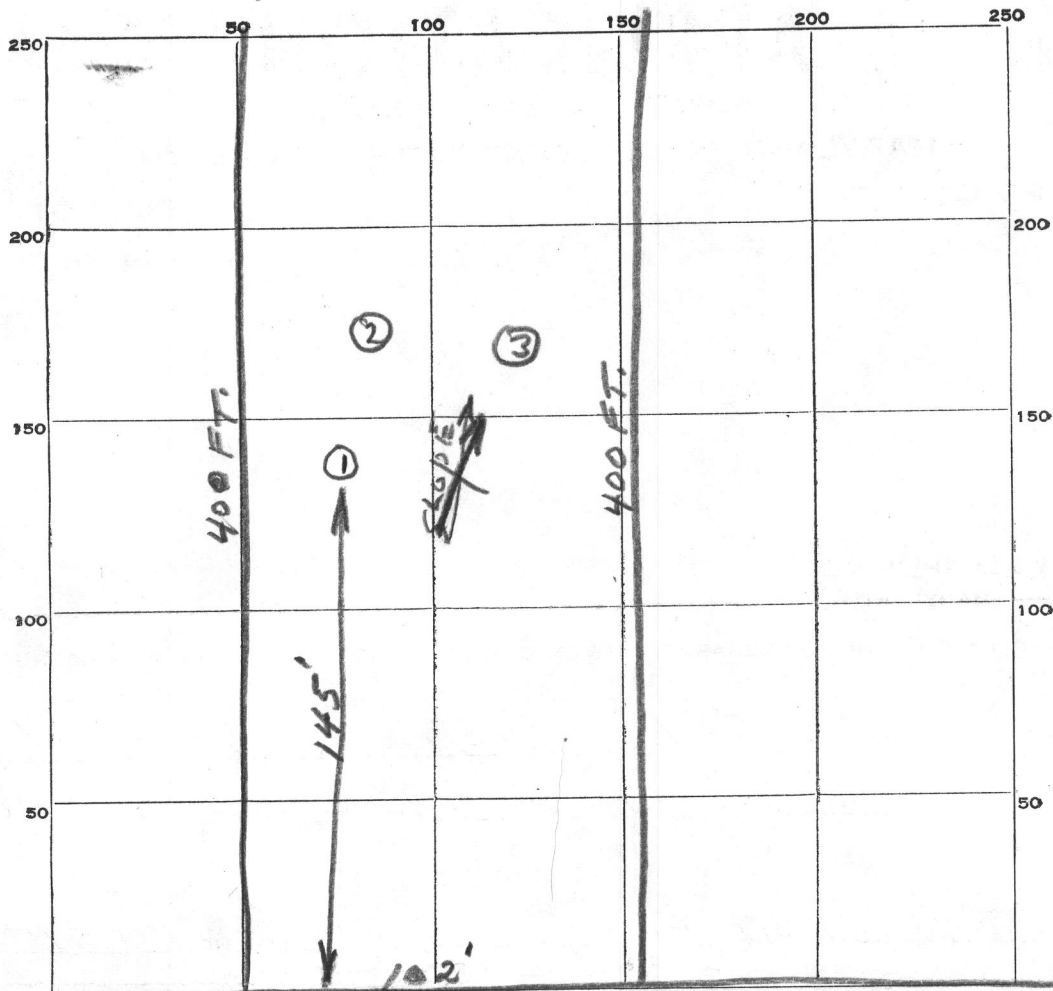

INDICATE NORTH. - NAME ADJOINING ROADWAY AS BASE LINE.

MARIOTTVILLE ROAD

DATE	TEST NO.	DEPTH	PRE-WET		TEST - 1" DROP		TIME
			START	STOP	START	STOP	
2-20-62	1	3' 4'	9:44	9:47	9:47	9:58	11 Min.
	2	3' 10"	9:56	10:11	10:31	10:31	20 Min.
	3	3' 4"	9:58	10:00	10:00	10:03	3 Min.

SOIL AUGER FINDING _____

TESTED BY JH.

REMARKS Take field depth 3 1/2 FT. Field to run across slope

2-20-62
ALSO PRESENT J. Emerson Leaga

LOT NO. 1