



Building Permit Application

Howard County Maryland
Department of Inspections, Licenses and Permits
3430 Court House Drive
Permits: 410-313-2455
www.howardcountymd.gov

Date Received: _____

Permit No.: _____

Building Address: 1885 LONG CORNER Rd
City: MT AIRY State: MD Zip Code: 21771
Suite/Apt. #: _____ SDP/WP/BA #: _____
Subdivision: WC FISHER SUB
Lot: 1 Tax Map: 0006 Parcel: 0218

Existing Use: HORSE BARN
Proposed Use: 1 HORSE BARN
Estimated Construction Cost: \$ 60,000
Description of Work: 36 X 36 POLE BARN
W/ LOFT.

Occupant/Tenant Name: MICHAEL HALEY
Was tenant space previously occupied? ☐ Yes ☐ No
Contact Name: _____
Address: _____
City: _____ State: _____ Zip Code: _____
Phone: _____ Fax: _____
Email: _____

Property Owner's Name: MICHAEL HALEY
Address: 1885 LONG CORNER Rd.
City: MT AIRY State: MD Zip Code: 21771
Phone: 301-587-5186 Fax: _____
Email: _____

Applicant's Name & Mailing Address, (if other than stated herein)
Applicant's Name: JOHN W PFAFF BLDG INC
Address: 15119 DAR ORCHARD Rd
City: NEW WINDSOR State: MD Zip Code: 21776
Phone: 410-875-6640 Fax: 410-875-6564
Email: PFAFF BUILD @ AOL.COM

Contractor Company: JOHN W PFAFF BLDG INC
Contact Person: ALAN
Address: 4211 RIDGE Rd
City: WEST State: MD Zip Code: 21157
License No.: 11642
Phone: 410-875-6640 Fax: 410-875-6564
Email: PFAFF BUILD @ AOL.COM

Engineer/Architect Company: _____
Responsible Design Prof.: _____
Address: _____
City: _____ State: _____ Zip Code: _____
Phone: _____ Fax: _____
Email: _____

Commercial Building Characteristics	Residential Building Characteristics
Height:	☐ SF Dwelling ☐ SF Townhouse
No. of stories:	Depth Width
Gross area, sq. ft./floor:	1 st floor:
	2 nd floor:
Area of construction (sq. ft.):	Basement:
	☐ Finished Basement
Use group:	☐ Unfinished Basement
	☐ Crawl Space
Construction type:	☐ Slab on Grade
☐ Reinforced Concrete	No. of Bedrooms:
☐ Structural Steel	Multi-family Dwelling
☐ Masonry	No. of efficiency units:
☐ Wood Frame	No. of 1 BR units:
☐ State Certified Modular	No. of 2 BR units:
	No. of 3 BR units:
	Other Structure:
	Dimensions:
> Roadside Tree Project Permit	Footings:
☐ Yes ☐ No	Roof:
Roadside Tree Project Permit #	☐ State Certified Modular
	☐ Manufactured Home

Utilities
Electric: ☒ Yes ☐ No
Gas: ☐ Yes ☐ No
Water Supply
☐ Public
☒ Private
Sewage Disposal
☐ Public
☒ Private
Heating System
☐ Electric ☐ Oil
☐ Natural Gas ☐ Propane Gas
☐ Other:
Sprinkler System:
☐ Yes ☐ No
Grading Permit Number:
Building Shell Permit Number:

THE UNDERSIGNED HEREBY CERTIFIES AND AGREES AS FOLLOWS: (1) THAT HE/SHE IS AUTHORIZED TO MAKE THIS APPLICATION; (2) THAT THE INFORMATION IS CORRECT; (3) THAT HE/SHE WILL COMPLY WITH ALL REGULATIONS OF HOWARD COUNTY WHICH ARE APPLICABLE THERETO; (4) THAT HE/SHE WILL PERFORM NO WORK ON THE ABOVE REFERENCED PROPERTY NOT SPECIFICALLY DESCRIBED IN THIS APPLICATION; (5) THAT HE/SHE GRANTS COUNTY OFFICIALS THE RIGHT TO ENTER ONTO THIS PROPERTY FOR THE PURPOSE OF INSPECTING THE WORK PERMITTED AND POSTING NOTICES.

Applicant's Signature: John W PFAFF
Email Address: PFAFF BUILD @ AOL.COM
Title/Company: PRESIDENT

Print Name: John W PFAFF
Date: 7/18/19

Checks Payable to: DIRECTOR OF FINANCE OF HOWARD COUNTY

PLEASE WRITE NEATLY & LEGIBLY
-FOR OFFICE USE ONLY-

AGENCY	DATE	SIGNATURE OF APPROVAL
State Highways		
Building Officials		
PSZA (Zoning)		
PSZA (Engineering)		
Health		

Is Sediment Control approval required for issuance? ☐ Yes ☐ No
☐ CONTINGENCY CONSTRUCTION START

DPZ SETBACK INFORMATION


Front: _____
Rear: _____
Side: _____
Side St.: _____
All minimum setbacks met? ☐ Yes ☐ No
Is Entrance Permit Required? ☐ Yes ☐ No
Historic District? ☐ Yes ☐ No
Lot Coverage for New Town Zone: _____
SDP/Red-line approval date: _____

Filing Fee	\$
Permit Fee	\$
Tech Fee	\$
Excise Tax	\$
PSFS	\$
Guaranty Fund	\$
Add'l per Fee	\$
Total Fees	\$
Sub- Total Paid	\$
Balance Due	\$
Check	#

Distribution of Copies: White: Building Officials Green: PSZA,Zoning Yellow: PSZA,Engineering Pink: Health Gold: SHA

MD1405.4256
 LOCATION DRAWING
 LOT 1
 JNO. FISHER
 HOWARD COUNTY, MARYLAND
 26-21-2014 SCALE 1"=120'


1885 LONG CORNER RD.
 MT AIRY MD 21771
 MICHAEL HALEY
 301 807 5186

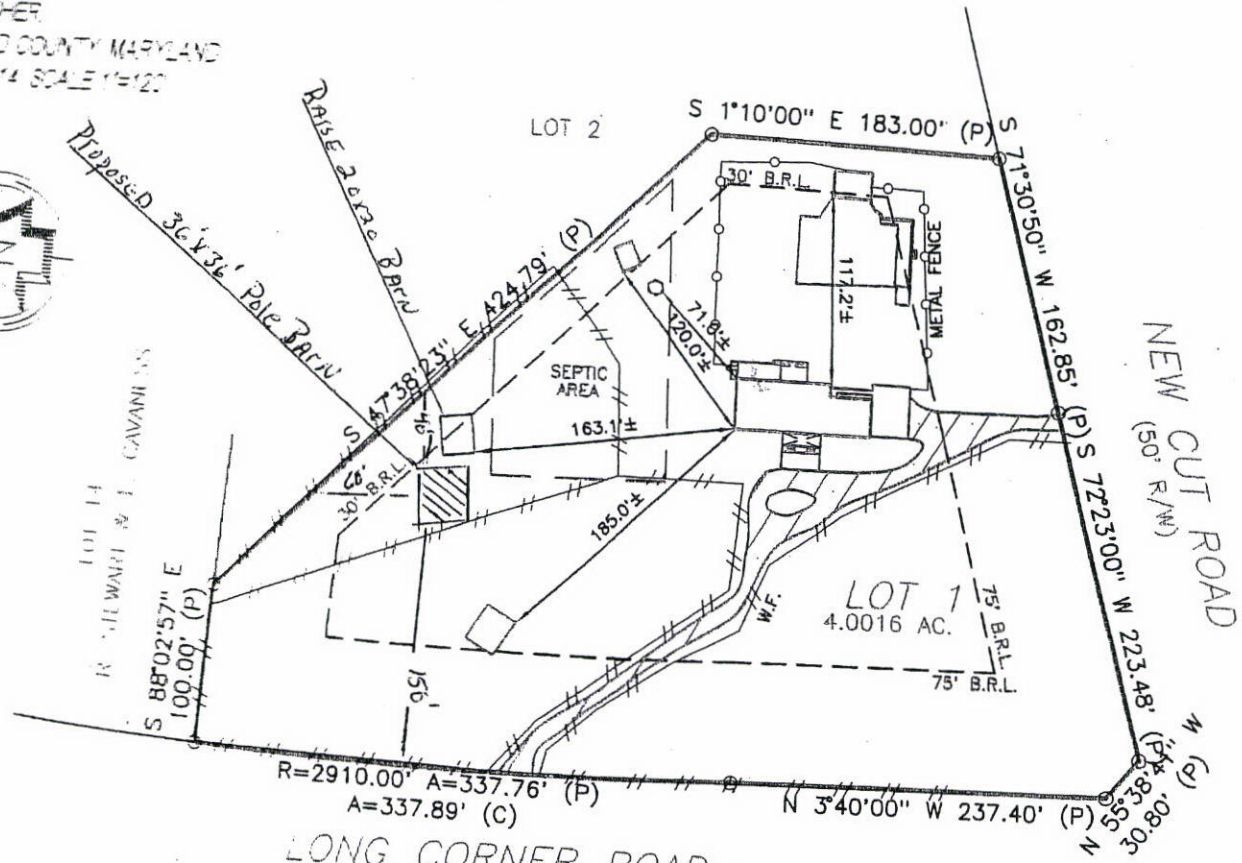

GRAPHIC SCALE (In Feet)
 1 inch = 120' ft.
 ACCURACY=3±



William J. Hale
 EXPIRES 1-14-2015

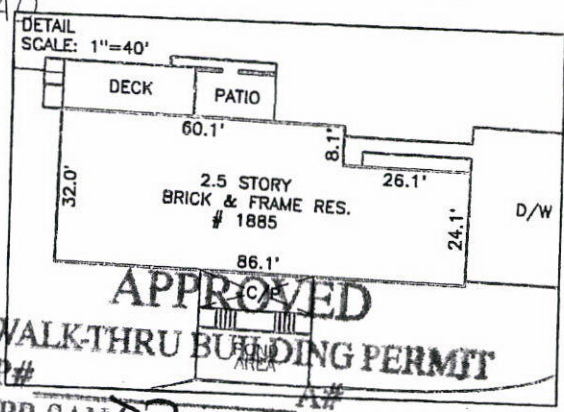

APPROVED
 WALK-THRU BUILDING PERMIT
 BR# _____
 APP. SANDBURN DATE: 7-19-19
 DESC. OF WORK: Pole Barn
 Approved As Shown

PTS OF INTEREST
 WE VISIBLE


EXT NUMBER: 141004
 DATE: 6/24/2014
 PER: MICHAEL HALEY
 LER: STEVEN AND WENDY DUNKLEBERGER
 ITIED TO:

2910.00	337.76	6°39'01"	169.07	N00°20'30"W	337.57
---------	--------	----------	--------	-------------	--------

ORDINATES	
NORTH	EAST
01.46	10540.72
82.86	9985.65
20.43	9983.63
21.01	10002.46
96.21	10239.29
02.38	10556.86
21.55	10634.69
47.85	10393.74
67.78	10400.25
97.00	10285.00
93.18	10103.45
16.21	10107.64

JACK D. BROOKMAN SUBDIVISION
PLATS 4492 & 5692

LONG-CORNER-ROAD (60' R/W)

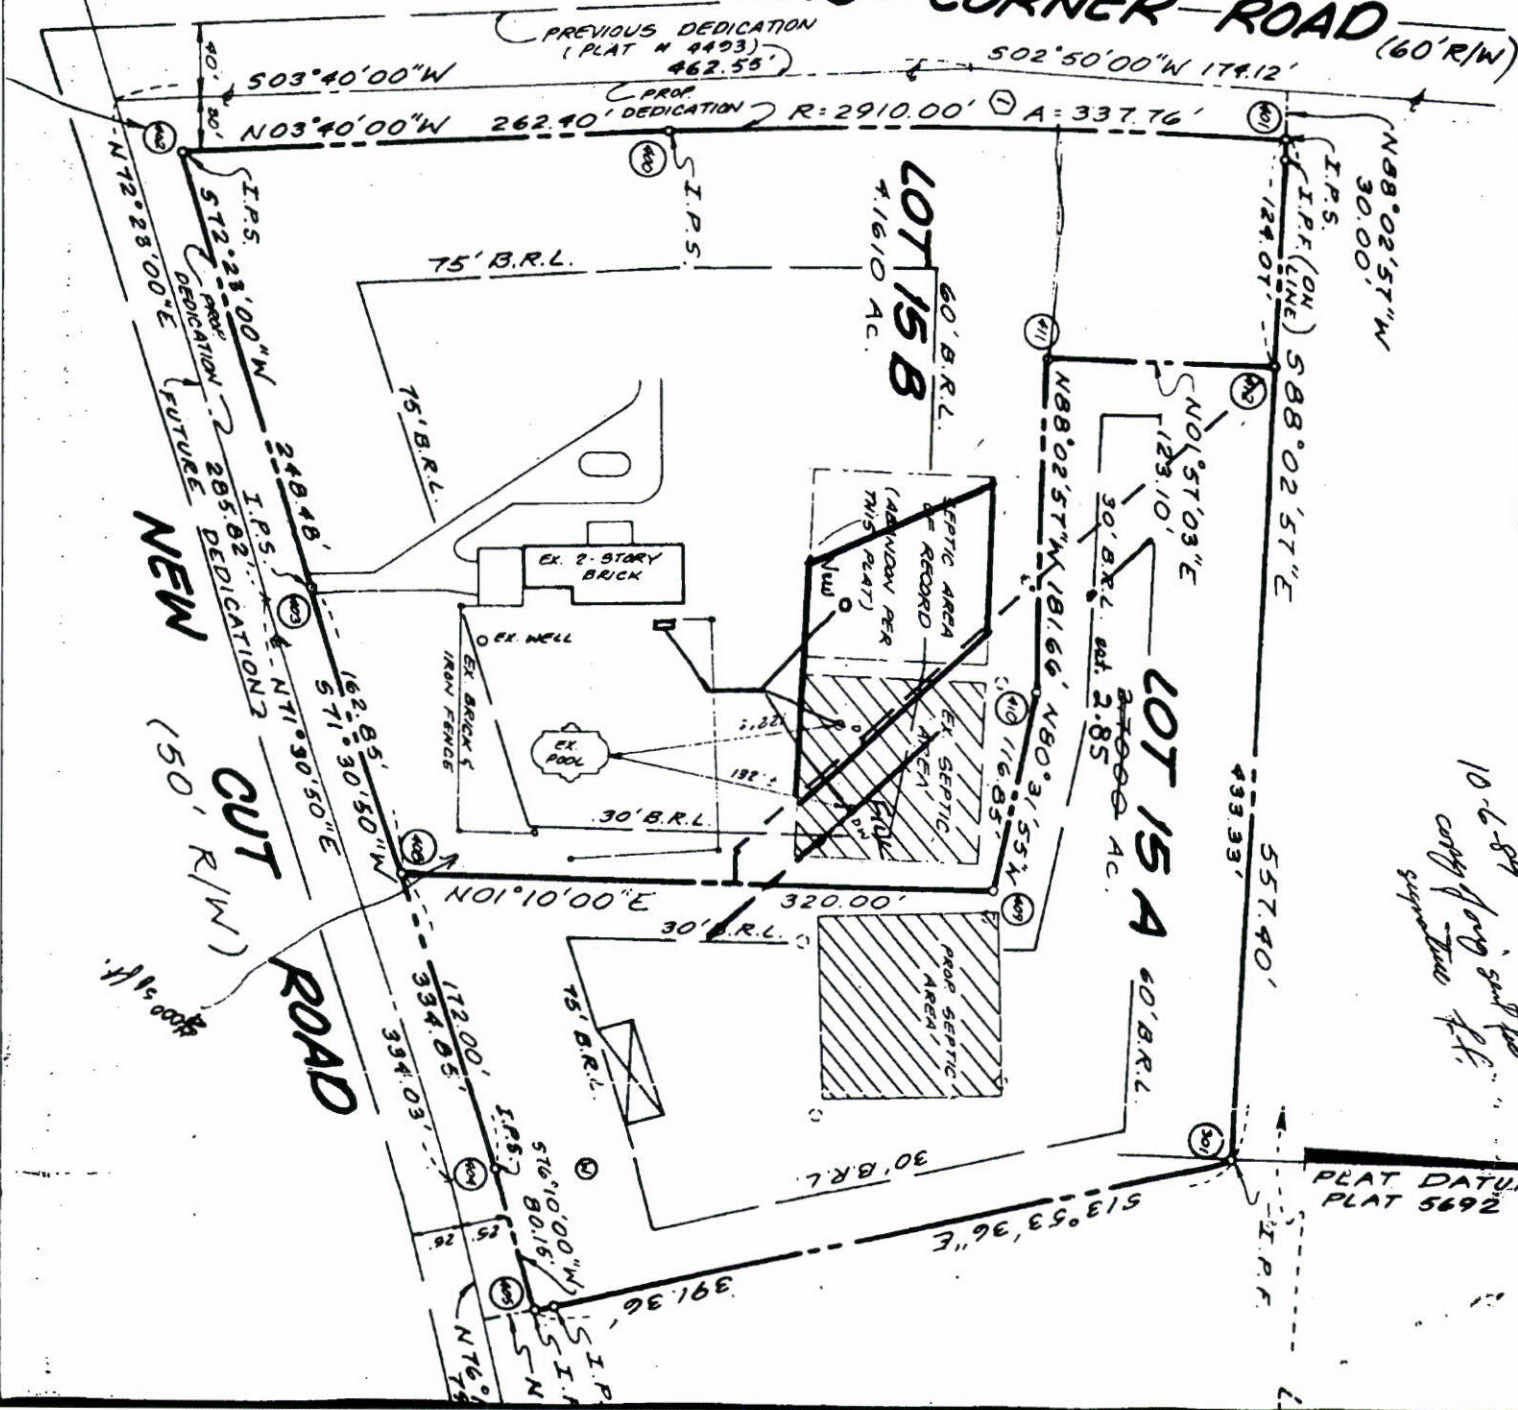

10-6-89
copy of long corner plat
submitted for file