

KB 8/26/19

Search Result for HOWARD COUNTY

[View Map](#) [View GroundRent Redemption](#) [View GroundRent Registration](#)

Tax Exempt: **Special Tax Recapture:**
Exempt Class: NONE
Account Identifier: **District - 05 Account Number - 404622**

Owner Information

Owner Name: WHITE JEREMY P **Use:** RESIDENTIAL
 WHITE KRISTA **Principal Residence:** YES
Mailing Address: 6154 JERRYS DR **Deed Reference:** /16986/ 00022
 COLUMBIA MD 21044-3825

Location & Structure Information

Premises Address: 6154 W JERRYS DR **Legal Description:** LOT 5 .5292 A
 COLUMBIA 21044-0000 6154 JERRYS DR
 OWEN BROWN VOTTA SUB

Map:	Grid:	Parcel:	Sub District:	Subdivision:	Section:	Block:	Lot:	Assessment Year:	Plat No:	7162
0035	0012	0413		3003			5	2020	Plat Ref:	

Special Tax Areas: **Town:** NONE
Ad Valorem: 104
Tax Class:

Primary Structure Built	Above Grade Living Area	Finished Basement Area	Property Land Area	County Use
1988	1,824 SF	600 SF	23,043 SF	

Stories	Basement	Type	Exterior	Full/Half Bath	Garage	Last Major Renovation
2	YES	STANDARD UNIT	WOOD SHINGLE	3 full/ 1 half	1 Attached	

Value Information

	Base Value	Value As of 01/01/2017	Phase-in Assessments	
			As of 07/01/2019	As of 07/01/2020
Land:	233,900	233,900		
Improvements	209,600	209,600		
Total:	443,500	443,500	443,500	
Preferential Land:	0			

Transfer Information

Seller: HOWELL STEPHEN S	Date: 07/18/2016	Price: \$463,000
Type: ARMS LENGTH IMPROVED	Deed1: /16986/ 00022	Deed2:
Seller: UNITED GENERAL CONTRACTORS INC	Date: 11/10/1988	Price: \$195,000
Type: ARMS LENGTH IMPROVED	Deed1: /01913/ 00600	Deed2:
Seller: JRD LIMITED PARTNERSHIP	Date: 05/28/1987	Price: \$130,000
Type: NON-ARMS LENGTH OTHER	Deed1: /01660/ 00370	Deed2:

Exemption Information

Partial Exempt Assessments:	Class	07/01/2019	07/01/2020
County:	000	0.00	
State:	000	0.00	
Municipal:	000	0.00	0.00

Tax Exempt: **Special Tax Recapture:**
Exempt Class: NONE

Homestead Application Information

Homestead Application Status: Approved 12/19/2017

Homeowners' Tax Credit Application Status: No Application

Date:

1. This screen allows you to search the Real Property database and display property records.
2. Click [here](#) for a glossary of terms.
3. Deleted accounts can only be selected by Property Account Identifier.
4. The following pages are for information purpose only. The data is not to be used for legal reports or documents. While we have confidence in the accuracy of these records, the Department makes no warranties, expressed or implied, regarding the information.

APPLICATION

A 03589

SEWAGE DISPOSAL TESTING

F _____

MARYLAND STATE DEPARTMENT OF HEALTH

HOWARD COUNTY

ELLICOTT CITY

Please fill out in triplicate and return to this office with a \$15 check made payable to the:

DISTRICT 5

HOWARD COUNTY HEALTH DEPT. - SANITATION

DATE 4-18-61

SEPTIC TANK - 750 gallon capacity for 3 bedrooms or less.
LEACHING BED - 648 square feet - to be installed in the area tested.

TO: THE COUNTY HEALTH OFFICER
ELLICOTT CITY, MARYLAND

I, HEREBY, APPLY FOR THE NECESSARY TESTS IN ORDER TO CONSTRUCT (OR RECONSTRUCT) A SEWAGE DISPOSAL SYSTEM.

PROPERTY OWNER Norman P. Uhl

ADDRESS 5419 55th Place, Riverdale, Md. PHONE UN 4-2810

PROPERTY LOCATION: Block "A" as recorded among the land records of Howard County, Md., in R.H.M. Plot Book No. 5, folio 15, on Aug. 18, 1956
SUBDIVISION Lot No. 3 LOT NO. 3

ROAD AND DESCRIPTION Northwest corner of Owen Brown Road and Jerry's Drive, Atholton, Maryland

OCCUPANT _____ PHONE _____

PERSON TO CONSTRUCT SYSTEM _____

ADDRESS _____ PHONE _____

SIZE OF LOT 3 1/4 acres TYPE BLDG. 3 NUMBER OF BEDROOMS

IF NOT SINGLE RESIDENCE DESCRIBE _____

SIGNATURE OF APPLICANT Norman Uhl


APPROVED BY Walton J. Levy FOR LEACHING BED DATE 4/19/61
(KIND OF SYSTEM)

REJECTED BY _____ FOR _____ DATE _____
(KIND OF SYSTEM)

HOLD PENDING FURTHER TESTS _____ DATE _____

REASONS FOR REJECTION OR HOLDING _____

THIS IS NOT A PERMIT

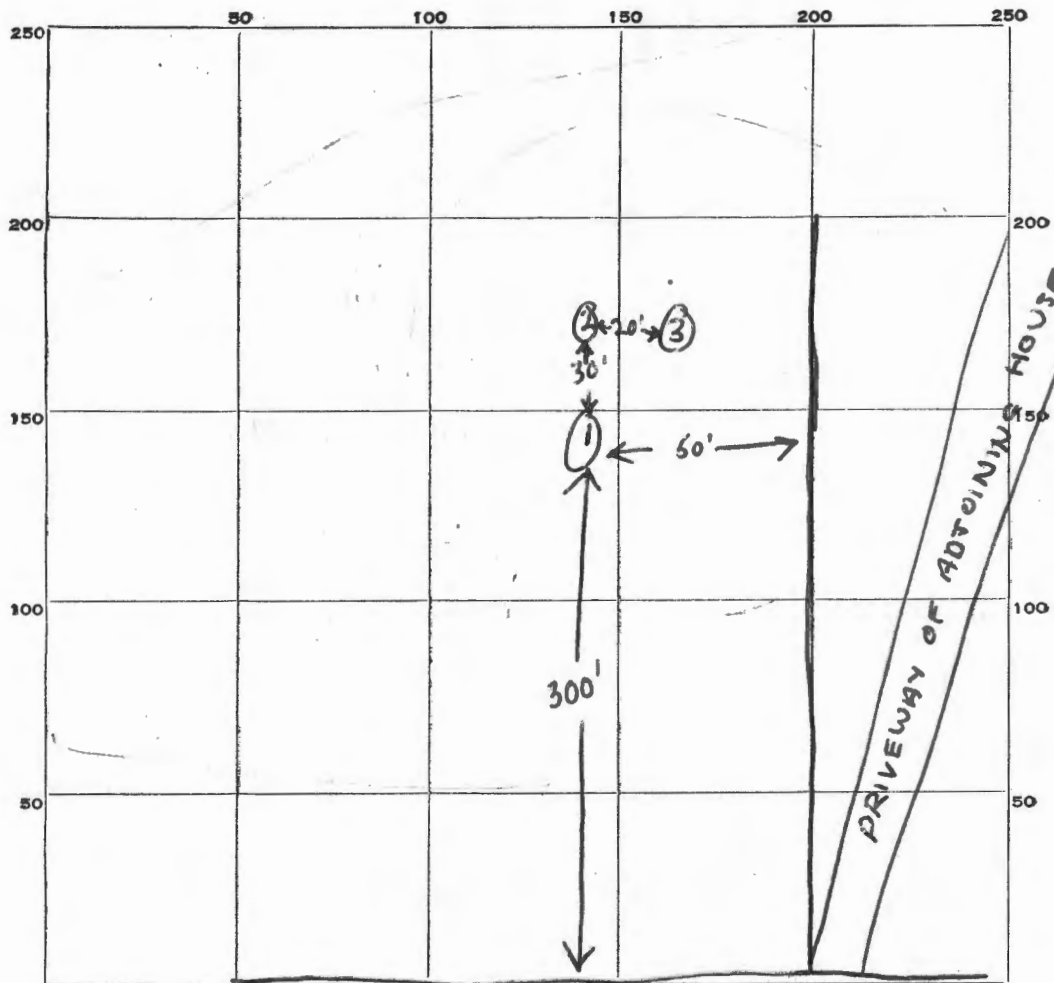

INDICATE NORTH. - NAME ADJOINING ROADWAY AS BASE LINE.

JERRY'S DRIVE

DATE	TEST NO.	DEPTH	PRE-WET		TEST - 1" DROP		TIME
			START	STOP	START	STOP	
4/19/61	1	4'	936	942	942	952	10 min
4/19/61	2	3'	938	1001	1001	1029	28 min
4/19/61	3	3'	939	1015	1015	—	40 min

} 78 min total
26 min average

SOIL AUGER FINDING _____
 TESTED BY Walter J. Jerry
 REMARKS _____
 ALSO PRESENT Walter R. Richette LOT NO. _____