



# Building Permit Application

Howard County Maryland  
Department of Inspections, Licenses and Permits  
3430 Court House Drive  
Permits: 410-313-2455  
www.howardcountymd.gov

Date Received: \_\_\_\_\_

Permit No.: B19002177

Building Address: 6674 LUSTER DRIVE  
City: MIDDLEBURY State: MD Zip Code: 20777  
Suite/Apt. # \_\_\_\_\_ SDP/WP/BA #: \_\_\_\_\_  
Subdivision: \_\_\_\_\_  
Lot: \_\_\_\_\_ Tax Map: \_\_\_\_\_ Parcel: \_\_\_\_\_

Existing Use: FINISHED WORK  
Proposed Use: 2 NEW BEDROOMS  
Estimated Construction Cost: \$ 30,000

Description of Work: REMOVE APPROX 75 SQ FT OF EXISTING WALLS AND REFRAMER  
2 NEW BEDROOMS

Occupant/Tenant Name: \_\_\_\_\_  
Was tenant space previously occupied?  Yes  No  
Contact Name: \_\_\_\_\_  
Address: \_\_\_\_\_  
City: \_\_\_\_\_ State: \_\_\_\_\_ Zip Code: \_\_\_\_\_  
Phone: \_\_\_\_\_ Fax: \_\_\_\_\_  
Email: \_\_\_\_\_

Property Owner's Name: KATHLEEN CHURCH  
Address: \_\_\_\_\_  
City: \_\_\_\_\_ State: \_\_\_\_\_ Zip Code: \_\_\_\_\_  
Phone: \_\_\_\_\_ Fax: \_\_\_\_\_  
Email: \_\_\_\_\_

**Applicant's Name & Mailing Address, (if other than stated herein)**  
Applicant's Name: \_\_\_\_\_  
Address: \_\_\_\_\_  
City: \_\_\_\_\_ State: \_\_\_\_\_ Zip Code: \_\_\_\_\_  
Phone: \_\_\_\_\_ Fax: \_\_\_\_\_  
Email: \_\_\_\_\_

Contractor Company: THE CONSTRUCTION LLC  
Contact Person: \_\_\_\_\_  
Address: \_\_\_\_\_  
City: \_\_\_\_\_ State: \_\_\_\_\_ Zip Code: \_\_\_\_\_  
License No.: 17840  
Phone: \_\_\_\_\_ Fax: \_\_\_\_\_  
Email: \_\_\_\_\_

Engineer/Architect Company: \_\_\_\_\_  
Responsible Design Prof.: \_\_\_\_\_  
Address: \_\_\_\_\_  
City: \_\_\_\_\_ State: \_\_\_\_\_ Zip Code: \_\_\_\_\_  
Phone: \_\_\_\_\_ Fax: \_\_\_\_\_  
Email: \_\_\_\_\_

Commercial Building Characteristics	Residential Building Characteristics	
Height:	<input type="checkbox"/> SF Dwelling <input type="checkbox"/> SF Townhouse	
No. of stories:	Depth	Width
Gross area, sq. ft./floor:	1 <sup>st</sup> floor:	
Area of construction (sq. ft.):	2 <sup>nd</sup> floor:	
Use group:	Basement:	
	<input type="checkbox"/> Finished Basement	
	<input type="checkbox"/> Unfinished Basement	
	<input type="checkbox"/> Crawl Space	
	<input type="checkbox"/> Slab on Grade	
<b>Construction type:</b>	No. of Bedrooms:	
<input type="checkbox"/> Reinforced Concrete		
<input type="checkbox"/> Structural Steel	<b>Multi-family Dwelling</b>	
<input type="checkbox"/> Masonry	No. of efficiency units:	
<input type="checkbox"/> Wood Frame	No. of 1 BR units:	
<input type="checkbox"/> State Certified Modular	No. of 2 BR units:	
	No. of 3 BR units:	
	Other Structure:	
	Dimensions:	
<input checked="" type="checkbox"/> <b>Roadside Tree Project Permit</b>	Footings:	
<input type="checkbox"/> Yes <input type="checkbox"/> No	Roof:	
<b>Roadside Tree Project Permit #</b>	<input type="checkbox"/> State Certified Modular	
	<input type="checkbox"/> Manufactured Home	

Utilities	
Electric:	<input type="checkbox"/> Yes <input type="checkbox"/> No
Gas:	<input type="checkbox"/> Yes <input type="checkbox"/> No
Water Supply	
<input type="checkbox"/> Public	
<input type="checkbox"/> Private	
Sewage Disposal	
<input type="checkbox"/> Public	
<input type="checkbox"/> Private	
Heating System	
<input type="checkbox"/> Electric <input type="checkbox"/> Oil	
<input type="checkbox"/> Natural Gas <input type="checkbox"/> Propane Gas	
<input type="checkbox"/> Other:	
Sprinkler System:	
<input type="checkbox"/> Yes <input type="checkbox"/> No	
<b>Grading Permit Number:</b>	
<b>Building Shell Permit Number:</b>	

THE UNDERSIGNED HEREBY CERTIFIES AND AGREES AS FOLLOWS: (1) THAT HE/SHE IS AUTHORIZED TO MAKE THIS APPLICATION; (2) THAT THE INFORMATION IS CORRECT; (3) THAT HE/SHE WILL COMPLY WITH ALL REGULATIONS OF HOWARD COUNTY WHICH ARE APPLICABLE THERETO; (4) THAT HE/SHE WILL PERFORM NO WORK ON THE ABOVE REFERENCED PROPERTY NOT SPECIFICALLY DESCRIBED IN THIS APPLICATION; (5) THAT HE/SHE GRANTS COUNTY OFFICIALS THE RIGHT TO ENTER ONTO THIS PROPERTY FOR THE PURPOSE OF INSPECTING THE WORK PERMITTED AND POSTING NOTICES.

Applicant's Signature: \_\_\_\_\_  
Email Address: \_\_\_\_\_  
Title/Company: \_\_\_\_\_

Print Name: MATTHEW SHAWNEY  
Date: 7/2/19

Checks Payable to: DIRECTOR OF FINANCE OF HOWARD COUNTY

\*\*PLEASE WRITE NEATLY & LEGIBLY\*\*

-FOR OFFICE USE ONLY-

AGENCY	DATE	SIGNATURE OF APPROVAL
State Highways		
Building Officials		
PSZA ( Zoning )		
PSZA ( Engineering )		
Health		<u>10-8 M. Bernard</u>

Is Sediment Control approval required for issuance?  Yes  No  
 CONTINGENCY CONSTRUCTION START

DPZ SETBACK INFORMATION
Front:
Rear:
Side:
Side St.:
All minimum setbacks met? <input type="checkbox"/> Yes <input type="checkbox"/> No
Is Entrance Permit Required? <input type="checkbox"/> Yes <input type="checkbox"/> No
Historic District? <input type="checkbox"/> Yes <input type="checkbox"/> No
Lot Coverage for New Town Zone:
SDP/Red-line approval date:

Filing Fee	\$
Permit Fee	\$
Tech Fee	\$
Excise Tax	\$
PSFS	\$
Guaranty Fund	\$
Add'l per Fee	\$
Total Fees	\$
Sub- Total Paid	\$
Balance Due	\$
Check	#

Distribution of Copies: White: Building Officials Green: PSZA,Zoning Yellow: PSZA,Engineering Pink: Health Gold: SHA



8-7-19 Spoke with homeowner and contractor  
Floor plans are needed for reverse DB


9-17-19 Returned Call to Homeowner  
@ 720-938-5074


9-19-19 Received floor plans thru e-mail  
and plans were not labeled.

DATE

RESULTS OF REVIEW FOR FILE

FILE NOTES

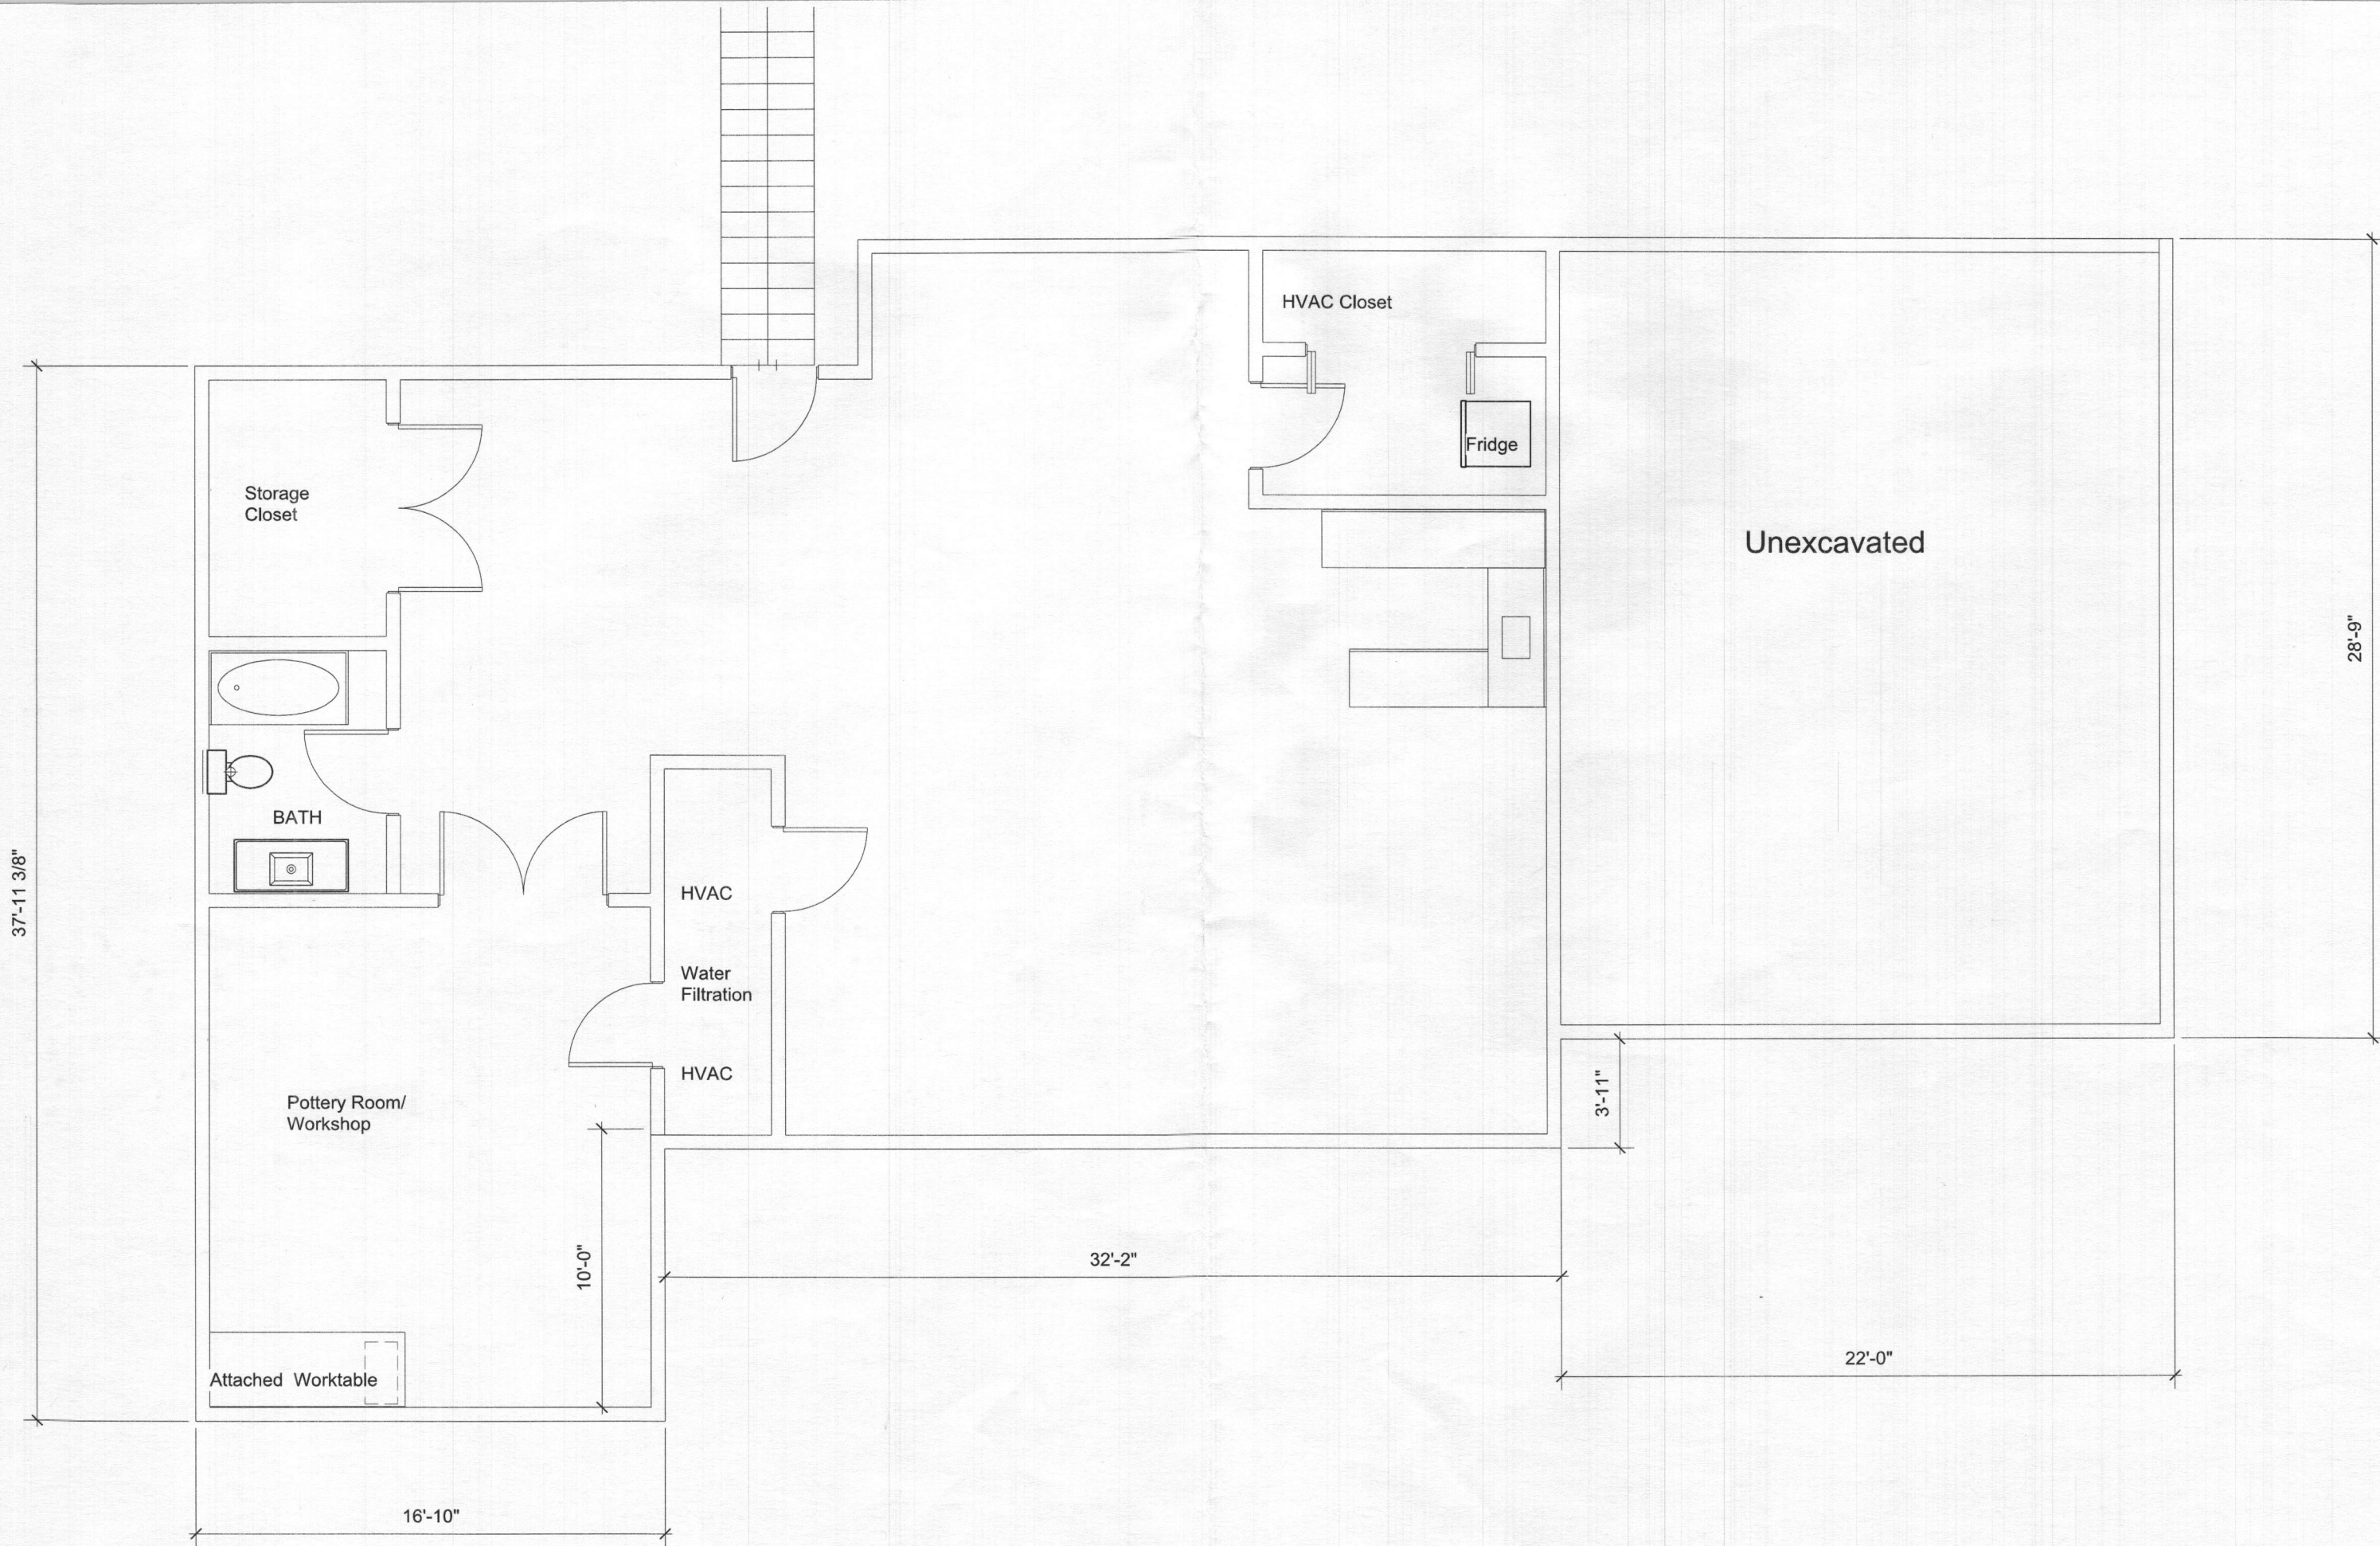

 Basement Layout

GENERAL STRUCTURAL NOTES


1. GENERAL
  - A. ALL CONSTRUCTION SHALL CONFORM WITH THE PROVISIONS OF THE 2015 INTERNATIONAL RESIDENTIAL CODE FOR ONE AND TWO FAMILY DWELLINGS.
  - B. DESIGN LIVE LOADS:
    - ROOF..... 40 PSF
    - FLOORS..... 40 PSF
    - SLEEPING AREAS..... 30 PSF
2. FOUNDATIONS
  - A. FOOTINGS ARE DESIGNED FOR AN ALLOWABLE SOIL BEARING CAPACITY OF 2000 PSF. FOOTINGS SHALL BEAR ON NATURAL UNDISTURBED SOIL 1'-0" BELOW ORIGINAL GRADE. THE BOTTOM OF EXTERIOR FOOTINGS SHALL BE A MINIMUM OF 2'-6" BELOW FINISHED GRADE. CONTRACTOR TO VERIFY THE ALLOWABLE SOIL PRESSURE IN THE FIELD. IF FOUND TO BE LESS THAN 2000 PSF, THE FOOTINGS WILL HAVE TO BE REDESIGNED.
3. CAST IN PLACE CONCRETE
  - A. ALL CONCRETE WORK SHALL CONFORM TO THE LATEST APPROVED (BY LOCAL GOVERNMENT) EDITIONS OF THE FOLLOWING A.C.I. AND A.S.T.M. DOCUMENTS:
    - ACI-301 SPECIFICATIONS FOR STRUCTURAL CONCRETE FOR BUILDINGS
    - ACI-318 BUILDING CODE REQUIREMENTS FOR REINFORCED CONCRETE
  - B. ALL CONCRETE, EXCEPT AS NOTED, SHALL BE (FC=3,000 PSI) STONE AGGREGATE CONCRETE AT 28 DAYS. ALL CONCRETE EXPOSED TO THE WEATHER SHALL BE AIR ENTRAINED.
  - C. SLABS ON GROUND SHALL BE 4" THICK CONCRETE REINFORCED WITH 6"x6" W/1.4X11.4 W/P OVER 6 MIL POLYETHYLENE VAPOR BARRIER AND 4" WASHED GRAVEL UNLESS OTHERWISE NOTED.
4. MASONRY
  - A. ALL MASONRY CONSTRUCTION AND MATERIALS USED THEREIN (CONCRETE MASONRY, CLAY MASONRY, MORTARS, GROUT AND STEEL REINFORCEMENT) SHALL CONFORM TO 'BUILDING CODE REQUIREMENTS FOR MASONRY STRUCTURES' (ACI 530-12/ASCE 5-12/TMS 402-12) AND 'SPECIFICATIONS FOR MASONRY STRUCTURES' (ACI 530.1-12/ASCE 6-12/TMS 602-12) IN ALL RESPECTS.
  - B. MASONRY BEARING WALLS SHALL CONSIST OF STANDARD HOLLOW UNITS CONFORMING TO ASTM C 90 UNLESS OTHERWISE NOTED. WHERE SOLID UNITS ARE REQUIRED, PROVIDE UNITS CONFORMING TO ASTM C 145.
  - C. ALL MORTAR SHALL CONFORM TO THE REQUIREMENTS FOR PROPORTIONS, MIXING, STRENGTH AND APPLICATION FOR PORTLAND CEMENT/LIME TYPE 'S' MORTAR AS DESCRIBED IN ACI 530-12.
  - D. ALL GROUT FILL IN MASONRY WALLS SHALL CONFORM TO ASTM C 476. SLUMP RANGE 8-11". PLACE GROUT IN 5'-0" MAXIMUM FOUR HEIGHTS AND CONSOLIDATE BY MECHANICAL VIBRATION.
  - E. PROVIDE 6" DEPTH OF 100% SOLID MASONRY BELOW ALL JOIST OR SLAB BEARING LINES. PROVIDE 16" HIGH X 16" LONG 100% SOLID MASONRY BELOW ALL LINTELS AND BEAMS UNLESS NOTED OTHERWISE.
  - F. ALL MASONRY WALLS SHALL BE REINFORCED WITH NO. 4 GAGE TRUSS TYPE GALVANIZED DUR-O-WALL SPACED VERTICALLY AT 16" O.C. U.N.O. LAP ALL DUR-O-WALL 6" MINIMUM. PROVIDE CORNER AND TEE PIECES AT ALL INTERSECTIONS.
  - G. LOOSE LINTELS FOR MASONRY WALLS SHALL BE FOR EACH 4" WIDTH OF MASONRY ONE STEEL ANGLE AS FOLLOWS:
 

0'-0" TO 3'-0"	3-1/2" X 3-1/2" X 5/16"
3'-1" TO 5'-0"	4" X 3-1/2" X 5/16"
5'-1" TO 6'-6"	5" X 3-1/2" X 3/8"
6'-7" TO 8'-0"	6" X 3-1/2" X 3/8"
  - H. ALL ANGLES SHALL HAVE THEIR SHORT LEGS OUTSTANDING AND 6" MINIMUM BEARINGS.
5. STRUCTURAL STEEL
  - A. ALL STRUCTURAL STEEL SHALL CONFORM TO ASTM SPECIFICATION A-36 (LATEST LOCAL APPROVED). ALL STEEL SHALL BE DETAILED, FABRICATED, AND ERECTED IN ACCORDANCE WITH THE AISC MANUAL, AISC SPECIFICATION AND AISC CODE OF STANDARD PRACTICE.
  - B. ALL WELDED CONNECTIONS SHALL BE DONE WITH E70XX ELECTRODES. SHOP AND FIELD WELDS SHALL BE MADE BY APPROVED CERTIFIED WELDERS AND SHALL CONFORM TO THE AMERICAN WELDING SOCIETY CODE FOR BUILDINGS AWS D1.1. WELDS SHALL DEVELOP THE FULL STRENGTH OF MATERIALS BEING WELDED UNLESS OTHERWISE NOTED.
6. WOOD
  - A. STRUCTURAL SOLID WOOD RAFTERS, JOISTS, BEAMS AND STUDS SHALL BE HEM FIR #2 OR SPRUCE PINE FIR #2 SURFACED DRY AT A MAXIMUM OF 19% MOISTURE CONTENT. ALL LUMBER EXPOSED TO WEATHER SHALL BE PRESSURE TREATED SOUTHERN PINE #2. ALL FABRICATION, ERECTION, OTHER PROCEDURES, AND MINIMUM UNIT STRESSES SHALL CONFORM TO THE CURRENT NATIONAL DESIGN SPECIFICATION FOR WOOD CONSTRUCTION.
  - B. WOOD TRUSSES SHALL BE DESIGNED, FABRICATED AND ERECTED IN ACCORDANCE WITH THE NATIONAL DESIGN STANDARD FOR METAL PLATE CONNECTED WOOD TRUSS CONSTRUCTION (ANSI/TPI 1) AND COMMENTARY AND RECOMMENDATIONS FOR HANDLING, INSTALLING AND BRACING METAL PLATE CONNECTED WOOD TRUSSES (HB-91) AS PUBLISHED BY THE TRUSS PLATE INSTITUTE AND IN ACCORDANCE WITH THE 1991 EDITION OF THE NATIONAL DESIGN SPECIFICATION FOR WOOD CONSTRUCTION.
  - C. WOOD TRUSSES AND ENGINEERED FLOOR JOISTS ARE TO BE DESIGNED BY THE SUPPLIER. SHOP DRAWINGS SHALL BE SUBMITTED TO THE ENGINEER/ARCHITECT FOR REVIEW. ALL TRUSSES AND JOISTS SHALL BE DESIGNED TO LIMIT THE BEARING STRESS TO 425 psi WHEN MEMBERS BEAR ON STUD WALLS. PROVIDE MEMBERS OF ADEQUATE WIDTH OR METAL CONNECTIONS TO LIMIT STRESSES TO THE SPECIFIED VALUE.
  - D. ALL LAMINATED VENEER LUMBER (LVL) OR PARALLEL STRAND LUMBER (PSL) SHALL HAVE THE FOLLOWING MINIMUM PROPERTIES: Fb=2600psi, Fv=205psi, E=1,900,000psi, Fc=2510psi(PARALLEL), Fc=1800psi(PERPENDICULAR).
  - E. ALL DOUBLE MEMBERS SHALL BE NAILED TOGETHER WITH 2 ROWS OF 16d NAILS SPACED AT 12" O.C. ALL TRIPLE MEMBERS SHALL BE NAILED TOGETHER WITH 3 ROWS OF 16d NAILS SPACED AT 12" O.C. NAILED FROM EACH SIDE.
  - F. PROVIDE DOUBLE JOISTS AT PARALLEL PARTITIONS WHERE PARTITION LENGTH EXCEEDS 1/3 JOIST SPAN.
  - G. ALL NAILS ARE TO BE COMMON WIRE NAILS. NAILING OF ALL FRAMING SHALL BE AS SPECIFIED IN THE CONTRACT DOCUMENTS BUT IN NO CASE SHALL BE LESS THAN THE RECOMMENDED NAILING SCHEDULE CONTAINED IN THE 2009 INTERNATIONAL RESIDENTIAL CODE. ALL MULTIPLE STUD POSTS ARE TO BE NAILED TOGETHER WITH 12d NAILS @ 6" O.C. STAGGERED.
  - H. PROVIDE BRIDGING SPACED AT 48" O.C. IN FIRST TWO JOIST, RAFTER OR TRUSS SPACES WHEN FRAMING IS PARALLEL TO EXTERIOR WALL. NAIL SHEATHING (FLOOR, CEILING OR ROOF) TO BRIDGING AND NAIL BRIDGING TO EXTERIOR WALL PLATE. PROVIDE ONE ROW OF BRIDGING BETWEEN ALL FLOOR AND ROOF JOISTS FOR EACH 8'-0" OF SPAN. PROVIDE SOLID BLOCKING OR A CONTINUOUS RIM JOIST AT THE BEARING OF JOISTS, RAFTERS OR TRUSSES ON WOOD PLATES.
  - I. PROVIDE THE FOLLOWING JAMB STUDS AT ALL BEARING WALL OPENINGS UNLESS NOTED OTHERWISE:
 

0'-3" OPENING	1 JACK STUD, 1 KING STUD
3'-1" - 6'-0" OPENING	2 JACK STUDS, 1 KING STUD
6'-1" - 9'-0" OPENING	2 JACK STUDS, 2 KING STUDS
  - J. PROVIDE DOUBLE STUDS AT ALL CORNERS AND BENEATH ALL GIRDER TRUSSES AND WOOD BEAMS UNLESS NOTED OTHERWISE ON PLANS. WOOD BEAMS, GIRDER TRUSSES AND HEADERS SHALL BEAR THE FULL DEPTH OF POSTS AND JACK STUDS.
  - K. ALL POSTS (MULTIPLE STUDS OR SOLID POST) SUPPORTING BEAMS, WALL HEADERS OR GIRDER TRUSSES, SHALL BE BLOCKED SOLID FOR THE FULL LENGTH AND WIDTH OF POSTS AT ALL INTERSECTIONS WITH FLOORS AS REQUIRED TO PROVIDE CONTINUOUS SUPPORT TO TOP OF FOUNDATION WALLS OR BEAMS. POSTS SHOWN ON UPPER LEVELS SHALL ALSO BE INSTALLED ON THE LOWER LEVELS IN LINE WITH THE POST ABOVE DOWN TO FOUNDATION WALLS OR BEAMS.
  - L. ALL FLUSH JOIST TO BEAM OR BEAM TO BEAM CONNECTIONS SHALL BE MADE WITH JOIST OR BEAM HANGERS TO SUPPORT THE LOAD CAPACITY INDICATED ON THE PLANS OR THE FULL CAPACITY OF THE JOIST OR BEAM. HANGERS SHALL BE PROVIDED BY SIMPSON STRONG TIE OR USF LUMBER CONNECTORS. THE SUPPLIER SHALL DESIGN ALL HANGERS FOR THE CAPACITY STATED. INSTALL ALL HANGERS IN STRICT CONFORMANCE TO THE MANUFACTURER'S INSTRUCTIONS. FILL ALL NAIL OR BOLT HOLES USING THE SPECIFIED NAILS AND BOLTS ONLY.


2015 IECC CODE COMPLIANCE

- R301.1 CLIMATE ZONE 4
  - R401.2 COMPLIANCE METHOD: MANDATORY AND PRESCRIPTIVE PROVISIONS
  - R402.1.1 VAPOR RETARDER: WALL ASSEMBLIES IN THE THERMAL BUILDING ENVELOPE SHALL COMPLY WITH THE VAPOR RETARDER REQUIREMENTS OF SECTION R102.7 OF THE IRC CODE, 2015 EDITION
  - R402.1.2 ATTIC INSULATION: RAISED HEEL TRUSSES: R-30
  - R402.1.2 WOOD FRAME WALL: R-20 OR R19-RS CONTINUOUS INSULATION
  - R402.1.2 BASEMENT WALL INSULATION: R-15-R-10 FOIL FACED CONTINUOUS, UNINTERRUPTED BATTS FULL HEIGHT.
  - R402.1.2 CRAWL SPACE WALL INSULATION: R-15-R-10 FOIL FACED CONTINUOUS BATTS FULL HEIGHT EXTENDING FROM FLOOR ABOVE TO FINISH GRADE LEVEL AND THEN VERTICALLY OR HORIZONTALLY AN ADDITIONAL 2'-0".
  - R402.1.2 FLOOR INSULATION OVER UNCONDITIONED SPACE: R-14 BATT INSULATION
  - R402.1.2 WINDOW U-VALUE / SHGC: .35 (U-VALUE) / .40 (SHGC)
  - R402.2.1 SLAB ON GRADE FLOORS LESS THAN 12" BELOW GRADE: R-10 RIGID FOAM BOARD UNDER SLAB EXTENDING EITHER 2'-0" HORIZONTALLY OR 2'-0" VERTICALLY.
  - R402.2.4 ATTIC ACCESS: ATTIC ACCESS SCUTTLE WILL BE WEATHERSTRIPPED AND INSULATED R-49.
  - R402.4 BUILDING THERMAL ENVELOPE (AIR LEAKAGE): EXTERIOR WALLS AND PENETRATIONS WILL BE SEALED PER THIS SECTION OF THE 2015 IECC WITH CAULK, GASKETS, WEATHERSTRIPPING OR AN AIR BARRIER OF SUITABLE MATERIAL.
  - R402.4.1.2 BUILDING THERMAL ENVELOPE TIGHTNESS TEST: BUILDING ENVELOPE SHALL BE TESTED AND VERIFIED AS HAVING AN AIR LEAKAGE RATE OF NOT EXCEEDING 3 AIR CHANGES PER HOUR. TESTING SHALL BE CONDUCTED IN ACCORDANCE WITH ASTM E 1171 OR ASTM E 1827 WITH (BLOWER DOOR) AS A PRESSURE OF 0.2 INCHES W.G. (50 PASCALS). TESTING SHALL BE SIGNED BY THE PARTY CONDUCTING THE TEST AND PROVIDED TO THE BUILDING INSPECTOR.
  - R402.4.2 FIREPLACES: NEW WOOD BURNING MASONRY FIREPLACES WILL HAVE TIGHT-FITTING FLUE DAMPERS AND OUTDOOR COMBUSTION AIR FIRE PLACE DOORS SHALL BE LISTED AND LABELED IN ACCORDANCE WITH UL 121 (FACTORY BUILT FIREPLACE) AND UL 401 (MASONRY FIREPLACE)
  - R402.4.4 ROOMS CONTAINING FUEL BURNING APPLIANCES WHERE OPEN COMBUSTION AIR DUCTS PROVIDE COMBUSTION AIR TO OPEN COMBUSTION FUEL BURNING APPLIANCES, THE APPLIANCES AND COMBUSTION AIR SHALL BE LOCATED OUTSIDE THE BUILDING THERMAL ENVELOPE TO ENCLOSED IN A ROOM ISOLATED FROM THE THERMAL ENVELOPE. EXCEPTION: DIRECT VENT APPLIANCES WITH BOTH INTAKE AND EXHAUST PIPES INSTALLED CONTINUOUS TO THE OUTSIDE. FIREPLACES AND STOVES COMPLYING WITH SECTION R402.4.2 AND SECTION R1006 OF THE IRC.
  - R402.4.5 RECESSED LIGHTING: RECESSED LUMINAIRES INSTALLED IN THE BUILDING THERMAL ENVELOPE SHALL BE SEALED TO LIMIT AIR LEAKAGE.
  - R403.1.1 THERMOSTAT: ALL DWELLING UNITS WILL HAVE AT LEAST (1) PROGRAMMABLE THERMOSTAT FOR EACH SEPARATE HEATING AND COOLING SYSTEM PER 2015 IECC SECTION 403.1.1
  - R403.1.2 WHERE A HEAT PUMP SYSTEM HAVING SUPPLEMENTARY ELECTRIC RESISTANCE HEAT IS USED THE THERMOSTAT SHALL PREVENT THE SUPPLEMENTARY HEAT FROM COMING ON WHEN HEAT PUMP CAN MEET HEATING LOAD.
  - R403.3.1 MECHANICAL DUCT INSULATION: SUPPLY AND RETURN DUCTS IN ATTIC R-8 MINIMUM, R-6 WHEN LESS THAN 8" SUPPLY AND RETURN DUCTS OUTSIDE OF CONDITIONED SPACE R-8 MINIMUM. ALL OTHER DUCTS EXCEPT THOSE LOCATED COMPLETELY INSIDE THE BUILDING THERMAL ENVELOPE R-6 MINIMUM. DUCTS LOCATED UNDER CONCRETE SLABS MUST BE R-8 MINIMUM.
  - R403.3.2 DUCT SEALING: ALL DUCTS, AIR HANDLERS, FILTER BOXES WILL BE SEALED. JOINTS AND SEAMS WILL COMPLY WITH SECTION M1601.4.1 OF THE IRC. A DUCT TIGHTNESS TEST (DUCT BLOWER) DUCT TOTAL LEAKAGE TEST) WILL BE PERFORMED ON ALL HOMES AND SHALL BE VERIFIED BY EITHER A POST CONSTRUCTION TEST OR A ROUGH-IN TEST. DUCT TIGHTNESS IS NOT REQUIRED IF THE AIR HANDLER AND ALL DUCTS ARE LOCATED WITHIN THE CONDITIONED SPACE.
  - R403.6 MECHANICAL VENTILATION: OUTDOOR (MAKE UP AND EXHAUSTS) AIR DUCTS TO BE PROVIDED WITH AUTOMATIC OR GRAVITY DAMPER THAT CLOSE WHEN THE VENTILATION SYSTEM IS NOT OPERATING.
  - R403.6.1 WHOLE HOUSE MECHANICAL VENTILATION SYSTEM FAN EFFICIENCY TO COMPLY WITH TABLE R403.6.1
  - R403.7 EQUIPMENT SIZES SHALL COMPLY WITH R403.7.
  - R404.1 LIGHTING EQUIPMENT: A MINIMUM OF 75% OF ALL LAMPS (LIGHTS) MUST BE HIGH-EFFICACY LAMPS.
- THE CONTRACTOR ALSO RESPONSIBLE FOR GENERATING CERTIFICATE OF COMPLIANCE AND AFFIXING TO ELECTRICAL PANEL OR WITHIN 6" OF THE PANEL AND BE READILY VISIBLE.

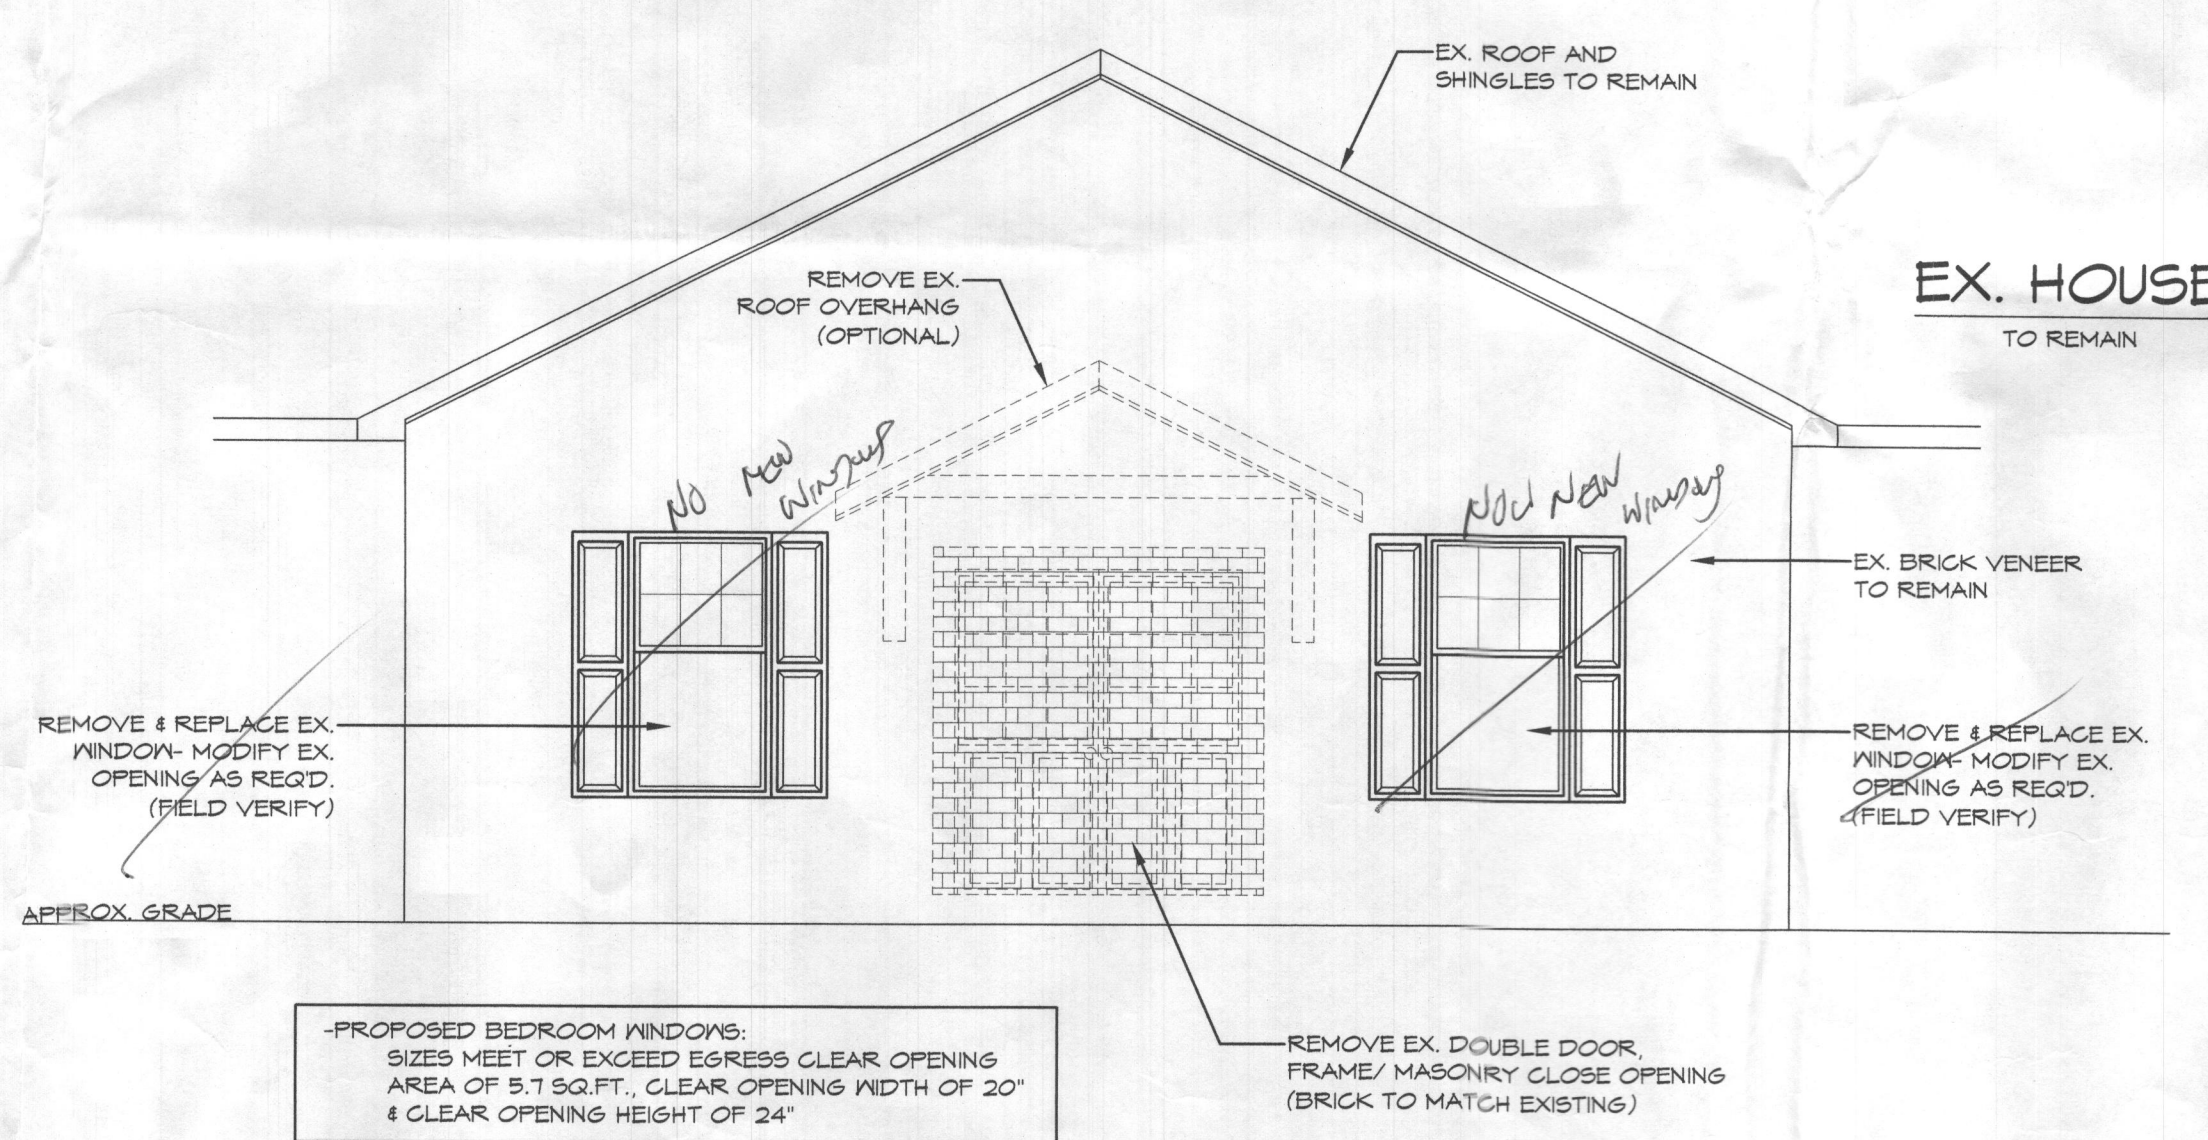

PARTIAL PROPOSED RIGHT SIDE ELEVATION

SCALE: 1/4"=1'-0"

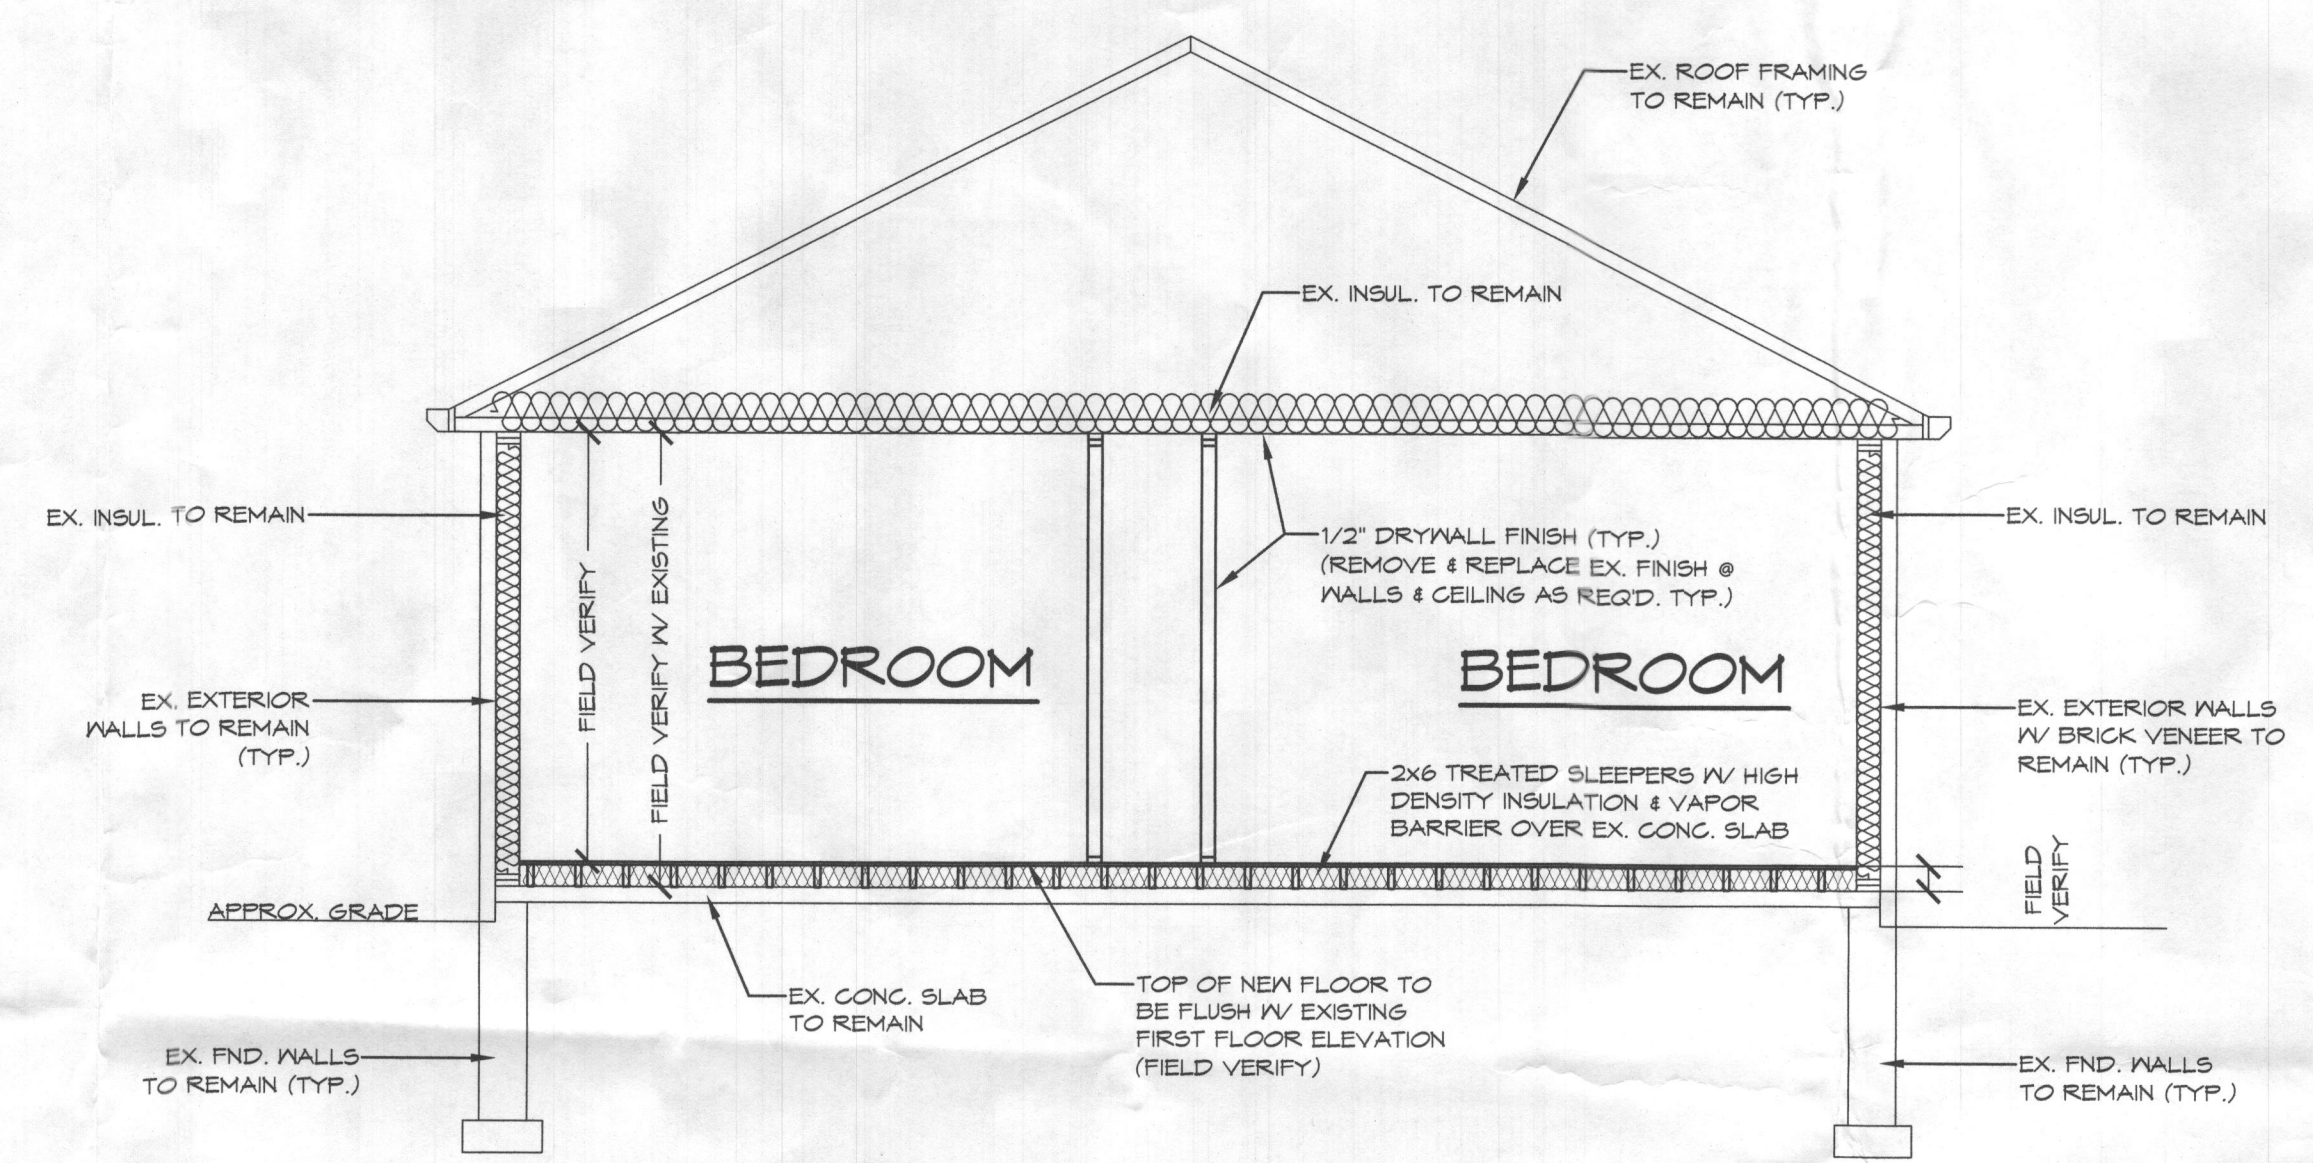

PROPOSED SECTION A

SCALE: 1/4"=1'-0"

PROJECT ADDRESS:  
6694 LUSTER DRIVE  
HIGHLAND, MD. 20771  
HOWARD COUNTY, MD.

REMODELING TO THE CHILAKA RESIDENCE


REVISED: 6/28/2019  
REVISED: 9/12/2019  
REVISED: 9/11/2019

FILE: CHILAKA REMODEL

SCALE: 1/4" = 1'-0"  
DATE: 9/2019  
SHEET NO.: 2


**GBL CUSTOM HOME DESIGN INC.**  
PO BOX 237 FINNSBURG, MD 21048  
PHONE 410-853-8520

REMODELING TO  
**THE CHILAKA RESIDENCE**

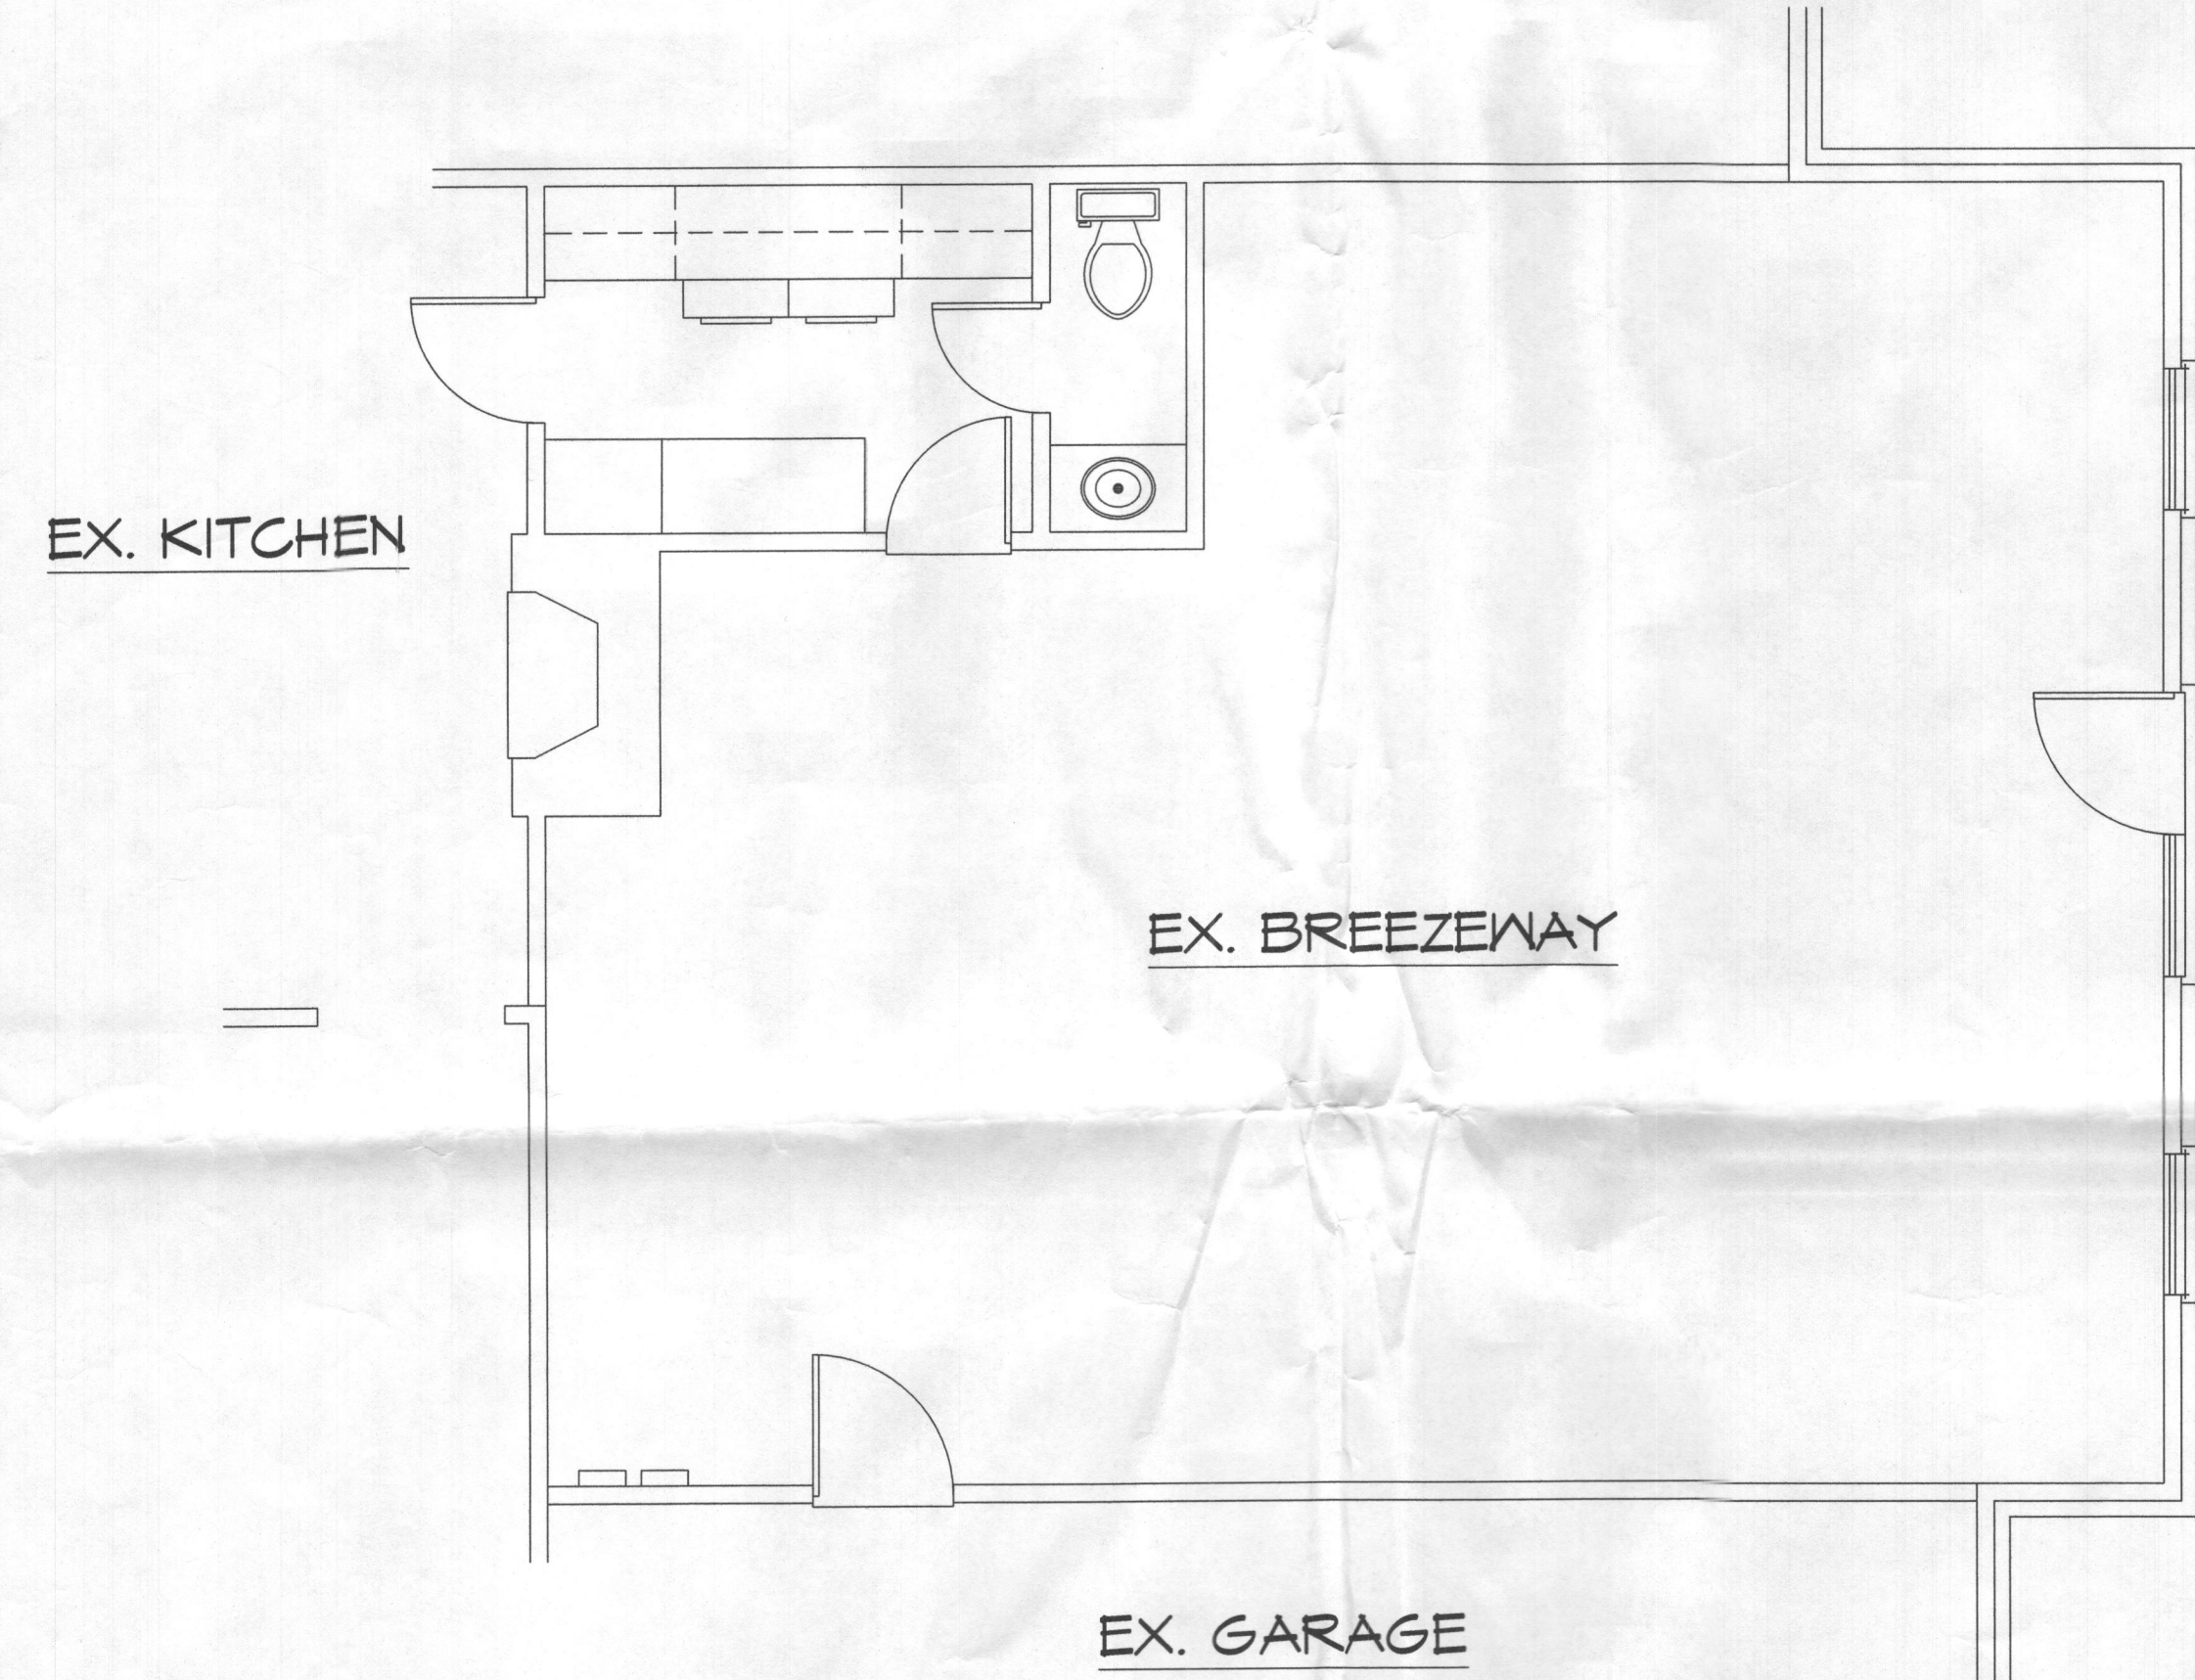

**PARTIAL EXISTING FIRST FLOOR PLAN**

SCALE: 1/4"=1'-0"

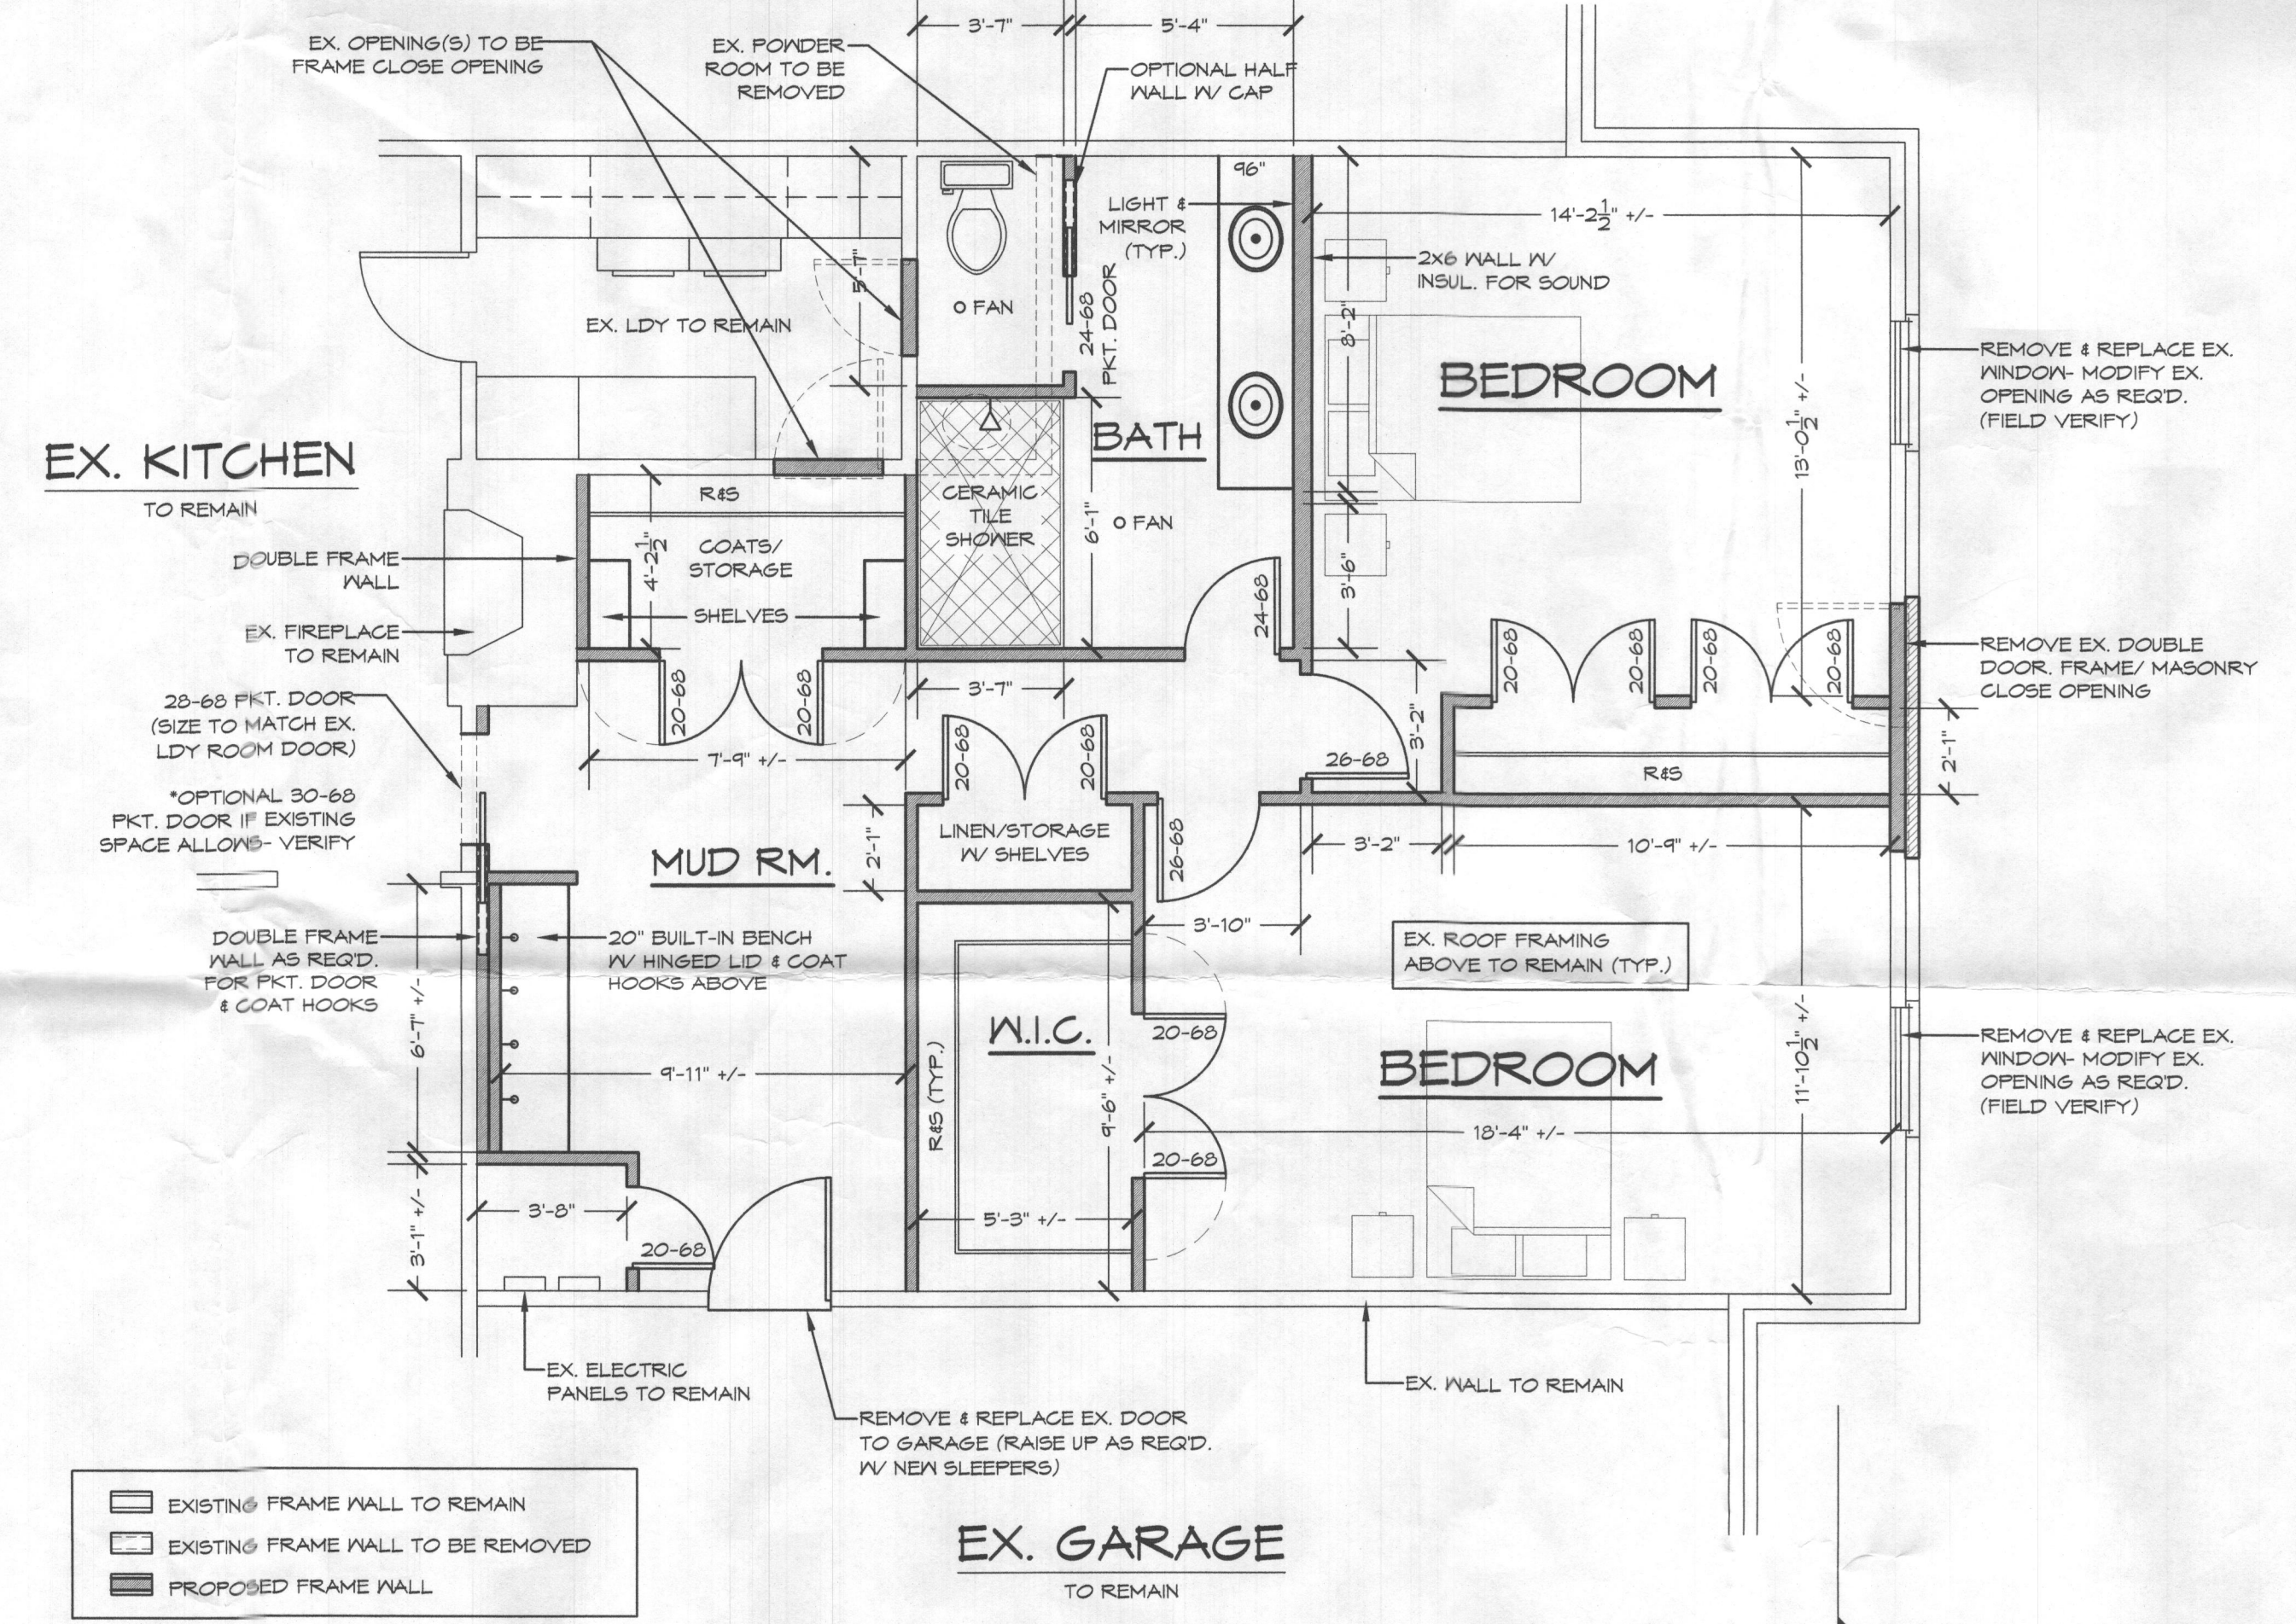

**PARTIAL PROPOSED FIRST FLOOR PLAN**

SCALE: 1/4"=1'-0"

\*NOTE: PROVIDE 2x6 TREATED SLEEPERS W/ HIGH DENSITY INSULATION & VAPOR BARRIER OVER EXISTING CONCRETE SLAB TO REMAIN

-PROPOSED BEDROOM WINDOWS: SIZES MEET OR EXCEED EGRESS CLEAR OPENING AREA OF 5.7 SQ.FT., CLEAR OPENING WIDTH OF 20" & CLEAR OPENING HEIGHT OF 24"

R613.2 WINDOW SILLS  
ALL WINDOWS WHERE THE OPERABLE OPENING IS LOCATED MORE THAN 12" ABOVE FINISHED GRADE OR SURFACE BELOW, THE LOWEST PART OF THE CLEAR OPENING SHALL BE A MIN. OF 24" ABOVE THE FINISHED FLOOR OF THE ROOM IN WHICH THE WINDOW IS LOCATED. GLAZING BETWEEN THE FLOOR AND 24" SHALL BE FIXED OR HAVE OPENINGS THROUGH WHICH A 4" DIA. SPHERE CANNOT PASS.  
EXCEPTIONS:  
1. WINDOWS WHOSE OPENINGS WILL NOT ALLOW A 4" DIA. SPHERE TO PASS THROUGH THE OPENING WHEN THE OPENING IS IN ITS LARGEST OPENED POSITION  
2. OPENINGS THAT ARE PROVIDED WITH WINDOW GUARDS THAT COMPLY WITH ASTM F 2006 OF F 2090


REVISED: 6/28/2019  
REVISED: 9/12/2019  
REVISED: 9/11/2019

FILE: CHILAKA REMODEL

SCALE: 1/4" = 1'-0"  
DATE: 9/20/19  
SHEET NO.: 1

**GBL CUSTOM HOME DESIGN INC.**  
PO BOX 237 FNKSBURG, MD 21048  
PHONE 410-833-8320

SECOND FLOOR PLAN

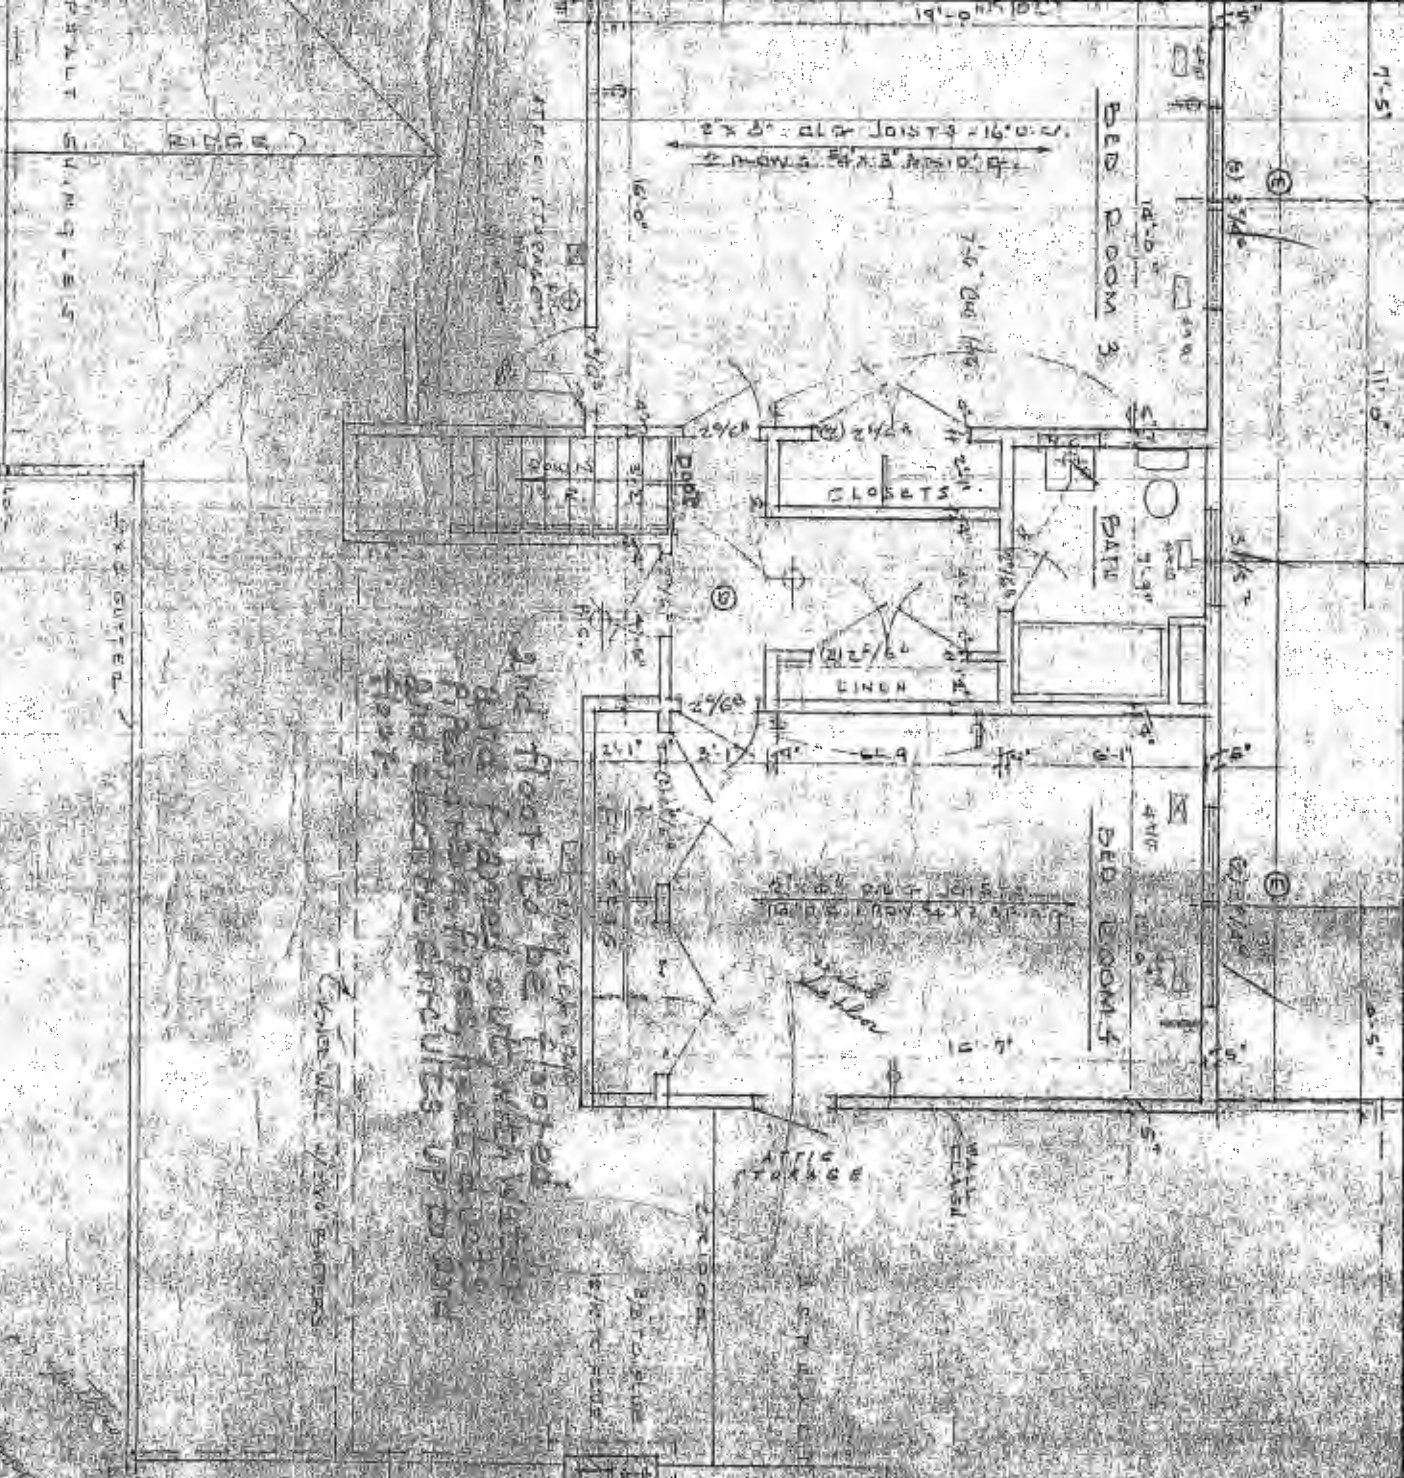

and floor to be floored  
 and floor to be floored with vinyl  
 and floor to be floored with vinyl  
 and floor to be floored with vinyl

FIXED OUTLET

FIXED OUTLET

and floor to be floored with vinyl

ATTIC STORAGE

BATH

LINE

CLOSETS

BATH

BED ROOM 2

BED ROOM 3

ATTIC STORAGE

DOOR

DOOR

2x8 @ 16" Joists - 16'-0" c/c

2x8 @ 16" Joists - 16'-0" c/c

