

Permit

APPLICATION

SEWAGE DISPOSAL TESTING

STATE OF MARYLAND - DEPARTMENT OF HEALTH AND MENTAL HYGIENE

A 33497

P _____

HOWARD COUNTY HEALTH DEPARTMENT
ENVIRONMENTAL HEALTH SERVICES

P. O. BOX 476 ELLICOTT CITY, MARYLAND 21043
TELEPHONE: 992-2330

DISTRICT 5

DATE 1-30-84

TO: THE COUNTY HEALTH OFFICER
ELLICOTT CITY, MARYLAND

I, HEREBY, APPLY FOR THE NECESSARY TEST IN ORDER TO CONSTRUCT (OR RECONSTRUCT) A SEWAGE DISPOSAL SYSTEM.

PROPERTY OWNER ANNA MACCARTHY NATUCKER Island Homes, Inc
Highland Development Corp

ADDRESS 4100 Cathedral ave DC 20016 PHONE 202-363-2725

PROPERTY LOCATION: BRIGHTON PINES I
SUBDIVISION Puppet property LOT NO. 9

ROAD AND DESCRIPTION Nicholas A. 13750 Lakeside Drive

SIZE OF LOT 3A TYPE BLDG. SFD-3 Bedroom
(NUMBER OF BEDROOMS)

BLDG. PERMIT SIGNED
AND RETURNED 2-2-85
Serial # 33497

THE SYSTEM INSTALLED UNDER THIS APPLICATION IS ACCEPTABLE ONLY UNTIL PUBLIC FACILITIES BECOME AVAILABLE. I FULLY UNDERSTAND THE FEE CONNECTED WITH THE FILING OF THIS PERC TEST APPLICATION IS NON-REFUNDABLE UNDER ANY CIRCUMSTANCES. I ALSO AGREE TO COMPLY WITH ALL M.O.S.H.A. REQUIREMENTS IN TESTING THIS LOT.

Richard W. Smith 445-0842
(SIGNATURE OF APPLICANT) 445-

APPROVED BY C. Williams FOR SHALLOW SYSTEM DATE 2-12-85

REJECTED BY _____ FOR _____ DATE _____





HOLD PENDING FURTHER TESTS C. Williams DATE 3-2-84

REASONS FOR REJECTION OR HOLDING LOT LINES TO BE ADJUSTED TO ALLOW

Room For House SITE. CW. BLDG. PERMIT SIGNED
AND RETURNED 7/5/82
Serial # 37011
SFD-3 Bedroom

THIS IS NOT A PERMIT

#1 & #6
SOIL PROFILE

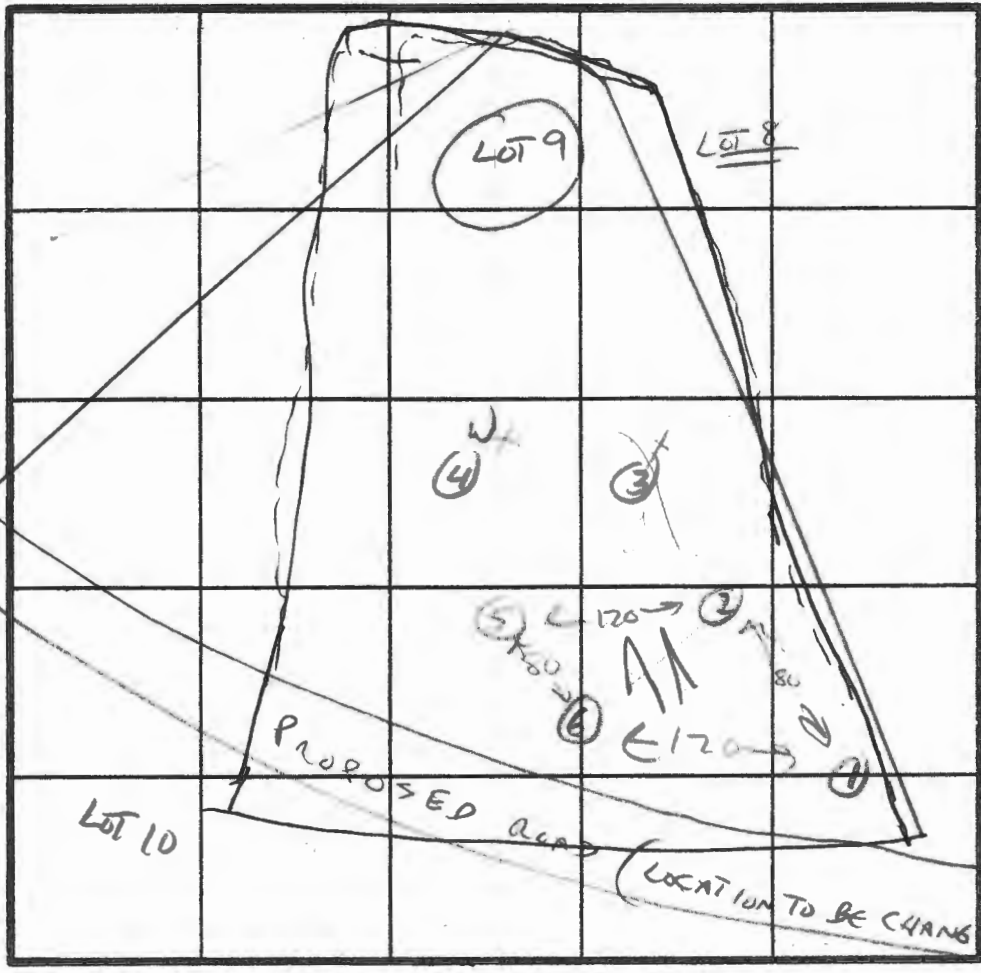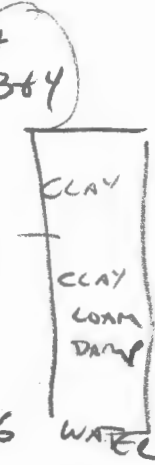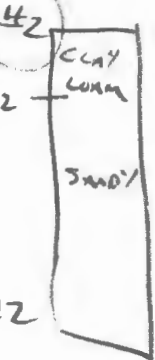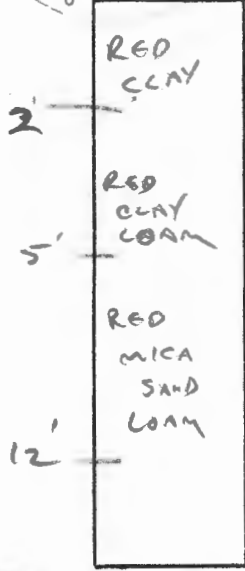

DARK LINES INDICATE NEW ROAD & LOT LINES PER P84-43

INDICATE NORTH - NAME ADJOINING ROADWAY AS BASE LINE.

DATE	TEST NO.	DEPTH	PRE-WET		TEST - 1" DROP		TIME
			START	STOP	START	STOP	
3-2-84	1 SAND MUD	0	3:46	3:52	3:52	4:08	16 MIN ✓
		8	3:46	3:50	3:50	3:56	6 MIN ✓
		12	CLAY SAND LOAM				
3-2-84	2	3	3:45	3:47	3:47	3:49	2 MIN ✓
		8					
		12	CLAY SAND				
3-2-84	3	4	—————		NOT TESTED		
		8					
			MOTTLED SAND LOAM				
3-2-84	4 W	X	CLAY SAND LOAM		WATER AT 0'		X
3-2-84	5	3	3:31	3:35	3:35	3:41	6 MIN ✓
		8	3:31	3:33	3:33	3:35	2 MIN ✓
		12	WATER AT 11				
3-2-84	6 HIGH	3	3:20	3:24	3:24	3:32	8 MIN ✓
		8	3:20	3:22	3:22	3:25	3 MIN ✓

REMARKS 12 RED MICA SAND LOAM

TYPE OF SOIL SHALLOW SYSTEM ONLY
LOT LINES MUST BE ADJUSTED TO ALLOW FOR HOUSE SITE


TESTED BY C. Williams ALSO PRESENT DEMMITT, MANGITZ, OSSEL

EH-12-1079

SITE INSPECTION SHEET


OWNER: _____ PHONE #: _____
ADDRESS: _____ CONTRACTOR: _____
WELL TAG #: _____
SUBDIVISION: Brighton Pines LOT: 9 COUNTY #: _____
PROPOSAL: check soil conditions

LOCATION DIAGRAM

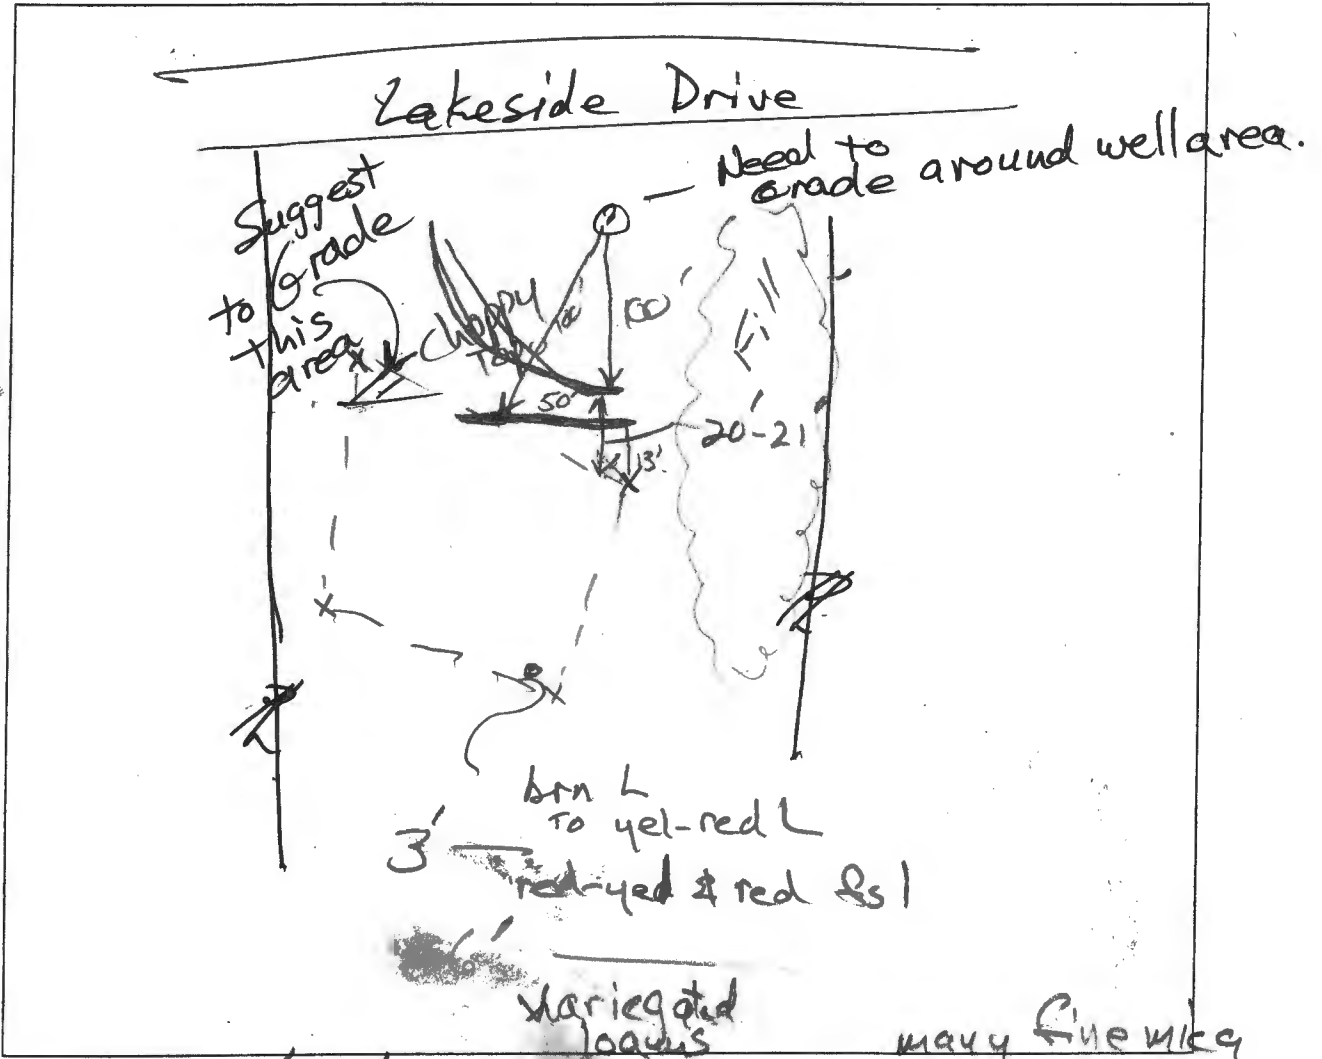

COMMENTS: _____

DATE: 7/8/14 INSPECTOR: P Bricker

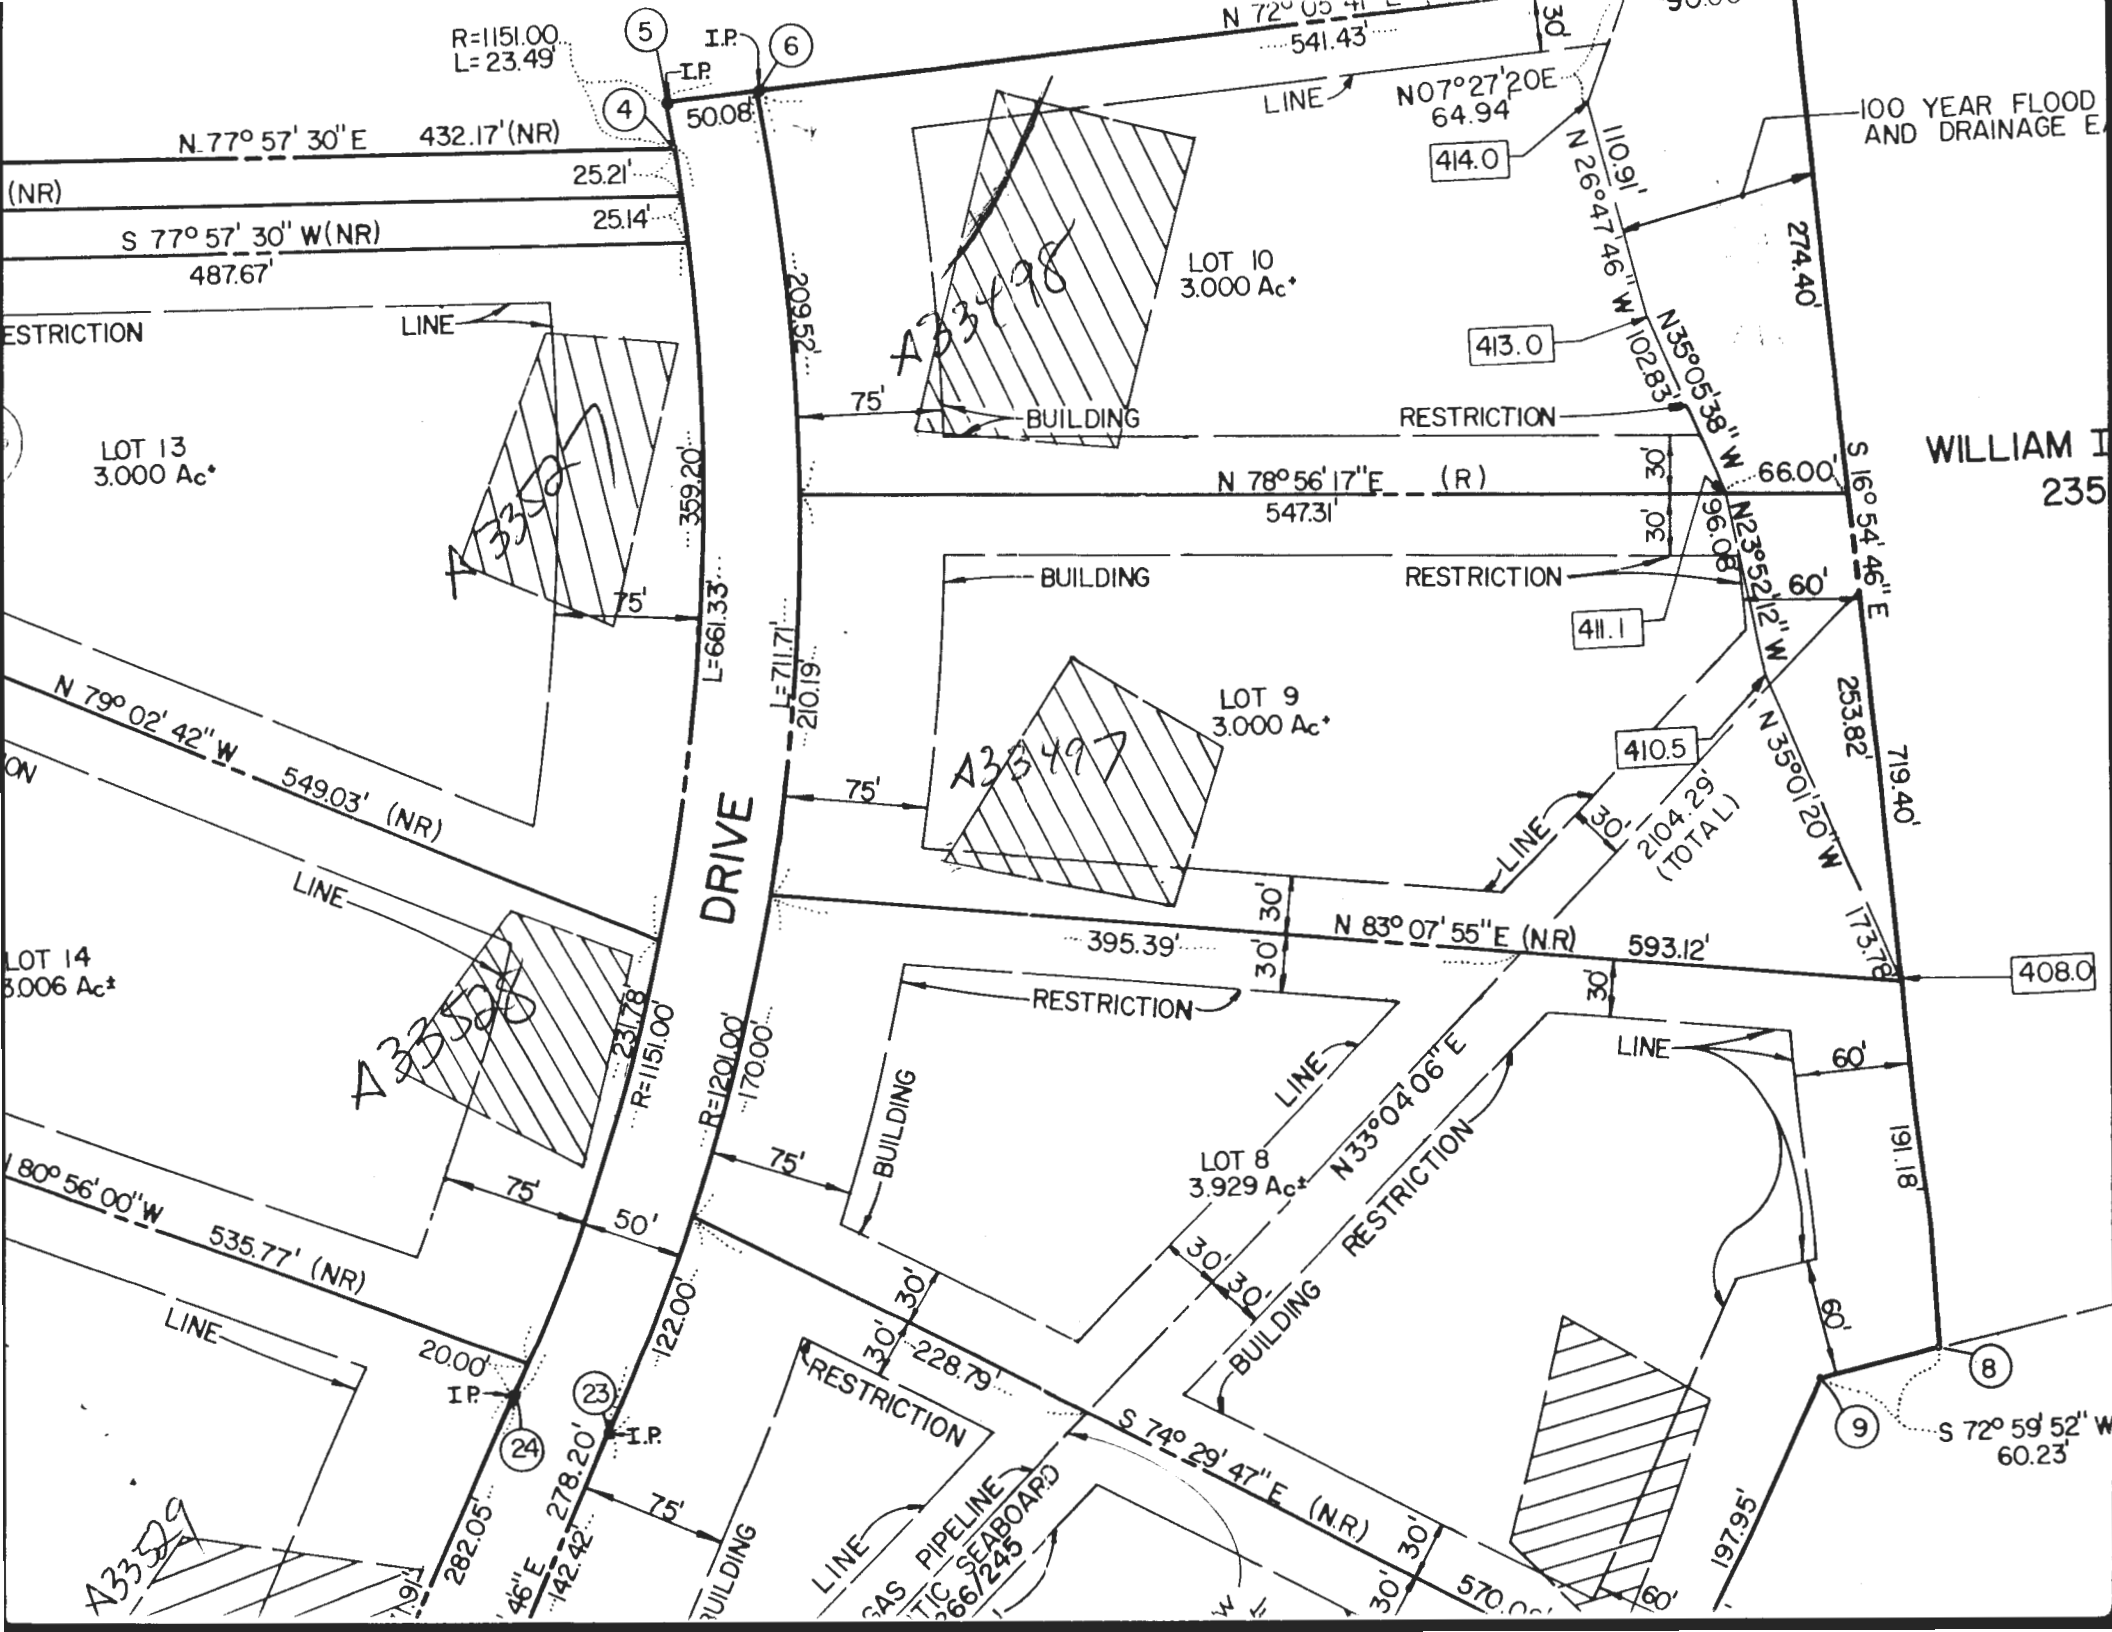

R=1151.00
L=23.49'

5 I.P.
6 I.P.

N 77° 57' 30" E 432.17' (NR)

N 72° 05' 41" E
541.43'

N 07° 27' 20" E
64.94'

100 YEAR FLOOD
AND DRAINAGE E

(NR) 25.21'

S 77° 57' 30" W (NR)
487.67'


25.14'

414.0

LOT 10
3.000 Ac⁺

413.0

RESTRICTION

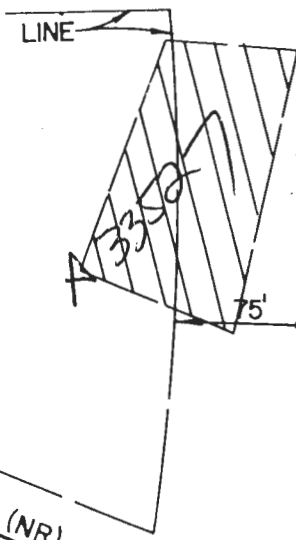

75' BUILDING

RESTRICTION

LOT 13
3.000 Ac⁺

N 78° 56' 17" E (R)
547.31'


WILLIAM I
235

BUILDING

RESTRICTION

411.1

LOT 9
3.000 Ac⁺

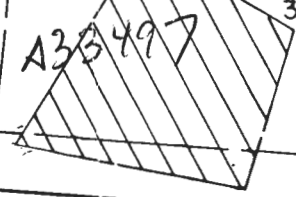

410.5

N 79° 02' 42" W
549.03' (NR)

DRIVE

L=661.33'

L=711.71'

L=610.12'

75'

RESTRICTION


LINE

2104.29'
(TOTAL)

N 83° 07' 55" E (NR)
593.12'

408.0

RESTRICTION

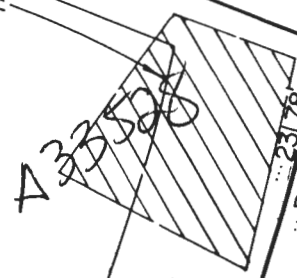

BUILDING

LINE

LOT 8
3.929 Ac⁺

N 33° 04' 06" E
RESTRICTION

LINE

S 80° 56' 00" W
535.77' (NR)

20.00' I.P.

23 I.P.

24 I.P.

BUILDING

RESTRICTION

BUILDING

RESTRICTION

LINE

191.18

A33529

282.05'

278.20' E


142.42'

BUILDING

GAS PIPELINE
TIC SEABOARD
66/245

S 74° 29' 47" E (NR)

570.00'

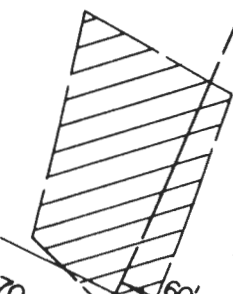

197.95'

60'

S 72° 59' 52" W
60.23'

8

9