

Approved
RM 9/17/2020

Menu Save Reset Cancel Help

Record Detail * (This section is required.)

Permit Type	Permit Number	Opened Date
Building/Residential/Misc/Pool Spa	B20003124	09/16/2020
Description of Work		
SFD/ CONSTRUCT 20 X 40 IN GROUND POOL DEPTH 3-6, FENCE TO CODE		

[check spelling](#)

Address * (This section is required.)

Search Reset Clear Get Parcel & Owner

Street #	Street Name	Street Type	
10356	KINGSBRIDGE	RD	
Unit Type	Unit #	X Coordinate	Y Coordinate
--Select--		-76.87797	39.26433
City	State	Zip Code	Primary
ELLCOTT CITY	MD	21042	Yes

Parcel * (This section is required.)

Search Reset Clear Get Address & Owner

GIS ID *	Parcel	Parcel Area	Land Value	Improved Value	Exemption Value	Plan Area
894461	766	3.52	346200	951500	605300	RURAL
Legal Description						
IMPSLOT 694 3.520 A[]10356 KINGSBRIDGE RD[]BURLEIGH MANOR S2 RSB B2						

[check spelling](#)

Block	Lot	Census Tract	Council Dist	Inspection Dist	Supervisor Dist	Map #	DAP Zone
	694	602303	1				
Plan Area	State Tax Id	Subdivision Name					
	1402339838						
Section	Area	Tax Map					
		23					
Grid	Zoning District	ADC Map					
23-18	RC-DEO	4814-K8					
SDP No.	Final Plan No.	WP File No.	Primary				
			Yes				
Record Plat No.	WS Contract No.	FDP No.					
8318							
Owner Occupied	Year Built	Historic District					
<input type="radio"/> Yes <input type="radio"/> No	1995	<input type="radio"/> Yes <input checked="" type="radio"/> No					
Historic District Registry No.	Stat Area	Flood Plain					
	2-08B	<input type="radio"/> Yes <input checked="" type="radio"/> No					

Building No

Owner * (This section is required.)

Search Reset Clear

Name *

Address Line 1

Address Line 2

Address Line 3

Mail City

Mail State

Mail Zip Code

Phone

Primary

E-mail

Cell Number

Fax Number

Professionals (This section is not required.)

Search Reset Clear

License # *

Business Name

License Type *

First Name

Middle Name

Last Name

Primary

Address Line 1

Address Line 2

City

State

ZIP Code

Phone 1

Phone 2

Fax

E-mail

Applicant (This section is not required.)

Search As Owner As Lic. Prof As Contact

Type *

First Name

MI

Last Name

Relationship

Full Name

Primary

Organization Name

Street Address

Address Line 2

City	State	Zip Code
MT. AIRY	MD	21771
Phone	Cell	Fax
410-489-0707		
E-mail *		
OFFICE@ROWANLANDSCAPE.COM		

Addtl Info

Est Construction Cost *	Housing Units *	Number of Buildings *	Public Owned
50000	0	0	No
Construction Type			
--Select--			

POOL INFORMATION

MISCELLANEOUS POOL INFORMATION

Capital Project-No Fee *	Capital Project Number	Fee Exempt *	Water Supply *	Sewage Disposal *
<input type="radio"/> Yes <input checked="" type="radio"/> No		<input type="radio"/> Yes <input checked="" type="radio"/> No	Private	Private
Existing Use	Type of Pool or Spa *	Electrical Permit Number	Expiration Date	
SFD	In Ground Pool		3/15/2021	

PAYMENT INFORMATION

Check 1	Payee 1	SAP Doc No	SAP Entered

Submit Cancel

NOTES:


If shown, was obtained from existing record plat or local agencies and is not guaranteed by NTL, Inc.
If Flood Zone information is subject to the interpretation of the originator.
Not a survey, or guaranteed by this location.
Not accurate.

LOT 695




1"=100'

Scale 1"=60'

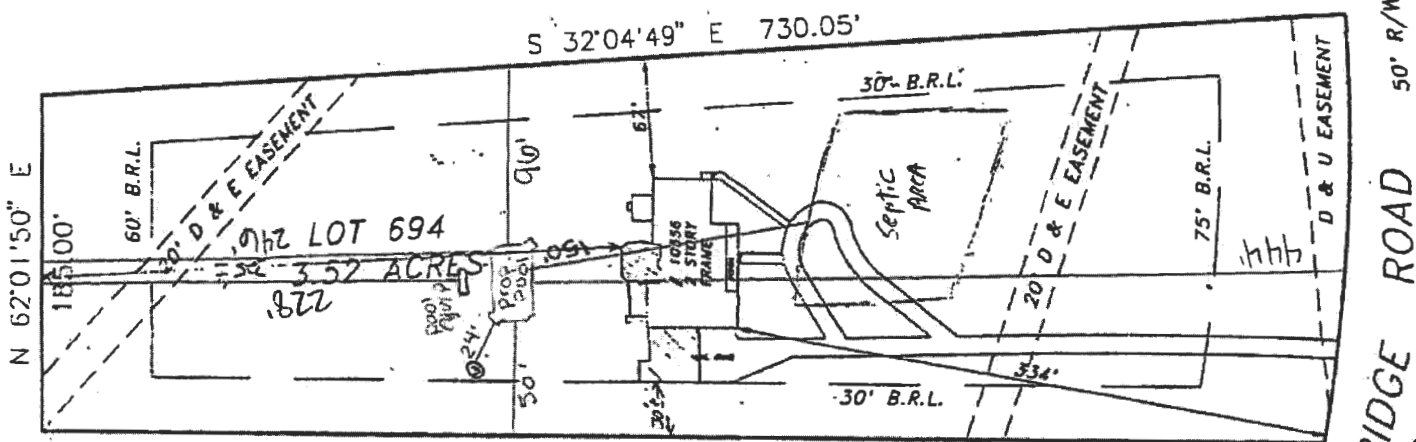

New Addition Area = [shaded area] N 27°58'10" W 716.20'

LOT 693

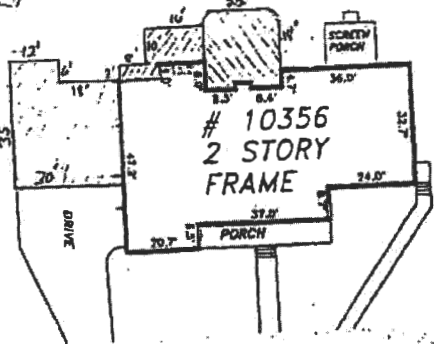

HOUSE DETAIL
SCALE 1"=30'

All Project
in Kingsbridge Rd
and City, MD 21001
Total Builders, Inc.
7-461-9908

This property is shown in Zone C
on FIRM Map of Howard County

KINGSBRIDGE ROAD 50' R/W

Approved
[Signature]

9/17/2020

B20000124

8/15/00
MTG w/BLDR.
OWNER
PROPOSED
ADD'N. IS TO
REPLACE EX. MBR.
WHICH WILL FUNCTION
AS SITTING ROOM/ACCESS
TO NEW MBR.
NO NET GAIN
IN BR
OK TO SIGN [Signature]