

Menu Save Reset Cancel Help

1/3/2020 Approved 319004147

Record Detail * (This section is required.)

Permit Type Permit Number Opened Date

Building/Residential/Misc/Deck B19004142 12/06/2019

Description of Work

SFD/CONSTRUCT A 41 X 16 OPEN WOOD DECK W/STEPS TO GRADE. DECKING WILL BE VINYL AND RAILING WILL BE ALUMINUM. REMOVE EXISTING DECK.

check spelling

Address * (This section is required.)

Search Reset Clear Get Parcel & Owner

Street # Street Name Street Type

13860 KENNARD DR

Unit Type Unit # X Coordinate Y Coordinate

--Select-- -76.99623 39.27055

City State Zip Code Primary

GI FNF I G MD 21737 Yes

Parcel * (This section is required.)

Search Reset Clear Get Address & Owner

GIS ID * Parcel Parcel Area Land Value Improved Value Exemption Value Plan Area

896326 533 3.14 221800 624200 402400 RURAL

Legal Description

IMPSLOT 31 3.141 A[]13860 KENNARD DR[]CRYSTAL CLEAR

check spelling

Block Lot Census Tract Council Dist Inspection Dist Supervisor Dist Map # DAP Zone

31 603000 5

Plan Area State Tax Id Subdivision Name

1403314383 CRYSTAL CLEAR

Section Area Tax Map

22

Grid Zoning District ADC Map

22-7 RR-DEO 4813-A7

SDP No. Final Plan No. WP File No. Primary

Yes

Record Plat No. WS Contract No. FDP No.

11084

Owner Occupied Year Built Historic District

Yes No 1995 Yes No

Historic District Registry No. Stat Area Flood Plain

3-04 Yes No

Building No

Owner * (This section is required.)

Search Reset Clear

Name *

EDGERTON JAMES B JR

Address Line 1

13860 KENNARD DR

Address Line 2

Address Line 3

Mail City Mail State Mail Zip Code
 Phone Primary
 E-mail
 Cell Number Fax Number

Professionals (This section is not required.)

Search Reset Clear

License # * Business Name
 License Type * First Name Middle Name Last Name
 Primary Address Line 1
 Address Line 2
 City State ZIP Code
 Phone 1 Phone 2 Fax
 E-mail

Applicant (This section is not required.)

Search As Owner As Lic. Prof As Contact

Type * First Name MI Last Name
 Relationship Full Name
 Primary Organization Name
 Street Address
 Address Line 2
 City State Zip Code
 Phone Cell Fax
 E-mail *

Addtl Info

Est Construction Cost *Housing Units * Number of Buildings *Public Owned
 Construction Type

MISC PERMIT INFO

MISCELLANEOUS PERMIT INFORMATION

Capital Project-No Fee * Capital Project Number Fee Exempt * Roadside Tree Project Permit * Roadside Tree Project Permit #
 Yes No Yes No Yes No
 Existing Use * Water Sewage Expiration Date

PAYMENT INFORMATION

Check 1 Payee 1 Check 2 Payee 2 SAP Doc No SAP Entered

AREA 1
N 65° 22' 09" E 309.19'

LOT 31
3.141 Ac.


Plan By Lanie Witmer
(301) 251-6730
224 N. Adams St
Rockville, MD
20850

Approved Septic System Plan
Howard County Health Department

Mark E. R. [Signature]
Signature Date 5/4/94


SEPTIC DESIGN (4 BEDROOMS)
3 TRENCHES @ 8'3" x 2'0"
PIPE @ HOUSE
GRADE = 622.0
INV. = ~~618.7~~ 618.7
SEPTIC TANK
GRADE = ~~620.5~~ 621.5
TOP = ~~619.2~~ 619.5
IN = ~~618.7~~ 618.5
OUT = ~~618.8~~ 618.1
DIST. BOX
GRADE = 620.0
PIPE INV. = ~~617.0~~ 617.0
TRENCH INV. = 617.5

APPROVED SEPTIC AREA
SEPTIC TANK INV. = 616.0

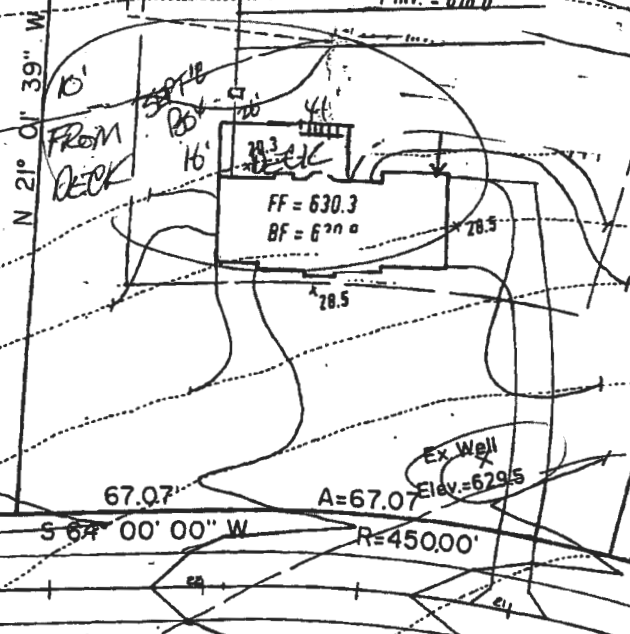

13860 KENNARD DRIVE
GLENELG MD
21737

SCALE
1" = 60'

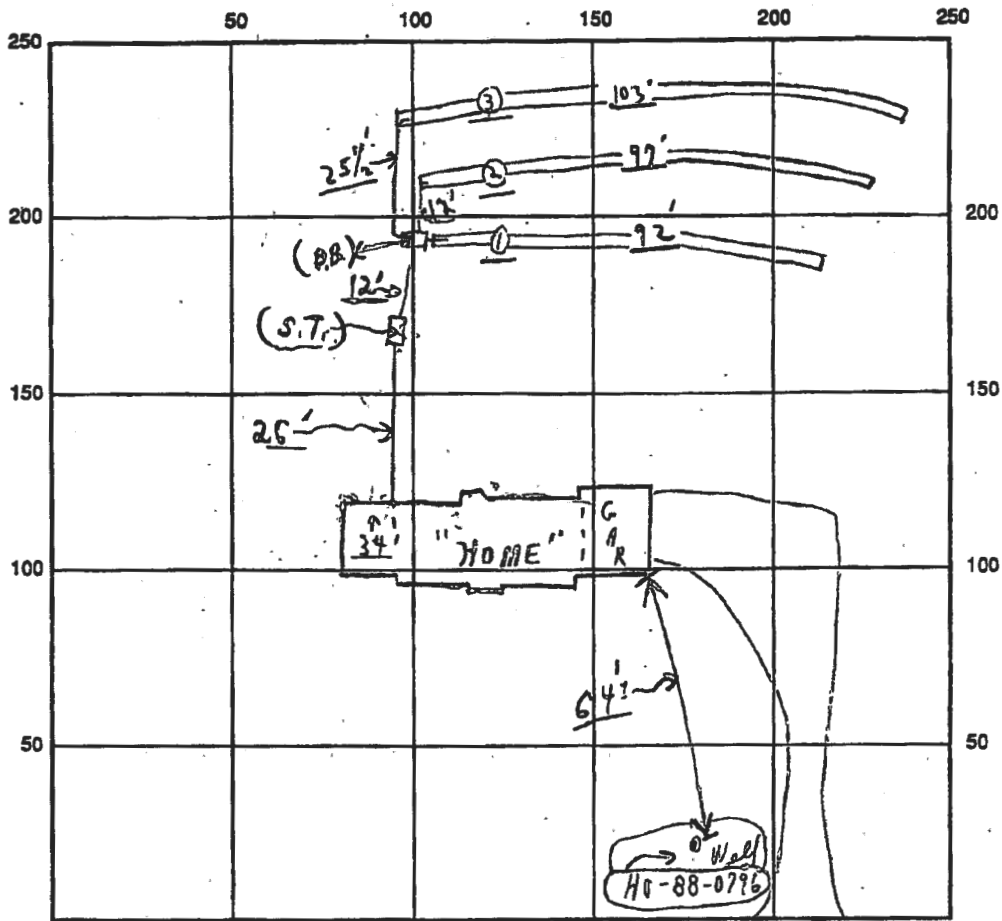

INDICATE NORTH - NAME ADJOINING ROADWAY AS BASE LINE

KENNARD DRIVE

SEPTIC TANK LEVEL OK CLEANOUTS S.T. OK

DISTRIBUTION BOX LEVEL OK (Baffles is in)

DRAIN FIELD/TITLE DEPTH 5 1/2 FT. TRENCH WIDTH 3 FT. INLET DEPTH 3 1/2 FT.

EFFECTIVE GRAVEL DEPTH 2 FT. TOTAL LENGTH 292 FT. } 292

NUMBER OF TRENCHES 3 ONE SIDEWALL/BOTTOM AREA 826 SQ. FT.

DRYWALL INSIDE DIAMETER ~ FT. EFFECTIVE DEPTH BELOW INLET ~ FT.


ABSORBENT AREA 826 SQ. FT.

REMARKS: 8/16/94 Final - all work done; c.R.

8/16 No W.P.I. checked / 9/17/94 No inspection on W.P.I. covered

DATE SYSTEM APPROVED 8/16/94 INSPECTOR Charles Bryan

WALK ORDER COPY

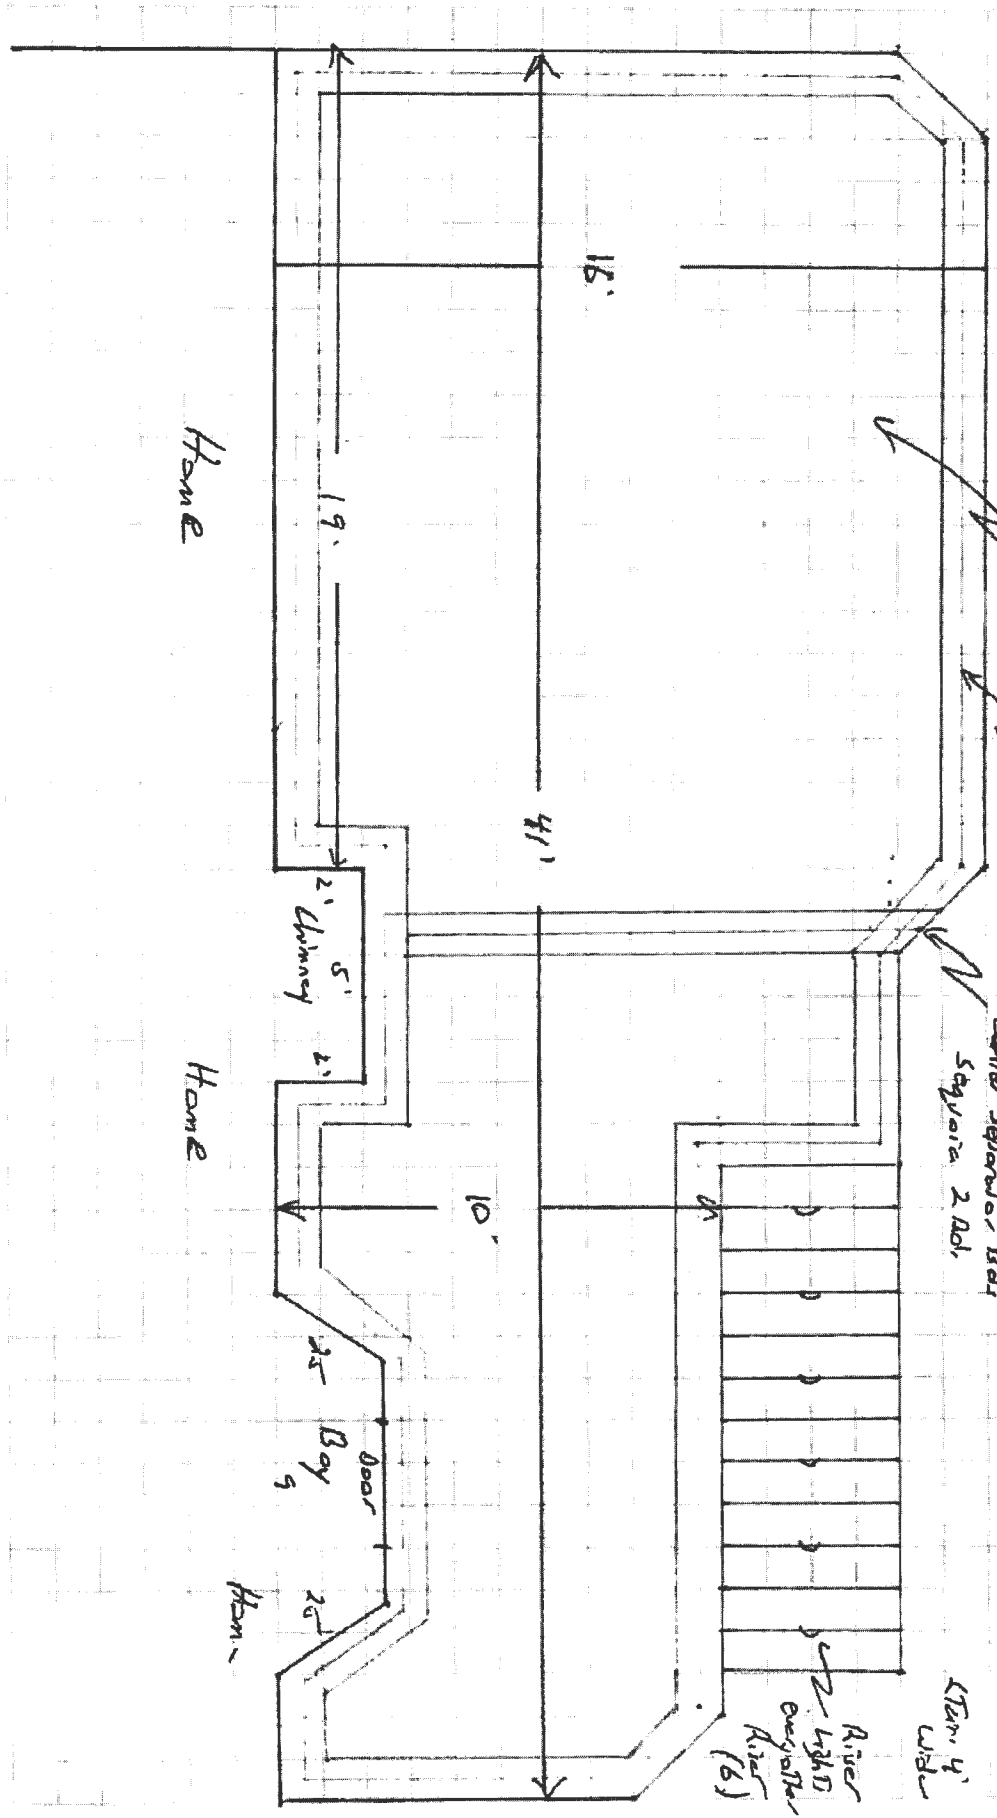

All Interior Panels Hidden by Trim - Olive Wood!
 Bonds & Add. Pict. Frame - Sycamore!
 Center Separators, Add. Sycamore 2 Add.

Rivets high D over Rivets (6)
 Trim 4" wide

Home

Home

Home