

\*\*\*\*\*  
 WATER WELL ABANDONMENT-SEALING REPORT FORM  
 \*\*\*\*\*

SUBMIT COPIES OF COMPLETED FORM TO:

- \* COUNTY ENVIRONMENTAL AGENCY (contact MDE, WMA if address needed)
- \* WELL OWNER
- \* MDE, WATER MANAGEMENT ADMINISTRATION, WELL PROGRAM

APPROVED  
 06/22/2020  
 (Signature)

DATE WELL ABANDONED: May 6, 2020 (month/day/year)

\* PERMIT NUMBER OF ABANDONED WELL (if any)

X - X - X


\* PERMIT NUMBER OF REPLACEMENT WELL:

\* PERSON ABANDONING WELL: John Hess WELL DRILLER'S LICENSE NUMBER: 553

\* OWNER'S NAME: Howard County / State Highway Admin CIRCLE: ~~MWD~~ / MSD / MGD

\* WELL LOCATION:  
 COUNTY: Howard  
 NEAREST TOWN: West Friendship  
 TAX MAP 15 BLOCK PARCEL 93  
 SUBDIVISION: 201  
 SECTION: \_\_\_\_\_ LOT: \_\_\_\_\_  
 STREET ADDRESS: 3106 MD Rt 32

SITE LOCATION MAP

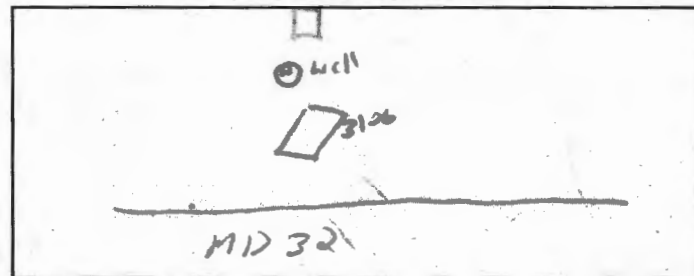

LATITUDE 3 9.284477  
 LONGITUDE 7 6.965902

LOG OF SEALING MATERIAL

MATERIAL	FEET	
	FROM	TO
<u>Quik Coat</u>	<u>76</u>	<u>9</u>
VOLUME OF MATERIAL USED		
<u>5 soft bags 130 gallons</u>		

\* TYPE OF WELL BEING ABANDONED:  
 DRILLED \_\_\_\_\_ JETTED  
 \_\_\_\_\_ BORED \_\_\_\_\_ HAND DUG  
 \_\_\_\_\_ OTHER (specify) \_\_\_\_\_

\* USE CODE:  
 DOMESTIC \_\_\_\_\_ MUNICIPAL/PUBLIC  
 \_\_\_\_\_ IRRIGATION \_\_\_\_\_ INDUSTRIAL  
 \_\_\_\_\_ TEST/OBSERVATION \_\_\_\_\_ GEOTHERMAL

\* TYPE OF CASING:  
 STEEL \_\_\_\_\_ PLASTIC  
 \_\_\_\_\_ CONCRETE \_\_\_\_\_ OTHER (specify) \_\_\_\_\_

SIZE OF CASING: 6 INCHES IN DIAMETER

DEPTH OF WELL: 76 FEET DEEP

WAS ANY CASING REMOVED? \_\_\_\_\_ YES  NO  
 If yes, length removed, in feet: X

WAS CASING CRIPPED OR PERFORATED? \_\_\_\_\_ YES  NO

SIGNATURE-MASTER WELL DRILLER OR SUPERVISING SANITARIAN LICENSE#  
John Hess

CIRCLE ONE MWD / MSD / MGS DATE May 6, 2020

COUNTY

50 WMA 13 WMS:33 REC'D BY WETT & ZELINSKI

Pursuant to § 10-624 of the State Govt. Article of the Maryland Code, personal info requested on this form is used in processing this form pursuant to COMAR 26.04.04. Failure to provide the info may result in this form not being processed. You have the right to inspect, amend, or correct this form. The Maryland Department of the Environment is subject to the Maryland Public Information Act. This form may be made available on the Internet via MDE's website and is subject to inspection or copying, in whole or in part, by the public and other governmental agencies, if not protected by federal or State Law.