

Menu Save Reset Cancel Help

Record Detail * (This section is required.)

Permit Type	Permit Number	Opened Date
Building/Residential/Misc/Tanks	B20002768	08/24/2020
Description of Work		
SFD//INSTALL A 1000 GAL UNDERGROUND PROPANE TANK		

check spelling

Address * (This section is required.)

Search Reset Clear Get Parcel & Owner

Street #	Street Name	Street Type	
4360	LINTHICUM	RD	
Unit Type	Unit #	X Coordinate	Y Coordinate
--Select--		-76.99489	39.25091
City	State	Zip Code	Primary
DAYTON	MD	21036	Yes

OK
reb
8/28/2020

Parcel * (This section is required.)

Search Reset Clear Get Address & Owner

GIS ID *	Parcel	Parcel Area	Land Value	Improved Value	Exemption Value	Plan Area
11060574	561	43124	231100	231100	0	RURAL
Legal Description						
43,124 SQ' []LINTHICUM []DAYTON						

check spelling

Block	Lot	Census Tract	Council Dist	Inspection Dist	Supervisor Dist	Map #	DAP Zone
		605101	5				
Plan Area	State Tax Id	Subdivision Name					
	1405435005						
Section	Area	Tax Map					
		22					
Grid	Zoning District	ADC Map					
22-19	RC-DEO	4813-A10					
SDP No.	Final Plan No.	WP File No.					
Record Plat No.	WS Contract No.	FDP No.	Primary				
			Yes				
Owner Occupied	Year Built	Historic District					
<input type="radio"/> Yes <input checked="" type="radio"/> No		<input type="radio"/> Yes <input checked="" type="radio"/> No					
Historic District Registry No.	Stat Area	Flood Plain					
	5-01	<input type="radio"/> Yes <input checked="" type="radio"/> No					
Building No							

Owner * (This section is required.)

Search Reset Clear

Name *
 KENNETH MUELLER

Address Line 1
 7014 MINK HOLLOW ROAD

Address Line 2

Address Line 3

Mail City **Mail State** **Mail Zip Code**
 HIGHLAND MD 20777

Phone **Primary**
 443-610-7514 Yes

E-mail

Cell Number **Fax Number**

B20002768
 'OK' reb 8/28/2020

Professionals (This section is not required.)

Search Reset Clear

License # * **Business Name**
 20100081215 AIR GAS

License Type * **First Name** **Middle Name** **Last Name**
 Propane Gs DENNIS FEAGA

Primary **Address Line 1**
 Yes 6750 MACLEAN DRIVE STE B

Address Line 2
 1625 HENRYTON RD

City **State** **ZIP Code**
 GLEN BURNIE MD 21060

Phone 1 **Phone 2** **Fax**
 4104425623 4104425623

E-mail

Applicant (This section is not required.)

Search As Owner As Lic. Prof As Contact

Type * **First Name** **MI** **Last Name**
 Applicant MICHELLE CLANCY

Relationship **Full Name**
 Applicant MICHELLE CLANCY

Primary **Organization Name**
 Yes APPLIED & APPROVED PERMITS LLC

Street Address
 P.O. BOX 310

Address Line 2

City **State** **Zip Code**
 PERRY HALL MD 21128

Phone **Cell** **Fax**
 443-340-1229 _____

E-mail *
 MICHELLE@APPLIEDANDAPPROVED.COM

B20002768
'OK' rj
8/28/2020

Addtl Info

Est Construction Cost *	Housing Units *	Number of Buildings *	Public Owned
3000	0	0	No
Construction Type			
--Select--			

TANK INFORMATION

RESIDENTIAL TANK INFORMATION

Capital Project-No Fee *	Capital Project Number	Fee Exempt *	Roadside Tree Project Permit *	Roadside Tree Permit #
<input type="radio"/> Yes <input checked="" type="radio"/> No		<input type="radio"/> Yes <input checked="" type="radio"/> No	<input type="radio"/> Yes <input checked="" type="radio"/> No	
Existing Use	Number of Tanks Installed *	Number of Tanks Removed *		
--Select--	1	0		
Water Supply	Sewage Disposal	Expiration Date	Relocate Existing Tank *	
Private	Private	2/21/2021	0	

PAYMENT INFORMATION

Check 1	Payee 1	Check 2	Payee 2	SAP Doc No	SAP Entered

Submit Cancel

LINTHICUM ROAD

APPROVED
WALK-THRU BUILDING PERMIT
BP#
APR. SAN. *Hank*
DATE: *3/29/2020*
DESC. OF WORK: *100-gal CP tank & 5' from Septic Tank*

Online Permit
B22002768



JIANGHAO SUN &
PING GENG
CLR17526 P139

HERBERT M. & RITA SAUNDERS KIRCH
CUR4307 P306

BG&E.359319

DRIVEWAY DETAIL
SCALE: 1"=20'

PLAN VIEW
SCALE: 1"=30'

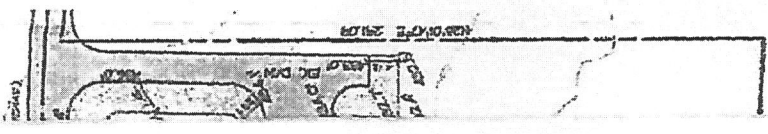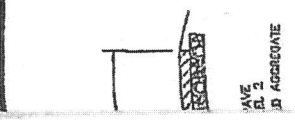

43600 Linticum Rd
Darton

1"=60'

