

Menu Save Reset Cancel Help

Record Detail * (This section is required.)

Permit Type	Permit Number	Opened Date
Building/Residential/Misc/Pool Spa	B20003362	10/02/2020
Description of Work		
SFD/40' x 20' In-Ground Swimming Pool, Depth 3.5' - 8', raised spa 24"- 7' x 7', water filled by truck with fence to code		

[check spelling](#)

Address * (This section is required.)

Search Reset Clear Get Parcel & Owner

Street #	Street Name	Street Type	
14238	MEADOW LAKE	DR	
Unit Type	Unit #	X Coordinate	Y Coordinate
--Select--		-77.01681	39.25897
City	State	Zip Code	Primary
GLENELG	MD	21737	Yes

Parcel * (This section is required.)

Search Reset Clear Get Address & Owner

GIS ID *	Parcel	Parcel Area	Land Value	Improved Value	Exemption Value	Plan Area
829797	97	1.16	226600	966800	740200	RURAL

Legal Description

IMPSLOT 15 1.160 A[]14238 MEADOW LAKE DR[]TRIADELPHIA CROSSING P1

[check spelling](#)

Block	Lot	Census Tract	Council Dist	Inspection Dist	Supervisor Dist	Map #	DAP Zone
9999	15	605601	5				

Plan Area	State Tax Id	Subdivision Name	
	1404369211	TRIADELPHIA CROSSING	
Section	Area	Tax Map	
		21	
Grid	Zoning District	ADC Map	
21-17	RC-DEO	4812-H9	
SDP No.	Final Plan No.	WP File No.	Primary
	F-04-118		Yes
Record Plat No.	WS Contract No.	FDP No.	
17235			
Owner Occupied	Year Built	Historic District	
<input type="radio"/> Yes <input type="radio"/> No	2006	<input type="radio"/> Yes <input checked="" type="radio"/> No	
Historic District Registry No.	Stat Area	Flood Plain	
	4-09	<input type="radio"/> Yes <input checked="" type="radio"/> No	

Building No

Owner * (This section is required.)

Search Reset Clear

Name *

Address Line 1

Address Line 2

Address Line 3

Mail City

Mail State

Mail Zip Code

Phone

Primary

E-mail

Cell Number

Fax Number

Professionals (This section is not required.)

Search Reset Clear

License # *

Business Name

License Type *

First Name

Middle Name

Last Name

Primary

Address Line 1

Address Line 2

City

State

ZIP Code

Phone 1

Phone 2

Fax

E-mail

Applicant (This section is not required.)

Search As Owner As Lic. Prof As Contact

Type *

First Name

MI

Last Name

Relationship

Full Name

Primary

Organization Name

Street Address

Address Line 2

City	State	Zip Code
West Friendship	MD	21794
Phone	Cell	Fax
410-489-9890	301-452-3160	
E-mail *		
customhomepools@gmail.com		

Addtl Info

Est Construction Cost *	Housing Units *	Number of Buildings *	Public Owned
100000	0	0	No
Construction Type			
434 - Additions, Alterations and Conversions - Residential			

POOL INFORMATION

MISCELLANEOUS POOL INFORMATION

Capital Project-No Fee *	Capital Project Number	Fee Exempt *	Water Supply *	Sewage Disposal *
<input type="radio"/> Yes <input checked="" type="radio"/> No		<input type="radio"/> Yes <input checked="" type="radio"/> No	Private	Private
Existing Use	Type of Pool or Spa *	Electrical Permit Number	Expiration Date	
SFD	In Ground Pool		4/3/2021	

PAYMENT INFORMATION

Check 1	Payee 1	SAP Doc No	SAP Entered

Related Records



« 1 »

<u>Permit Number</u>	<u>Record Type Alias</u>	<u>Status</u>	<u>Number</u>	<u>Street Name</u>	<u>Opened Date</u>	<u>Des</u>
B20003362	Residential Pool or Spa Permit	Review In Process	14238	MEADOW LAKE	10/02/2020	SFI
E20004509	Residential Electrical Miscellaneous Permit	Issued	14238	MEADOW LAKE	10/12/2020	Bor

« 1 »

< _____ >

Submit **Cancel**

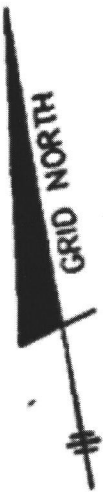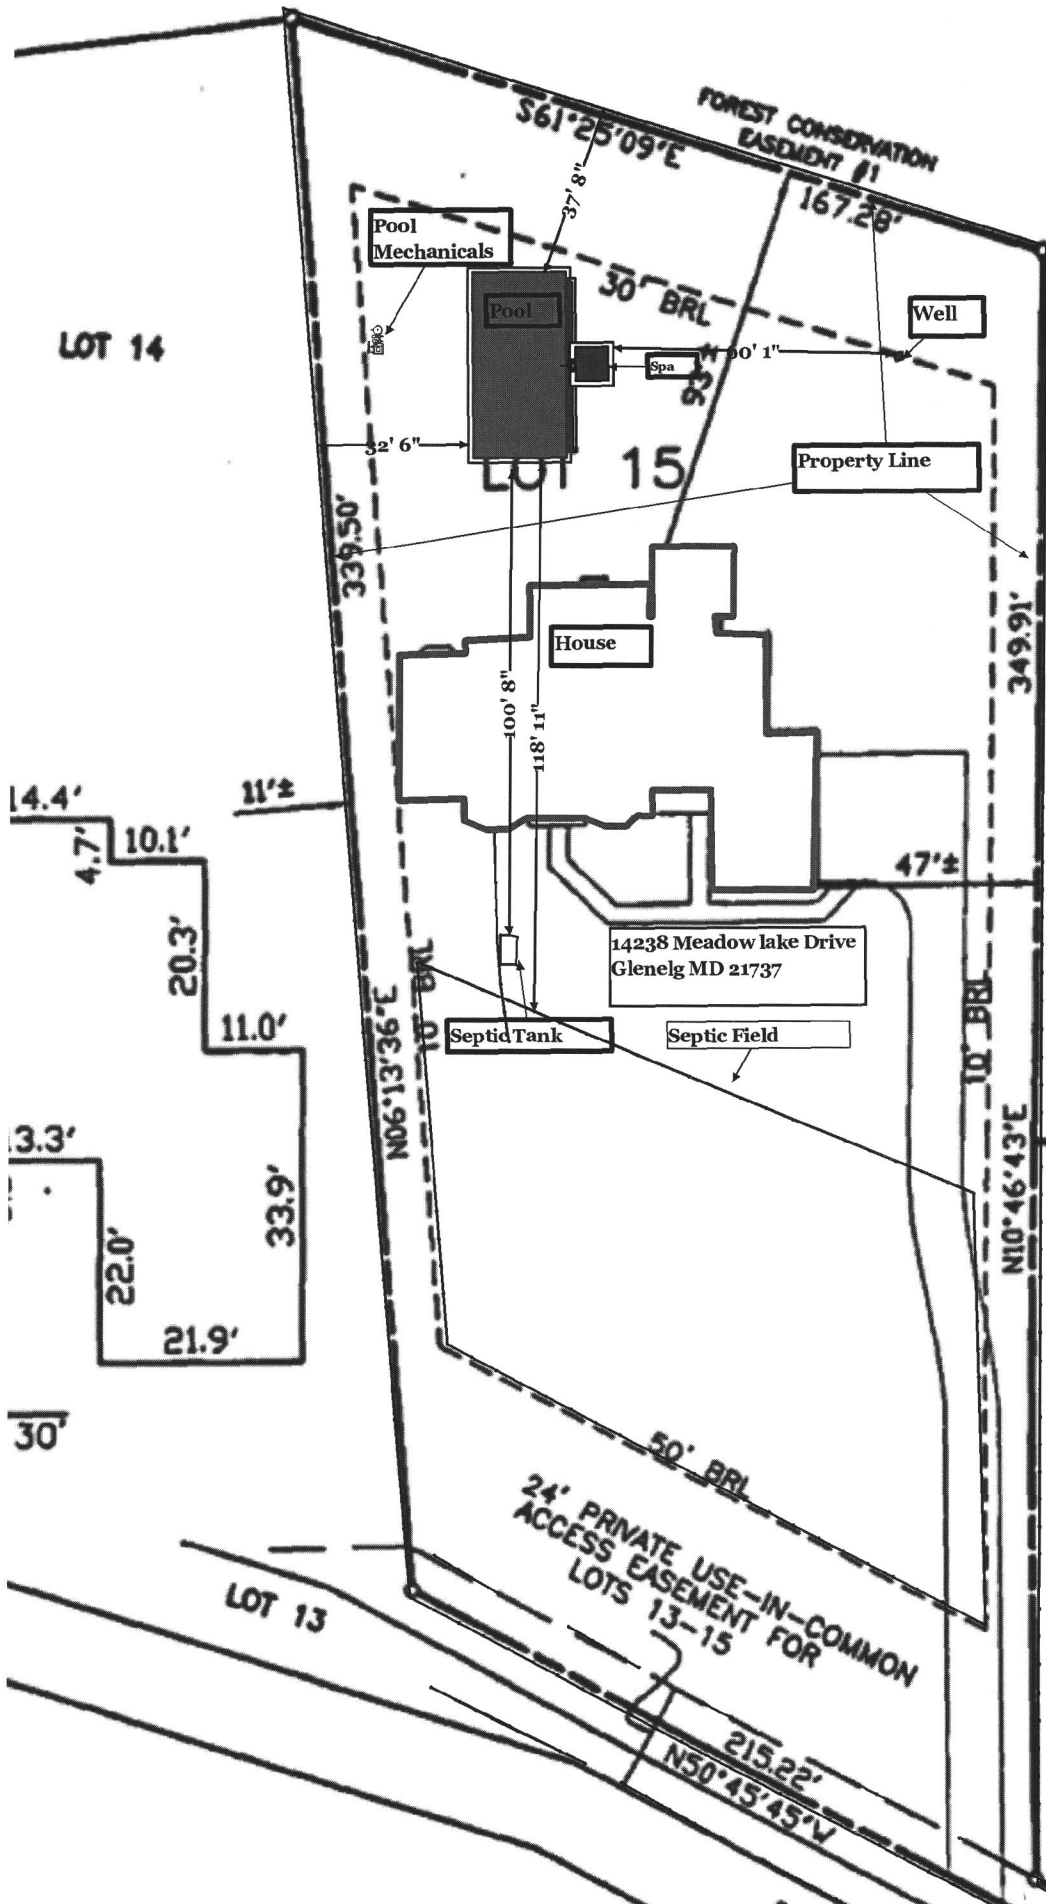

PARCEL 227
 N/F
 CLARKS WOODS I
 EDGEBROOK FARM, INC.
 NON-BUILDABLE
 PRESERVATION PARCEL A
 4839/244
 PLAT NO. 14203
 ZONED RC-DEO

6' PUBLIC BIT
 MAINTENANCE EA