

Online Permit
Approved

B20002948

Menu Save Reset Cancel Help

Record Detail * (This section is required.)

Permit Type	Permit Number	Opened Date
Building/Residential/Misc/Deck	B20002948	09/02/2020

Description of Work

Construct a 600 sq ft synthetic deck on the rear of home. Deck will include 2 sets of stairs and be roughly 4 to 5 ft off the ground level. Finally the deck will include a 12 x 12 octagonal shaped screened in gazebo also to be constructed of synthetic materials. Deck will be built to code.

[check spelling](#)

Address * (This section is required.)

Search Reset Clear Get Parcel & Owner

Street #	Street Name	Street Type	
12833	LIME KILN	RD	
Unit Type	Unit #	X Coordinate	Y Coordinate
--Select--		-76.96447	39.1513
City	State	Zip Code	Primary
HIGHLAND	MD	20777	Yes

Parcel * (This section is required.)

Search Reset Clear Get Address & Owner

GIS ID *	Parcel	Parcel Area	Land Value	Improved Value	Exemption Value	Plan Area
925928	12,114	3.09	240600	1169300	928700	RURAL

Legal Description

IMPVLOT 13 3.0906 A[]12833 LIME KILN ROAD[]LIME KILN VALLEY PH I&II

[check spelling](#)

Block	Lot	Census Tract	Council Dist	Inspection Dist	Supervisor Dist	Map #	DAP Zone
	13	605102	5				

Plan Area	State Tax Id	Subdivision Name
	1405450632	Lime Kiln Valley

Section	Area	Tax Map
		45

Grid	Zoning District	ADC Map
45-4	RR-DEO	5051-F6

SDP No.	Final Plan No.	WP File No.	Primary
	F-06-107		Yes

Record Plat No.	WS Contract No.	FDP No.
19732-1973		

Owner Occupied	Year Built	Historic District
<input type="radio"/> Yes <input checked="" type="radio"/> No	2012	<input type="radio"/> Yes <input checked="" type="radio"/> No

Historic District Registry No.	Stat Area	Flood Plain
	5-15A	<input type="radio"/> Yes <input checked="" type="radio"/> No

Building No

Owner * (This section is required.)

Search Reset Clear

Name *

BALTIMORE WASHINGTON CONFERENCE		
Address Line 1		
11711 E. MARKET PL		
Address Line 2		
Address Line 3		
Mail City	Mail State	Mail Zip Code
FULTON	MD <input checked="" type="checkbox"/>	20759
Phone	Primary	
301-992-7335	Yes <input checked="" type="checkbox"/>	
E-mail		
Cell Number	Fax Number	

Professionals (This section is not required.)

Search Reset Clear

License # *	Business Name		
08050125616	HAMMERHEAD CONTRACTING CORPORATION		
License Type *	First Name	Middle Name	Last Name
MHIC Co <input checked="" type="checkbox"/>	JEFFREY		WILSON
Primary	Address Line 1		
Yes <input checked="" type="checkbox"/>	3805 BELL ROAD		
Address Line 2			
City	State	ZIP Code	
BURTONSVILLE	MD	20866-0000	
Phone 1	Phone 2	Fax	
3019927335		3014210782	
E-mail			
HAMMERHEAD2139@GMAIL.COM			

Applicant (This section is not required.)

Search As Owner As Lic. Prof As Contact

Type *	First Name	MI	Last Name
Applicant <input checked="" type="checkbox"/>	JEFFREY		WILSON
Relationship	Full Name		
Applicant <input checked="" type="checkbox"/>	JEFFREY WILSON		
Primary	Organization Name		
Yes <input checked="" type="checkbox"/>	HAMMERHEAD CONTRACTING CORPORATION		
Street Address			
3805 BELL ROAD			
Address Line 2			
City	State	Zip Code	
BURTONSVILLE	MD	20866-0000	
Phone	Cell	Fax	
3019927335		3014210782	
E-mail *			
HAMMERHEAD2139@GMAIL.COM			

Addtl Info

Est Construction Cost *	Housing Units *	Number of Buildings *	Public Owned
77000	0	0	No <input checked="" type="checkbox"/>
Construction Type			

--Select--

MISC PERMIT INFO

MISCELLANEOUS PERMIT INFORMATION


Capital Project-No Fee * Yes No Capital Project Number Fee Exempt * Yes No Roadside Tree Project Permit * Yes No Roadside Tree Project Permit #

Existing Use * Water Sewage Expiration Date

PAYMENT INFORMATION

Check 1	Payee 1	Check 2	Payee 2	SAP Doc No	SAP Entered
<input type="text"/>	<input type="text"/>	<input type="text"/>	<input type="text"/>	<input type="text"/>	<input type="text"/> <input type="button" value=""/>

Submit Cancel

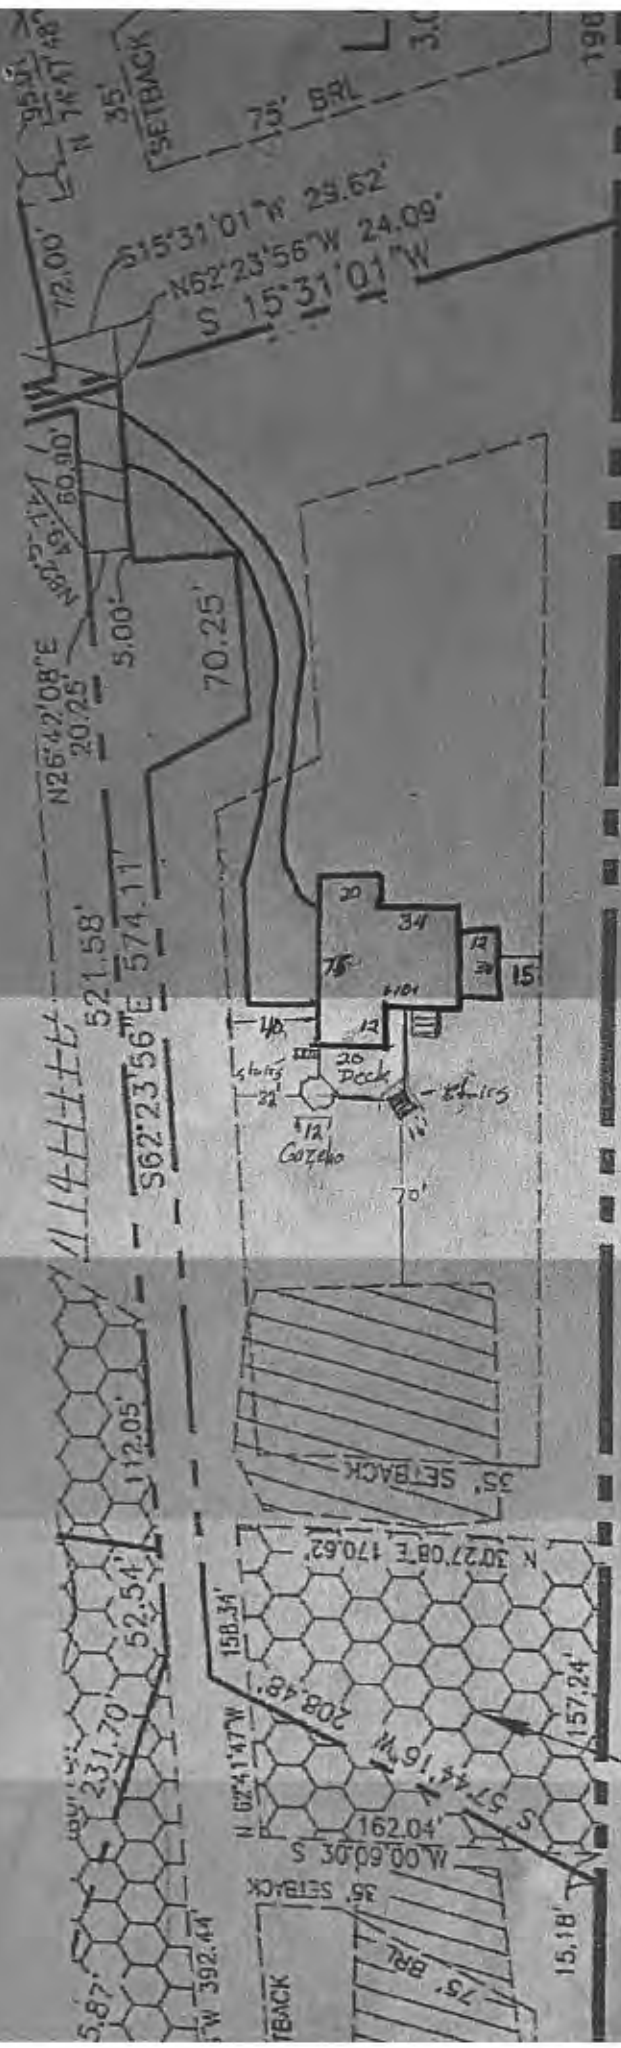

N 59° 35' 23" W 1708.62'

* NOTE: PLANTING OF ANY NATURE IS PROHIBITED
 WITHIN THE SEWERAGE DISPOSAL FACILITY

EAST CONSERVATION
 ELEMENT 7, RETENTION