

Menu Refine Search GIS Help Data Filter: Filter TMP's My Filters

Showing 1 of 1

<input type="checkbox"/> Permit #	Status	Record Type Alias	Street #	Street Name	Type	Unit Type	Unit #	City
<input type="checkbox"/> <u>B21002375</u>	Review In Process	Residential Deck Permit	3236	JONES	RD			WOODB








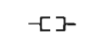
Page of 1


Approved Septic System Plan
 Howard County Health Department
Dana Bernard 6-29-21
 Signature Date
 B21002375

OWNER/APPLICANT:
GORDON WALLACE
3236 JONES ROAD
WOODBINE, MD 21797

BUILDER:
HB HOMES LLC
719 LAKE VARUNA DR.
GAITHERSBURG, MD 20878
240-848-2045


LEGEND:

- PROPOSED HOUSE 
- LIMIT OF DISTURBANCE 
- SUPER SILT FENCE 
- SILT FENCE 
- EXISTING CONTOUR 
- PROPOSED CONTOUR 
- PROPOSED WELL 
- PROPOSED SEPTIC 

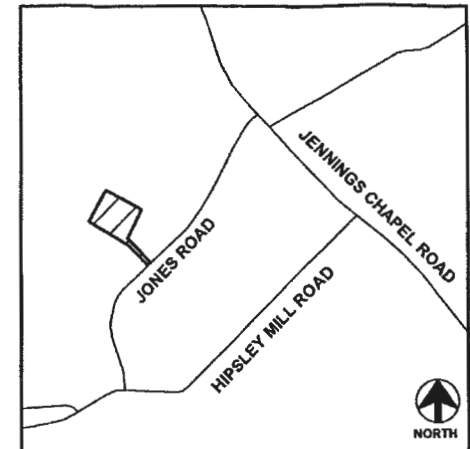


VICINITY MAP
SCALE: 1" = 2,000'

PLOT PLAN
3236 JONES RD.
Parcel 43
Election District 04
Tax Map 20
Howard County, Maryland
Date: 10/04/13
Sheet 1 of 2

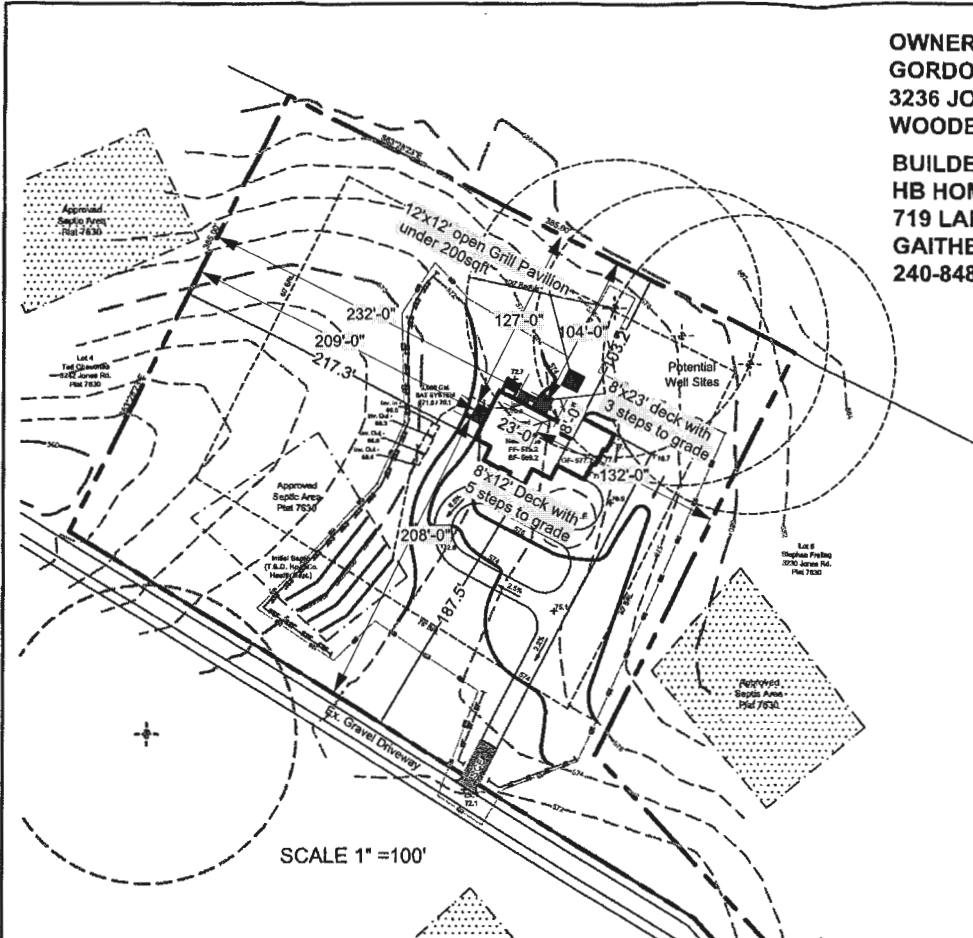

SCALE 1" = 100'

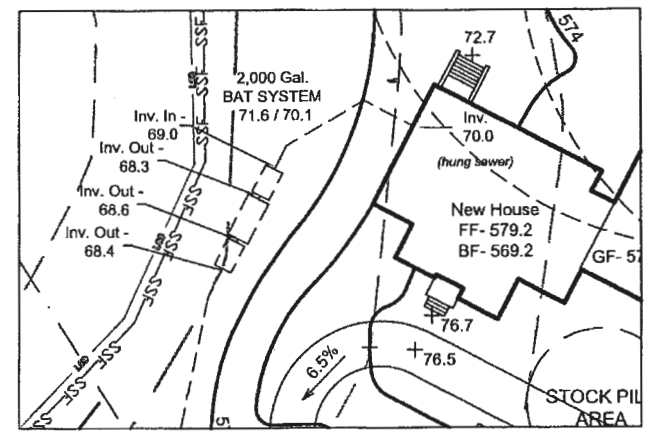

DETAIL VIEW: SEPTIC
1" = 40'

SOURCE OF TWO-FOOT CONTOUR INTERVAL TOPOGRAPHY:
 FISHER, CARTER, & COLLINS INC.
 CIVIL ENGINEERING CONSULTANTS & LAND SURVEYORS
 10272 BALTIMORE NATIONAL PIKE
 ELLICOTT CITY, MD 21042
 410-465-2885

Approved Septic System Plan
Howard County Health Department

Kama Dwyer
 Signature
 B&A
 6-29-13
 240-848-2045

Benning & Associates, Inc.
 Land Planning Consultants
 8933 Shady Grove Court
 Gaithersburg, MD 20877
 (301)948-0240

I HEREBY CERTIFY THAT THESE DOCUMENTS WERE PREPARED OR APPROVED BY ME, AND THAT I AM A DULY LICENSED PROFESSIONAL LANDSCAPE ARCHITECT UNDER THE LAWS OF THE STATE OF MARYLAND, LICENSE NO. 2001, EXPIRATION DATE 10/21/2014



David William McKee
 10-4-13