

Save Reset Cancel Help

Record Detail * (This section is required.)

Permit Type	Permit Number	Opened Date
Building/Residential/Misc/Deck	B21003861	10/13/2021
Description of Work		
SFD/ CONSTRUCT 571 SQFT IRREGULAR SHAPED OPEN DECK WITH 2 SETS OF STEPS TO GRADE		

Approved RIK
10/18/2021

[check spelling](#)

Address * (This section is required.)

Search Reset Clear Get Parcel & Owner

Street #	Street Name	Street Type	
5045	LINDERA	CT	
Unit Type	Unit #	X Coordinate	Y Coordinate
--Select--		-76.94362	39.23518
City	State	Zip Code	Primary
ELLCOTT CITY	MD	21042	Yes

Parcel * (This section is required.)

Search Reset Clear Get Address & Owner

GIS ID *	Parcel	Parcel Area	Land Value	Improved Value	Exemption Value	Plan Area
1105355	49	38228	338800	1164300	825500	RURAL

Legal Description

IMPSLOT 123, 38,228 SQ[F]5045 LINDERA CT[WALNUT CREEK PHASE 4

[check spelling](#)

Block	Lot	Census Tract	Council Dist	Inspection Dist	Supervisor Dist	Map #	DAP Zone
	123	605101	5				
Plan Area	State Tax Id	Subdivision Name					
	1405598876	Walnut Creek					
Section	Area	Tax Map					
		28					
Grid	Zoning District	ADC Map					
28-12	RC-DEO	4933-J3					
SDP No.	Final Plan No.	WP File No.					
	F-07-076						
Record Plat No.	WS Contract No.	FDP No.	Primary				
23611-2362			Yes				
Owner Occupied	Year Built	Historic District					
<input type="radio"/> Yes <input type="radio"/> No	2017	<input type="radio"/> Yes <input checked="" type="radio"/> No					
Historic District Registry No.	Stat Area	Flood Plain					
	5-02A	<input type="radio"/> Yes <input checked="" type="radio"/> No					
Building No							


Owner * (This section is required.)

Search Reset Clear


Name *		
TIWARI KRIPA		
Address Line 1		
5045 LINDERA CT		
Address Line 2		
Address Line 3		
Mail City	Mail State	Mail Zip Code
ELLCOTT CITY	MD	21042
Phone	Primary	
410-549-5050	Yes	
E-mail		
Cell Number	Fax Number	

Professionals (This section is not required.)

1" = 40'

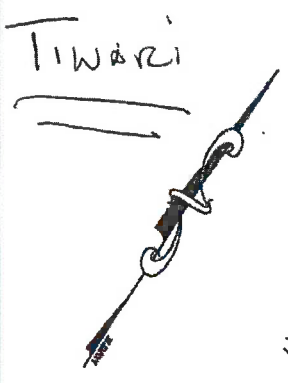

Approved
B21003861
10/18/2021
RLE

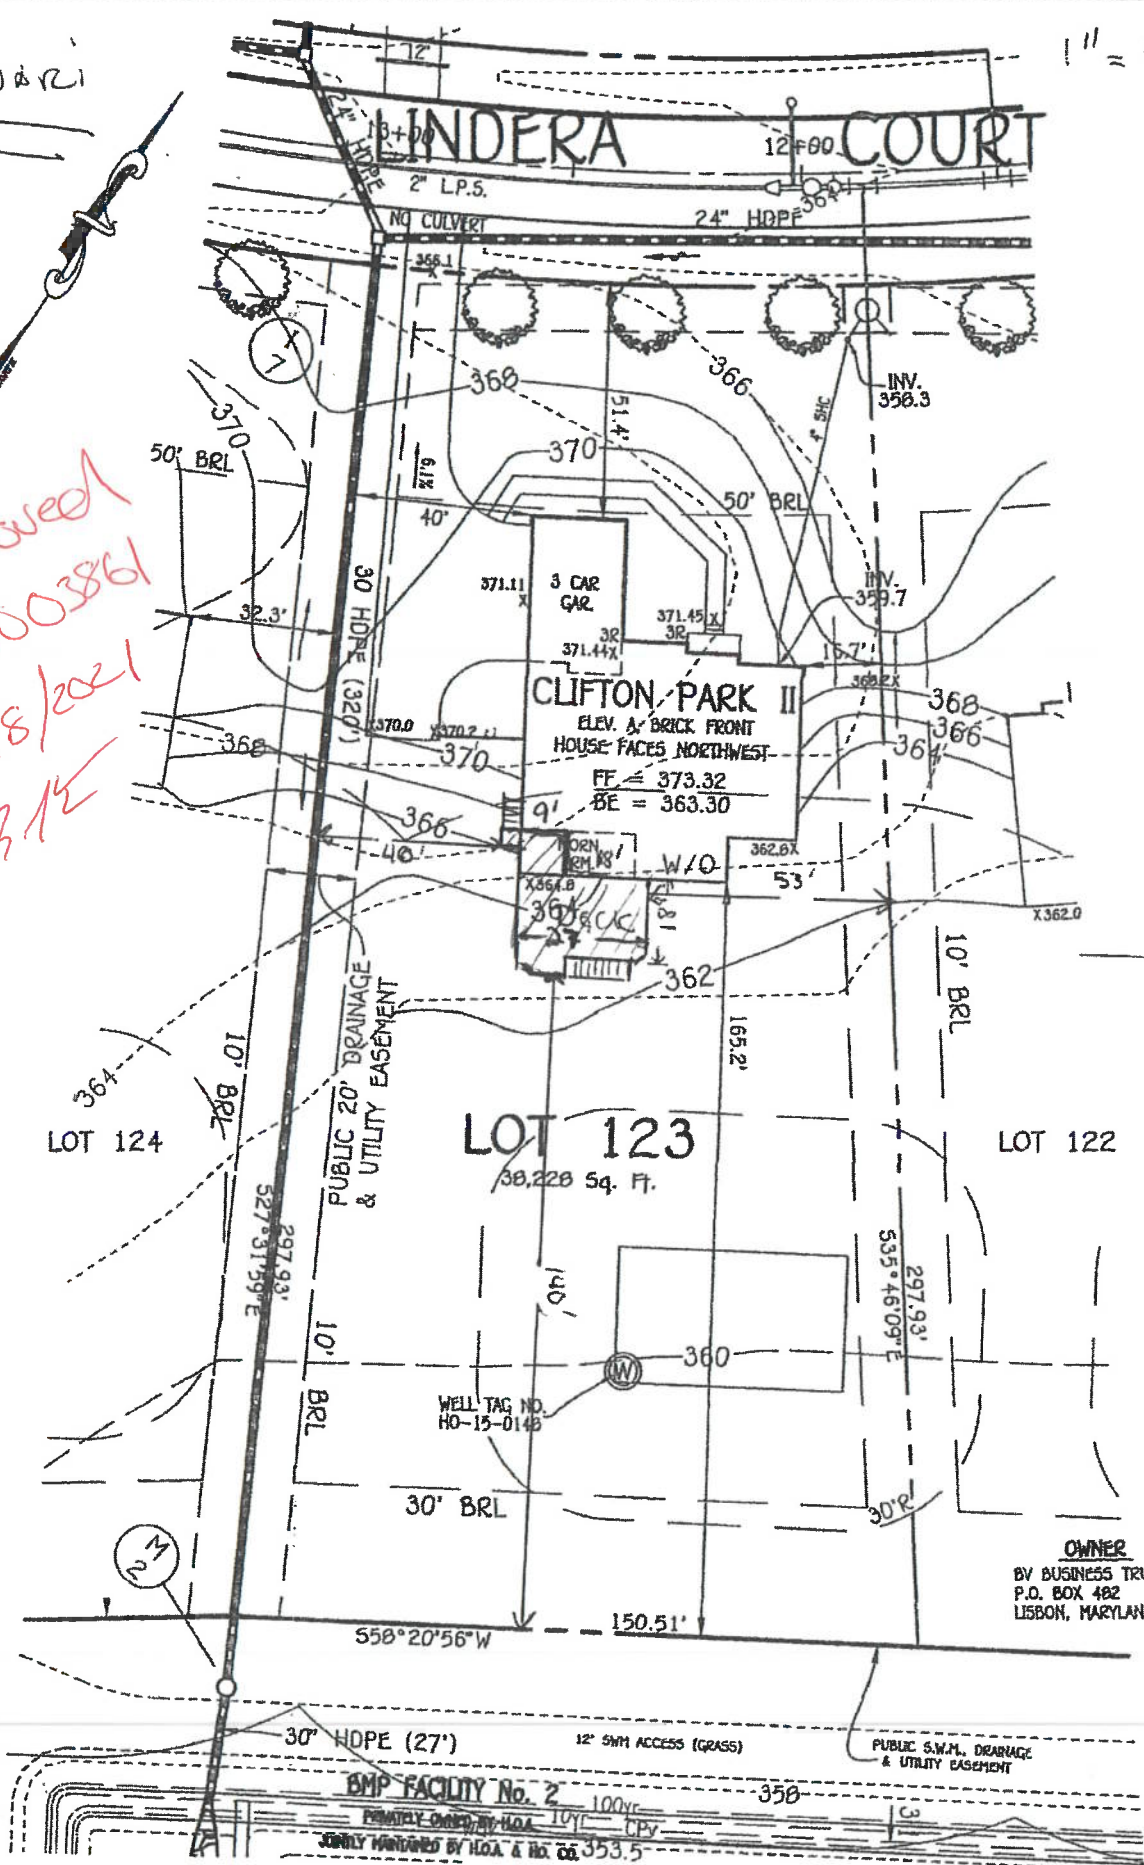

OWNER
BY BUSINESS TRUST
P.O. BOX 482
LISBON, MARYLAND 21765-0482

WELL CERTIFICATION:
THE EXISTING WELL, TAG NO. HO-15-0146, HAS BEEN

PLAN
SCALE: 1/8" = 1'-0"

PERMIT SITE PLAN
LOT 123

Permit Site Plans File #Per #Lot 123.dwg, 1/20/2017 10:54:09 AM, DWG To PDF.pc3