

PERMIT NUMBER: B 21003423

DATE ACCEPTED:

RECEIVED

SEP 10 2021



RESIDENTIAL BUILDING PERMIT APPLICATION

HOWARD COUNTY DEPARTMENT OF INSPECTIONS, LICENSES, AND PERMITS

LICENSES & PERMITS DIVISION

3430 COURT HOUSE DRIVE, ELLICOTT CITY, MD 21043 - PHONE: (410) 313-2455 OPTION #4

www.howardcountymd.gov

BUILDING SITE ADDRESS REQUIRED

Street Address: 4360 Linthicum Rd
City: Dayton
State: MD
Zip Code: 21036
Subdivision/Village/Complex Name:
SDP/WP/BA #:
Lot:
Tax Map:
Parcel:
Grading Permit #:

DESCRIPTION OF WORK REQUIRED

Existing Use: Unfinished Storage
Proposed Use: Finished Family Room Area
Estimated Cost: \$40,000.00
Trade Work to Be Completed (Separate Permits Required):
Mechanical (HVACR)
Electrical
Plumbing
None
Finish 900 SF Basement area to include Family Room, Play Room, finished Bath from previous rough-in. Utility Room and Storage area to be unfinished

PROPERTY OWNER INFORMATION REQUIRED

Owner(s) Name(s) (As it appears on tax records): Kenneth Mueller
Primary Residence: Yes No
Owner's Street Address: 4360 Linthicum RD
City: Dayton
State: MD
Zip Code: 21036
Phone: (443) 651-1470
Email: kwmuel5@aol.com

APPLICANT NAME REQUIRED - INDIVIDUAL WHO SIGNS THIS APPLICATION

Business Name: N/A
Contact Name: Kenneth Mueller
Street Address: 4360 Linthicum Rd
City: Dayton
State: MD
Zip Code: 21036
Phone: (443) 651-1470
Email: kwmuel5@aol.com

CONTRACTOR INFORMATION REQUIRED

Business Name: Moore Family Builders
Licensee's Name: Travis Wennrick
License #: 119198
Street Address: 75 Lori Lane
City: Littlestown
State: PA
Zip Code: 17340
Phone: (443) 250-5016
Email: moorefamilybuilders@gmail.com

ARCHITECT/ENGINEER INFORMATION INDIVIDUAL WHO SIGNED PLANS, IF APPLICABLE

Business Name: N/A
Name:
Street Address:
City:
State:
Zip Code:
Phone:
Email:

BUILDING CHARACTERISTICS REQUIRED

Primary Structure: SF Dwelling SF Townhouse SF Duplex Mobile Home Multi-Family Dwelling (MF*)
Condo: Yes No
Utilities: Electric Gas Water Supply: Public Private (Well) Sewage Disposal: Public Private (Septic)
Heating System: Electric Natural Gas Propane Other: Roadside Tree Project: No Yes: #
Sprinkler System: NFPA 13 NFPA 13R NFPA 13D None Fire Alarm System: Yes No Voice Evac

ADDITIONAL RESIDENTIAL INFORMATION (PLEASE SELECT/COMPLETE ALL THAT APPLY)

Model Name & Options:
of Bedrooms (SF): # of efficiency units (MF*): # of 1 BR (MF*): # of 2 BR (MF*): # of 3 BR (MF*):
Rooms: # Full Baths: # Half Baths: # Fireplaces:
Garage/Carport Info: Attached Garage Detached Garage Integral Garage Carport None
Basement/Foundation Info: Slab on Grade Post & Pier Unfinished Basement Finished Basement: Full or Partial
1st Fl Width: 1st Fl Depth: 2nd Fl Width: 2nd Fl Depth: Bsmt Width: Bsmt Depth:
Energy Method: Prescriptive Performance UA Alternative ERI Gross Area: sq ft Occupiable Area: sq ft

AGREEMENT/ DISCALIMER REQUIRED

THE UNDERSIGNED HEREBY CERTIFIES AND AGREES AS FOLLOWS: (1) THAT HE/SHE IS AUTHORIZED TO MAKE THIS APPLICATION; (2) THAT THE INFORMATION IS CORRECT; (3) THAT HE/SHE WILL COMPLY WITH ALL REGULATIONS OF HOWARD COUNTY WHICH ARE APPLICABLE THERETO; (4) THAT HE/SHE WILL PERFORM NO WORK ON THE ABOVE REFERENCED PROPERTY NOT SPECIFICALLY DESCRIBED IN THIS APPLICATION; (5) THAT HE/SHE GRANTS COUNTY OFFICIALS THE RIGHT TO ENTER ONTO THIS PROPERTY FOR THE PURPOSE OF INSPECTING THE WORK PERMITTED AND POSTING NOTICES.

APPLICANT'S ORIGINAL SIGNATURE DATE SIGNED 9/10/2021

FOR OFFICE USE ONLY CHECKS PAYABLE TO: DIRECTOR OF FINANCE OF HOWARD COUNTY


AGENCIES REQUIRED/APPROVALS:
PR DPZ DED Health SHA CID

SUBMITTAL FEES: 135- PAYMENT: pay online ACCEPTED BY: [Signature]



cadaworks inc.
RESIDENTIAL DESIGN
332 WEST PATRICK STREET / FREDERICK, MD / 21701
(V) 301.695.9101 (E) DESIGN@CADDWORKS.NET
(F) 301.695.4668 (W) WWW.CADDWORKS.NET

© Copyright Cadaworks, Inc. expressly reserves the copyright for the design and other property rights in this plan. These are not to be reproduced, changed or copied in any form or manner whatsoever, without the express written permission and consent of Cadaworks, Inc.

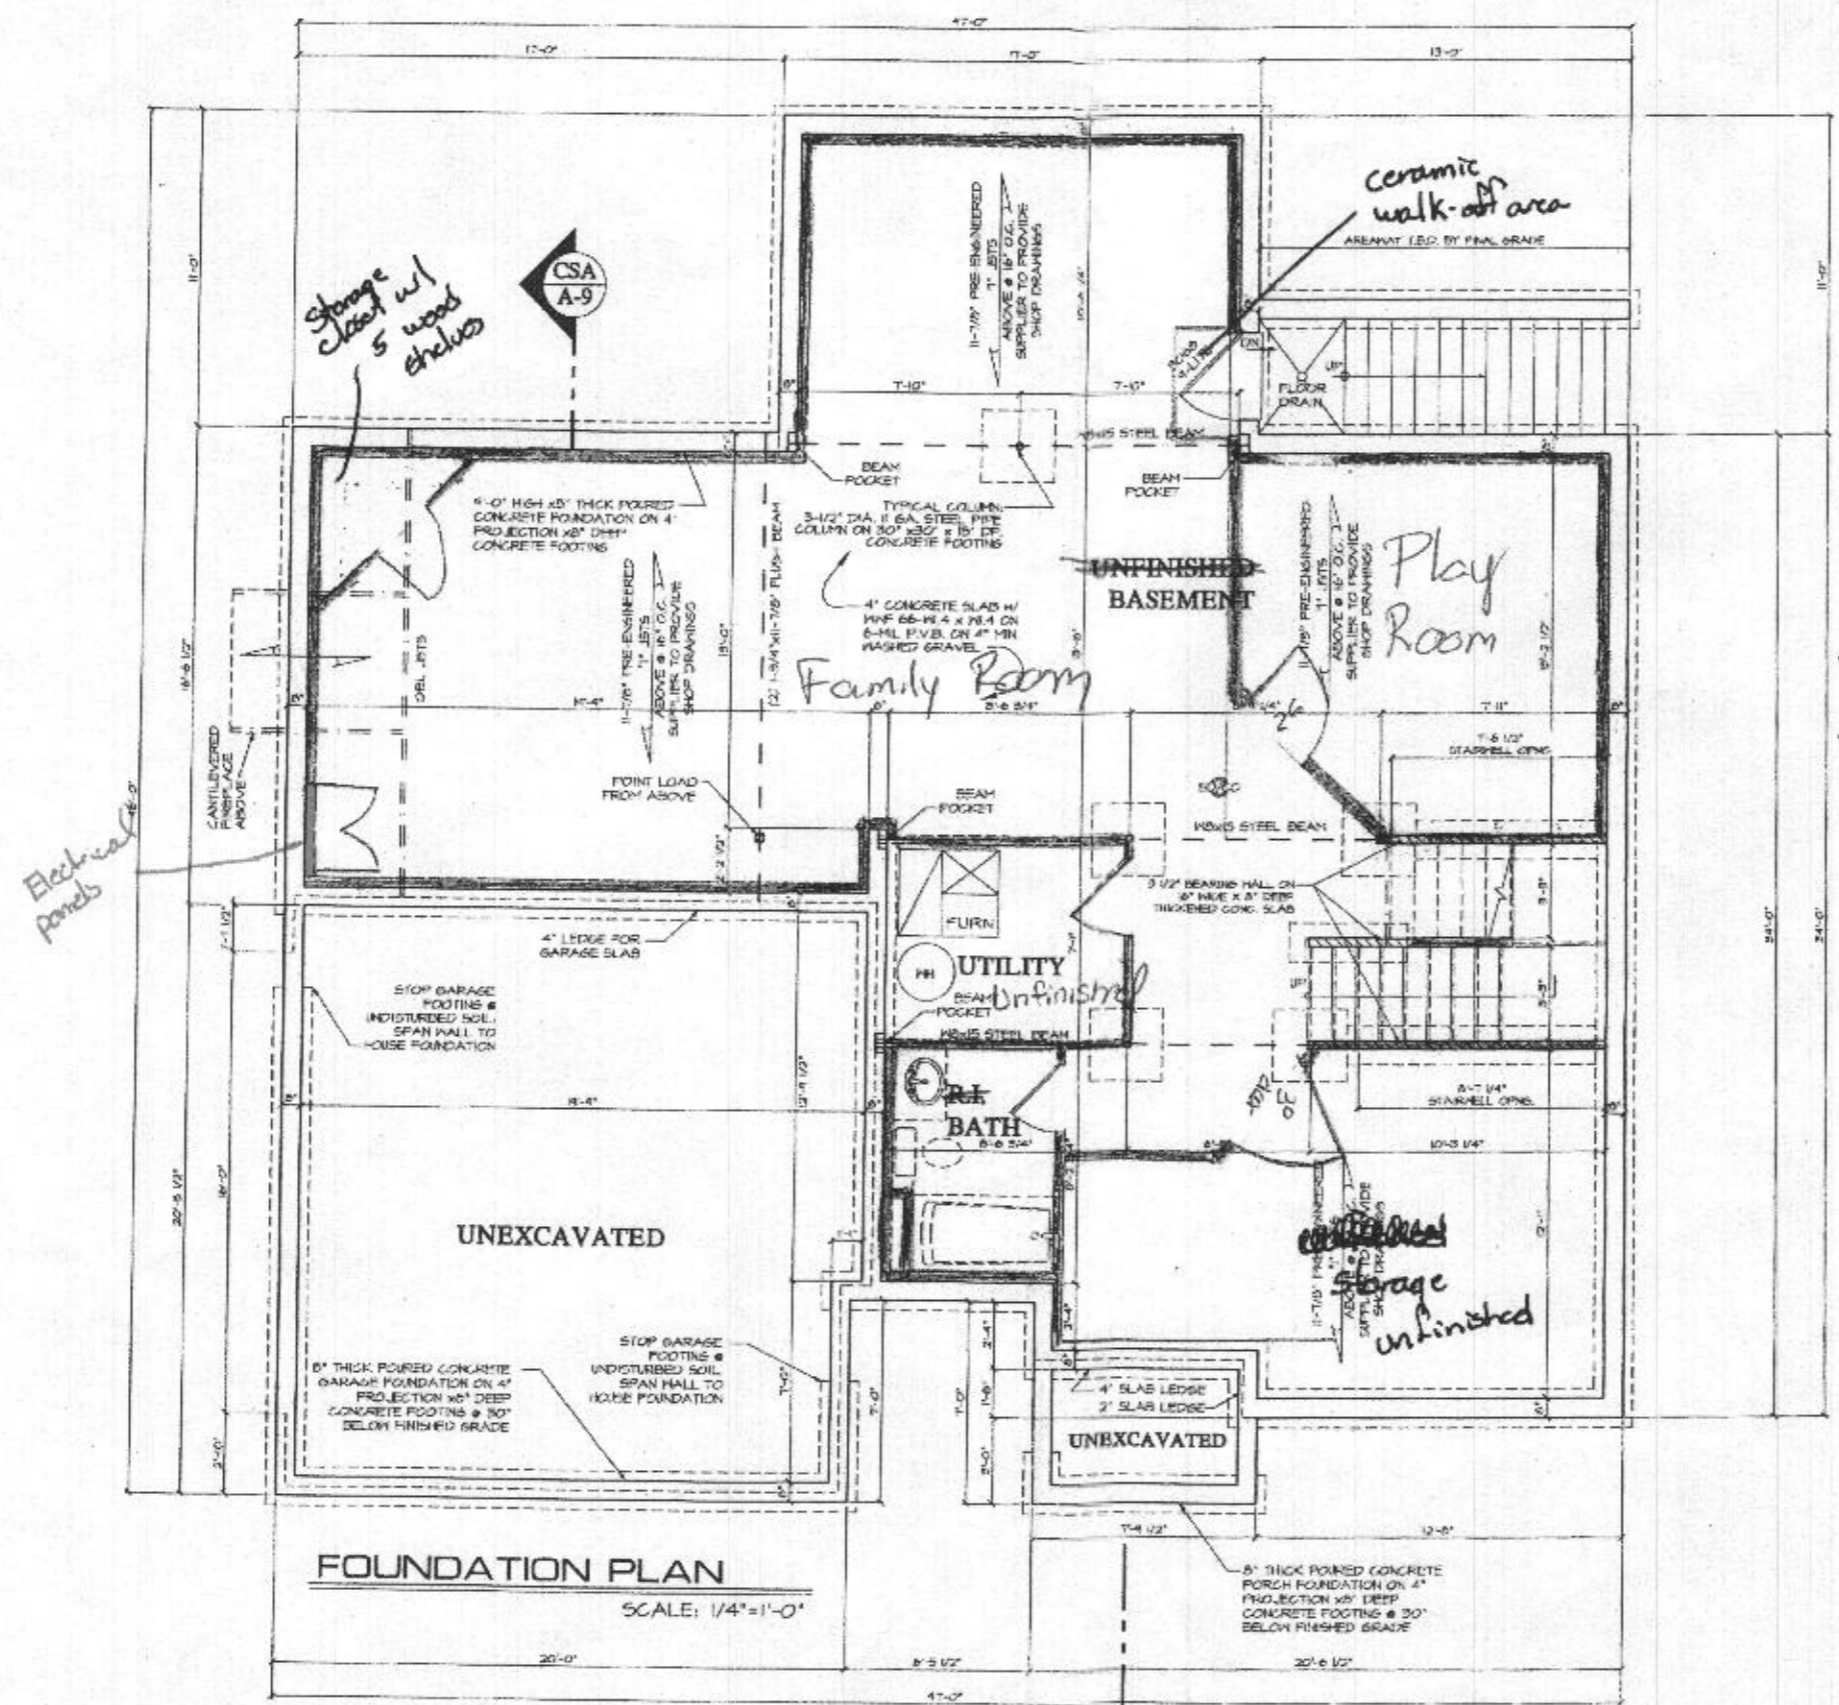

- 2x4 walls w/ treated bottom plates
- R13 batt insulation
- 1/2 drywall, screwed & glued

SUBMITTALS

ISSUE	DATE	REMARKS
1	12-20-21	PRELIMINARY PLAN
2	12-21-21	REVISED PLAN
3	1-29-22	REVISED PLAN
4	1-29-22	REVISED PLAN

FOUNDATION PLAN

FOUNDATION PLAN
SCALE: 1/4" = 1'-0"

Approved R/R #B 21003423
9/29/2021

PROPOSED NEW HOME FOR:
THE MUELLER FAMILY

SHEET NO.
A-1