

*n/k req. ex floor plan
 1/5 Exi Floor Plan submitted
 Approved*

Menu Save Reset Cancel Help

Record Detail * (This section is required.)

Permit Type	Permit Number	Opened Date
Building/Residential/Alteration/SFD	B20003792	11/03/2020
Description of Work		
SFD/ Finish basement to include: to include recreation room and full bath using existing rough in, unfinished storage, utility and shop. 1050 finished square feet.		

[check spelling](#)

Address * (This section is required.)

Search Reset Clear Get Parcel & Owner

Street #	Street Name	Street Type	
11058	HUNTERS VIEW	RD	
Unit Type	Unit #	X Coordinate	Y Coordinate
--Select--		-76.9009	39.24637
City	State	Zip Code	Primary
ELLCOTT CITY	MD	21042	Yes

Parcel * (This section is required.)

Search Reset Clear Get Address & Owner

GIS ID *	Parcel	Parcel Area	Land Value	Improved Value	Exemption Value	Plan Area
922080	20	42427	308400	740900	432500	RURAL
Legal Description						
IMPSLOT 12 42427 SQ[]11058 HUNTERS VIEW RD[]RIVERWOOD PHASE 1						

[check spelling](#)

Block	Lot	Census Tract	Council Dist	Inspection Dist	Supervisor Dist	Map #	DAP Zone
21	12	603000	5				
Plan Area	State Tax Id		Subdivision Name				
	1403345157		Riverwood				
Section	Area		Tax Map				
			29				
Grid	Zoning District		ADC Map				
29-4	RC-DEO		4934-F1				
SDP No.	Final Plan No.		WP File No.		Primary		
	F-04-082				Yes		
Record Plat No.	WS Contract No.		FDP No.				
18031-1804							
Owner Occupied	Year Built		Historic District				
<input type="radio"/> Yes <input type="radio"/> No	2010		<input type="radio"/> Yes <input checked="" type="radio"/> No				
Historic District Registry No.	Stat Area		Flood Plain				
	3-09A		<input type="radio"/> Yes <input checked="" type="radio"/> No				

Building No

Owner (This section is not required.)

Search Reset Clear

Name *

Address Line 1

Address Line 2

Address Line 3

Mail City	Mail State	Mail Zip Code
ELLICOTT CITY	MD	21042

Phone	Primary
240-441-8849	Yes

E-mail

Cell Number	Fax Number
<input type="text"/>	<input type="text"/>

Professionals (This section is not required.)

Search Reset Clear

License # *	Business Name		
08050129832	HUNTS END REMODELING LLC		
License Type *	First Name	Middle Name	Last Name
MHIC Co	MICHAEL		BIRNER
Primary	Address Line 1		
Yes	2600 LONGSTONE LANE SUITE 204		
	Address Line 2		
	<input type="text"/>		
	City	State	ZIP Code
	MARRIOTTSVILLE	MD	21104-0000
	Phone 1	Phone 2	Fax
	4109700084		2089068696
	E-mail		
	INFO@HUNTSSENDREMODELING.COM		

Applicant (This section is not required.)

Search As Owner As Lic. Prof As Contact

Type *	First Name	MI	Last Name
Applicant	MICHAEL		BIRNER
Relationship	Full Name		
Applicant	MICHAEL BIRNER		
Primary	Organization Name		
No	HUNTS END REMODELING LLC		
	Street Address		
	2600 LONGSTONE LANE SUITE 204		
	Address Line 2		
	<input type="text"/>		

City	State	Zip Code
MARRIOTTSVILLE	MD	211040000
Phone	Cell	Fax
4109700084		2089068696
E-mail *		
mike_birner@huntsendremodeling.com		

Contact (This section is not required.)

Search As Owner As Lic. Prof As Contact

Type	First Name	MI	Last Name
Contact	Michael	J	Birner
Relationship	Full Name		
Licensed Professional	Michael J Birner		
Primary	Organization Name		
Yes	Hunts End Remodeling, LLC		
Street Address			
2600 Longstone Lane, Suite 204			
Address Line 2			
City	State	Zip Code	
Marriottsville	MD	21104	
Phone	Cell	Fax	
4419700084			
E-mail			
mike_birner@huntsendremodeling.com			

Addtl Info

Est Construction Cost *	Housing Units *	Number of Buildings *	Public Owned
30000	0	0	No
Construction Type			
434 - Additions, Alterations and Conversions - Residential			

RESIDENTIAL ALTERATION INFO

RESIDENTIAL ALTERATION INFORMATION

Total Square Footage *	Bedrooms	Full Baths	Half Baths	Water *	Sewage *	Existing Utilities *
1050 SQFT	0	1	0	Private	Private	Gas & Electric
Existing Heating System *	Existing Sprinkler System *	Type of New Fireplace	Expiration Date	Fee Exempt *		
Natural Gas	None	--Select--	5/2/2021	<input type="radio"/> Yes <input checked="" type="radio"/> No		

PAYMENT INFORMATION

Check 1	Payee 1	Check 2	Payee 2	SAP Doc No	SAP Entered


Submit Cancel

Approved Septic System Plan
 Howard County Health Department
 Basement remodel to include
 Bath and Shop & Rec Room

B20003792

[Signature]
 Signature

11/15/2020
 Date

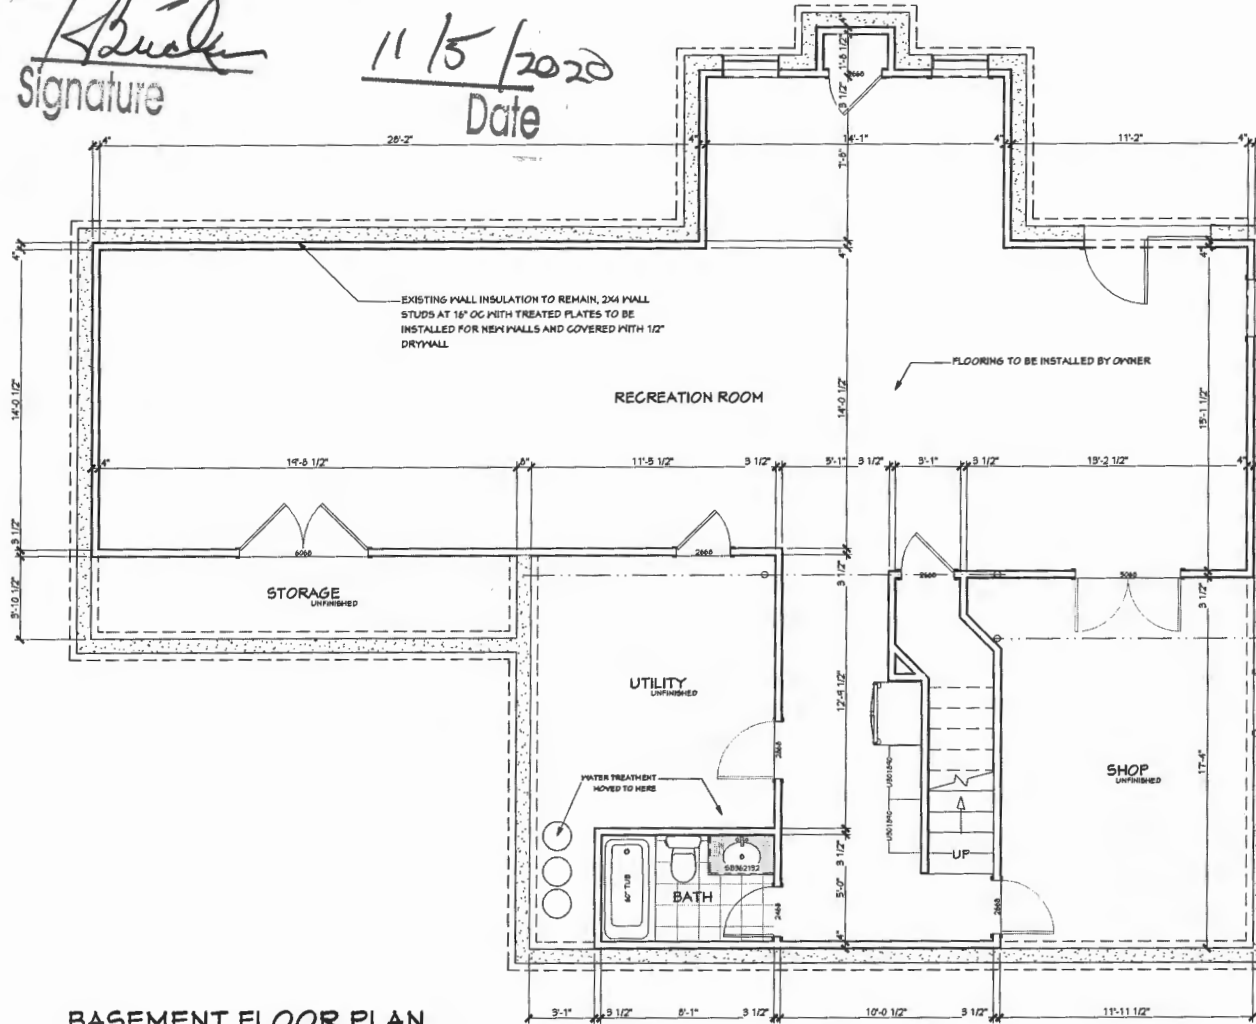

BASEMENT FLOOR PLAN

1050 FINISHED SQUARE FEET

H·E

HUNTS END
 REMODELING, LLC
 2800 LONGSTONE LANE
 SUITE 204
 MARRIOTTSVILLE, MD 21104
 410 910 0084
 INFO@HUNTSENDREMODELING.COM
 WWW.HUNTSENDREMODELING.COM

BASEMENT FINISHING FOR
 KIMJARONOVA RESIDENCE
 11058 HUNTERS VIEW ROAD
 ELLICOTT CITY, MD 21042

REVISED:	
BY	DATE

DATE:
 11/2/20

PAGE:
 A-1