

Menu Save Reset Cancel Help

Record Detail * (This section is required.)

Permit Type	Permit Number	Opened Date
Building/Residential/Misc/Pool Spa	B20004373	12/12/2020
Description of Work		
SFD/Construction of inground pool approx. 21' x 44', 870 square feet, 3.5-8' in depth and approx. 28,000 gallons of water. 48" fence to code		

[check spelling](#)

Address * (This section is required.)

Search Reset Clear Get Parcel & Owner

Street #	Street Name	Street Type	
5001	LINDERA	CT	
Unit Type	Unit #	X Coordinate	Y Coordinate
--Select--		-76.94263	39.23842
City	State	Zip Code	Primary
ELLCOTT CITY	MD	21042	Yes

Parcel * (This section is required.)

Search Reset Clear Get Address & Owner

GIS ID *	Parcel	Parcel Area	Land Value	Improved Value	Exemption Value	Plan Area
1101209	49	39639	340200	1053700	713500	RURAL
Legal Description						
IMPSLOT 66 39,639 SQ[]5001 LINDERA CT[]WALNUT CREEK PHASE 2						

[check spelling](#)

Block	Lot	Census Tract	Council Dist	Inspection Dist	Supervisor Dist	Map #	DAP Zone
	66	605101	5				
Plan Area	State Tax Id		Subdivision Name				
	1405595207		Walnut Creek				
Section	Area		Tax Map				
			28				
Grid	Zoning District		ADC Map				
28-12	RC-DEO		4933-K2				
SDP No.	Final Plan No.		WP File No.		Primary		
	F-07-076				Yes		
Record Plat No.	WS Contract No.		FDP No.				
22227-2224							
Owner Occupied	Year Built		Historic District				
<input type="radio"/> Yes <input type="radio"/> No	2015		<input type="radio"/> Yes <input checked="" type="radio"/> No				
Historic District Registry No.	Stat Area		Flood Plain				
	5-02A		<input type="radio"/> Yes <input checked="" type="radio"/> No				

Building No

Owner * (This section is required.)

Search Reset Clear

Name *

Address Line 1

Address Line 2

Address Line 3

Mail City Mail State Mail Zip Code

Phone

Primary

 Yes

E-mail

Cell Number

Fax Number

Professionals (This section is not required.)

Search Reset Clear

License # *

Business Name

License Type *

First Name

Middle Name

Last Name

Primary

 Yes

Address Line 1

Address Line 2

City

State

ZIP Code

Phone 1

Phone 2

Fax

E-mail

Applicant (This section is not required.)

Search As Owner As Lic. Prof As Contact

Type *

First Name

MI

Last Name

Relationship

Full Name

Primary

 Yes

Organization Name

Street Address

Address Line 2

City	State	Zip Code
ODENTON	MD	21113-0000
Phone	Cell	Fax
4437583480		
E-mail *		
STEPHENESTRADA@ME.COM		

Addtl Info

Est Construction Cost *	Housing Units *	Number of Buildings *	Public Owned
35000	0	0	No <input type="checkbox"/>
Construction Type			
434 - Additions, Alterations and Conversions - Residential <input type="checkbox"/>			

POOL INFORMATION


MISCELLANEOUS POOL INFORMATION

Capital Project-No Fee *	Capital Project Number	Fee Exempt *	Water Supply *	Sewage Disposal *
<input type="radio"/> Yes <input checked="" type="radio"/> No		<input type="radio"/> Yes <input checked="" type="radio"/> No	Private <input type="checkbox"/>	Private <input type="checkbox"/>
Existing Use	Type of Pool or Spa *	Electrical Permit Number	Expiration Date	
SFD <input type="checkbox"/>	In Ground Pool <input type="checkbox"/>		6/12/2021 <input type="checkbox"/>	

PAYMENT INFORMATION

Check 1	Payee 1	SAP Doc No	SAP Entered

Submit Cancel

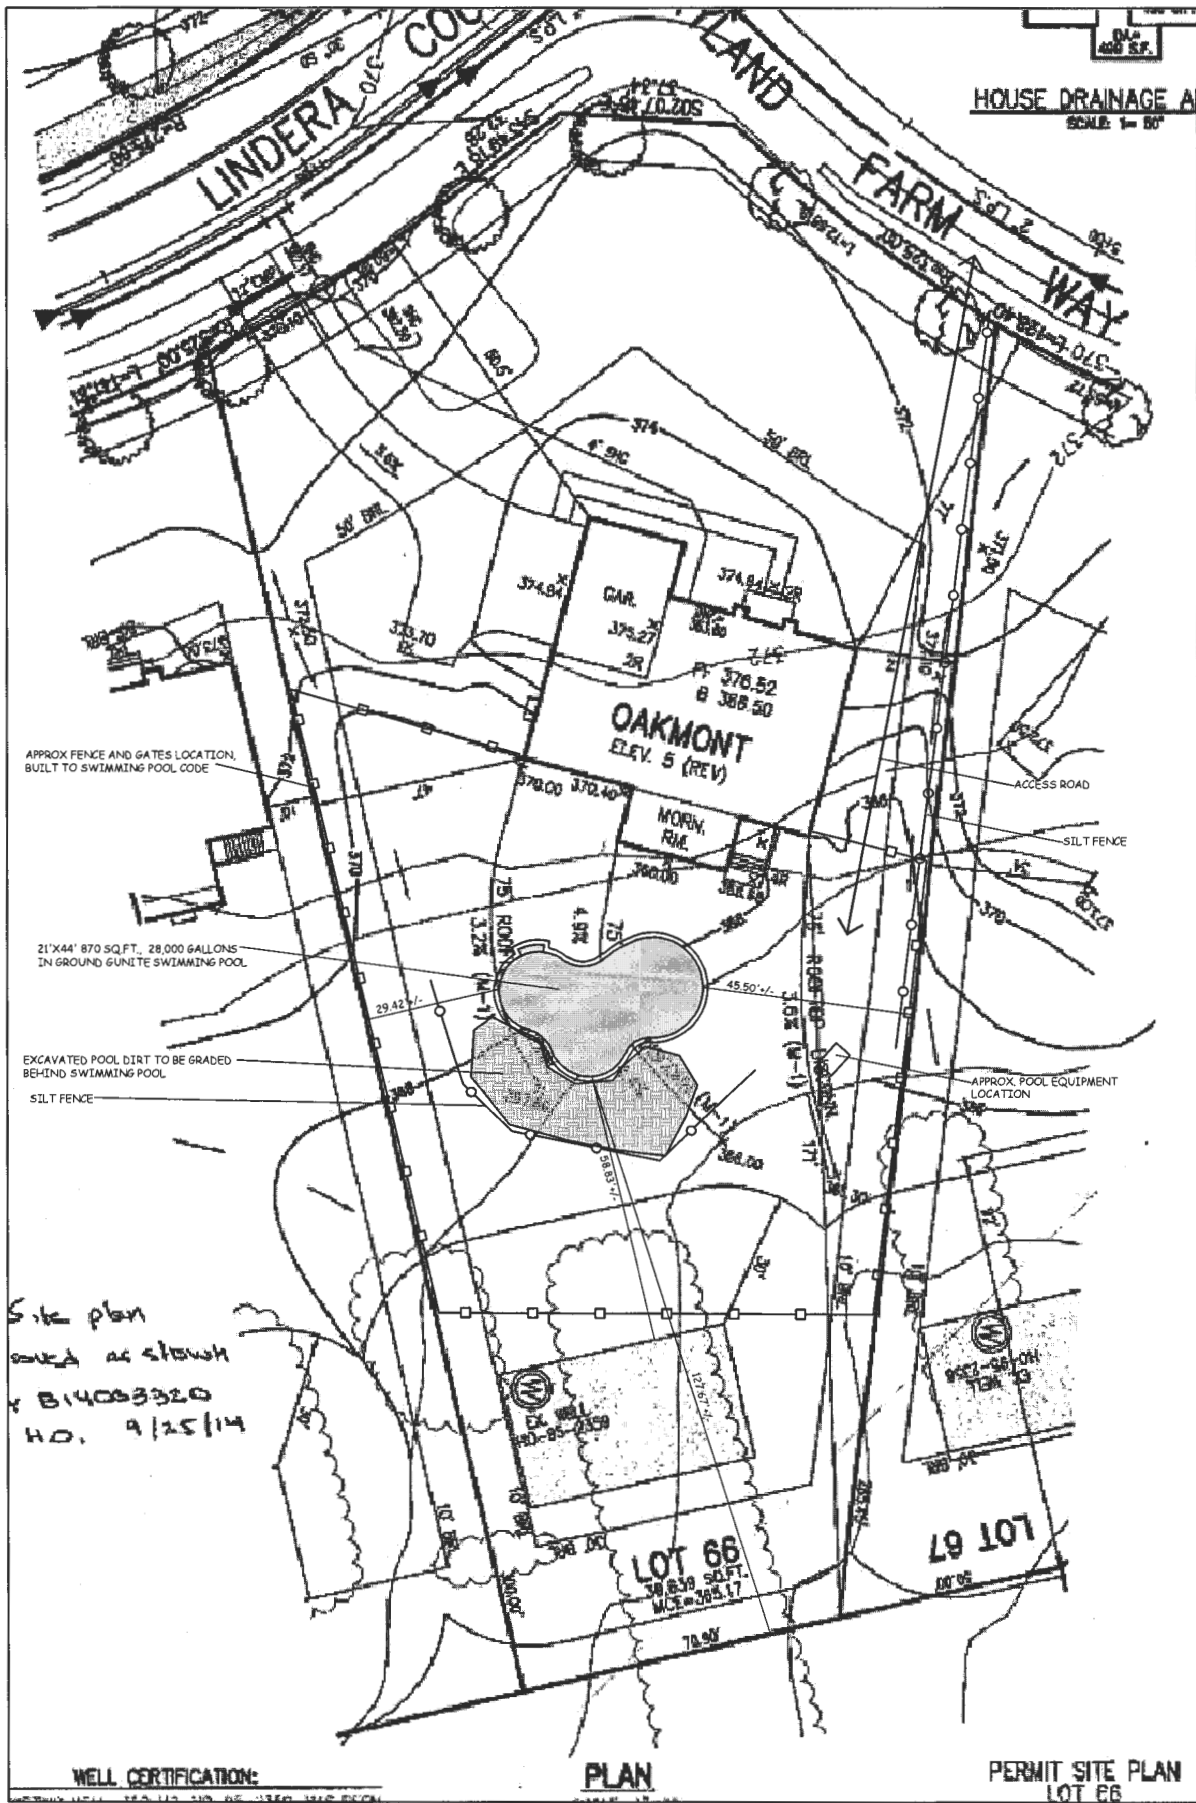

Johnson Pools

1424 Odenton Road, Ste 2B, Odenton, MD 21113
O:410.507.5932 www.jpools.com MHIC # 133219

Use of Documents:
The designs and concepts represented in these drawings and accompanying documents are the sole property of Johnson Pools. No part thereof shall be used, copied, or reproduced without prior written consent of a representative of Johnson Pools. Any infringement will be subject to legal action.

Disclaimer:
This plan is approximate and may be acquired in the field to allow

Miller Residence

PROJECT ADDRESS:

5001 Lindera Court
Ellicott City, MD 21042

TITLE
Site Plan

REVISION DATE:

DRAWING BY:
Zachary S. Casto
SCALE:
1" = 40'-0"
DATE:
12/09/2020