


SCALE: 1" = 500'

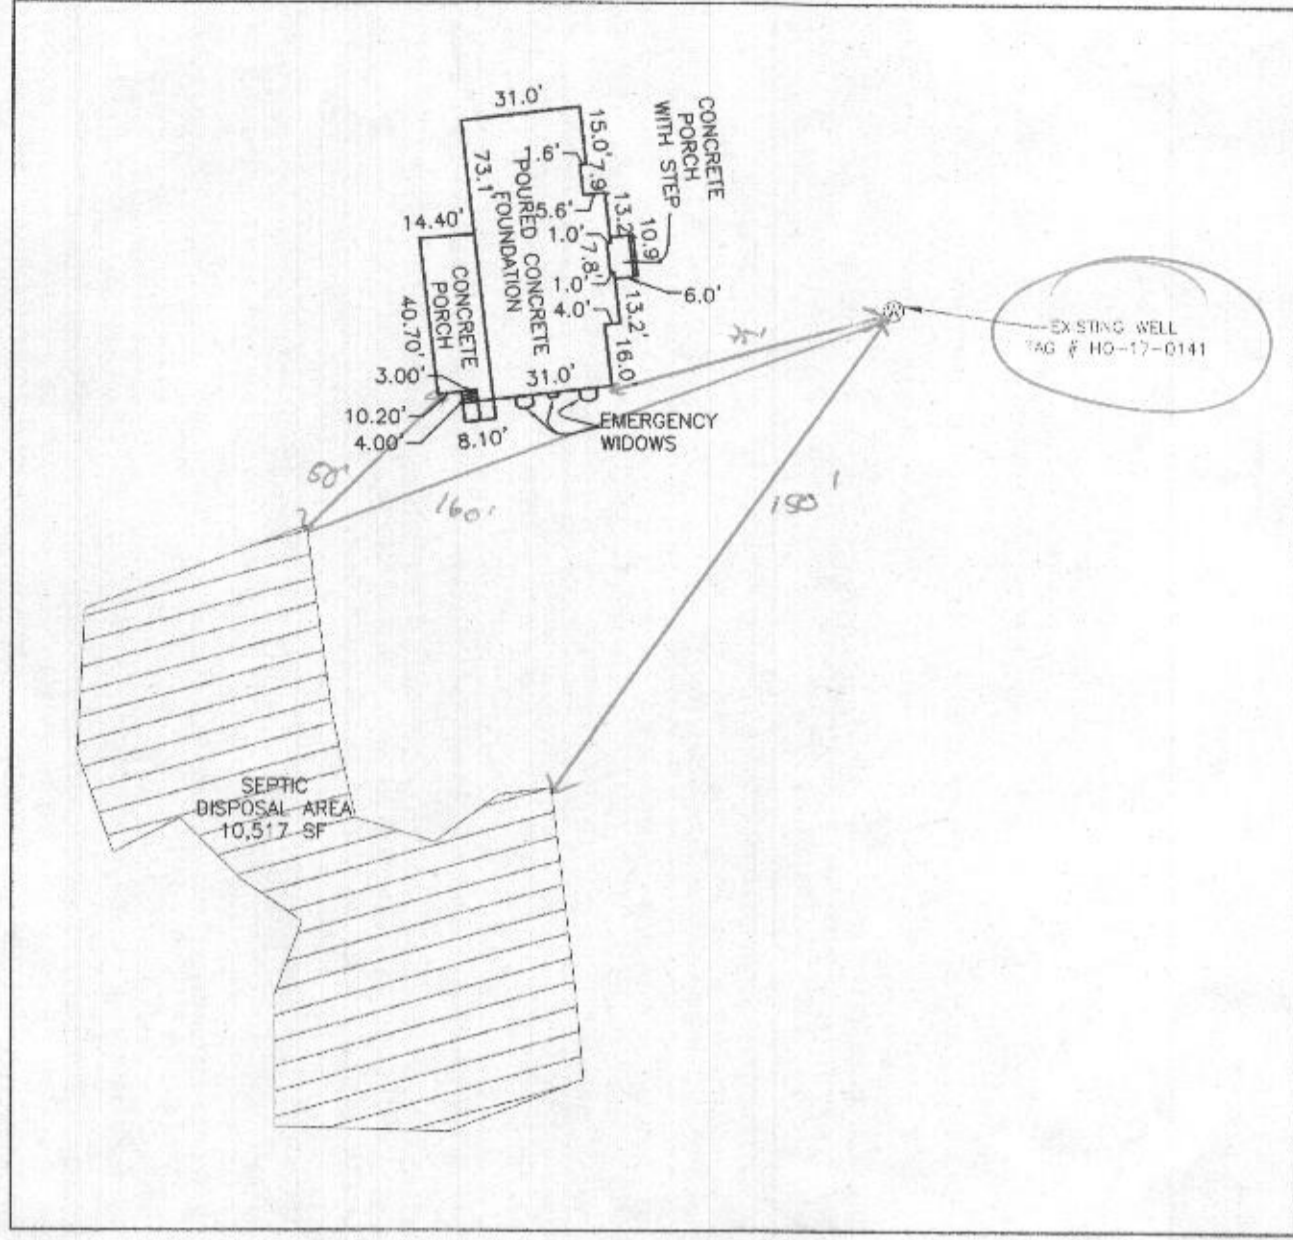

FOUNDATION DETAIL
SCALE: 1" = 50'

FIRST FLOOR ELEVATION = 450.5'
OFFSET DIMENSIONS TO PROPERTY LINES ARE ± 0.1'

NEED TOP OF WALL 02/08/2021

BENCHMARK
ENGINEERS • LAND SURVEYORS • PLANNERS
ENGINEERING, INC.

8480 BALTIMORE NATIONAL PIKE • SUITE 315 • ELLICOTT CITY, MARYLAND 21043
(P) 410-465-6105 (F) 410-465-6644
WWW.BEI-CIVILENGINEERING.COM

SURVEYOR'S CERTIFICATE

I HEREBY CERTIFY THAT THESE DOCUMENTS, WERE PREPARED BY ME OR UNDER MY RESPONSIBLE CHARGE, AND THAT I AM A DULY LICENSED PROFESSIONAL LAND SURVEYOR UNDER THE LAWS OF THE STATE OF MARYLAND, LICENSE NO. 21320, EXPIRATION DATE 1-7-2023 AND TO THE BEST OF MY PROFESSIONAL KNOWLEDGE, INFORMATION AND BELIEF, THAT THE DIMENSIONS OF THE BUILDING WALLS SHOWN HEREON ARE CORRECT; THAT THEY ARE BASED ON A FIELD RUN SURVEY PERFORMED BY BENCHMARK ENGINEERING, INC. ON 01/06/2021.

Donald A. Mason
DONALD A. MASON
PROFESSIONAL LAND SURVEYOR
MARYLAND REG. NO. 21320

FEMA FIRM No. 24027C0070D
ZONE: X
DATED: 11/6/2013

WALL CHECK
CARROLL MILL FARM
PARCEL 'B'

PLAT NO. 12425
TAX MAP: 23, GRID: 10, PARCEL: P/O 130
4044 MANOR LANE

3RD ELECTION DISTRICT
HOWARD COUNTY, MARYLAND
FIELD OBS. BY PJ
COMP. BY DAM
DRAWN BY EWF SCALE: 1" = 500' DATE: 01/06/2021