


- GENERAL PLAN NOTES**
- A. ALL WOOD STUD PARTITIONS NOT DIMENSIONED ARE TO BE 3/4" MIN UNDER OR AND 5/8" TOP FOR EXTERIOR WALLS UNLESS OTHERWISE NOTED.
 - B. ALL INTERIOR DIMENSIONS ARE TO FACE OF STUDS.
 - C. ALL EXTERIOR DIMENSIONS ARE TO FACE OF STUDS.
 - D. ALL DIMENSIONS GIVEN OVER SCALE.
 - E. ALL SMOKE DETECTORS ARE TO BE INSTALLED IN SUCH A MANNER THAT ACTIVATION OF ONE WILL ACTIVATE THEM ALL.
 - F. ENCLOSED ADDITIONAL SPACE UNDER STAIRS SHALL HAVE MAIN STAIRS DOOR PROTECTED BY SMOKE RATED DOOR WITH 20" CRYSTALLINE BOARD.
 - G. ALL WINDOWS ARE TO BE NOTED IN FEET + INCHES AS MEASURED FROM FINISH TO FINISH.
 - H. REFER TO ELEVATIONS FOR WINDOW HEAD HEIGHTS.
 - I. ALL DOORS ARE TO BE 6'-0" HIGH UNLESS OTHERWISE NOTED.
 - J. WASHER ALWAYS TO BE ON LEFT SIDE OF DRYER.
 - K. DRYER AREA ALWAYS TO BE ON RIGHT SIDE OF WASH.

© ELEV. 1 - CRAFTSMAN shown
 See additional pages
 for "Modern Farmhouse"

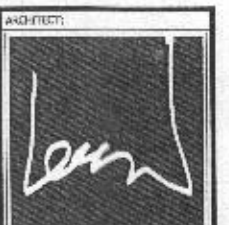

**lessard
DESIGN**

8521 Leesburg Pike
 Suite 700 | Vienna, VA 22182
 P: 571.830.1800 | F: 571.830.1801
 www.lessarddesign.com

SEAL & SIGNATURE:

TOLL BROTHERS
 19775 BELMONT DISCOUNT PLAZA
 ARLINGTON, VA 22247
 P: 571.291.8663
 CONTACT: CHRISTINA LEMLEY
 clemley@tollbrothers.com

MARYLAND
**PARKHURST
FLOOR PLANS**



PROJECT NAME: _____
 SHEET TITLE: _____

ISSUE / REVISION		
NO.	DESCRIPTION	DATE
01	ISSUE	08.28.13
02	REVISED	08.28.13
03	REVISED	08.28.13
04	REVISED	08.28.13
05	REVISED	08.28.13
06	REVISED	08.28.13
07	REVISED	08.28.13
08	REVISED	08.28.13
09	REVISED	08.28.13
10	REVISED	08.28.13

PROJECT NO: _____
 DRAWN BY: _____
 CHECKED BY: _____
 DATE: _____

A-120

- GENERAL PLAN NOTES**
- ALL WOOD STUD PARTITIONS NOT DIMENSIONED ARE TO BE 3 1/2" x 10" FOR INTERIOR AND 4" x 12" FOR EXTERIOR WALLS UNLESS OTHERWISE NOTED.
 - ALL INTERIOR DIMENSIONS ARE TO FACE OF STUDS.
 - ALL EXTERIOR DIMENSIONS ARE TO FACE OF STUDS.
 - ALL DIMENSIONS GOVERN OVER SCALE.
 - ALL DOOR SCHEDULES ARE TO BE W-2000 UNLESS OTHERWISE NOTED OR INDICATED BY OTHER NOTATION OF ONE WILL ACTUALLY BE USED.
 - ENCLOSED ACCESSIBLE SPACE UNDER STAIRS SHALL HAVE WALLS AND DOORSETS PROTECTED ON ENCLOSED SIDE WITH 1/2" THICK SOLID BOARD.
 - ALL WINDOW SIZES ARE NOTED IN FEET - INCHES AS VIEWED FROM SOUTH TO NORTH.
 - REFER TO ELEVATIONS FOR WINDOW HEAD HEIGHTS.
 - ALL DOORS ARE TO BE 6'-0" HIGH UNLESS OTHERWISE NOTED.
 - WASHER ALWAYS TO BE ON LEFT SIDE OF SINK.
 - DRYER ALWAYS TO BE ON RIGHT SIDE OF SINK.

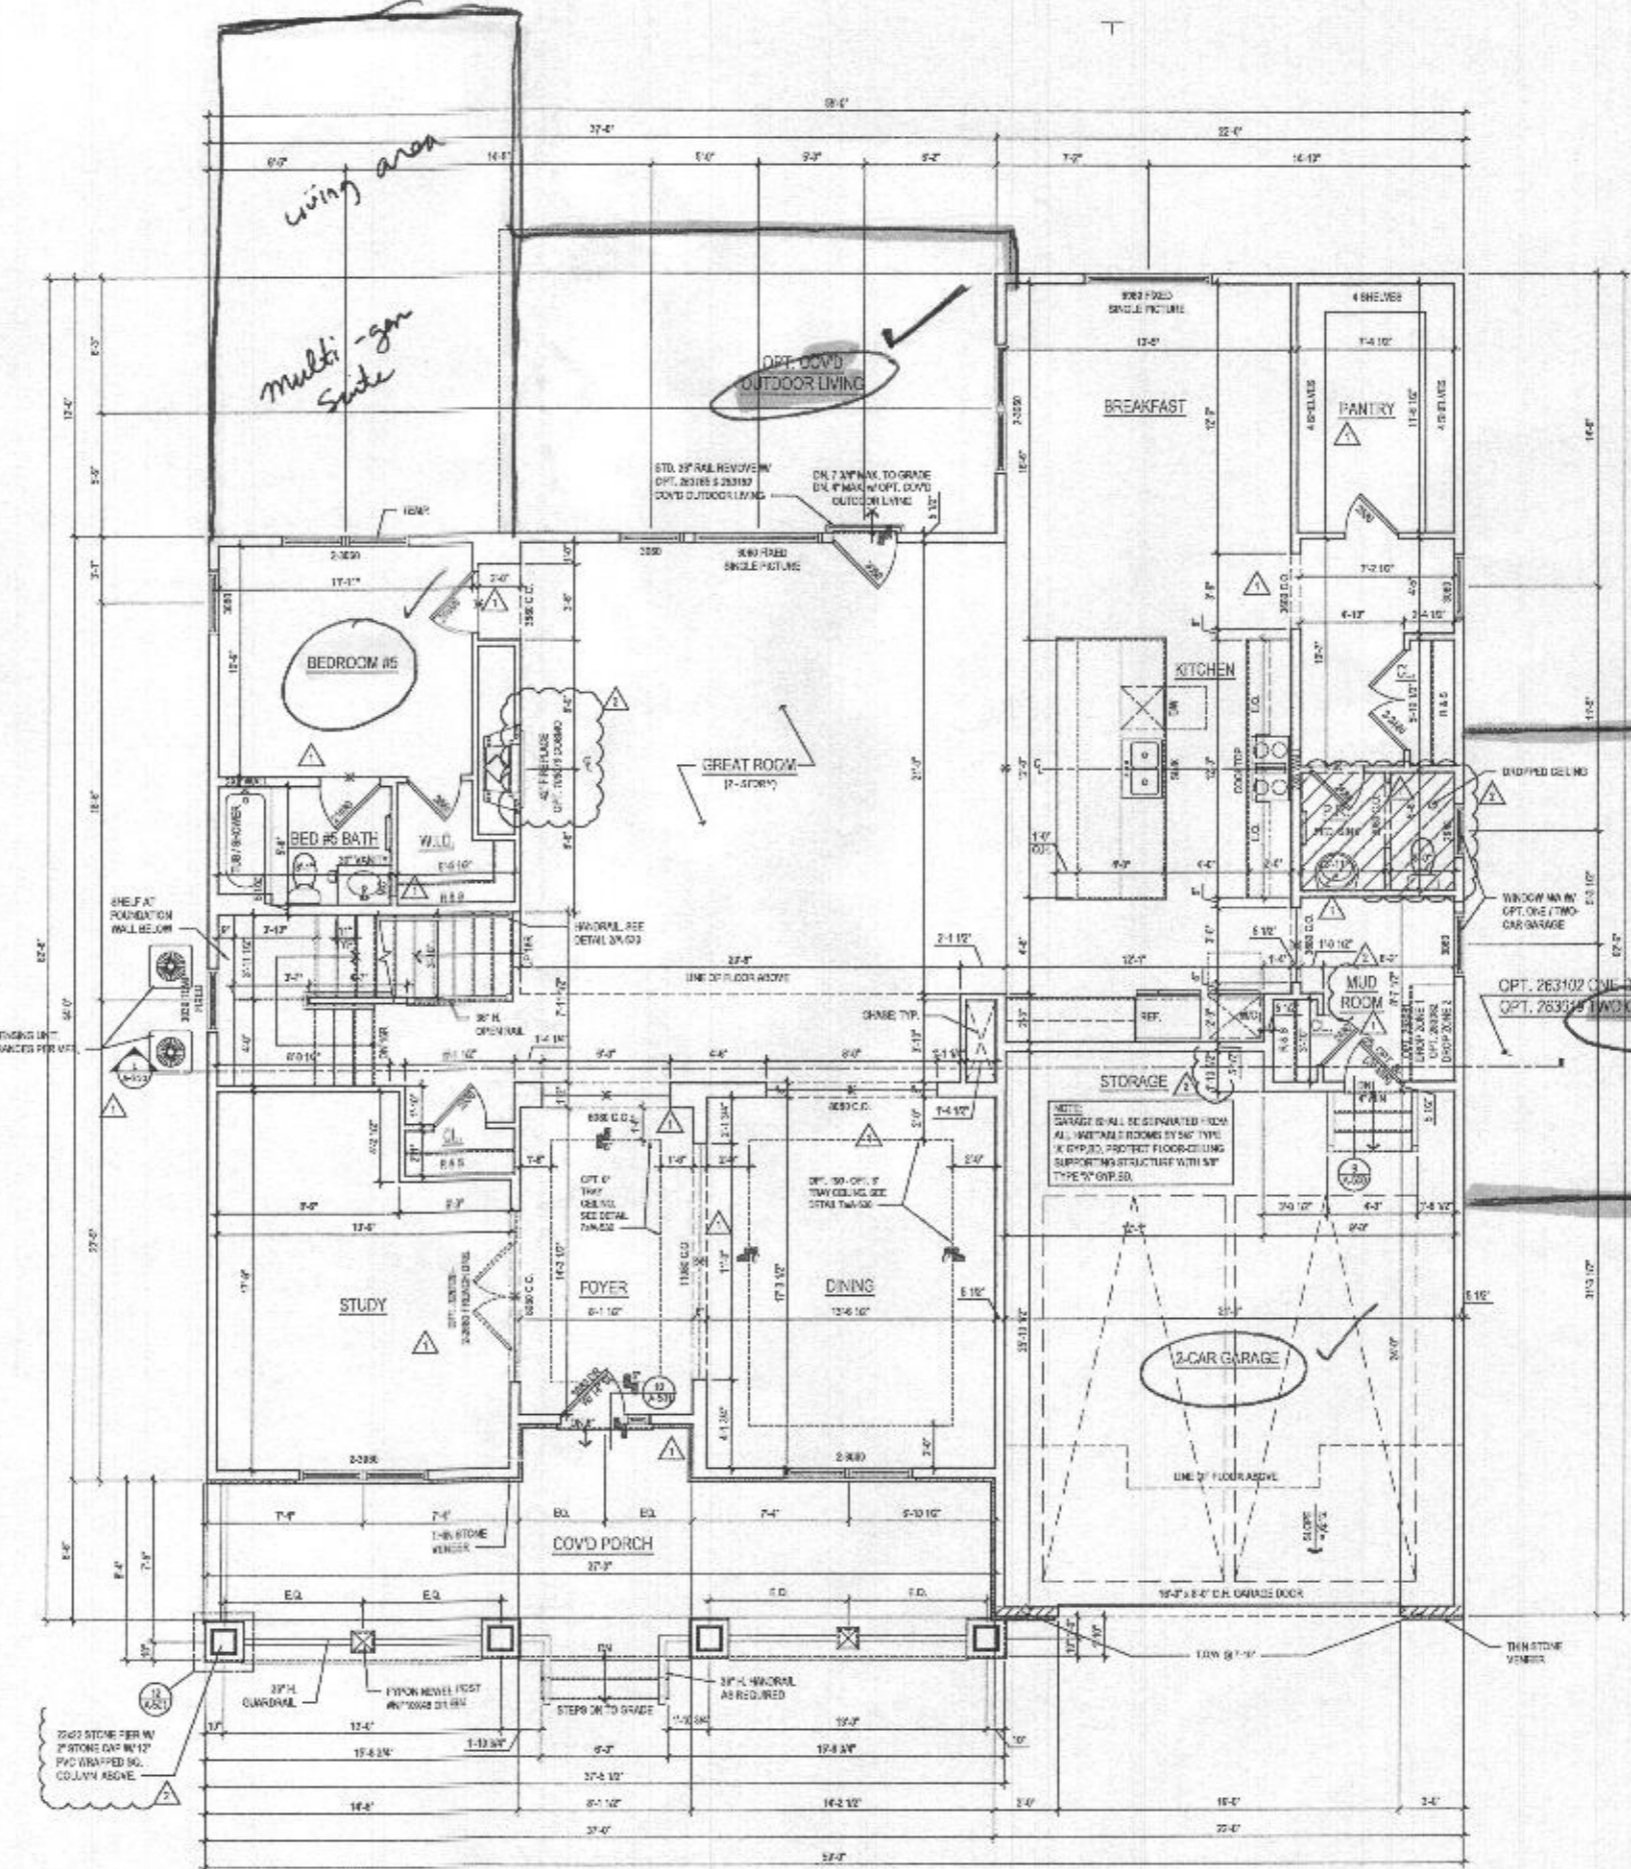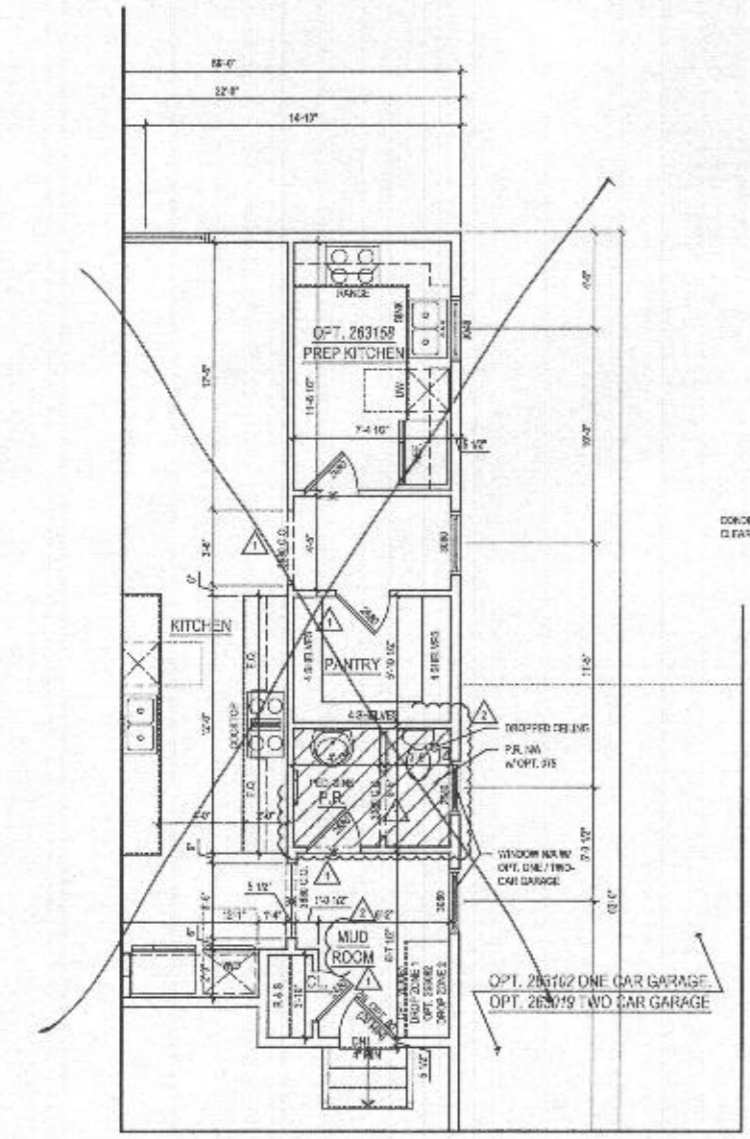

ARCHITECT:

lessard
DESIGN

8521 Leesburg Pike
 Suite 700 | Vienna, VA 22182
 P: 571.830.1803 | F: 571.830.1801
 www.lessarddesign.com

SEAL & SIGNATURE

TOLL BROTHERS
 18775 BELMONT EXECUTIVE PLAZA
 GAITHERSBURG, VA 20147
 P: 571.291.8005
 CONTACT: CHRISTINA LEMLEY
 clemley@tollbrothers.com

MARYLAND
**PARKHURST
 FLOOR PLANS**

PROJECT NAME: _____
 SHEET TITLE: _____

ISSUE / REVISION		
NO.	DESCRIPTION	DATE
1	ISSUED	06.28.23
2	PERMIT SET	06.18.23
3	MD NEW STAIRCASES	06.16.23
4	2nd #333241	12.11.23



PROJECT NO: 104/014
 DRAWN BY: JEM/AV
 CHECKED BY: JEM/AV
 DATE: 10.26.24
 SHEET NO: 10/26/2024

A-110

@ ELEV. 1 - CRAFTSMAN Shown,
 See additional pages for
 "Modern farmhouse"

File No: TOL087M_A110.dwg
 Plot By: anik

- GENERAL PLAN NOTES**
- ALL WOOD STUD PARTITIONS NOT DIMENSIONED ARE TO BE 3 1/2" FOR INTERIOR AND 4" FOR EXTERIOR WALLS UNLESS OTHERWISE NOTED.
 - ALL INTERIOR DIMENSIONS ARE TO FACE OF STUDS.
 - ALL EXTERIOR DIMENSIONS ARE TO FACE OF STUDS.
 - ALL DIMENSIONS GOVERN OVER SCALE.
 - ALL DOOR SCHEDULES ARE TO BE W100 IN 2 1/2" x 6" SCHEDULE UNLESS OTHERWISE NOTED.
 - ENCLOSED ACCESSIBLE SPACE UNDER STAIRS SHALL HAVE WALLS AND DOORETS PROTECTED ON ENCLOSED SIDE WITH 1/2" THICK BOARD.
 - ALL WINDOW SIZES ARE NOTED IN FEET - INCHES AS VIEWED FROM SOUTH TO NORTH.
 - REFER TO ELEVATIONS FOR WINDOW HEAD HEIGHTS.
 - ALL DOORS ARE TO BE 6'-0" HIGH UNLESS OTHERWISE NOTED.
 - WASHER ALWAYS TO BE ON LEFT SIDE OF SINK.
 - DRYER ALWAYS TO BE ON RIGHT SIDE OF SINK.

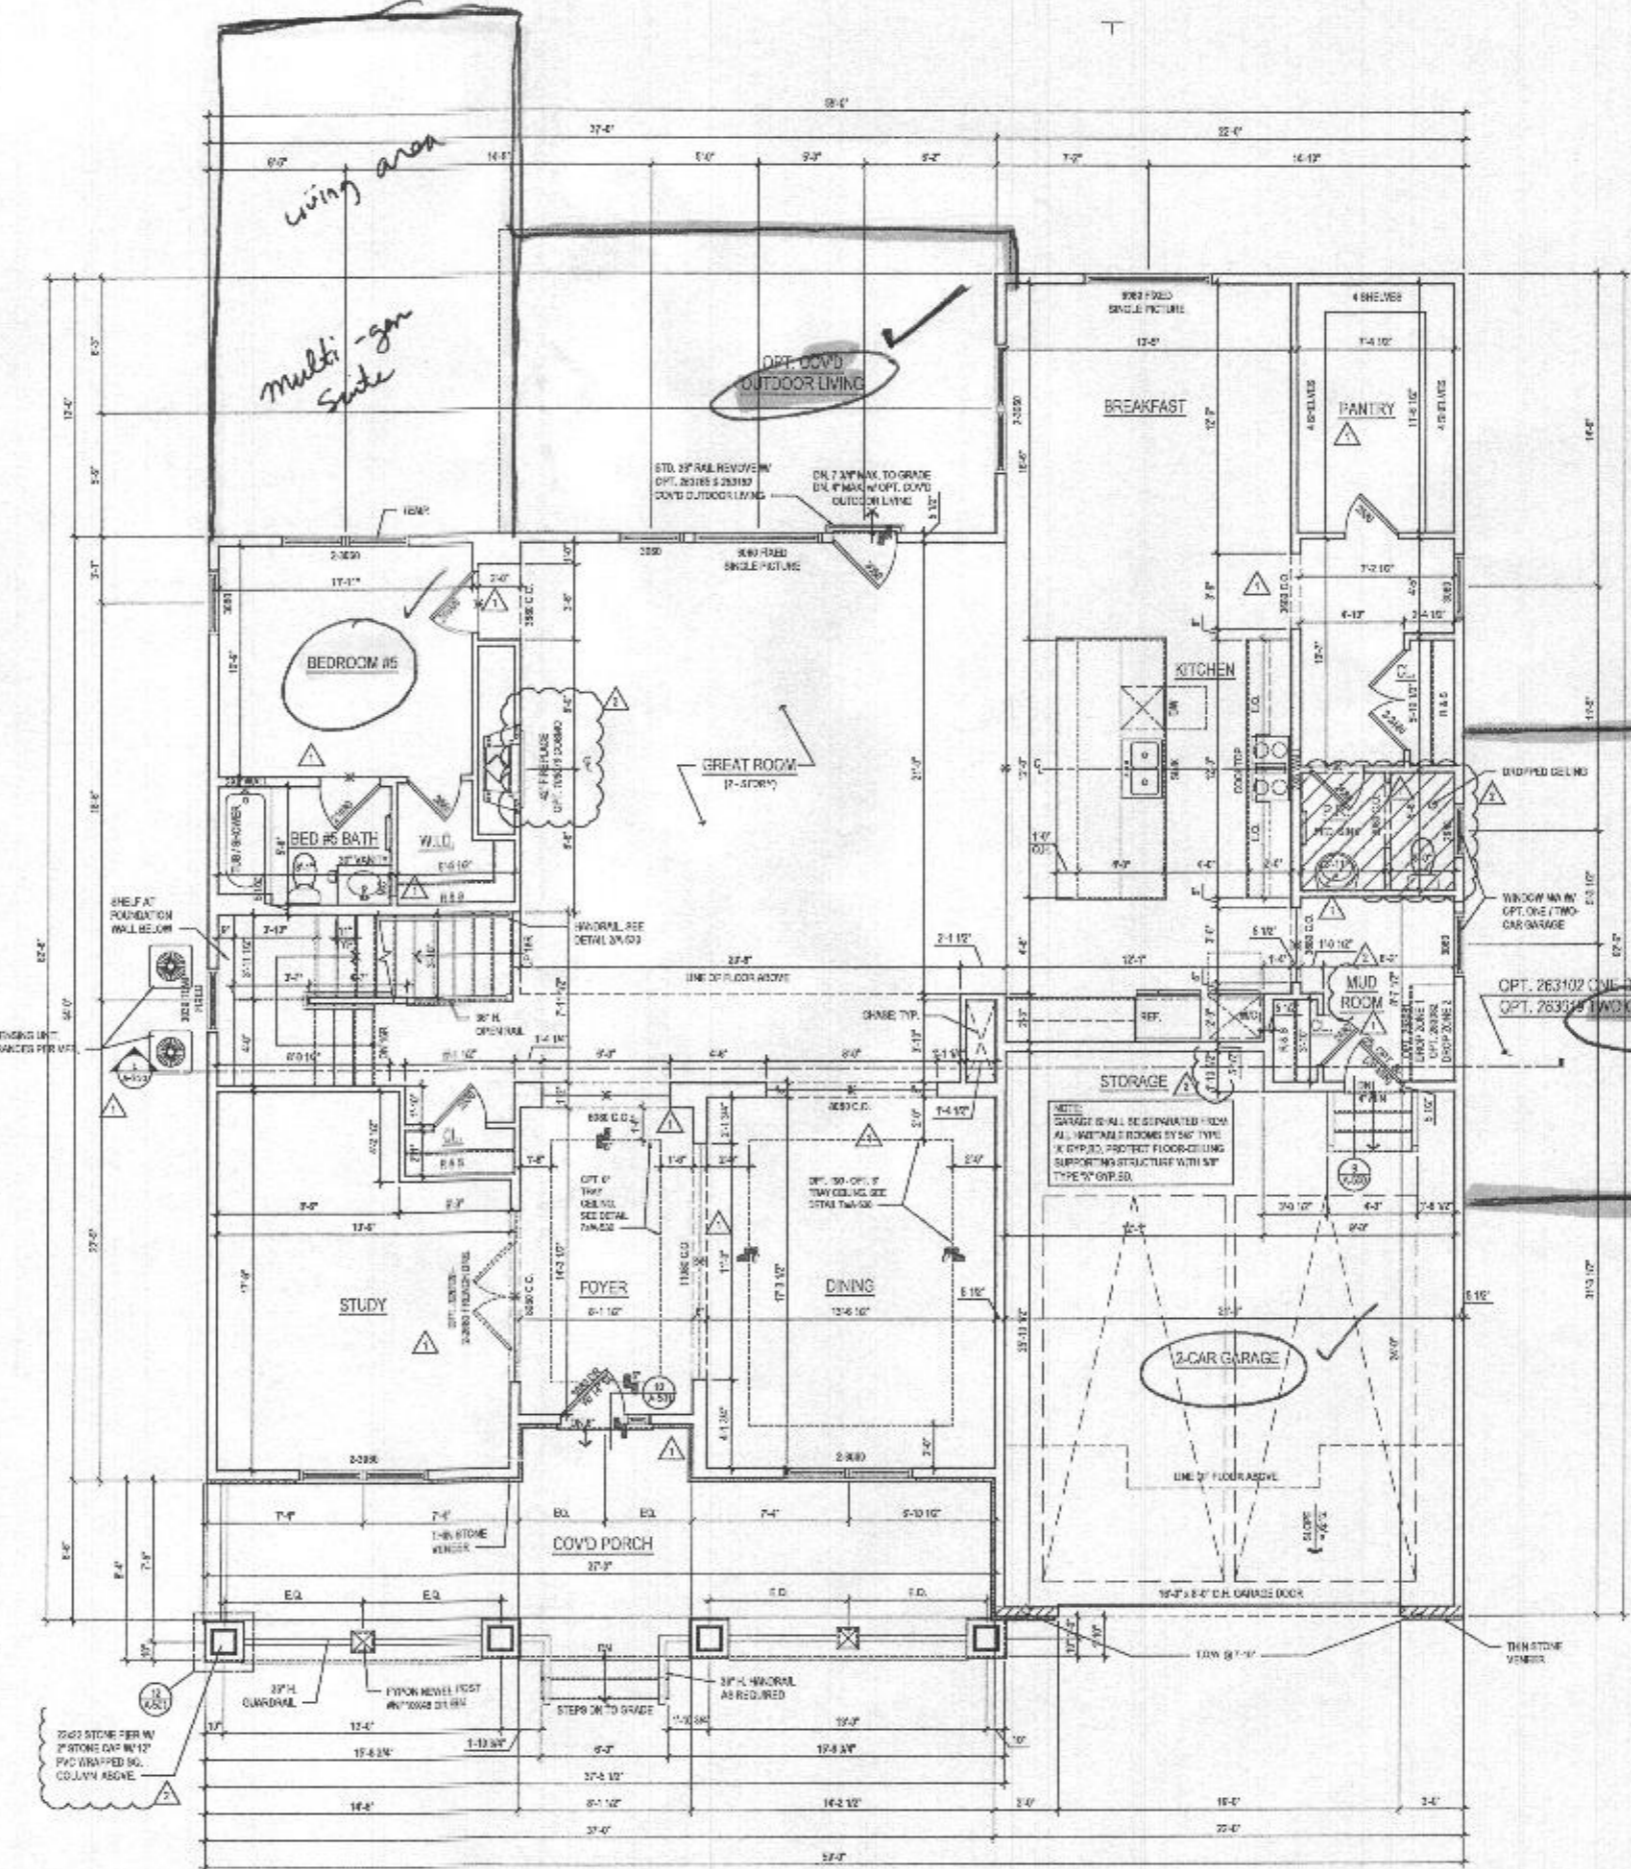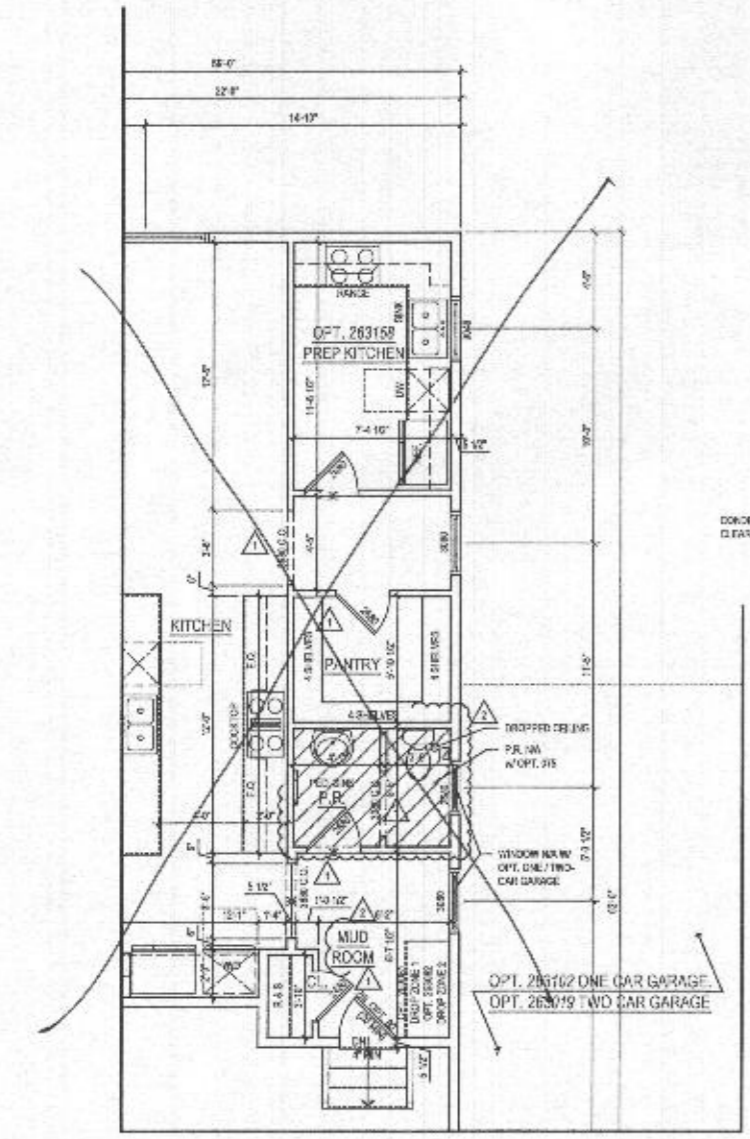

ARCHITECT:

lessard
DESIGN

8521 Leesburg Pike
 Suite 700 | Vienna, VA 22182
 P: 571.830.1800 | F: 571.830.1801
 www.lessarddesign.com

SEAL & SIGNATURE

TOLL BROTHERS
 18075 BELMONT EXECUTIVE PLAZA
 GAITHERSBURG, VA 20147
 P: 571.291.8005
 CONTACT: CHRISTINA LEMLEY
 clemley@tollbrothers.com

MARYLAND
**PARKHURST
 FLOOR PLANS**


ISSUE / REVISION		
NO.	DESCRIPTION	DATE
1	PERMIT SET	06.18.23
2	PERMITS STAMPADES	06.16.23
3	REV #232241	12.11.23

PROJECT NO: 104/014
 DRAWN BY: JEM/AV
 CHECKED BY: JEM/AV
 DATE: 10.26.24
 FILE NAME: 10_26_24_A110.dwg

A-110


@ ELEV. 1 - CRAFTSMAN Shown,
 See additional pages for
 "Modern farmhouse"

- GENERAL PLAN NOTES**
- A. ALL WOOD STUD PARTITIONS NOT DIMENSIONED ARE TO BE 2" FOR INTERIOR AND 1" FOR EXTERIOR WALLS UNLESS OTHERWISE NOTED.
 - B. ALL INTERIOR DIMENSIONS ARE TO FACE OF STUDS.
 - C. ALL EXTERIOR DIMENSIONS ARE TO FACE OF STUDS.
 - D. ALL DIMENSIONS COVER OVER SCALE.
 - E. ALL SMOKE DETECTORS ARE TO BE WIRED IN SUCH-A-MANNER THAT ACTIVATION OF ONE WILL ACTIVATE THEM ALL.
 - F. ENCLOSURE ACCESSIBLE SINCE UNDER STAIRS SHALL HAVE WALLS AND SLOTTED PROTECTED ON ENCLOSED SIDE WITH 1/2" CORRUGUM BOARD.
 - G. ALL WINDOWS LEFT ARE NOTED IN FOOTING AS MEASURED FROM SASH TO SASH.
 - H. REFER TO ELEVATIONS FOR WINDOW HEAD HEIGHTS.
 - I. ALL DOORS ARE TO BE 8'-0" HIGH UNLESS OTHERWISE NOTED.
 - J. WASHER ALWAYS TO BE ON LEFT SIDE OF DOOR.
 - K. NO WASHER ALWAYS TO BE ON RIGHT SIDE OF DOOR.

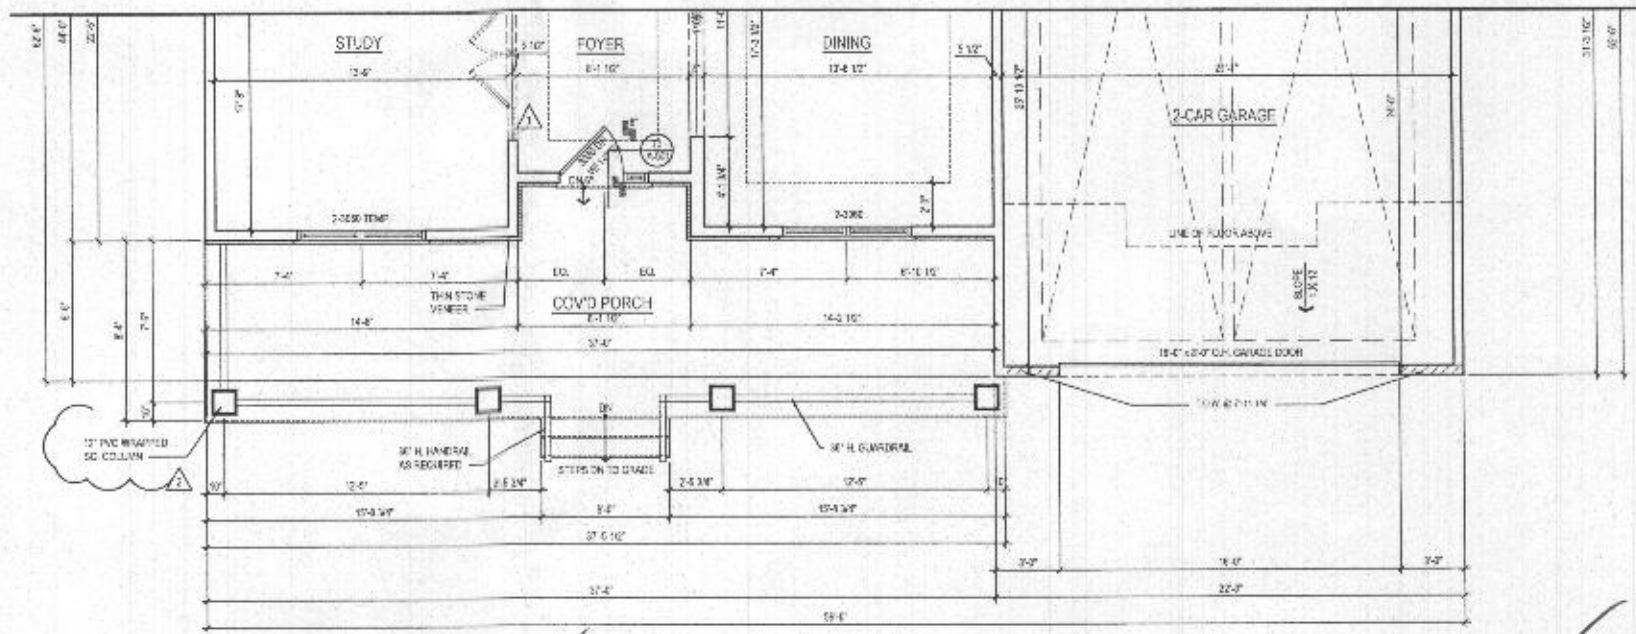

2 FIRST FLOOR PLAN
 A-140 SCALE: 1/8"=1'-0"
 12/28/2018

@ ELEV. 2 MODERN FARMHOUSE

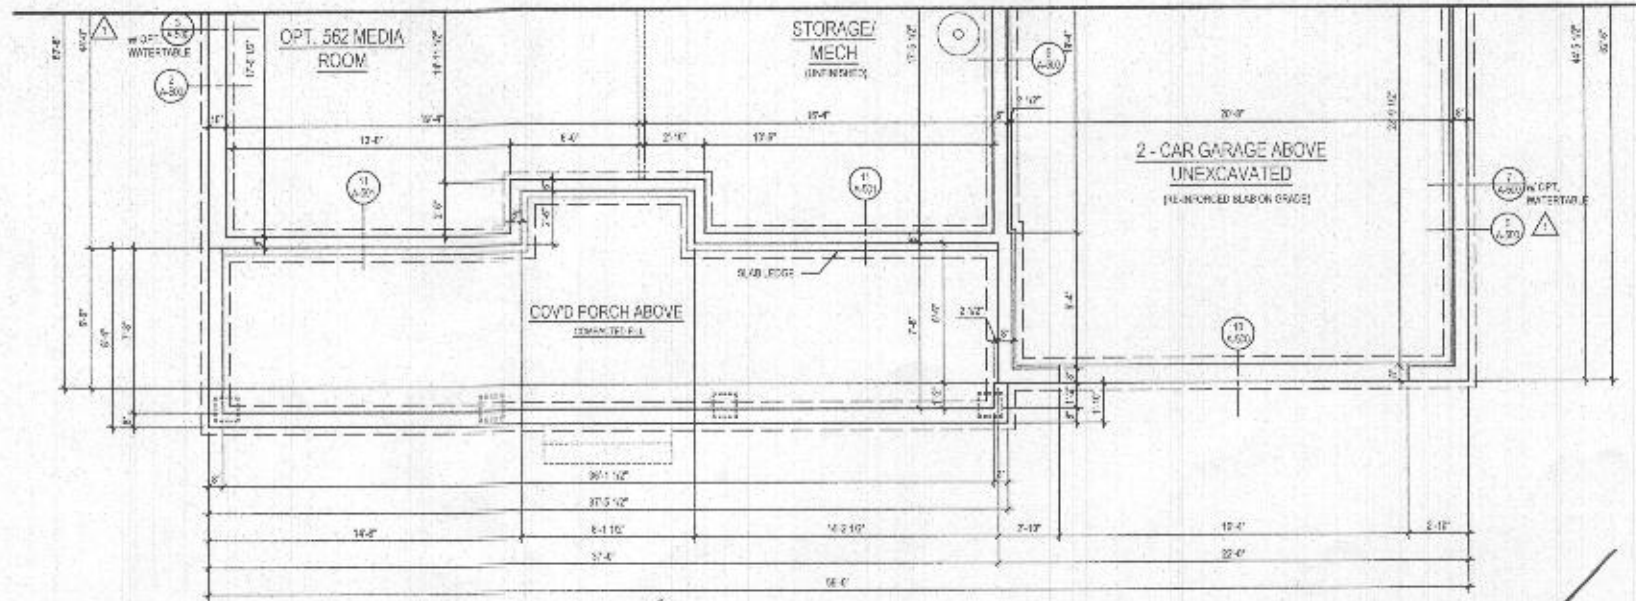

1 BASEMENT FLOOR PLAN
 A-140 SCALE: 1/8"=1'-0"
 12/28/2018

@ ELEV. 2 MODERN FARMHOUSE

ARC ETC.

8523 Leesburg Pike
 Suite 200 | Vienna, VA 22182
 P: 571.830.1800 | F: 571.830.1801
 www.lessardesign.com

OWNER:

TOLL BROTHERS
 18775 BELMONT EXECUTIVE PLAZA
 ARLINGTON, VA 22204
 P: 571.291.0028
 CONTACT: CHRISTINE LEWLEY
 clewley@tollbrothers.com

PROJECT NAME: MARYLAND PARKHURST FLOOR PLANS

SHEET TITLE:


NO.	DESCRIPTION	DATE
1	REVISED	12/28/18
2	REVISED	12/28/18

PROJECT NO: 18-001
 DRAWN BY: JLD
 CHECKED BY: JLD
 PLOT DATE: 12/28/18
 PLOT NAME: 18-001-01

A-140


File No: TOLBRLS_A140.dwg
 Plot By: mmk

- GENERAL PLAN NOTES**
- ALL WOOD STUD PARTITIONS NOT DIMENSIONED ARE TO BE 2" FOR INTERIOR AND 1" FOR EXTERIOR WALLS UNLESS OTHERWISE NOTED.
 - ALL INTERIOR DIMENSIONS ARE TO FACE OF STUDS.
 - ALL EXTERIOR DIMENSIONS ARE TO FACE OF STUDS.
 - ALL DIMENSIONS GIVEN ON SCALE.
 - ALL SMOKE DETECTORS ARE TO BE WIRED IN SUCH-A-MANNER THAT ACTIVATION OF ONE WILL ACTIVATE THEM ALL.
 - ENCLOSURE ACCESSIBLE SINCE UNDER STAIRS SHALL HAVE WALLS AND DOORS PROTECTED ON ENCLOSED SIDE WITH 1/2" Gypsum BOARD.
 - ALL WINDOWS LEFT ARE NOTED IN FOOTING AS MEASURED FROM SASH TO SASH.
 - REFER TO ELEVATIONS FOR WINDOW HEAD HEIGHTS.
 - ALL DOORS ARE TO BE 8'-0" HIGH UNLESS OTHERWISE NOTED.
 - WASHER ALWAYS TO BE ON LEFT SIDE OF DRIVER.
 - NO WASHER ALWAYS TO BE ON RIGHT SIDE OF SEW.

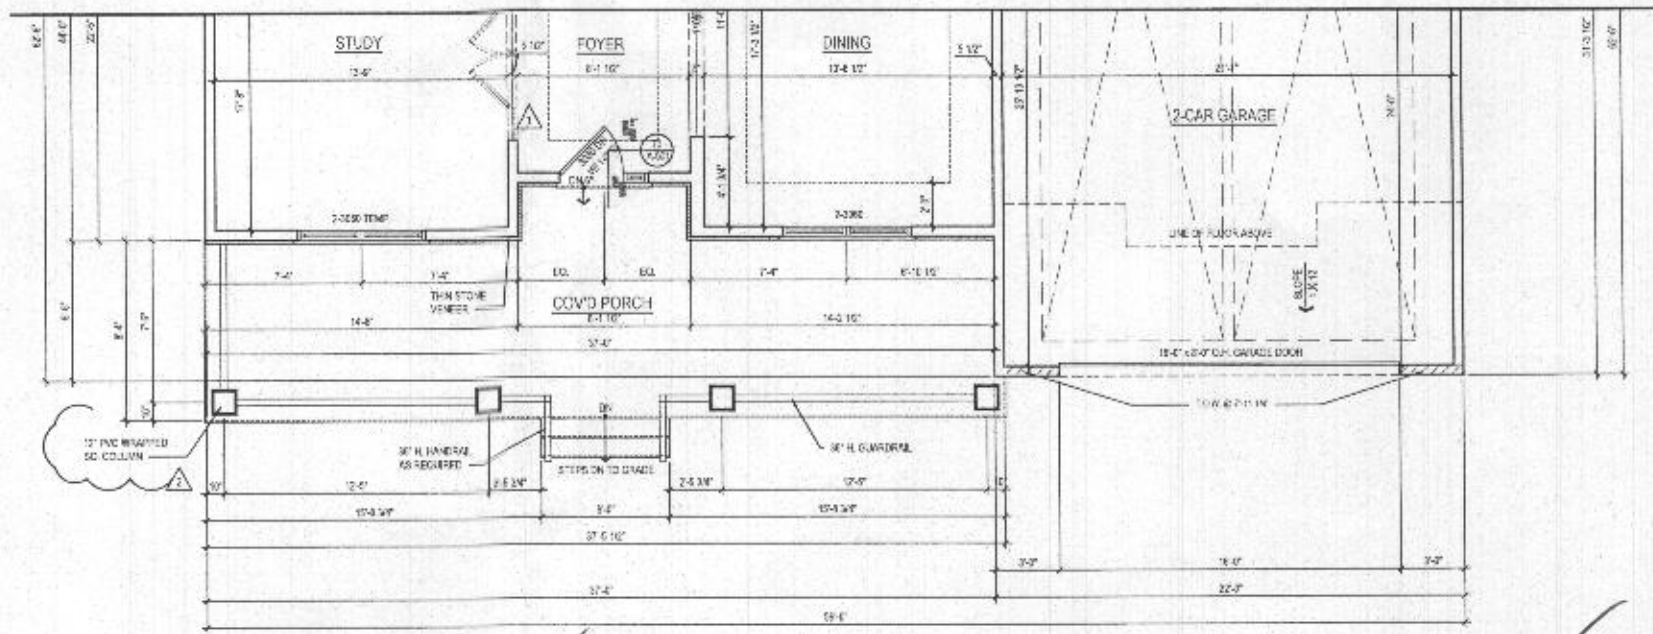

2 FIRST FLOOR PLAN
 A-140 SCALE: 1/4" = 1'-0"
 TOLL BROTHERS

@ ELEV. 2 MODERN FARMHOUSE

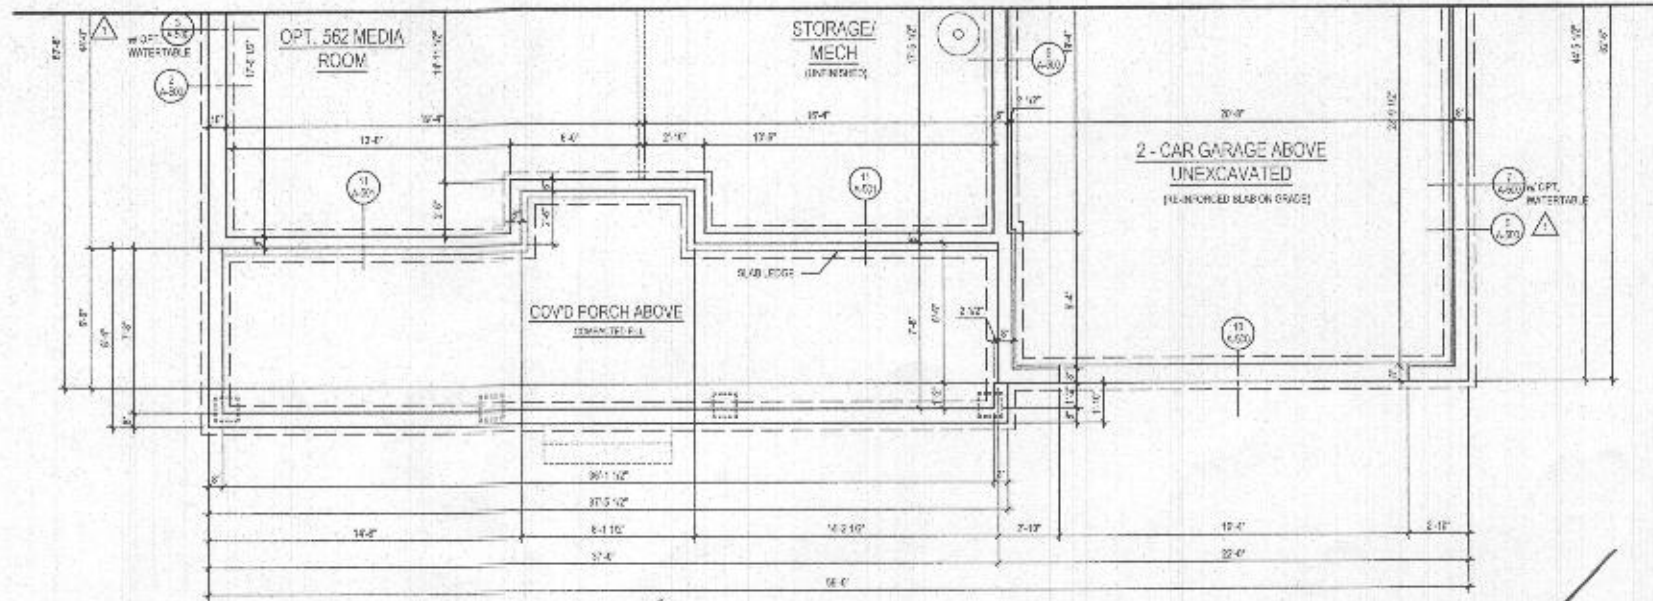

1 BASEMENT FLOOR PLAN
 A-140 SCALE: 1/4" = 1'-0"
 TOLL BROTHERS

@ ELEV. 2 MODERN FARMHOUSE

ARC (ETC.)

8523 Leesburg Pike
 Suite 200 | Vienna, VA 22182
 P: 571.830.1800 | F: 571.830.1801
 www.lessardesign.com

OWNER:

TOLL BROTHERS
 18775 BELMONT EXECUTIVE PLAZA
 ARLINGTON, VA 22204
 P: 571.291.0028
 CONTACT: CHRISTINE LEWLEY
 clewley@tollbrothers.com

PROJECT NAME: MARYLAND PARKHURST FLOOR PLANS


SHEET TITLE:

ISSUE / REVISION		
NO.	DESCRIPTION	DATE
1	ISSUED	12.20.15
2	PERMIT SET	06.16.15
3	2015 NEW STATUTE	06.16.15
4	2015 #2800-1	12.11.15

PROJECT NO: 150404
 DRAWN BY: JH
 CHECKED BY: JH
 PLOT DATE: 12.11.15
 PLOT NAME: 150404-15E-200

A-140

- GENERAL PLAN NOTES**
- A. ALL WOOD STUD PARTITIONS NOT DIMENSIONED ARE TO BE 2 1/2" FOR INTERIOR AND 5 1/2" FOR EXTERIOR WALLS UNLESS OTHERWISE NOTED.
 - B. ALL INTERIOR DIMENSIONS ARE TO FACE OF STUDS.
 - C. ALL EXTERIOR DIMENSIONS ARE TO FACE OF STUDS.
 - D. ALL DIMENSIONS GOVERN OVER SCALE.
 - E. ALL SMOKE DETECTORS ARE TO BE WITHIN 5' OF EXITS THAT ACTIVATION OF ONE WILL ACTIVATE THEM ALL.
 - F. ENCLOSED ACCESSIBLE SPACE UNDER STAIRS SHALL HAVE WALLS AND BOARDS PROTECTED ON ENCLOSED SIDE WITH 1/2" OFF-SHORE BOARD.
 - G. ALL WINDOWS SIZE ARE NOTED IN FEET + INCHES AS VIEWED FROM INSIDE TO OUTSIDE.
 - H. REFER TO ELEVATIONS FOR WINDOW HEAD HEIGHTS.
 - I. ALL DOORS ARE TO BE 6'8" HIGH UNLESS OTHERWISE NOTED.
 - J. WASHERS ALWAYS TO BE ON LEFT SIDE OF DRIVER.
 - K. DRYWASHER ALWAYS TO BE ON RIGHT SIDE OF SINK.

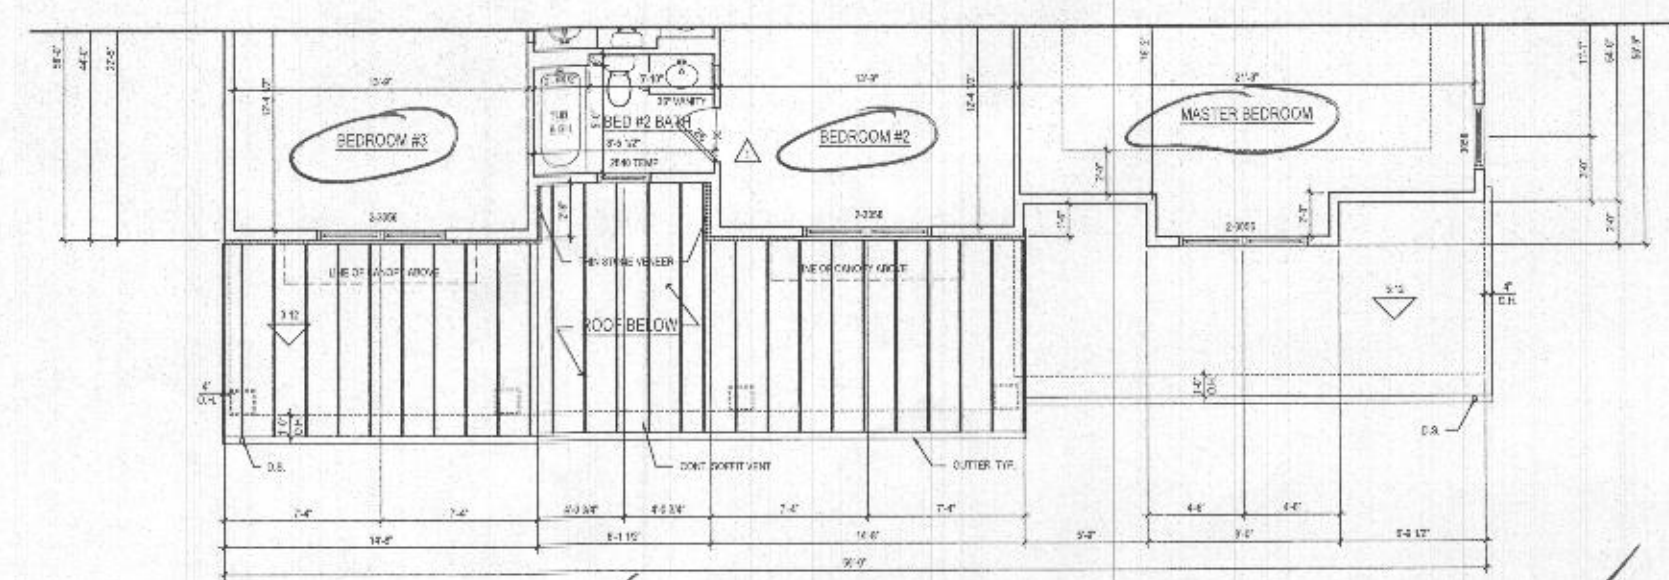

1 SECOND FLOOR PLAN
 A-141 SCALE: 1/4"=1'-0"
1/8"=1'-0"

@ ELEV. 2 - MODERN FARMHOUSE

lessard DESIGN
 8521 Leesburg Pike
 Suite 700 | Vienna, VA 22182
 P: 571.830.1800 | F: 571.830.1801
 www.lessarddesign.com

OWNER:
TOLL BROTHERS
 1975 BELMONT EXECUTIVE PLAZA
 ARLINGTON, VA 22202
 P: 571.201.2000
 CONTACT: CRISTINA LEMLEY
 clemley@tollbrothers.com

PROJECT NAME: MARYLAND
 SHEET TITLE: PARKHURST FLOOR PLANS

ISSUE / REVISION		
NO.	DESCRIPTION	DATE
1	ISSUE SET	12.26.19
2	FOR STAKEHOLDER REVIEW	12.16.19
3	FOR CONSTRUCTION	12.11.19

PROJECT NO: 191001
 DRAWN BY: ADP
 CHECKED BY: JF
 PLOT DATE: 12.26.19
 FILE NAME: 191001_A-141.dwg

A-141

Plot By: male
 File No: 191001.dwg, A-141.dwg