

RECEIVED

PERMIT NUMBER B20004569

DATE ACCEPTED:

DEC 28 2020



RESIDENTIAL BUILDING PERMIT APPLICATION

PERMITS DIVISION

HOWARD COUNTY DEPARTMENT OF INSPECTIONS, LICENSES, AND PERMITS

3430 COURT HOUSE DRIVE, ELLICOTT CITY, MD 21043 - PHONE: (410) 313-2455 OPTION #4 www.howardcountymd.gov

BUILDING SITE ADDRESS REQUIRED

Street Address: 15621 Linden Grove La, City: Woodbine, State: MD, Zip Code: 21797, Subdivision/Village/Complex Name: Linden Grove, SDP/WP/BA #: , Lot: 5, Tax Map: , Parcel: , Grading Permit #:

DESCRIPTION OF WORK REQUIRED

Existing Use: vacant lot, Proposed Use: SFD, Estimated Cost: \$ 300,000, Trade Work to Be Completed: Mechanical (HVACR), Electrical, Plumbing, None, New 2 story "Dumont" Fairview elev, 2 car garage, 1 car side attached garage, walkout luxury covered deck, and finished lower level (living room, bathroom, kitchen, etc.) finished which is about 4 weeks duration

PROPERTY OWNER INFORMATION REQUIRED

Owner(s) Name(s): Tall Mid Atlantic LP Co. Inc., Primary Residence: No, Owner's Street Address: 250 Gibraltar Rd, City: Hershams, State: PA, Zip Code: 17044, Phone: 410-872-9105, Email: sriley1@tallbrothers.com

APPLICANT NAME REQUIRED - INDIVIDUAL WHO SIGNS THIS APPLICATION

Business Name: DeRater Building Services, Contact Name: Jim Kerwin, Street Address: PO Box 552, City: Woodbine, State: MD, Zip Code: 21797, Phone: 443-209-7792, Email: jim@deraterbuilding.com

CONTRACTOR INFORMATION REQUIRED

Business Name: Tall Mid Atlantic LP Co Inc., License #: 8220, Street Address: 7164 Columbia Gateway Dr, Ste 230, City: Columbia, State: MD, Zip Code: 21046, Phone: 240-451-5950, Email: sriley1@tallbrothers.com

ARCHITECT/ENGINEER INFORMATION INDIVIDUAL WHO SIGNED PLANS, IF APPLICABLE

Business Name: , Name: , Street Address: , City: , State: , Zip Code: , Phone: , Email:

BUILDING CHARACTERISTICS REQUIRED

Primary Structure: SF Dwelling, Condo: No, Utilities: Electric, Gas, Water Supply: Private (Well), Sewage Disposal: Private (Septic), Heating System: Electric, Roadside Tree Project: No, Sprinkler System: NFPA 13, Fire Alarm System: No, Voice Evac

ADDITIONAL RESIDENTIAL INFORMATION (PLEASE SELECT/COMPLETE ALL THAT APPLY)

Model Name & Options: Annual Fairview elev, 2 car garage, 1 car garage, luxury deck, walkout/lwr, finished lower level, # of Bedrooms (SF): 5, # of efficiency units (MF*): , # of 1 BR (MF*): , # of 2 BR (MF*): , # of 3 BR (MF*): , # Rooms: 10 11, # Full Baths: 5, # Half Baths: 1, # Fireplaces: 1 w/ 1st floor, Garage/Carport Info: Attached Garage, Basement/Foundation Info: Finished Basement: Full, 1st Fl Width: 72, 1st Fl Depth: 68, 2nd Fl Width: 58, 2nd Fl Depth: 45, Bsmt Width: 58, Bsmt Depth: 52, Energy Method: Performance, Gross Area: 7213 sq ft, Occupiable Area: 6765 sq ft

AGREEMENT/ DISCALIMER REQUIRED

THE UNDERSIGNED HEREBY CERTIFIES AND AGREES AS FOLLOWS: (1) THAT HE/SHE IS AUTHORIZED TO MAKE THIS APPLICATION; (2) THAT THE INFORMATION IS CORRECT; (3) THAT HE/SHE WILL COMPLY WITH ALL REGULATIONS OF HOWARD COUNTY WHICH ARE APPLICABLE THERETO; (4) THAT HE/SHE WILL PERFORM NO WORK ON THE ABOVE REFERENCED PROPERTY NOT SPECIFICALLY DESCRIBED IN THIS APPLICATION; (5) THAT HE/SHE GRANTS COUNTY OFFICIALS THE RIGHT TO ENTER ONTO THIS PROPERTY FOR THE PURPOSE OF INSPECTING THE WORK PERMITTED AND POSTING NOTICES.

APPLICANT'S ORIGINAL SIGNATURE: [Signature], DATE SIGNED: 12/24/2020

FOR OFFICE USE ONLY


CHECKS PAYABLE TO: DIRECTOR OF FINANCE OF HOWARD COUNTY

AGENCIES REQUIRED/APPROVALS: PR, DPZ, DED, Health, SHA, CID, SUBMITTAL FEES: \$150.00, PAYMENT: CFT 01525917, ACCEPTED BY: [Signature]

LEGEND:


- BRL BUILDING RESTRICTION LINE
- (W) WELL LOCATION
- T.W. TOP OF WALL
- G.F. GARAGE FLOOR
- B.F. BASEMENT FLOOR
- PASSED PERC LOCATION
- FAILED PERC LOCATION
- SILT FENCE
- SUPER SILT FENCE
- SCE STONE CONSTRUCTION ENTRANCE
- ▨ SEPTIC RESERVE AREA
- ▩ WELL BOX AREA
- PROPOSED TREE
- PROPOSED TREE
- PROPOSED TREE

NOTE:
TOTAL LIMITS OF DISTURBANCE (LOD) = 32,280 SQ. FT.

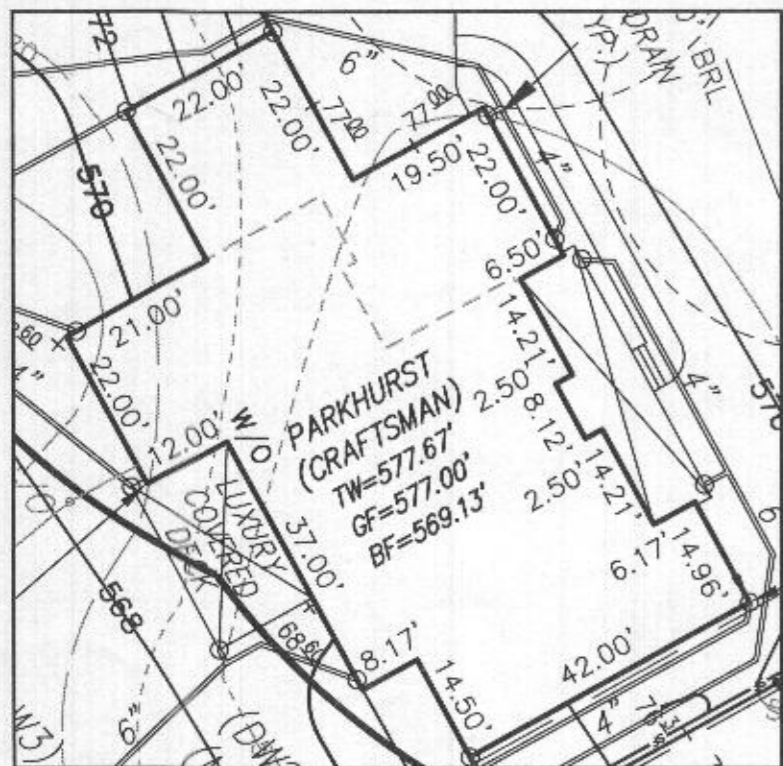

HOUSE ENLARGEMENT
NOT TO SCALE

BUILDING SETBACKS (B.R.L.'s) SHOWN HEREON PER SITE DEVELOPMENT PLAN
SETBACK DISTANCES SHOWN HEREON AS "±" HAVE AN ACCURACY OF ±0.1' FOOT.

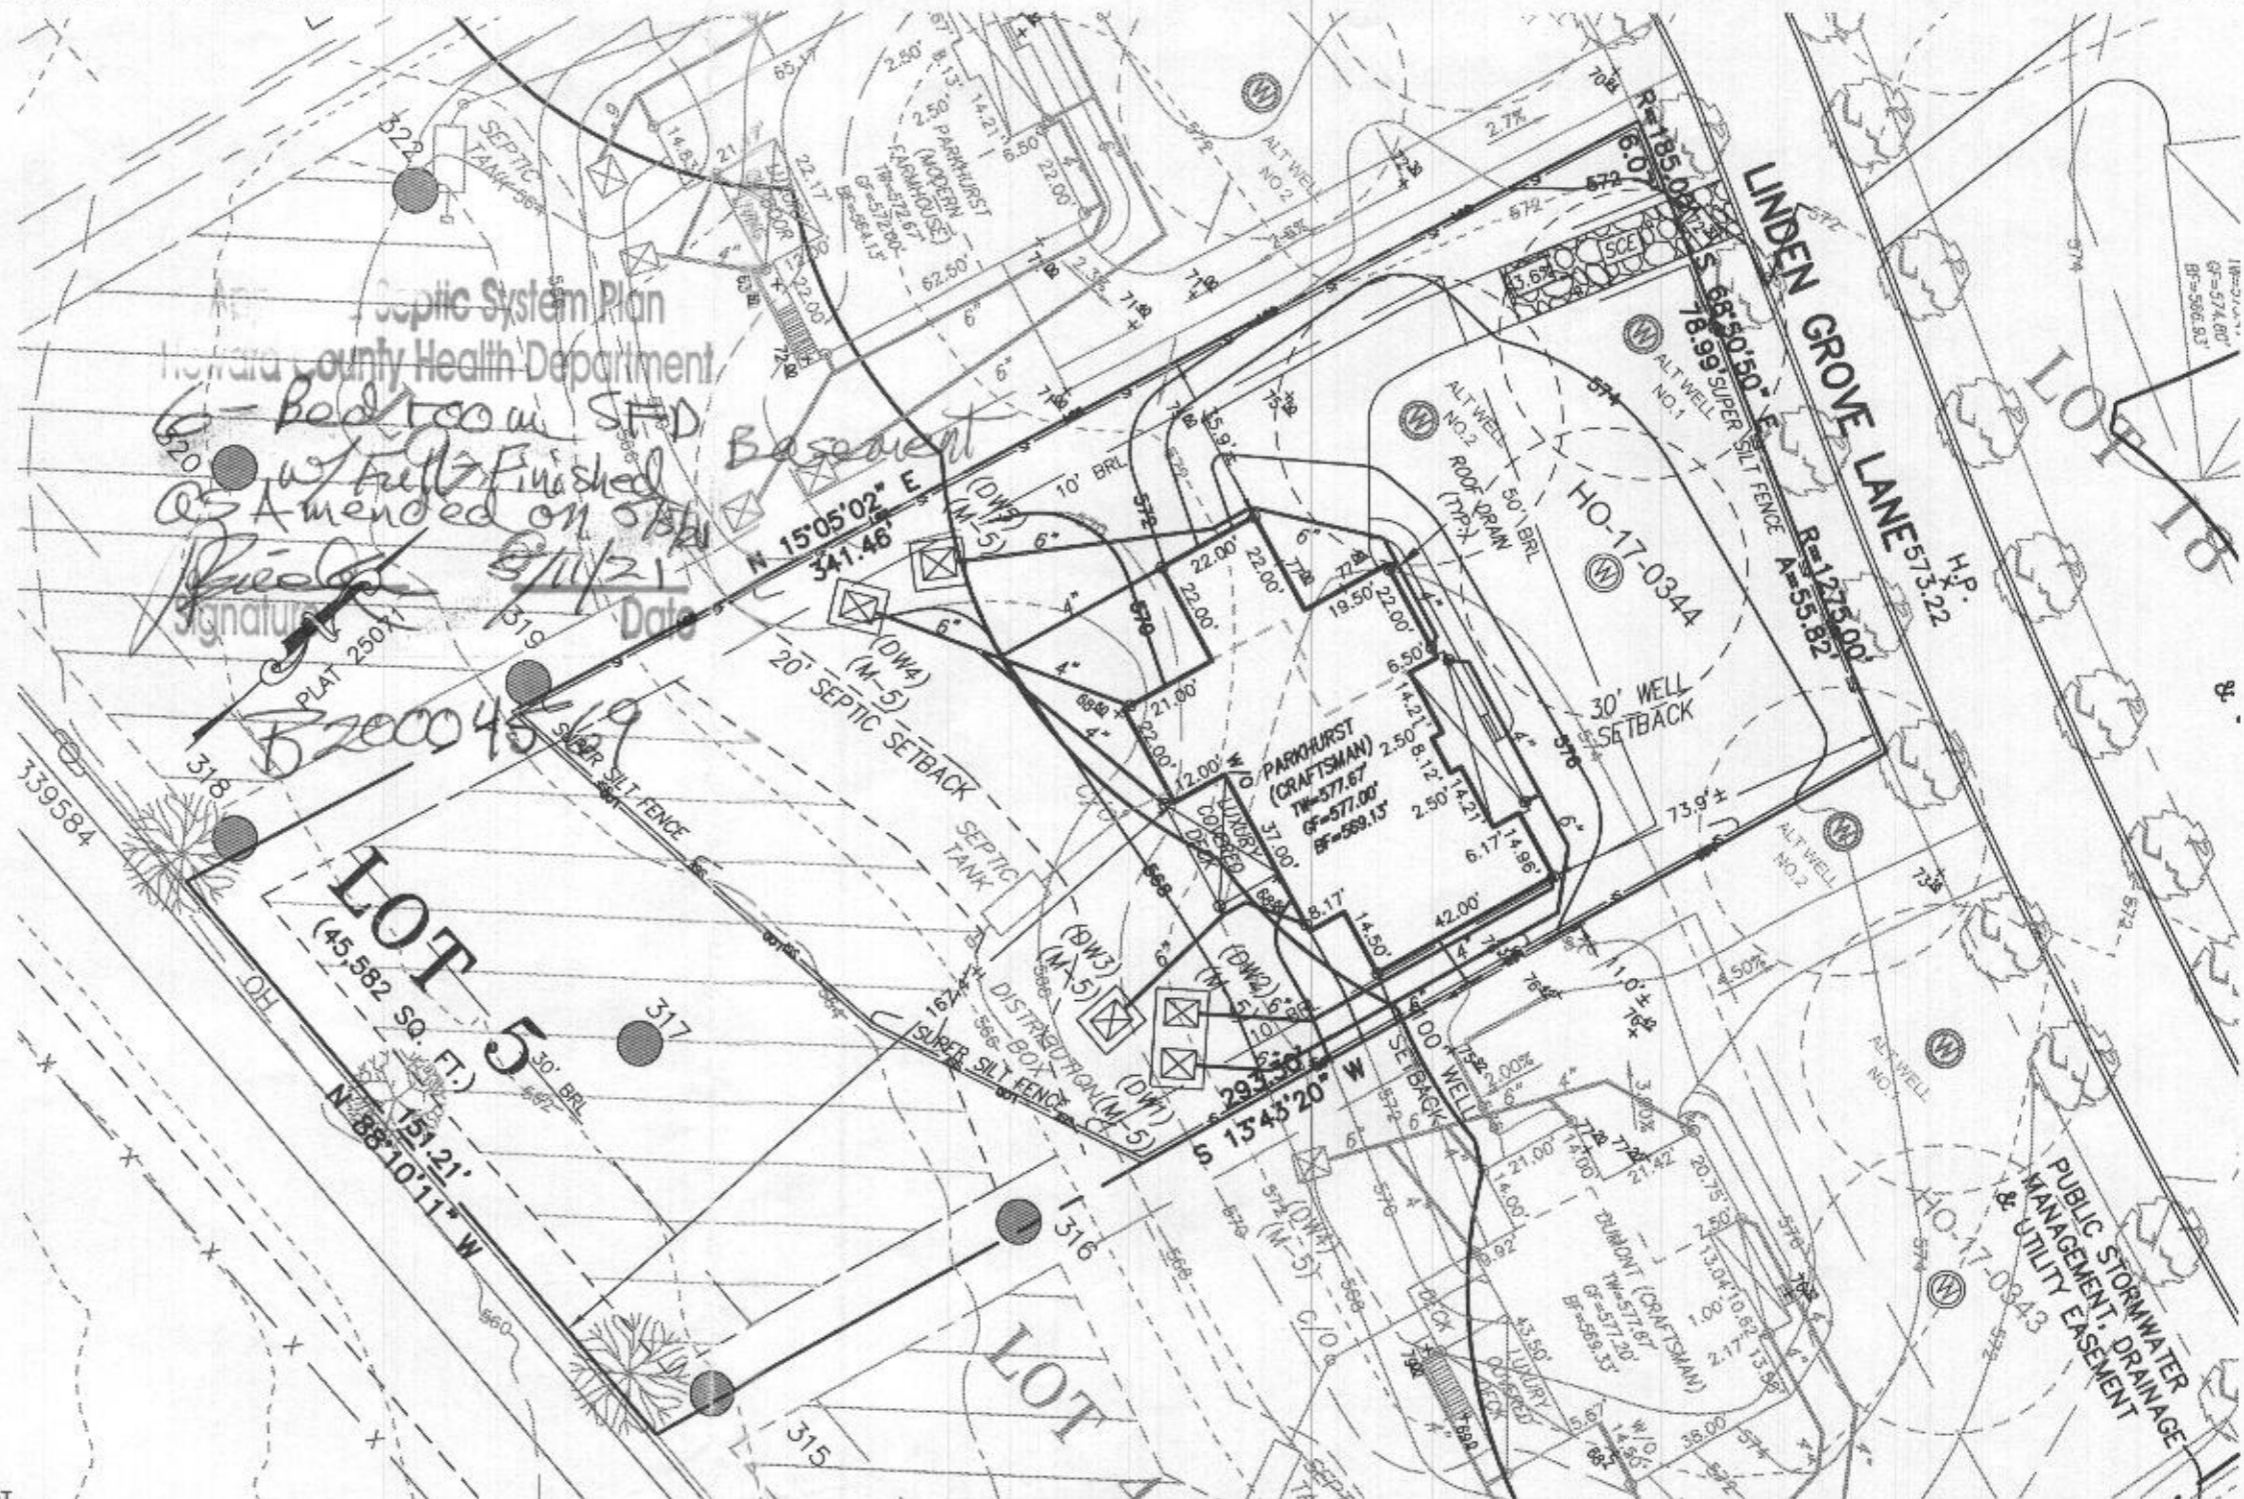

Septic System Plan
Howard County Health Department
6 - Bedroom SFD
Basement
As Amended on 05/21/21
Signature: [Handwritten Signature]
Date: 8/11/21



HOUSE TYPE: PARKHURST (CRAFTSMAN)

- | | |
|---|---------------------|
| TWO CAR SIDE ENTRY GARAGE CONFIGURATION | OPTION No. 012 |
| WALK-OUT BASEMENT | OPTION No. 017 |
| ADD'L TWO CAR FRONT ENTRY GARAGE | OPTION No. 263019 |
| GRAND MULTI-GENERATIONAL SUITE ADDITION | OPTION No. 263075 |
| OPTIONAL DROP ZONE | OPTION No. 263081 |
| WALK-OUT LUXURY COVERED DECK | OPTION No. 263169 |
| DOUBLE WIDE DRIVEWAY TAIL | OPTION No. 851 |
| WET BAR ROUGH IN BASEMENT | OPTION No. 90005021 |

WELL NUMBER: HO-17-0344
ADDRESS: 15621 LINDEN GROVE LANE
WOODBINE, MD 21797

PLOT PLAN
LOT 5
LINDEN GROVE
LIBER 15899, FOLIO 246
PLAT NO. 25071
ELECTION DISTRICT No. 4
HOWARD COUNTY, MARYLAND

ESE CONSULTANTS
ENGINEERING • PLANNING • SURVEYING • ENVIRONMENT

ESE Consultants, Inc.
7164 Columbia Gateway Drive • Suite 230 • Columbia, MD 21046
T: 410-872-9105

DATE: 04/01/2021 SCALE: 1" = 40' FILE: 4683 PP LOT 5 - PARK. CRAFT.
CHK'D: M.J.B. JOB NO: 4683 DRAWN: G.V.S. / V.X.P.

Health Dept

B20004569

revised House type

15621 Linden Grove Lane

LOT 5


- GENERAL PLAN NOTES**
- ALL WOOD STUD PARTITIONS NOT DIMENSIONED ARE TO BE 2" X 4" FOR INTERIOR AND 2" X 6" FOR EXTERIOR WALLS UNLESS OTHERWISE NOTED.
 - ALL INTERIOR DIMENSIONS ARE TO FACE OF STUD.
 - ALL EXTERIOR DIMENSIONS ARE TO FACE OF STUD.
 - ALL DIMENSIONS GOVERN OVER SCALE.
 - ALL SMOKE DETECTORS ARE TO BE WIRED IN SUCH A MANNER THAT ACTIVATION OF ONE WILL ACTIVATE THEM ALL.
 - UNFINISHED ACCESSIBLE SPACE UNDER STAIRS SHALL HAVE WALLS AND DECKING PROTECTED ON ENCLOSED SIDE WITH 1/2" GYPSUM BOARD.
 - ALL WINDOW SIZES ARE NOTED IN FEET - INCHES AS MEASURED FROM SASH TO SASH.
 - REFER TO ELEVATIONS FOR WINDOW HEAD HEIGHTS.
 - ALL DOORS ARE TO BE 6'-8" HIGH UNLESS OTHERWISE NOTED.
 - WALLS ARE ALWAYS TO BE ON LEFT SIDE OF DOOR.
 - DOORWAYS ARE ALWAYS TO BE ON RIGHT SIDE OF SINK.

Grand multi gen suite above

unfinished area
See attached pages

Luxury covered Deck above
See attached pages

OPT. 263218 TWO CAR GARAGE
See attached pages

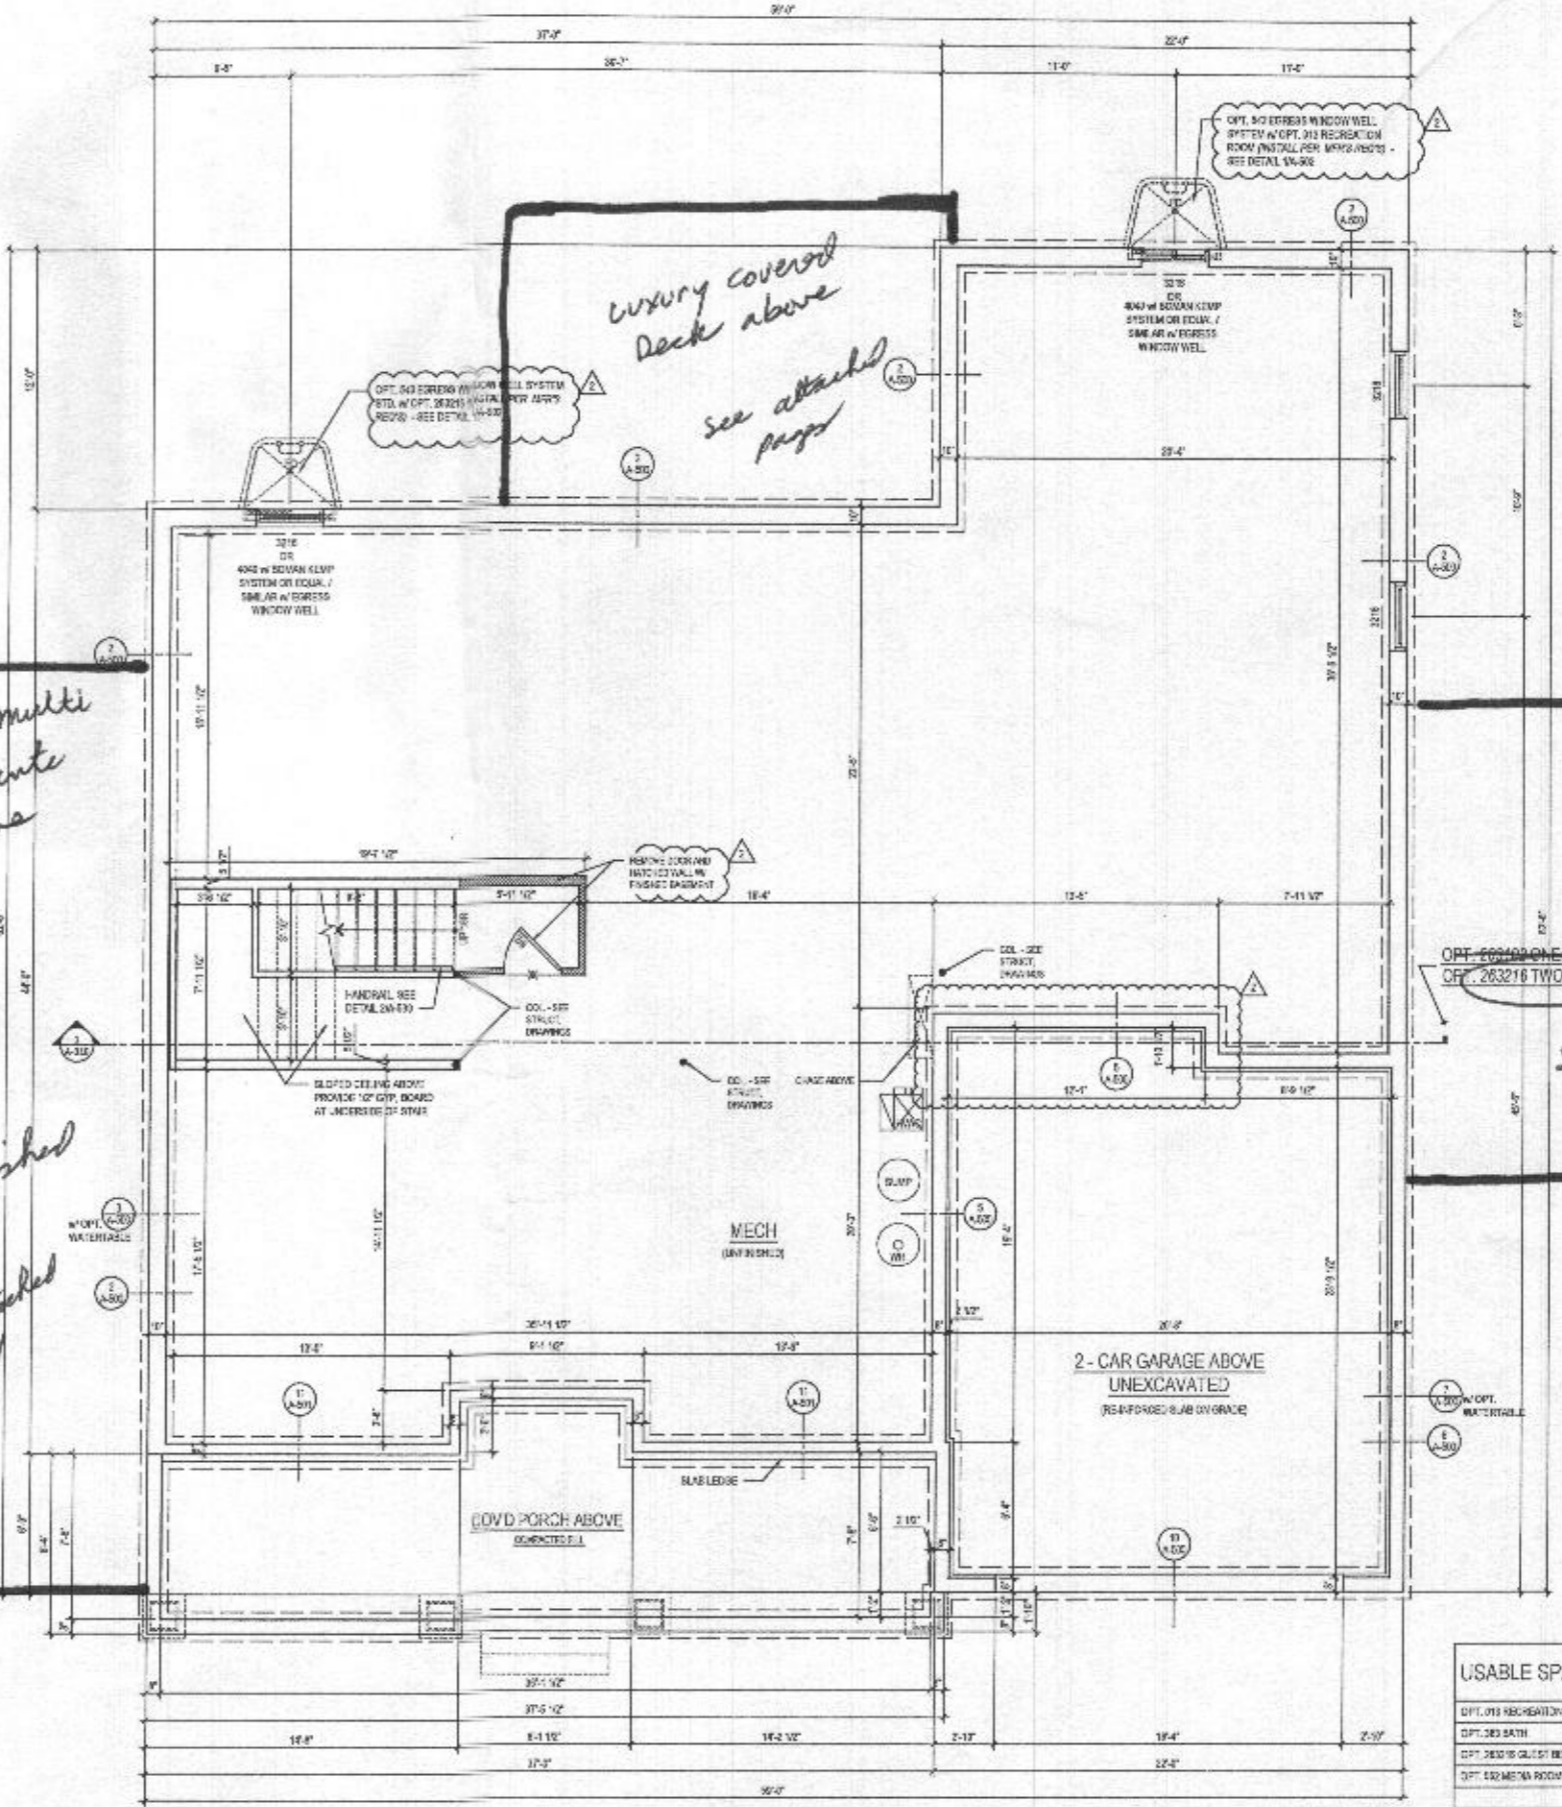

1 BASEMENT FLOOR PLAN *unfinished*
A-100 SCALE: 1/4" = 1'-0"
DATE: 06/20/19

@ ELEV. 1 - CRAFTSMAN
@ UNFINISHED CONDITION

USABLE SPACE	SQ. FT.
OPT. 019 RECREATION ROOM	1,172
OPT. 283 BATH	41
OPT. 283 CLUST. BEDROOM	212
OPT. 132 MEDIA ROOM	246
TOTAL	1,671

ARCHITECT:

8521 Leesburg Pike
Suite 700 | Vienna, VA 22182
P: 571.830.1800 | F: 571.830.1801
www.lessarddesign.com

SCALE & STRUCTURE

OWNER:

TOLL BROTHERS
10775 BELMONT EXECUTIVE PLAZA
ASHLAND, VA 23047
P: 571.251.0005
CONTACT: CHRISTINA LEHLEY
clehley@tollbrothers.com

MARYLAND

PARKHURST FLOOR PLANS

PROJECT NAME:


SHEET TITLE:

SCALE / REVISION		
NO.	DESCRIPTION	DATE
01	ISSUE SET	05.20.19
02	PERMIT SET	05.20.19
03	NO NEW STANDARDS	05.20.19
04	REV. 42280-01	12.31.20


PROJECT NO: 19-001
DRAWN BY: JAP/ML
CHECKED BY: JAP/ML
PLOT DATE: Dec. 28, 2020
PLOT NAME: 19-001_A100.dwg

A-100

- GENERAL PLAN NOTES**
- A. ALL WOOD STUD PARTITIONS NOT DIMENSIONED ARE TO BE 2" X 4" FOR INTERIOR AND 6" X 6" FOR EXTERIOR WALLS UNLESS OTHERWISE NOTED.
 - B. ALL INTERIOR DIMENSIONS ARE TO FACE OF STUDS.
 - C. ALL EXTERIOR DIMENSIONS ARE TO FACE OF STUDS.
 - D. ALL DIMENSIONS GOVERN OVER SCALE.
 - E. ALL SMOKE DETECTORS ARE TO BE WIRED IN SUCH A MANNER THAT ACTIVATION OF ONE WILL ACTIVATE THEM ALL.
 - F. ENCL. INTO ACCESSIBLE SPACE UNDER STAIRS SHALL HAVE WALLS AND CEILING PROTECTED ON ENCLOSED SIDE WITH 1/2" OSB/PLY BOARD.
 - G. ALL WINDOWS SHOWN ARE NOTED IN FEET - INCHES AS MEAS. FROM SASH TO SASH.
 - H. REFER TO ELEVATIONS FOR WINDOW HEAD HEIGHTS.
 - I. ALL DOORS ARE TO BE 80" HIGH UNLESS OTHERWISE NOTED.
 - J. WASHER ALWAYS TO BE ON LEFT SIDE OF SINK.
 - K. DRYER ALWAYS TO BE ON RIGHT SIDE OF SINK.

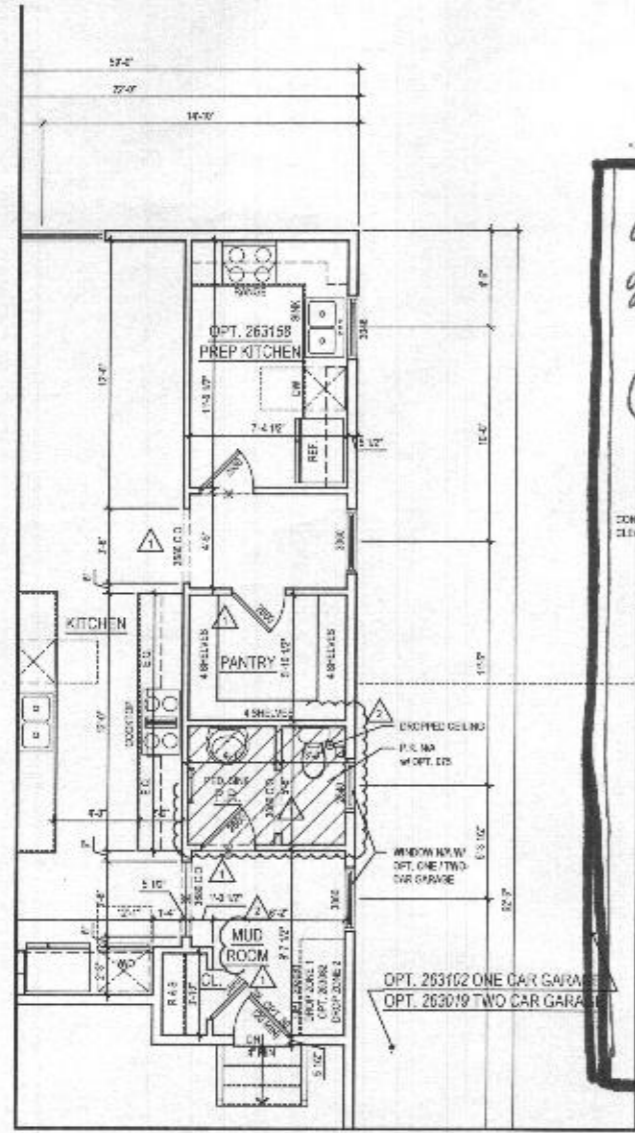

2 PART. FIRST FLOOR PLAN w/ OPT. 263158 - OPT. PREP KITCHEN
 A-110 SCALE: 1/4" = 1'-0"
 10/24/21 (A-110)

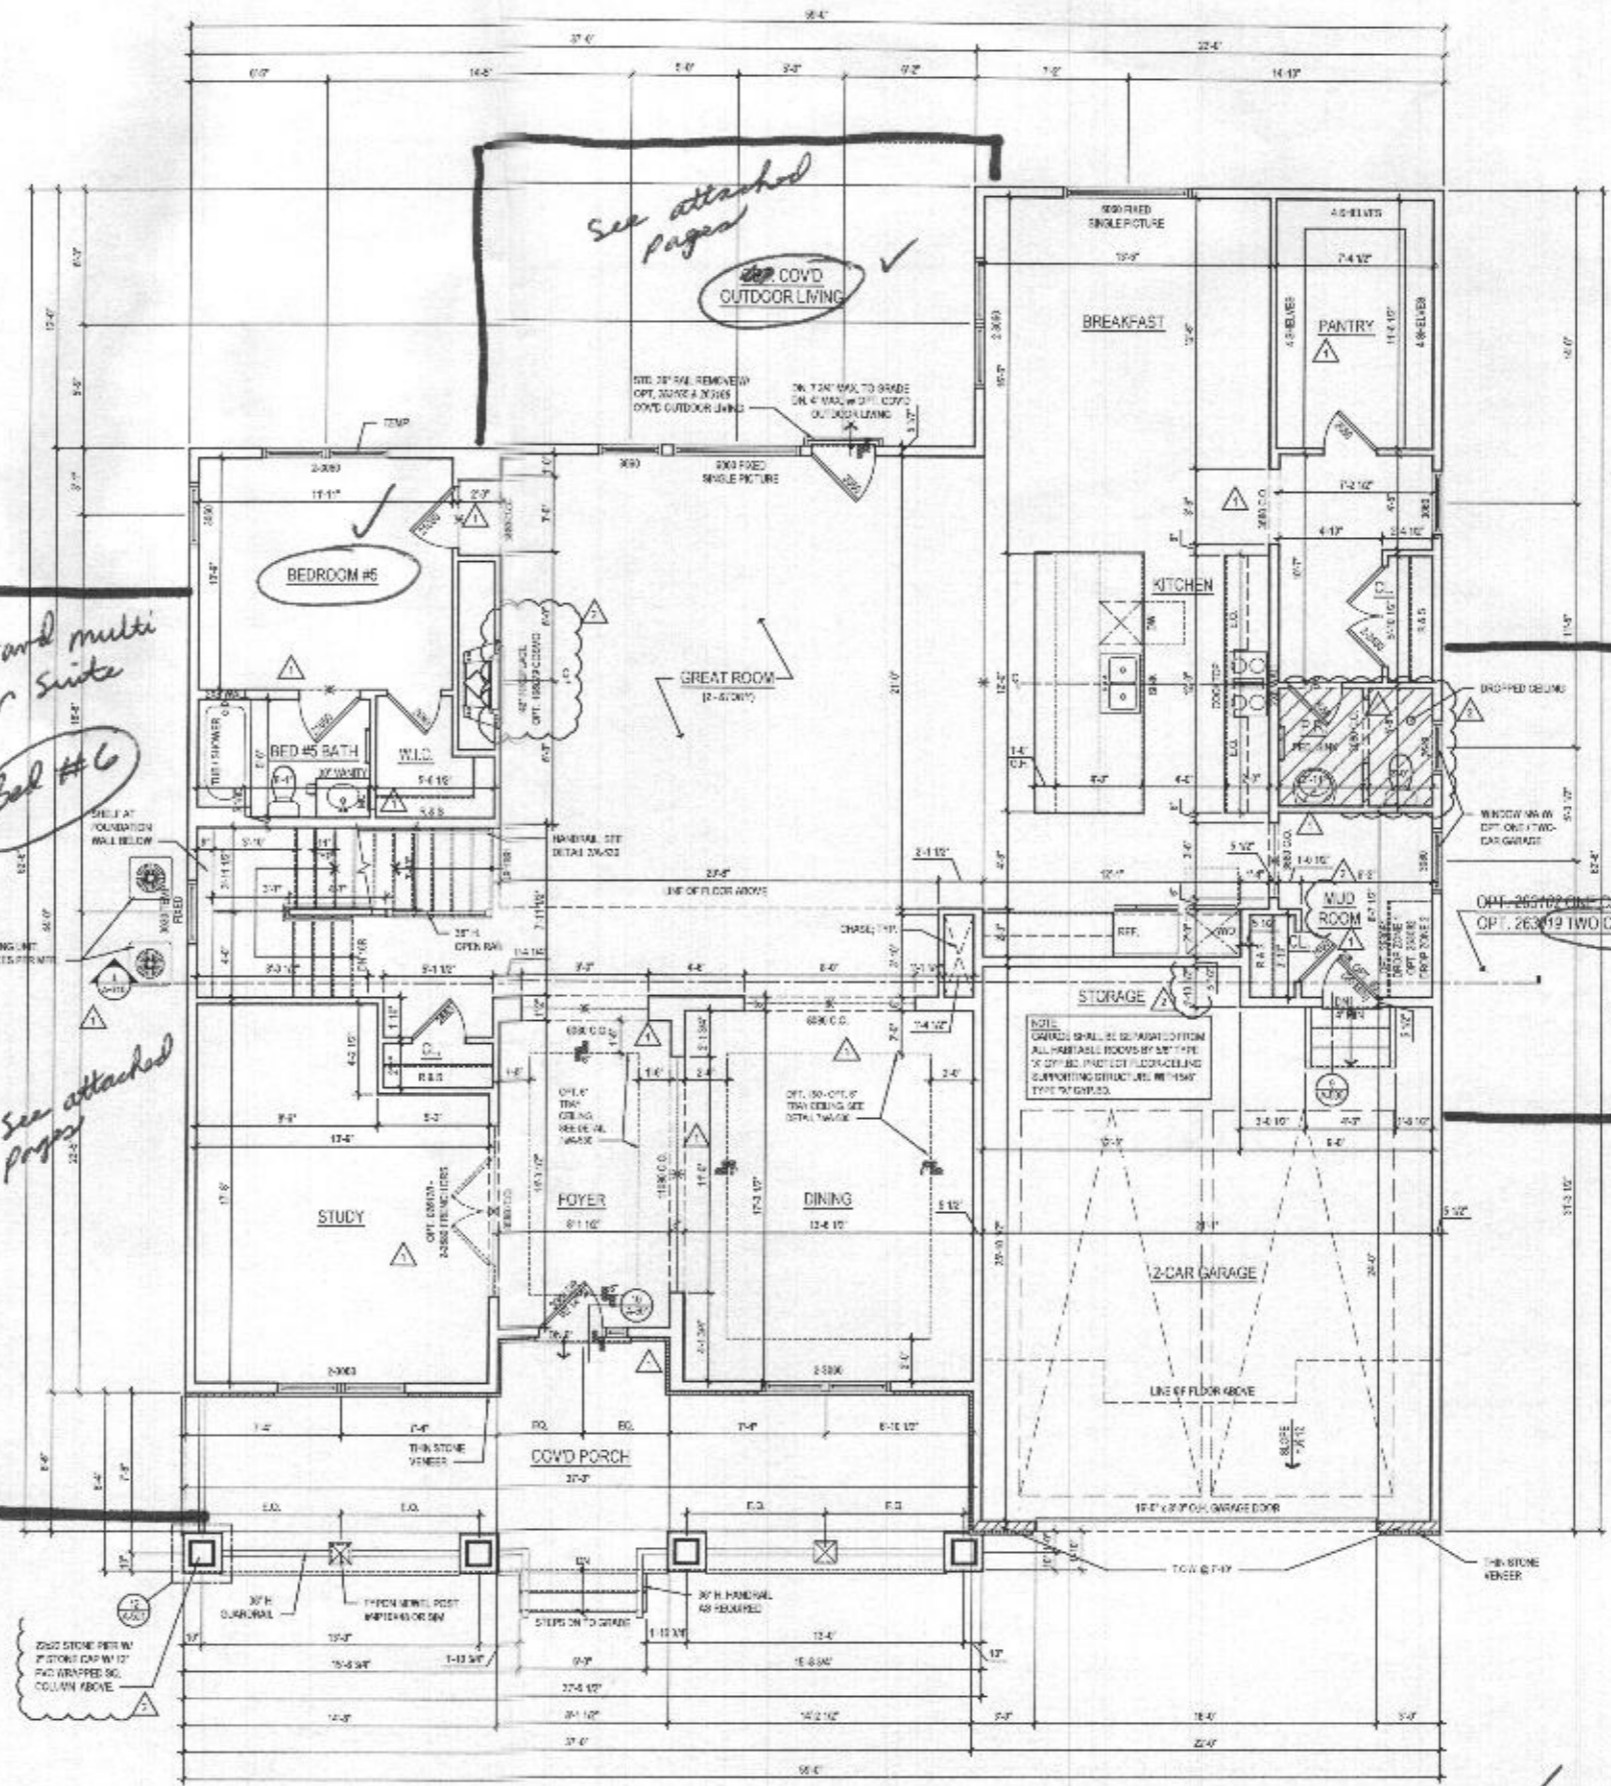

1 FIRST FLOOR PLAN
 A-110 SCALE: 1/4" = 1'-0"
 10/24/21 (A-110)

@ ELEV. 1 - CRAFTSMAN

lessard DESIGN
 8521 Leesburg Pike
 Suite 700 | Vienna, VA 22182
 P: 571.830.1800 | F: 571.830.1801
 www.lessarddesign.com

TOLL BROTHERS
 775 BELMONT EXECUTIVE PLAZA
 ARLINGTON, VA 22202
 P: 571.281.2000
 CONTACT: CHRISTINA LEYLER
 christina@tollbrothers.com

MARYLAND
PARKHURST
FLOOR PLANS


NO.	DATE / REVISION	DATE
1	ISSUED SET	06.24.21
2	REVISIONS	06.24.21
3	NO. 1 REVISIONS	06.25.21
4	NO. 2 REVISIONS	12.11.21

PROJECT NAME: _____
 SHEET TITLE: _____

DESIGNER: _____
 DRAWN BY: _____
 CHECKED BY: _____
 DATE: Nov. 30, 2021
 FILE NAME: 10-010_A110.dwg


A-110

File No: TOL081a_A110.dwg
 Plot by: ewk

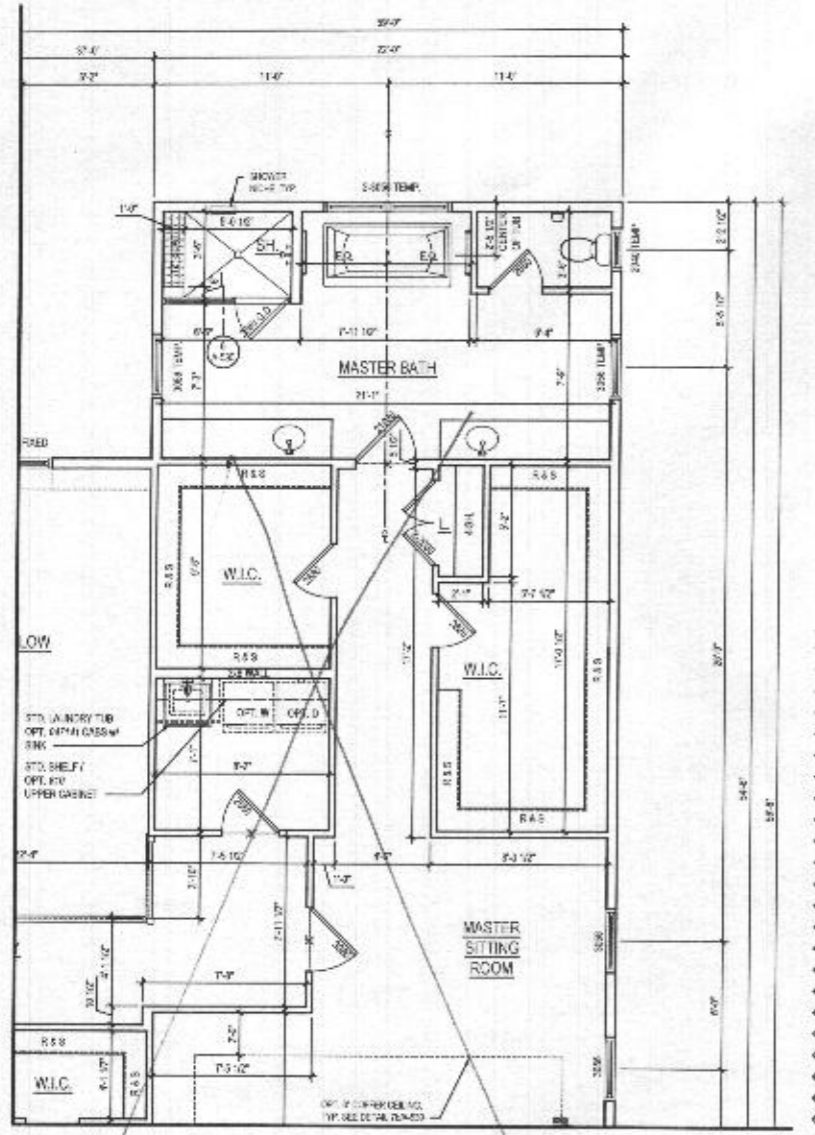

2 PART. SECOND FLOOR PLAN w/ OPT. 030 - ADDITIONAL WALK IN CLOSET
 A-120 SCALE: 1/4" = 1'-0"
 12/15/2011

- GENERAL PLAN NOTES**
- ALL WOOD STUD PARTITIONS NOT DIMENSIONED ARE TO BE 2x4 FOR INTERIOR AND 2x6 FOR EXTERIOR WALLS UNLESS OTHERWISE NOTED.
 - ALL INTERIOR DIMENSIONS ARE TO FACE OF STUDS.
 - ALL EXTERIOR DIMENSIONS ARE TO FACE OF STUDS.
 - ALL DIMENSIONS GOVERN OVER SCALE.
 - ALL SMOKE DETECTORS ARE TO BE WIRED IN SUCH MANNER THAT ACTIVATION OF ONE WILL ACTIVATE THEM ALL.
 - ENCLOSED ACCESSIBLE SINGLE USER STAIRS SHALL HAVE WALLS AND GUTTERS PROTECTED ON ENCLOSED SIDE WITH 1/2" GYP-SHM BOARD.
 - ALL WINDOWS SHALL BE NOTED IN FEET + INCHES AS MEASURED FROM GROUND TO SILL.
 - REFER TO ELEVATIONS FOR WINDOW AND HEIGHTS.
 - ALL DOORS ARE TO BE 6' 8" UNLESS OTHERWISE NOTED.
 - WALKER ALWAYS TO BE ON LEFT SIDE OF DOOR.
 - DOOR WASHER ALWAYS TO BE ON RIGHT SIDE OF DOOR.

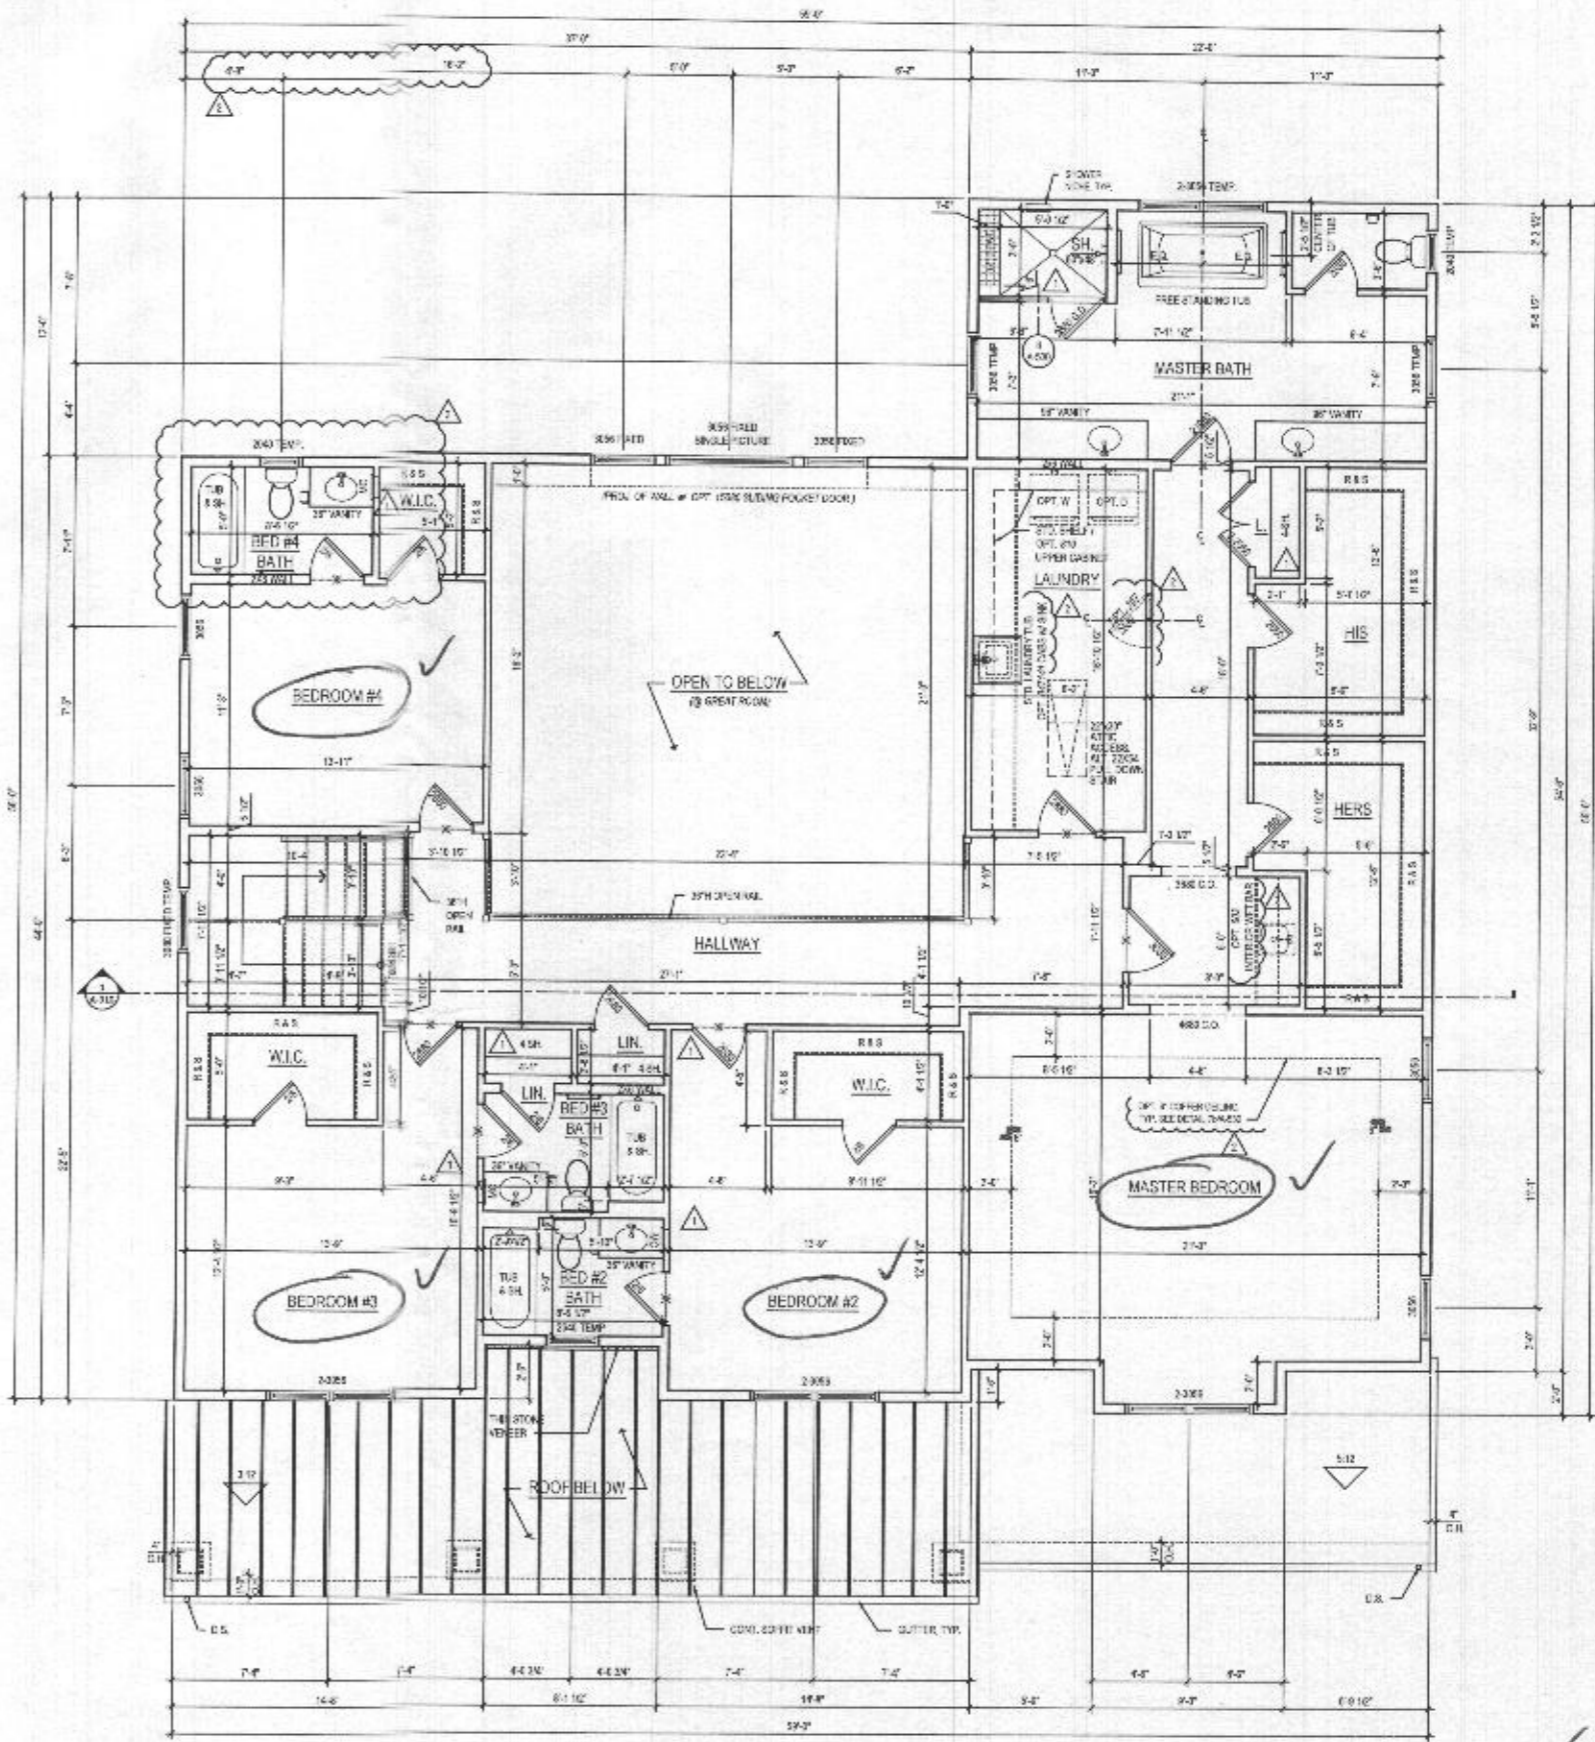

1 SECOND FLOOR PLAN
 A-120 SCALE: 1/4" = 1'-0"
 12/15/2011

@ ELEV. 1 - CRAFTSMAN

ARCHITECT

lessard
DESIGN

8521 Leesburg Pike
Suite 700 | Vienna, VA 22182
P: 571.830.1800 | F: 571.830.1803
www.lessarddesign.com

OWNER:

TOLL BROTHERS
 19775 BELLEVUE EXECUTIVE PLAZA
 KENNESAW, WA 98147
 P: 206.255.5068
 CONTACT: CHRIS LUK CONVEY
 dluk@tollbrothers.com

PROJECT NAME: MARYLAND


SHEET TITLE: PARKHURST FLOOR PLANS

NO.	DESCRIPTION	DATE
1	ISSUE FOR PERMITS	06.20.11
2	ISSUE FOR PERMITS	06.20.11
3	ISSUE FOR PERMITS	07.16.11
4	ISSUE FOR PERMITS	11.11.11


PROJECT NO: TOL 2006
 DRAWN BY: MCH
 CHECKED BY: JH
 PLOT DATE: 11/15/11
 FILE NAME: TOL06A_R30.dwg

A-120

- GENERAL PLAN NOTES**
- ALL WOOD STUD PARTITIONS NOT DIMENSIONED ARE TO BE 2" X 4" FOR INTERIORS AND 2" X 6" FOR EXTERIORS UNLESS OTHERWISE NOTED.
 - ALL INTERIOR DIMENSIONS ARE TO FACE OF STUDS.
 - ALL EXTERIOR DIMENSIONS ARE TO FACE OF STUDS.
 - ALL DIMENSIONS GOVERN OVER SCALE.
 - ALL SMOKE DETECTORS ARE TO BE WIRELESS IN SUCH A MANNER THAT ACTIVATION OF ONE WILL ACTIVATE THEM ALL.
 - ENTRANCED ACCESSIBLE SPACES UNDER STAIRS SHALL HAVE WALLS AND CEILING PROTECTED ON ENCLOSED SIDE BY 1/2" X 1/2" LIVING IN BOARD.
 - ALL WINDOWS SEE SPEC NOTED IN FILE - BEING AS NEARLY AS POSSIBLE FROM DASH TO SASH.
 - REFER TO ELEVATIONS FOR WINDOW HEAD HEIGHTS.
 - ALL DOORS ARE TO BE 42" HIGH UNLESS OTHERWISE NOTED.
 - WALKWAY IS ALWAYS TO BE ON LEFT SIDE OF DOOR.
 - DOORWAY IS ALWAYS TO BE ON RIGHT SIDE OF DOOR.

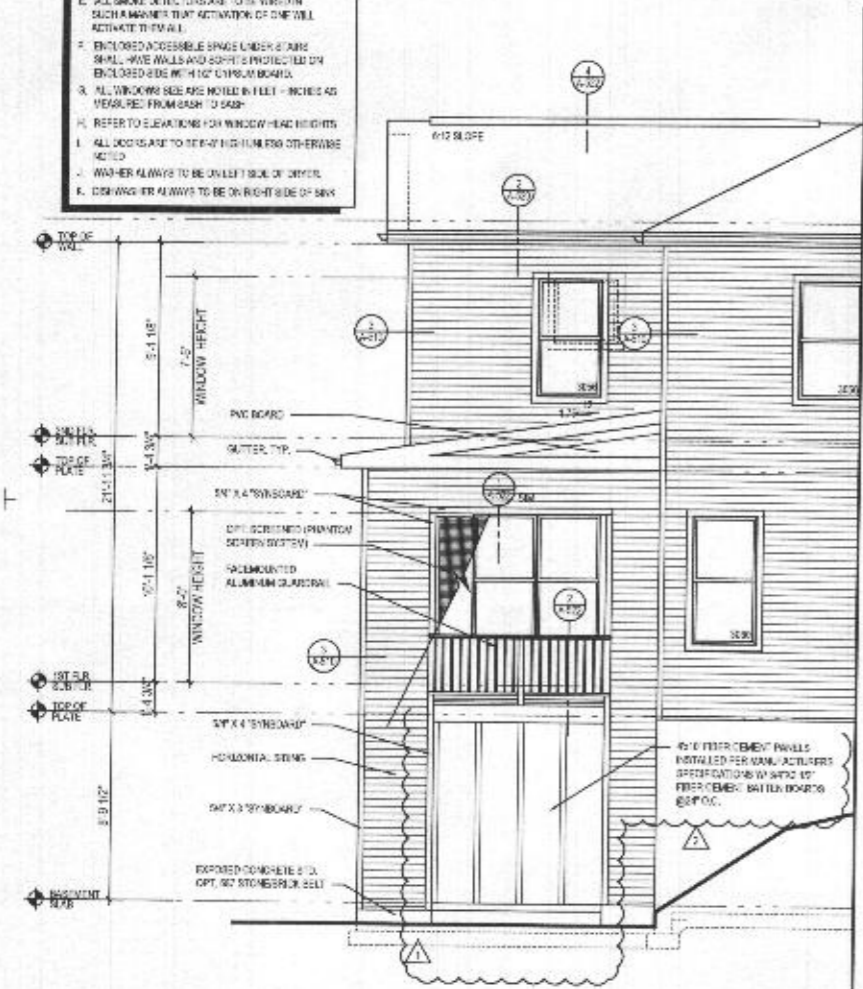

6 PART. LEFT ELEV.
A-403 SCALE 1/8"=1'-0"
TOLSON/STUBBS

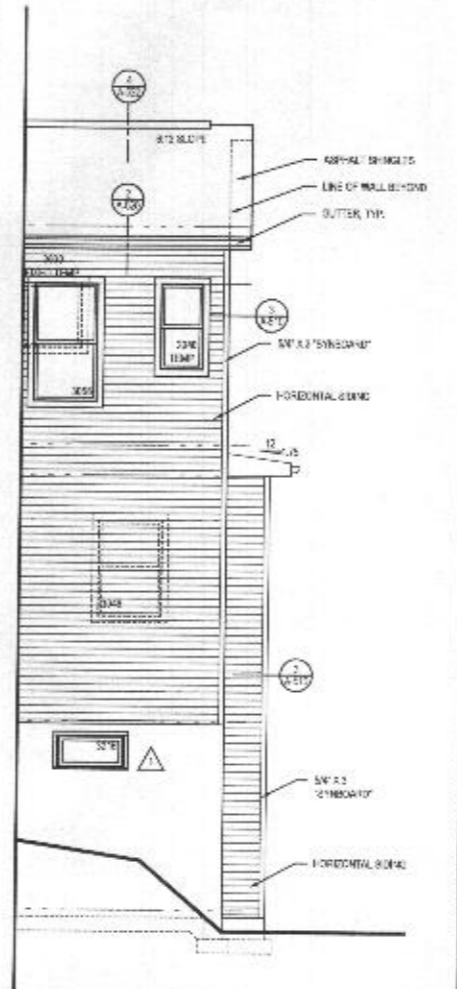


5 PART. RIGHT ELEV.
A-403 SCALE 1/8"=1'-0"
TOLSON/STUBBS




4 REAR ELEVATION
A-403 SCALE 1/8"=1'-0"
TOLSON/STUBBS

ROOF VENTILATION CALCULATIONS - REAR ROOF


ROOF AREA	=	326.0 SQ. FT.
1 IN. R.C.	=	2.15 SQ. FT.
4 12 x 12	=	214.8 SQ. FT.
ROOF VENT. REQUIRED INTAKE @ 1.0 SQ. FT. / 1 FT. L	=	53.3 FT. L
ROOF VENT. PROVIDED	=	30.0 FT. L

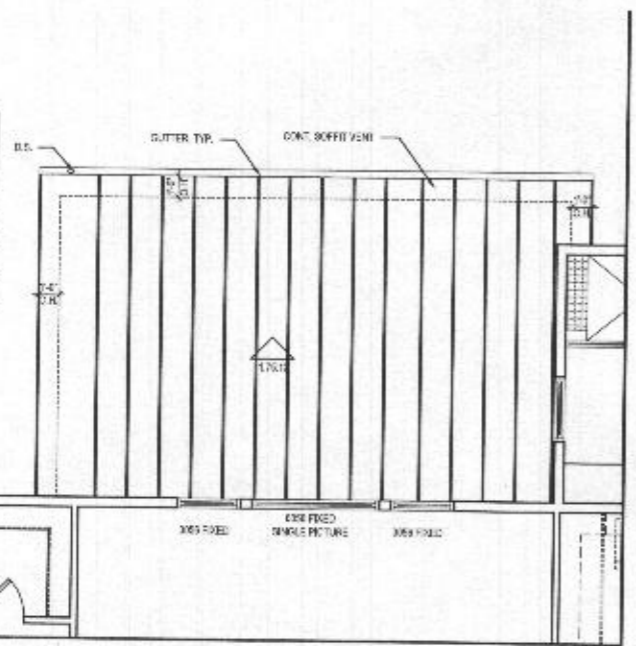

3 PART. SECOND FLOOR PLAN
A-403 SCALE 1/4"=1'-0"
TOLSON/STUBBS

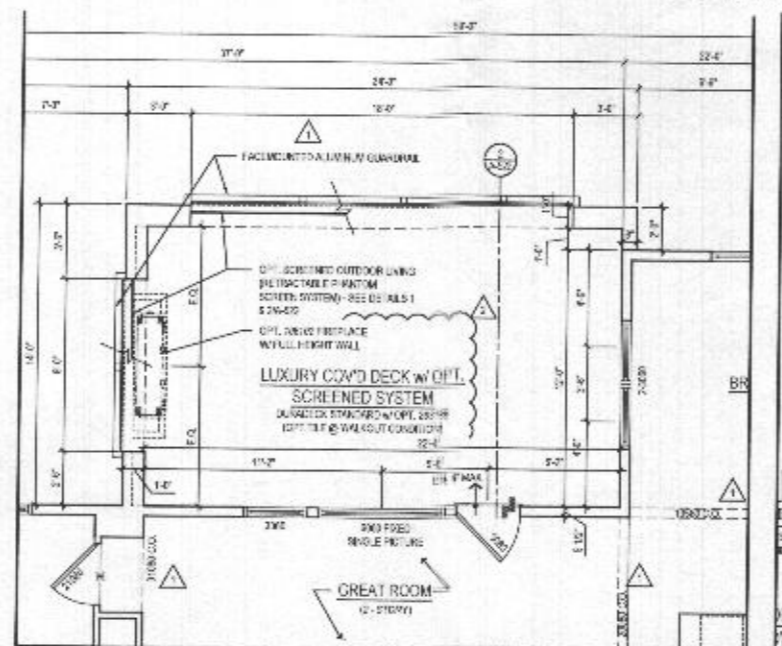

2 PART. FIRST FLOOR PLAN
A-403 SCALE 1/4"=1'-0"
TOLSON/STUBBS

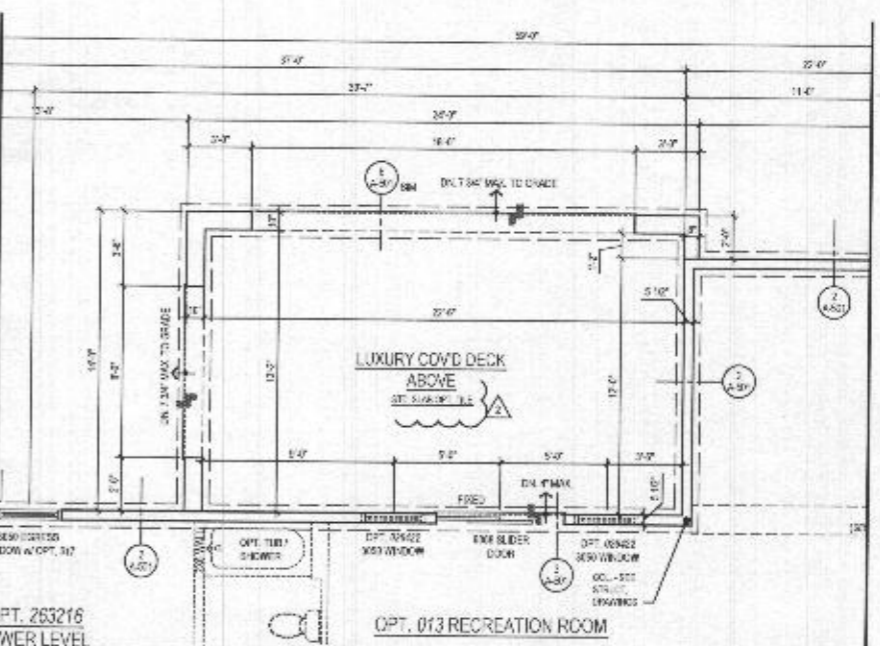

1 PART. BASEMENT FLOOR PLAN
A-403 SCALE 1/4"=1'-0"
TOLSON/STUBBS

w/ OPT. 263169 - WALKOUT LUXURY COVERED DECK

ARCHITECT

lessard DESIGN
8521 Leesbury Pike
Suite 700 | Vienna, VA 22182
P: 571.830.1800 | F: 571.830.1801
www.lessarddesign.com

SEAL & STRUCTURE

OWNER:

TOLL BROTHERS
19775 BELMONT EXECUTIVE PLAZA
ASHBURN, VA 22647
P: 571.291.8088
CONTACT: CHRISTINA LITTELL
tollbrothers.com

MARYLAND

PARKHURST OPTIONS

PROJECT NAME: _____

SHEET TITLE: _____

NO.	DESCRIPTION	DATE
1	ISSUED FOR PERMIT	11.26.19
2	PERMIT SET	12.18.19
3	NO NEW STANDARDS	09.12.19
4	2\"/>	


PROJECT NO: _____
DRAWN BY: _____
CHECKED BY: _____
DATE: _____
FILE NO: _____

A-403


File No: TOL0814_A403.dwg
Rev By: sba



6 REAR ELEVATION w/ OPT. 263075 GRAND MULTI-GEN. SUITE
 A-406 SCALE: 1/4"=1'-0"
 TYPICAL WALLS

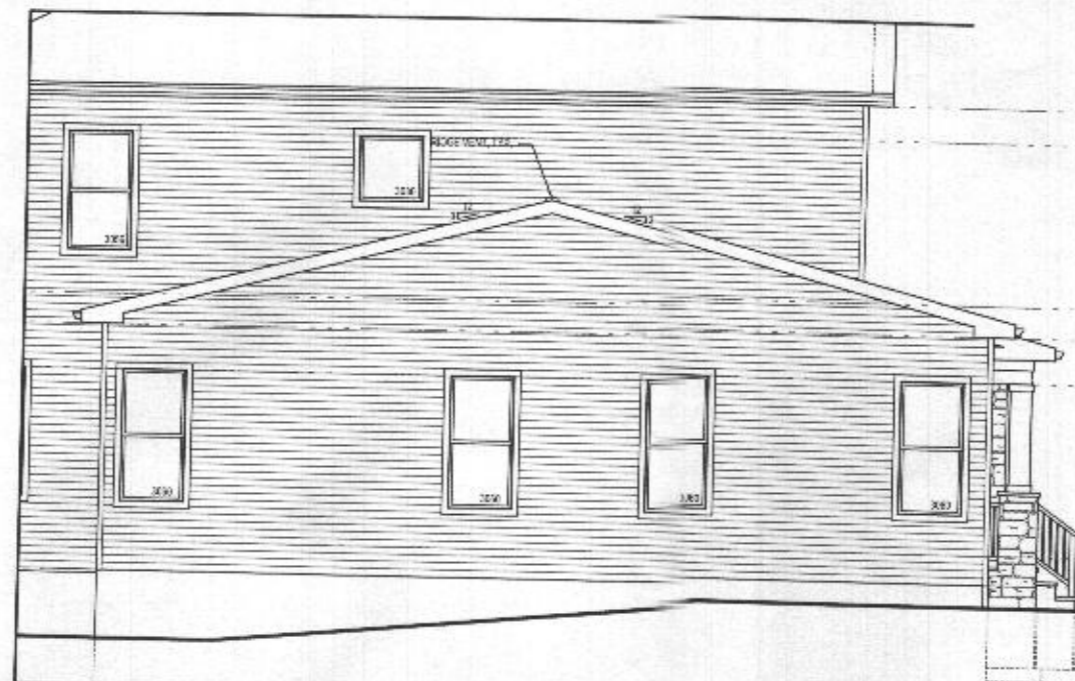

5 PART. LEFT ELEV. w/ OPT. 263075 GRAND MULTI-GEN. SUITE
 A-406 SCALE: 1/4"=1'-0"
 TYPICAL WALLS ELEV. AS SHOWN

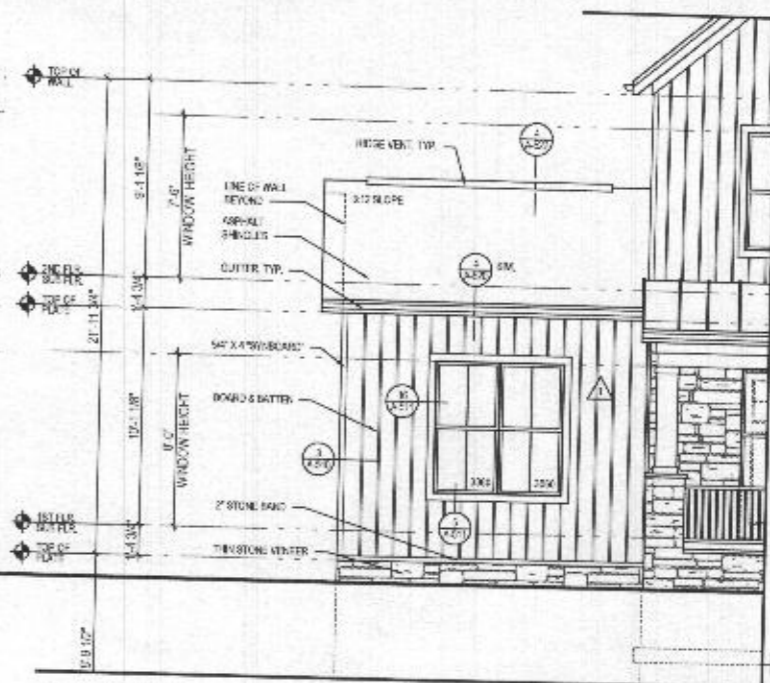


4 PART. FRONT ELEV. w/ OPT. 263075 GRAND MULTI-GEN. SUITE
 A-406 SCALE: 1/4"=1'-0"
 TYPICAL WALLS ELEV. AS SHOWN


ROOF VENTILATION CALCULATIONS - MULTI. GEN SUITE ROOF

ROOF AREA	=	911.41 SQ. FT.
ZON	=	2.34 SQ. FT.
4"x4" IZ	=	23.46 SQ. FT.
MIN INTAKE	=	148.71 SQ. FT.
SOFFIT VENT. REQUIRED INCOME @ 5.3 SQ. FT. VENT.	=	28.67 FT.
SOFFIT VENT. PROVIDED	=	31.4'
MIN. INTAKE	=	148.71 SQ. FT.
ROOF VENT. - REQUIRED (1/4" x 14" IZ)	=	16.4 FT.
ROOF VENT. - PROVIDED	=	14'


- GENERAL PLAN NOTES**
- ALL WOOD SILL PARTITIONS NOT DIMENSIONED ARE TO BE 2" HIGH INTERIOR AND 3" HIGH EXTERIOR WALLS - UNLESS OTHERWISE NOTED.
 - ALL INTERIOR DOOR SWINGS ARE TO FACE OF STUDIOS.
 - ALL EXTERIOR DOOR SWINGS ARE TO FACE OF STUDIOS.
 - ALL DIMENSIONS UNLESS OTHERWISE NOTED.
 - ALL SMOKE DETECTORS ARE TO BE WIRE IN SUCH A MANNER THAT ACTIVATION OF ONE WILL ACTIVATE THEM ALL.
 - ENCLOSED ACCESSIBLE SPACE UNDER STAIRS SHALL HAVE WALKWAYS AND SLOTTED FLOOR ON ENCLOSED SIDE WITH 1/4" SLOPE TO WALKWAY.
 - ALL WINDOWS SHALL BE NOTED IN PLAN - INCHES AS MEASURED FROM GASH TO SASH.
 - REFER TO PARTITIONS FOR WINDOW HEAD HEIGHTS.
 - ALL DOORS ARE TO BE 3'-6" HIGH UNLESS OTHERWISE NOTED.
 - WASHERS ALWAYS TO BE ON LEFT SIDE OF BAY.
 - RESTRICTIONS ALWAYS TO BE ON RIGHT SIDE OF BAY.

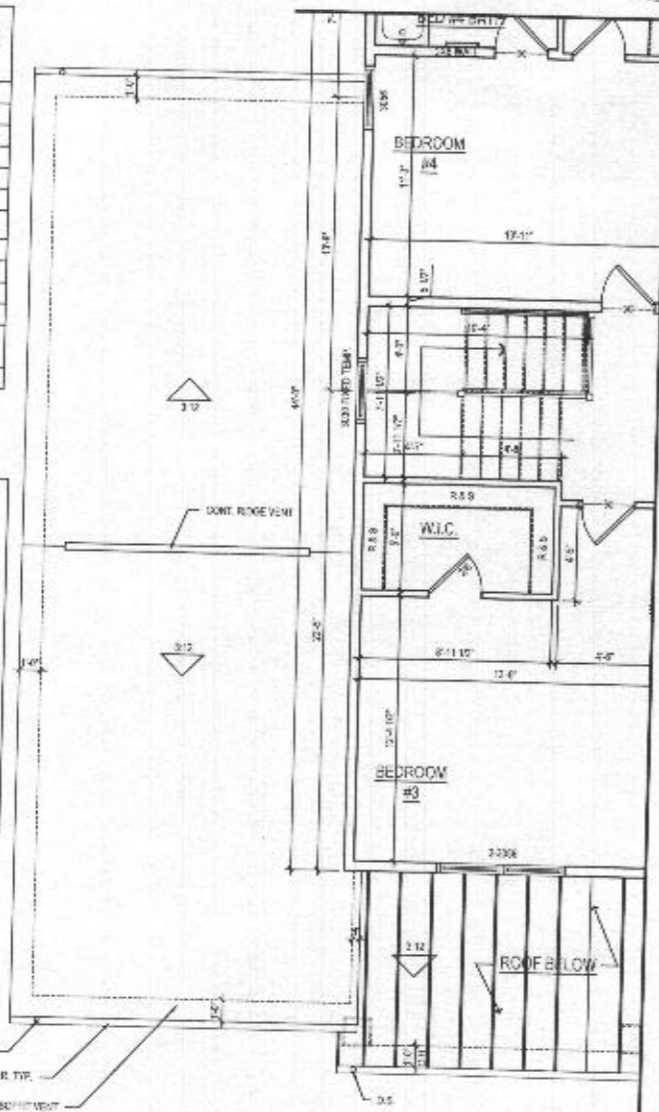

3 PART. SECOND FLOOR PLAN w/ OPT. 263075 GRAND MULTI-GEN. SUITE
 A-406 SCALE: 1/4"=1'-0"
 TYPICAL WALLS

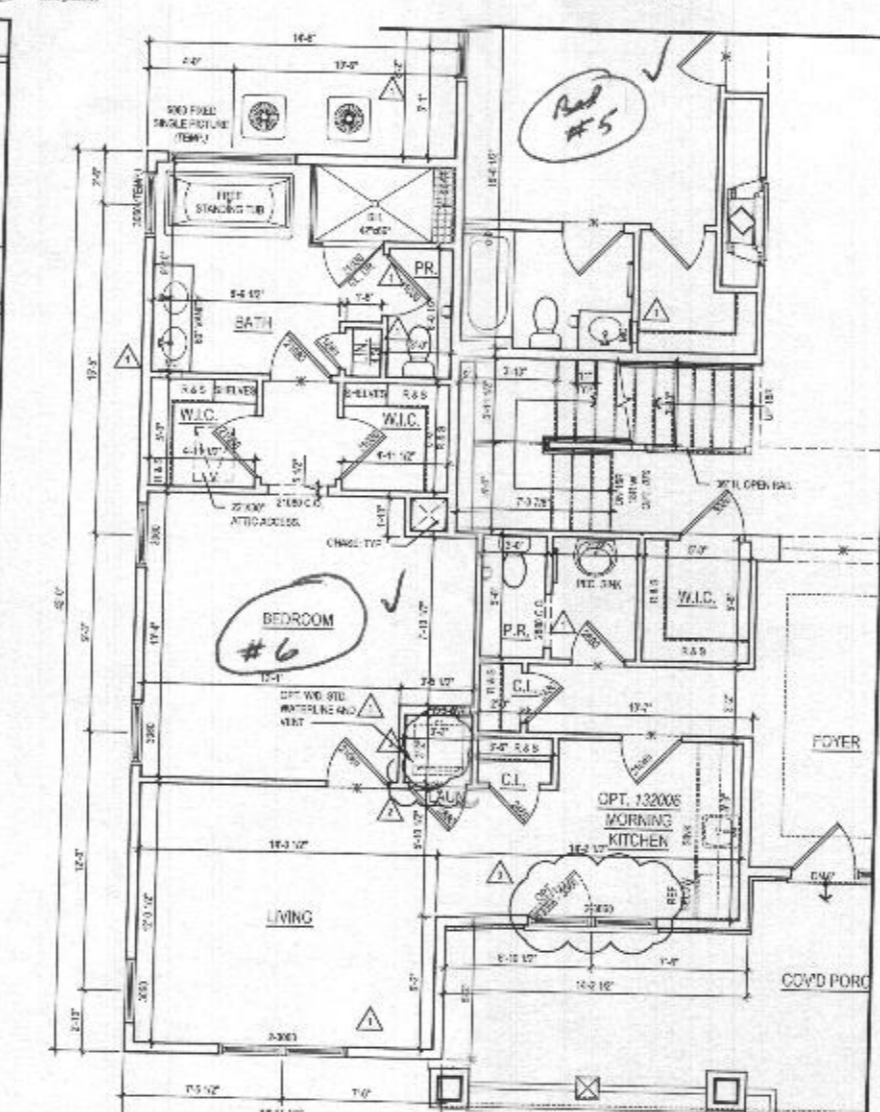

2 PART. FIRST FLOOR PLAN w/ OPT. 263075 GRAND MULTI-GEN. SUITE
 A-406 SCALE: 1/4"=1'-0"
 TYPICAL WALLS

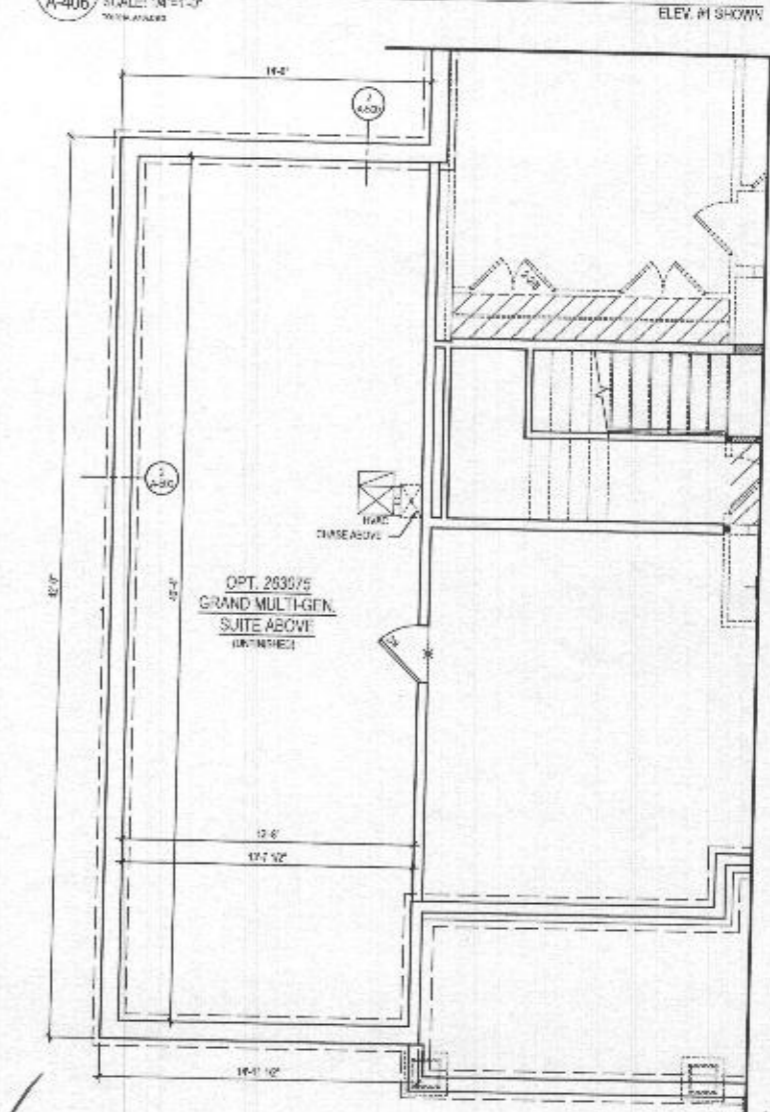

1 PART. BASEMENT PLAN w/ OPT. 263075 GRAND MULTI-GEN. SUITE
 A-406 SCALE: 1/4"=1'-0"
 TYPICAL WALLS

ARCHITECT:

 8523 Loebing Place
 Suite 208 | Vienna, VA 22182
 P: 571.830.1800 | F: 571.830.1801
 www.lessarddesign.com
 SEAL & SIGNATURE:

OWNER:
TOLL BROTHERS
 19775 BELMONT EXECUTIVE PLAZA
 ARLINGTON, VA 22207
 P: 571.221.5868
 CONTACT: CHRISTINA GEMLEY
 christina@tollbrothers.com

EXECUTIVE SERIES
 MARYLAND
**PARKHURST
 OPTIONS**

PROJECT NAME: _____ SHEET TITLE: _____

NO.	DESCRIPTION	DATE
1	PERMIT SET	02.18.18
2	NO NEW FINISHES	06.14.18
3	NO #22241	12.11.17

PROJECT NO: _____ TOR NO: _____
 DRAWN BY: _____
 CHECKED BY: _____
 PLOT DATE: _____
 FILE NAME: _____

A-406

Professionals (This section is not required.)

Search Reset Clear

License # *	Business Name		
103851	HJ POIST		
License Type *	First Name	Middle Name	Last Name
Plumb/Gas	SEAN		UNDERWOOD
Primary	Address Line 1		
Yes	360 MAIN ST		
	Address Line 2		
	City	State	ZIP Code
	LAUREL	MD	20707
	Phone 1	Phone 2	Fax
	E-mail		

Applicant (This section is not required.)

Search As Owner As Lic. Prof As Contact

Type *	First Name	MI	Last Name
Applicant	MICHELLE		CLANCY
Relationship	Full Name		
Applicant	MICHELLE CLANCY		
Primary	Organization Name		
Yes	APPLIED & APPROVED PERMITS LLC		
	Street Address		
	P.O. BOX 310		
	Address Line 2		
	City	State	Zip Code
	PERRY HALL	MD	21128
	Phone	Cell	Fax
	443-340-1229		
	E-mail *		
	MICHELLE@APPLIEDANDAPPROVED.COM		

Addtl Info

Est Construction Cost *	Housing Units *	Number of Buildings *	Public Owned
3000	0	0	No
Construction Type			
--Select--			

TANK INFORMATION


RESIDENTIAL TANK INFORMATION

Capital Project-No Fee *	Capital Project Number	Fee Exempt *	Roadside Tree Project Permit *	Roadside Tree Permit #
<input type="radio"/> Yes <input checked="" type="radio"/> No		<input type="radio"/> Yes <input checked="" type="radio"/> No	<input type="radio"/> Yes <input checked="" type="radio"/> No	
Existing Use	Number of Tanks Installed *	Number of Tanks Removed *		
SFD	1	0		
Water Supply	Sewage Disposal	Expiration Date	Relocate Existing Tank *	
Private	Private	5/14/2022	0	

PAYMENT INFORMATION

Check 1	Payee 1	Check 2	Payee 2	SAP Doc No	SAP Entered

Submit Cancel

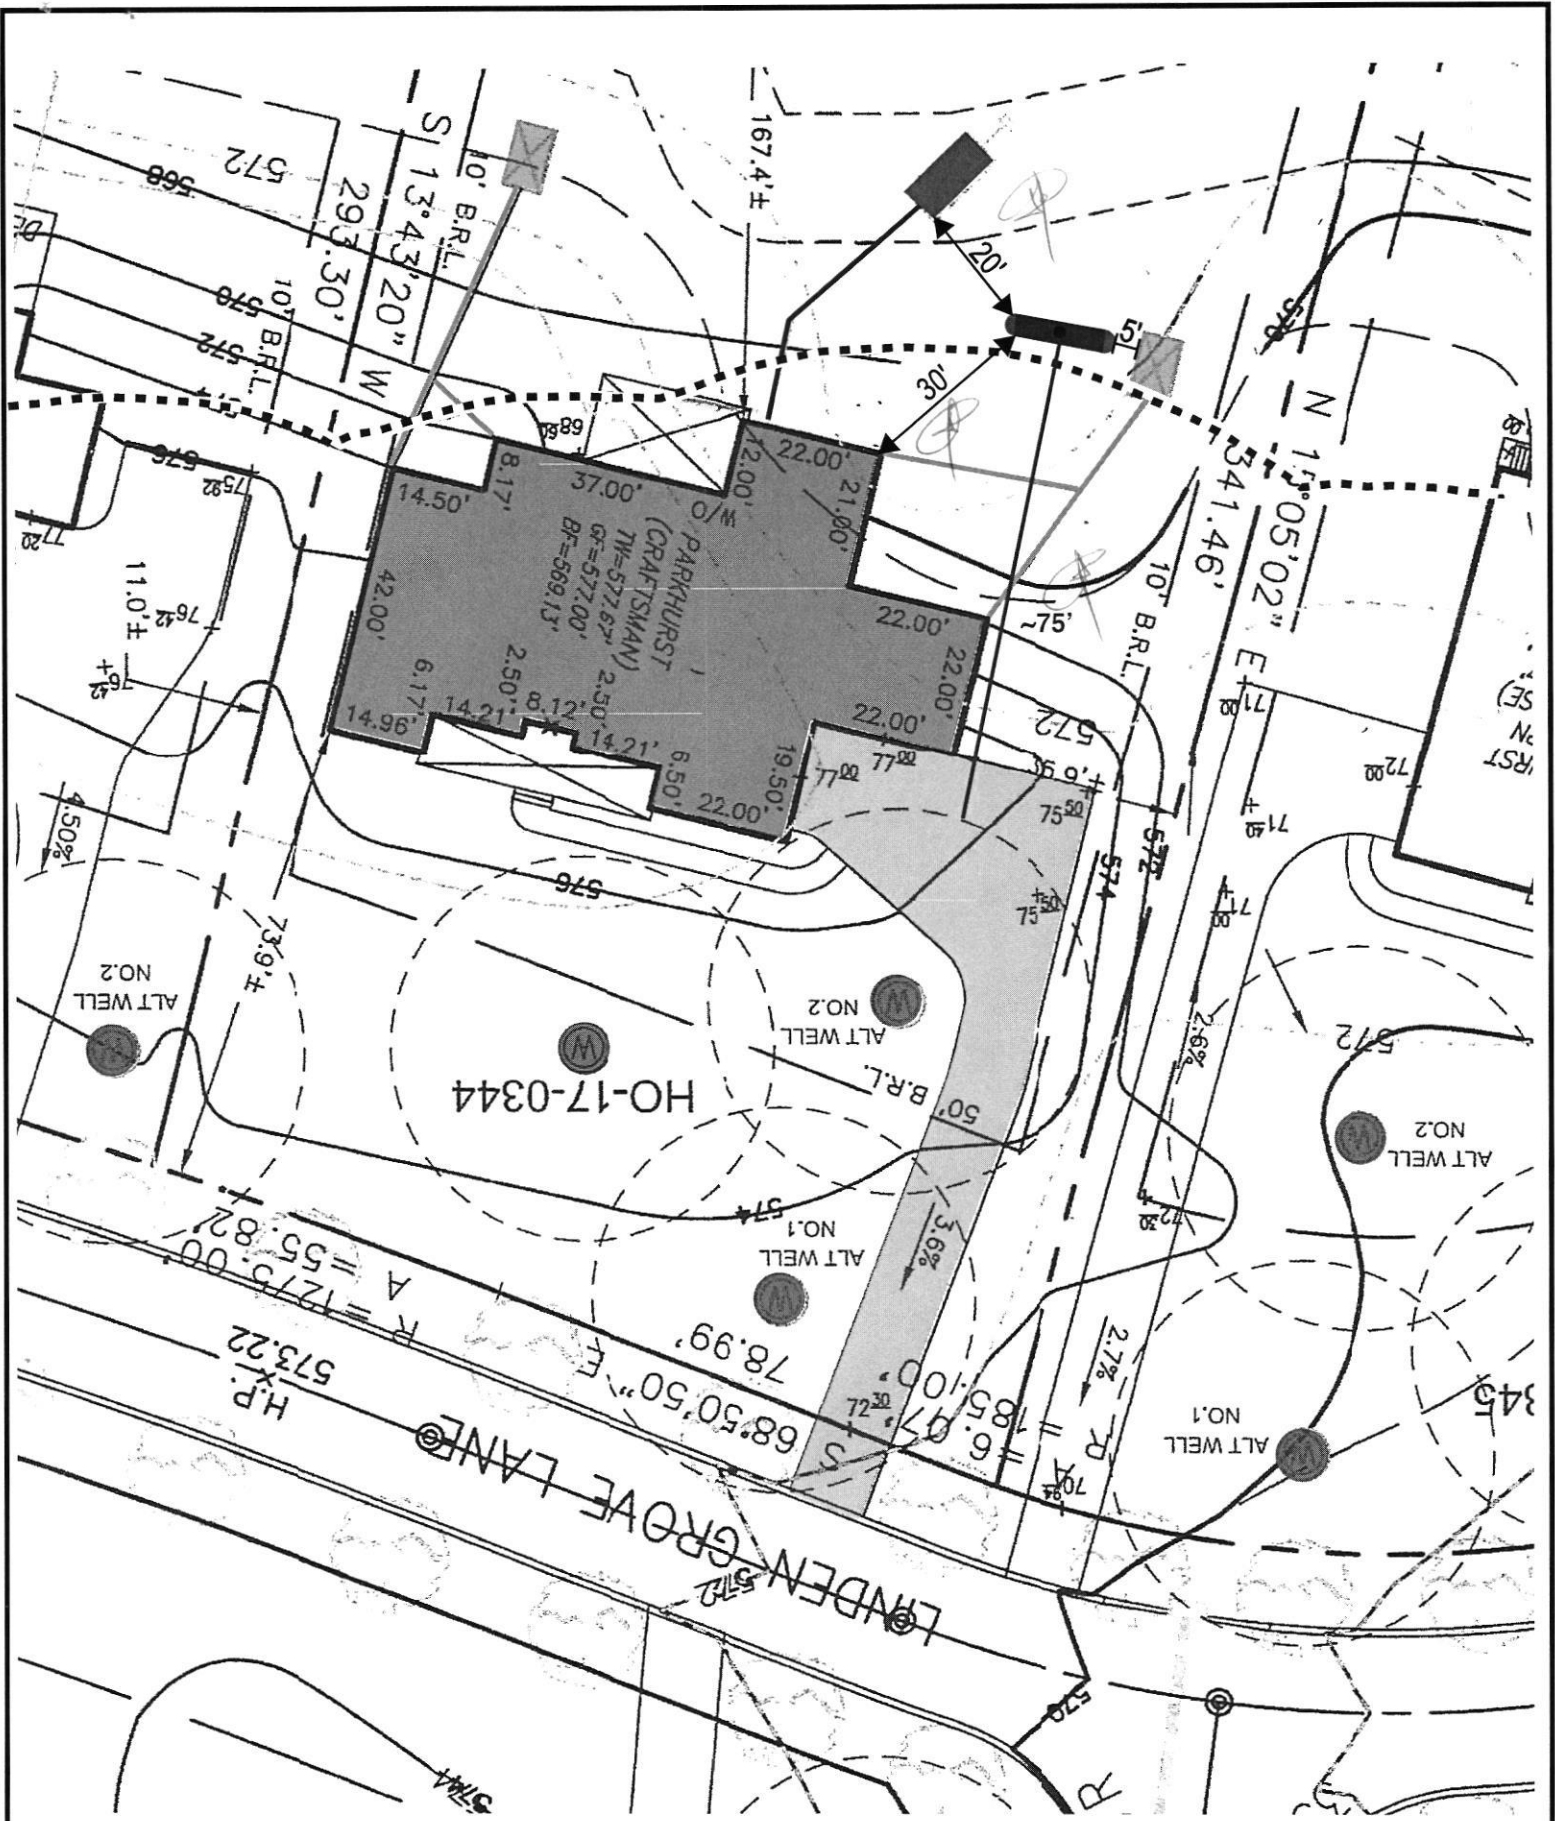



1,000-GALLON UNDERGROUND TANK LOCATION PLAN
 15621 LINDEN GROVE LANE, WOODBINE, MD 21797

SCALE 1" = 30'

POIST GAS COMPANY ~ 360 MAIN ST., LAUREL, MD 20707 ~ (301) 725-3232 ~ WWW.POISTGAS.COM

TRINITY INDUSTRIES, INC.

Underground Vessel

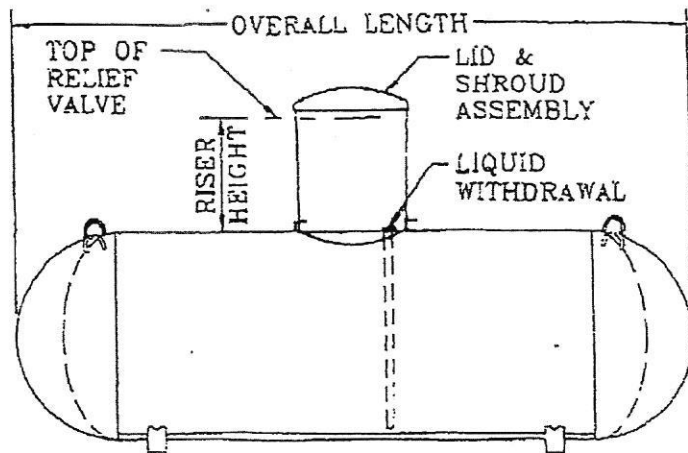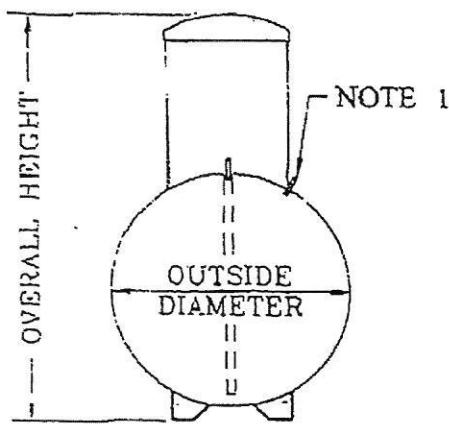

General Specifications

Conforms to the latest edition and addenda of the ASME, Section VIII, div.1 code for Pressure Vessels. Complies with NFPA 58 and is listed by Underwriters Laboratories, Inc.

Rated at 250 psig from -20°F. to 125°F. All tanks may be evacuated to a full (14.7 psi) vacuum.

Vessel Finish: Coated with epoxy red powder.

Applicable federal, state or local regulations may contain specific requirements for protective coatings and cathodic protection. The purchaser and installer are responsible for compliance with such federal, state or local regulations.

All vessel dimensions are approximate

WATER CAPACITY	OUTSIDE DIAMETER	HEAD TYPE	OVERALL LENGTH	OVERALL HEIGHT		WEIGHT	QUANTITY IN FULL LOAD
				Riser Height			
				14"	28"		
120 wg 454.2 L	24" 609.6 mm	Ellip	5' - 5 7/8" 1671.6 mm	3' - 9 7/8" 1165.2 mm	4' - 8 3/8" 1431.9 mm	252 lbs. 114.3 kg	63
250 wg 946.3 L	31.5" 800.1 mm	Hemi	7' - 2 1/2" 2197.1 mm	4' - 5 3/8" 1355.7 mm	5' - 3 3/8" 1609.7 mm	472 lbs. 214.1 kg	42
320 wg 1211.2 L	31.5" 800.1 mm	Hemi	8' - 11 3/4" 2736.9 mm	4' - 5 3/8" 1355.7 mm	5' - 3 3/8" 1609.7 mm	588 lbs. 266.7 kg	35
500 wg 1892.5 L	37.42" 950.5 mm	Hemi	9' - 10" 2997.2 mm	4' - 11 3/8" 1506.6 mm	5' - 9 7/8" 1773.2 mm	921 lbs. 417.8 kg	25
1000 wg 3785.0 L	40.96" 1040.4 mm	Hemi	15' - 10 7/8" 4846.6 mm	5' - 2 7/8" 1597.0 mm	6' - 1 3/8" 1863.7 mm	1731 lbs. 785.2 kg	15
2000 wg 3785.6 L	46.614" 1183.9 mm	Ellip	23' - 9 3/8" 7248.5 mm	5' - 8 13/16" 1747.8 mm	6' - 7 5/16" 2014.5 mm	3685 lbs. 1671.4 kg	8