

PERMIT NUMBER: B 21009518

DATE ACCEPTED: OILP 2021 OCT 28 AM 10:32



# RESIDENTIAL BUILDING PERMIT APPLICATION

HOWARD COUNTY DEPARTMENT OF INSPECTIONS, LICENSES, AND PERMITS  
3430 COURT HOUSE DRIVE, ELLICOTT CITY, MD 21043 PHONE: (410) 313-2455 OPTION #4  
www.howardcountymd.gov

### BUILDING SITE ADDRESS REQUIRED

Street Address: 10713 Hunting Lane		Unit:
City: Columbia	State: MD	Zip Code: 21044
Subdivision/Village/Complex Name:		SDP/WP/BA #:
Lot: 47	Tax Map: 0041	Parcel: 0252
Grading Permit #:		

### DESCRIPTION OF WORK REQUIRED

Existing Use: SFD	Proposed Use: SFD w/Carport & Pool	Estimated Cost: \$ 15,000.00
Trade Work to Be Completed (Separate Permits Required): <input type="checkbox"/> Mechanical (HVACR) <input type="checkbox"/> Electrical <input type="checkbox"/> Plumbing <input checked="" type="checkbox"/> None (Constructing a Carport from Porch & All Siding with 14'x17' and a Concrete Pad without both Porches sit on with Piers for Support. Note: Pool driveway permit has been submitted and separate permit App.		

### PROPERTY OWNER INFORMATION REQUIRED

Owner(s) Name(s) (As it appears on tax records): Lester Keith Anthony Jr	Primary Residence: <input checked="" type="checkbox"/> Yes <input type="checkbox"/> No
Owner's Street Address: 10713 Hunting Lane	
City: Columbia	State: MD
Phone: 201-395-3795	Email: KStphenia30@gmail.com
Zip Code: 21044	

### APPLICANT NAME REQUIRED - INDIVIDUAL WHO SIGNS THIS APPLICATION

Business Name: Same as Owner	Contact Name:
Street Address:	
City:	State:
Phone:	Email:
Zip Code:	

### CONTRACTOR INFORMATION REQUIRED

Business Name: Same as Owner	License #:
Licensee's Name:	
Street Address:	
City:	State:
Phone:	Email:
Zip Code:	

### ARCHITECT/ENGINEER INFORMATION INDIVIDUAL WHO SIGNED PLANS, IF APPLICABLE

Business Name:	Name:
Street Address:	
City:	State:
Phone:	Email:
Zip Code:	

### BUILDING CHARACTERISTICS REQUIRED

Primary Structure: <input checked="" type="checkbox"/> SF Dwelling <input type="checkbox"/> SF Townhouse <input type="checkbox"/> SF Duplex <input type="checkbox"/> Mobile Home <input type="checkbox"/> Multi-Family Dwelling (MF*)	Condo: <input type="checkbox"/> Yes <input type="checkbox"/> No
Utilities: <input checked="" type="checkbox"/> Electric <input checked="" type="checkbox"/> Gas <input type="checkbox"/> Water Supply: <input type="checkbox"/> Public <input checked="" type="checkbox"/> Private (Well)	Sewage Disposal: <input type="checkbox"/> Public <input checked="" type="checkbox"/> Private (Septic)
Heating System: <input checked="" type="checkbox"/> Electric <input type="checkbox"/> Natural Gas <input type="checkbox"/> Propane <input type="checkbox"/> Other:	Roadside Tree Project: <input checked="" type="checkbox"/> No <input type="checkbox"/> Yes: #
Sprinkler System: <input type="checkbox"/> NFPA 13 <input type="checkbox"/> NFPA 13R <input type="checkbox"/> NFPA 13D <input checked="" type="checkbox"/> None	Fire Alarm System: <input type="checkbox"/> Yes <input type="checkbox"/> No <input type="checkbox"/> Voice Evac

### ADDITIONAL RESIDENTIAL INFORMATION (PLEASE SELECT/COMPLETE ALL THAT APPLY)

Model Name & Options:					
# of Bedrooms (SF):	# of efficiency units (MF*):	# of 1 BR (MF*):	# of 2 BR (MF*):	# of 3 BR (MF*):	
# Rooms:	# Full Baths:	# Half Baths:	# Fireplaces:		
Garage/Carport Info: <input type="checkbox"/> Attached Garage <input type="checkbox"/> Detached Garage <input type="checkbox"/> Integral Garage <input type="checkbox"/> Carport <input type="checkbox"/> None					
Basement/Foundation Info: <input type="checkbox"/> Slab on Grade <input type="checkbox"/> Post & Pier <input type="checkbox"/> Unfinished Basement <input type="checkbox"/> Finished Basement: <input type="checkbox"/> Full or <input type="checkbox"/> Partial					
1 <sup>st</sup> Fl Width:	1 <sup>st</sup> Fl Depth:	2 <sup>nd</sup> Fl Width:	2 <sup>nd</sup> Fl Depth:	Bsmt Width:	Bsmt Depth:
Energy Method: <input type="checkbox"/> Prescriptive <input type="checkbox"/> Performance <input type="checkbox"/> UA Alternative <input type="checkbox"/> ERI		Gross Area: sq ft		Occupiable Area: sq ft	

### AGREEMENT/ DISCALIMER REQUIRED

THE UNDERSIGNED HEREBY CERTIFIES AND AGREES AS FOLLOWS: (1) THAT HE/SHE IS AUTHORIZED TO MAKE THIS APPLICATION; (2) THAT THE INFORMATION IS CORRECT; (3) THAT HE/SHE WILL COMPLY WITH ALL REGULATIONS OF HOWARD COUNTY WHICH ARE APPLICABLE THERETO; (4) THAT HE/SHE WILL PERFORM NO WORK ON THE ABOVE REFERENCED PROPERTY NOT SPECIFICALLY DESCRIBED IN THIS APPLICATION; (5) THAT HE/SHE GRANTS COUNTY OFFICIALS THE RIGHT TO ENTER ON TO THIS PROPERTY FOR THE PURPOSE OF INSPECTING THE WORK PERMITTED AND POSTING NOTICES.

APPLICANT'S ORIGINAL SIGNATURE: *[Signature]* DATE SIGNED: 10/28/21



### FOR OFFICE USE ONLY

CHECKS PAYABLE TO: DIRECTOR OF FINANCE OF HOWARD COUNTY

AGENCIES REQUIRED/APPROVALS:					
<input type="checkbox"/> PR	<input checked="" type="checkbox"/> DPZ	<input checked="" type="checkbox"/> DED	<input checked="" type="checkbox"/> Health 11/2/21	<input type="checkbox"/> SHA	<input type="checkbox"/> CID
SUBMITTAL FEES: \$25.00		PAYMENT: CASH		ACCEPTED BY: AKH	

**NOTES**

- 1) This plat is of benefit to a consumer only insofar as it is required by a lender or title insurance company or its agent in connection with contemplated transfer, financing or refinancing.
- 2) This plat is not to be relied upon for the establishment or location of fences, garages, buildings, or other existing or future improvements.
- 3) This plat does not provide for the accurate identification of property boundary lines, but such identification may not be required for the transfer of title or securing financing or refinancing.
- 4) The level of accuracy of apparent setback distances is within 3 feet +/-.
- 5) No title research furnished to or done by this office.
- 6) The subject property falls in flood zone "C" as shown on the flood hazard boundary map 24004400388 dated 12/04/86.
- 7) This plat shows the principal structure and significant structures (close to the apparent property lines) as required by Maryland law. However, additional internal structures may not be shown.
- 8) The licensee either personally prepared this drawing or was in responsible charge over its preparation and the surveying work reflected in it, all in compliance with requirements set forth in Regulation .12 of Chapter 06 Minimum Standards of Practice.
- 9) The source of data, bearings, and/or coordinates used on this drawing are based on the record plat or deed referenced: PB 7/69

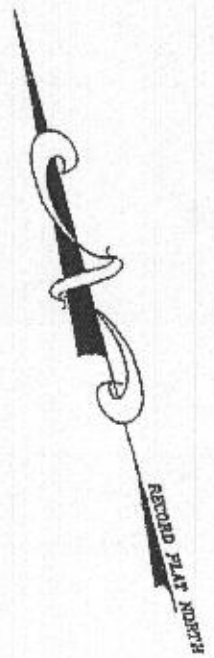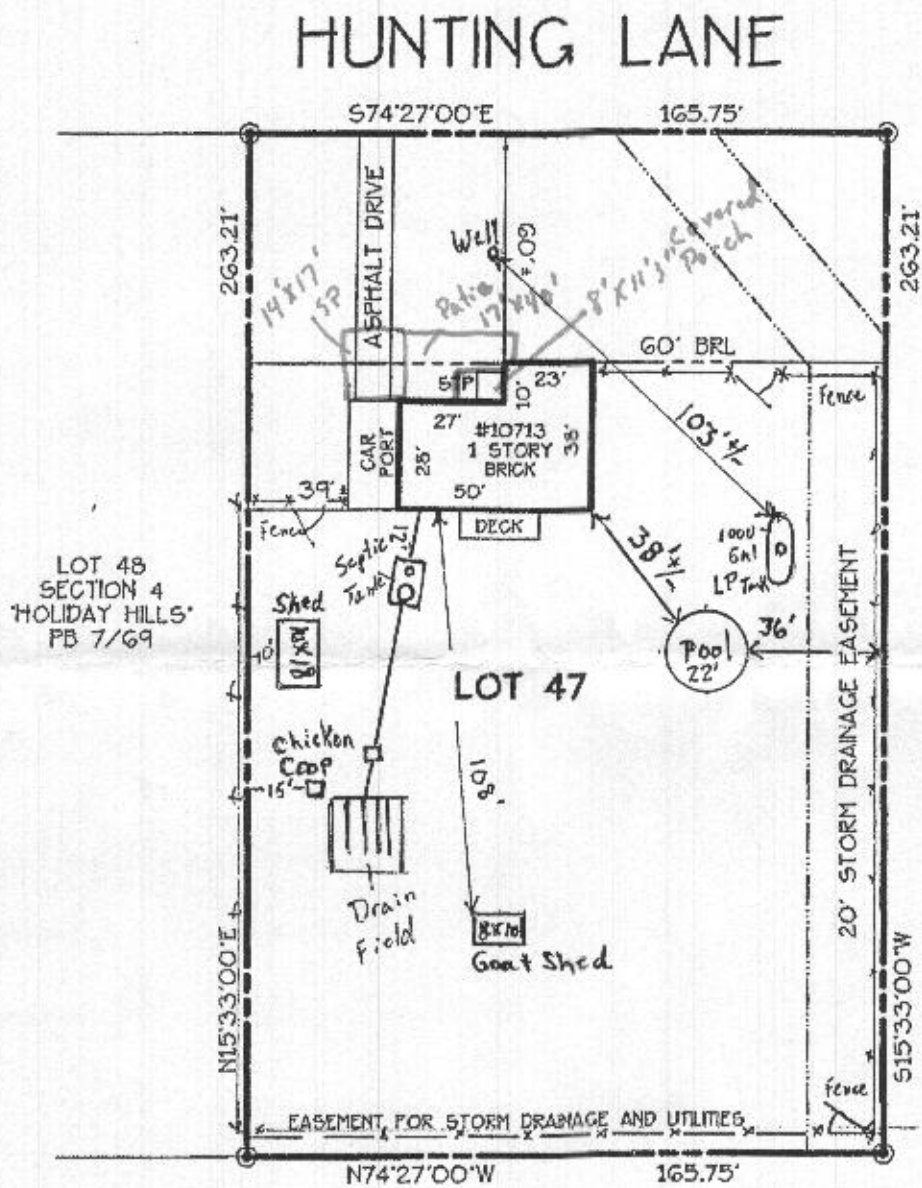

I hereby certify that the improvements shown hereon, to the best of my professional knowledge and ability, have been located by a transit, tape or total-station survey.

*George A. Parrish IV*

GEORGE A. PARRISH IV PROP. LS #577 07/13/11  
 LICENSE EXPIRATION DATE 03/24/13

ATTENTION USER: SURVEY ORDER MUST BE ON FILE WITH ADVANCED SURVEYS BEFORE THIS DOCUMENT CAN BE USED.

10713 HUNTING LANE PB 7/69  
 LOCATION DRAWING LOT 47 SECTION 4

**HOLIDAY HILLS**


5TH ELECTION DISTRICT  
 HOWARD COUNTY, MARYLAND  
 SCALE: 1" = 50' JULY 2011


PROJECT #30969  
 CAD FILENAME: HOLIDAYHILLS-54-L47.DWG  
 DRAWN BY: BTG CHECKED BY:



Established 1975  
 3140 West Ward Road Suite 103  
 Dunkirk, Maryland 20754  
 Ph: 410-286-9712 Fax: 410-286-9716  
 Toll-Free: 1-800-235-4681

# HUNTING LANE

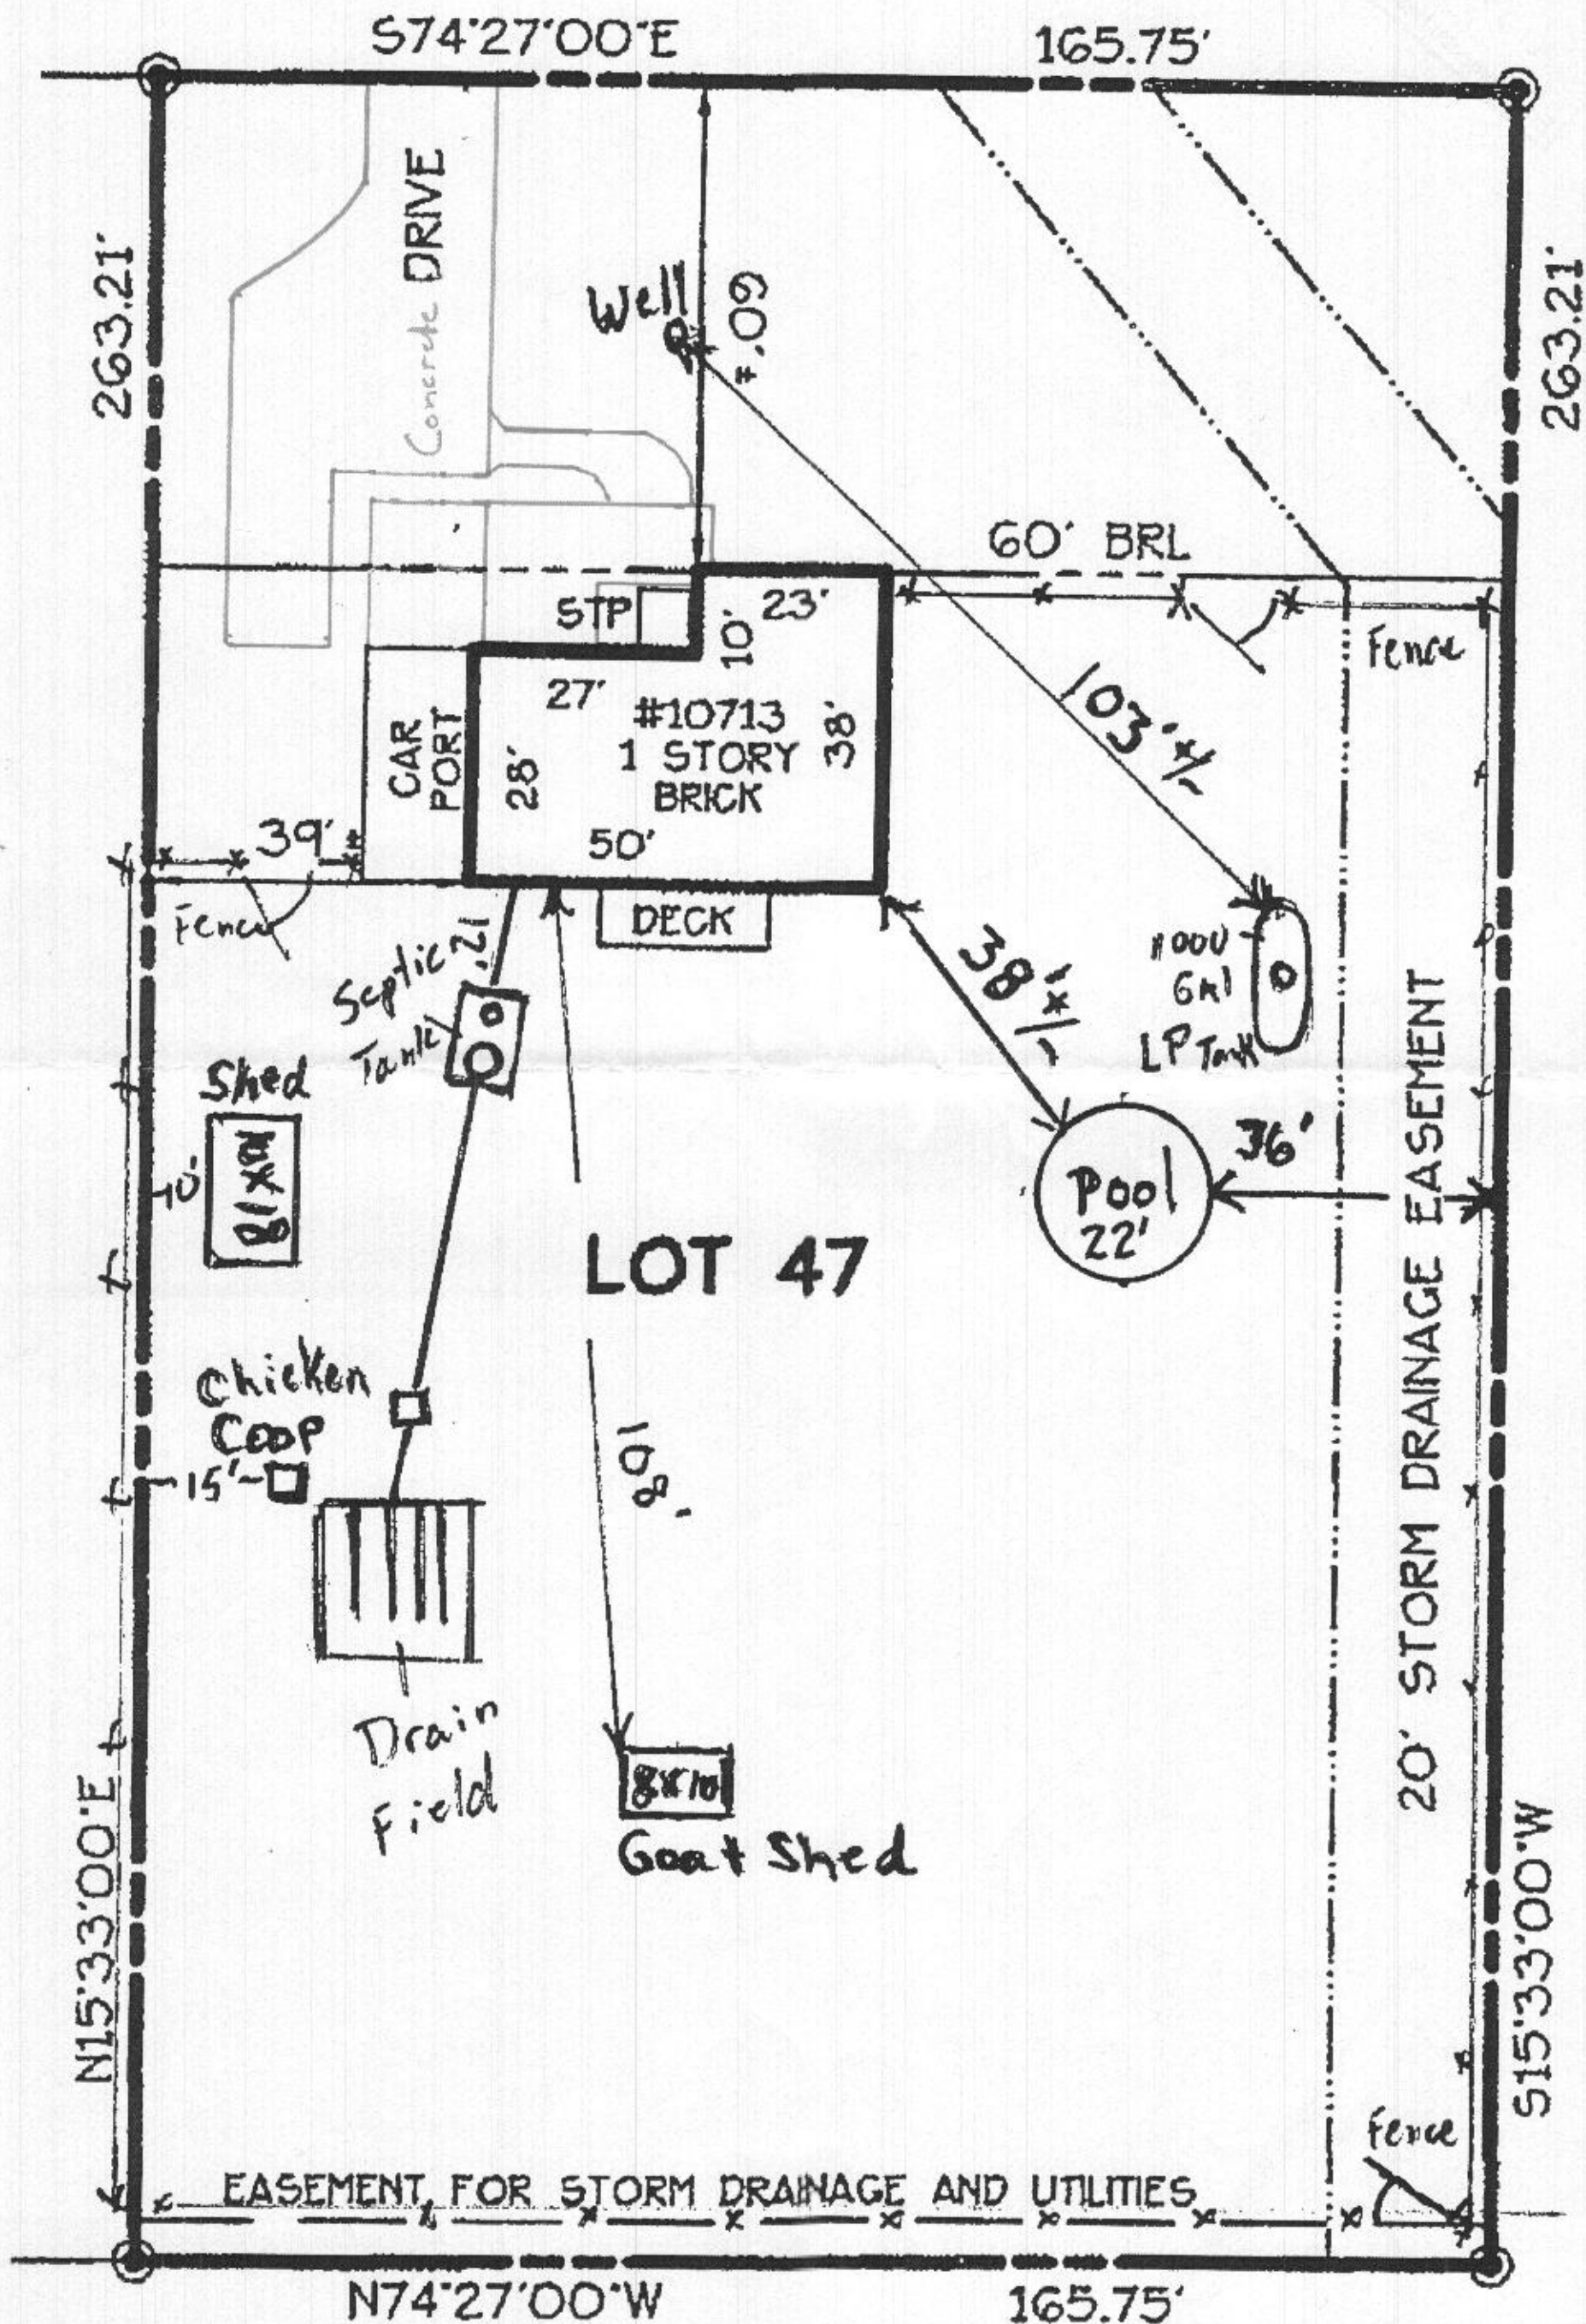

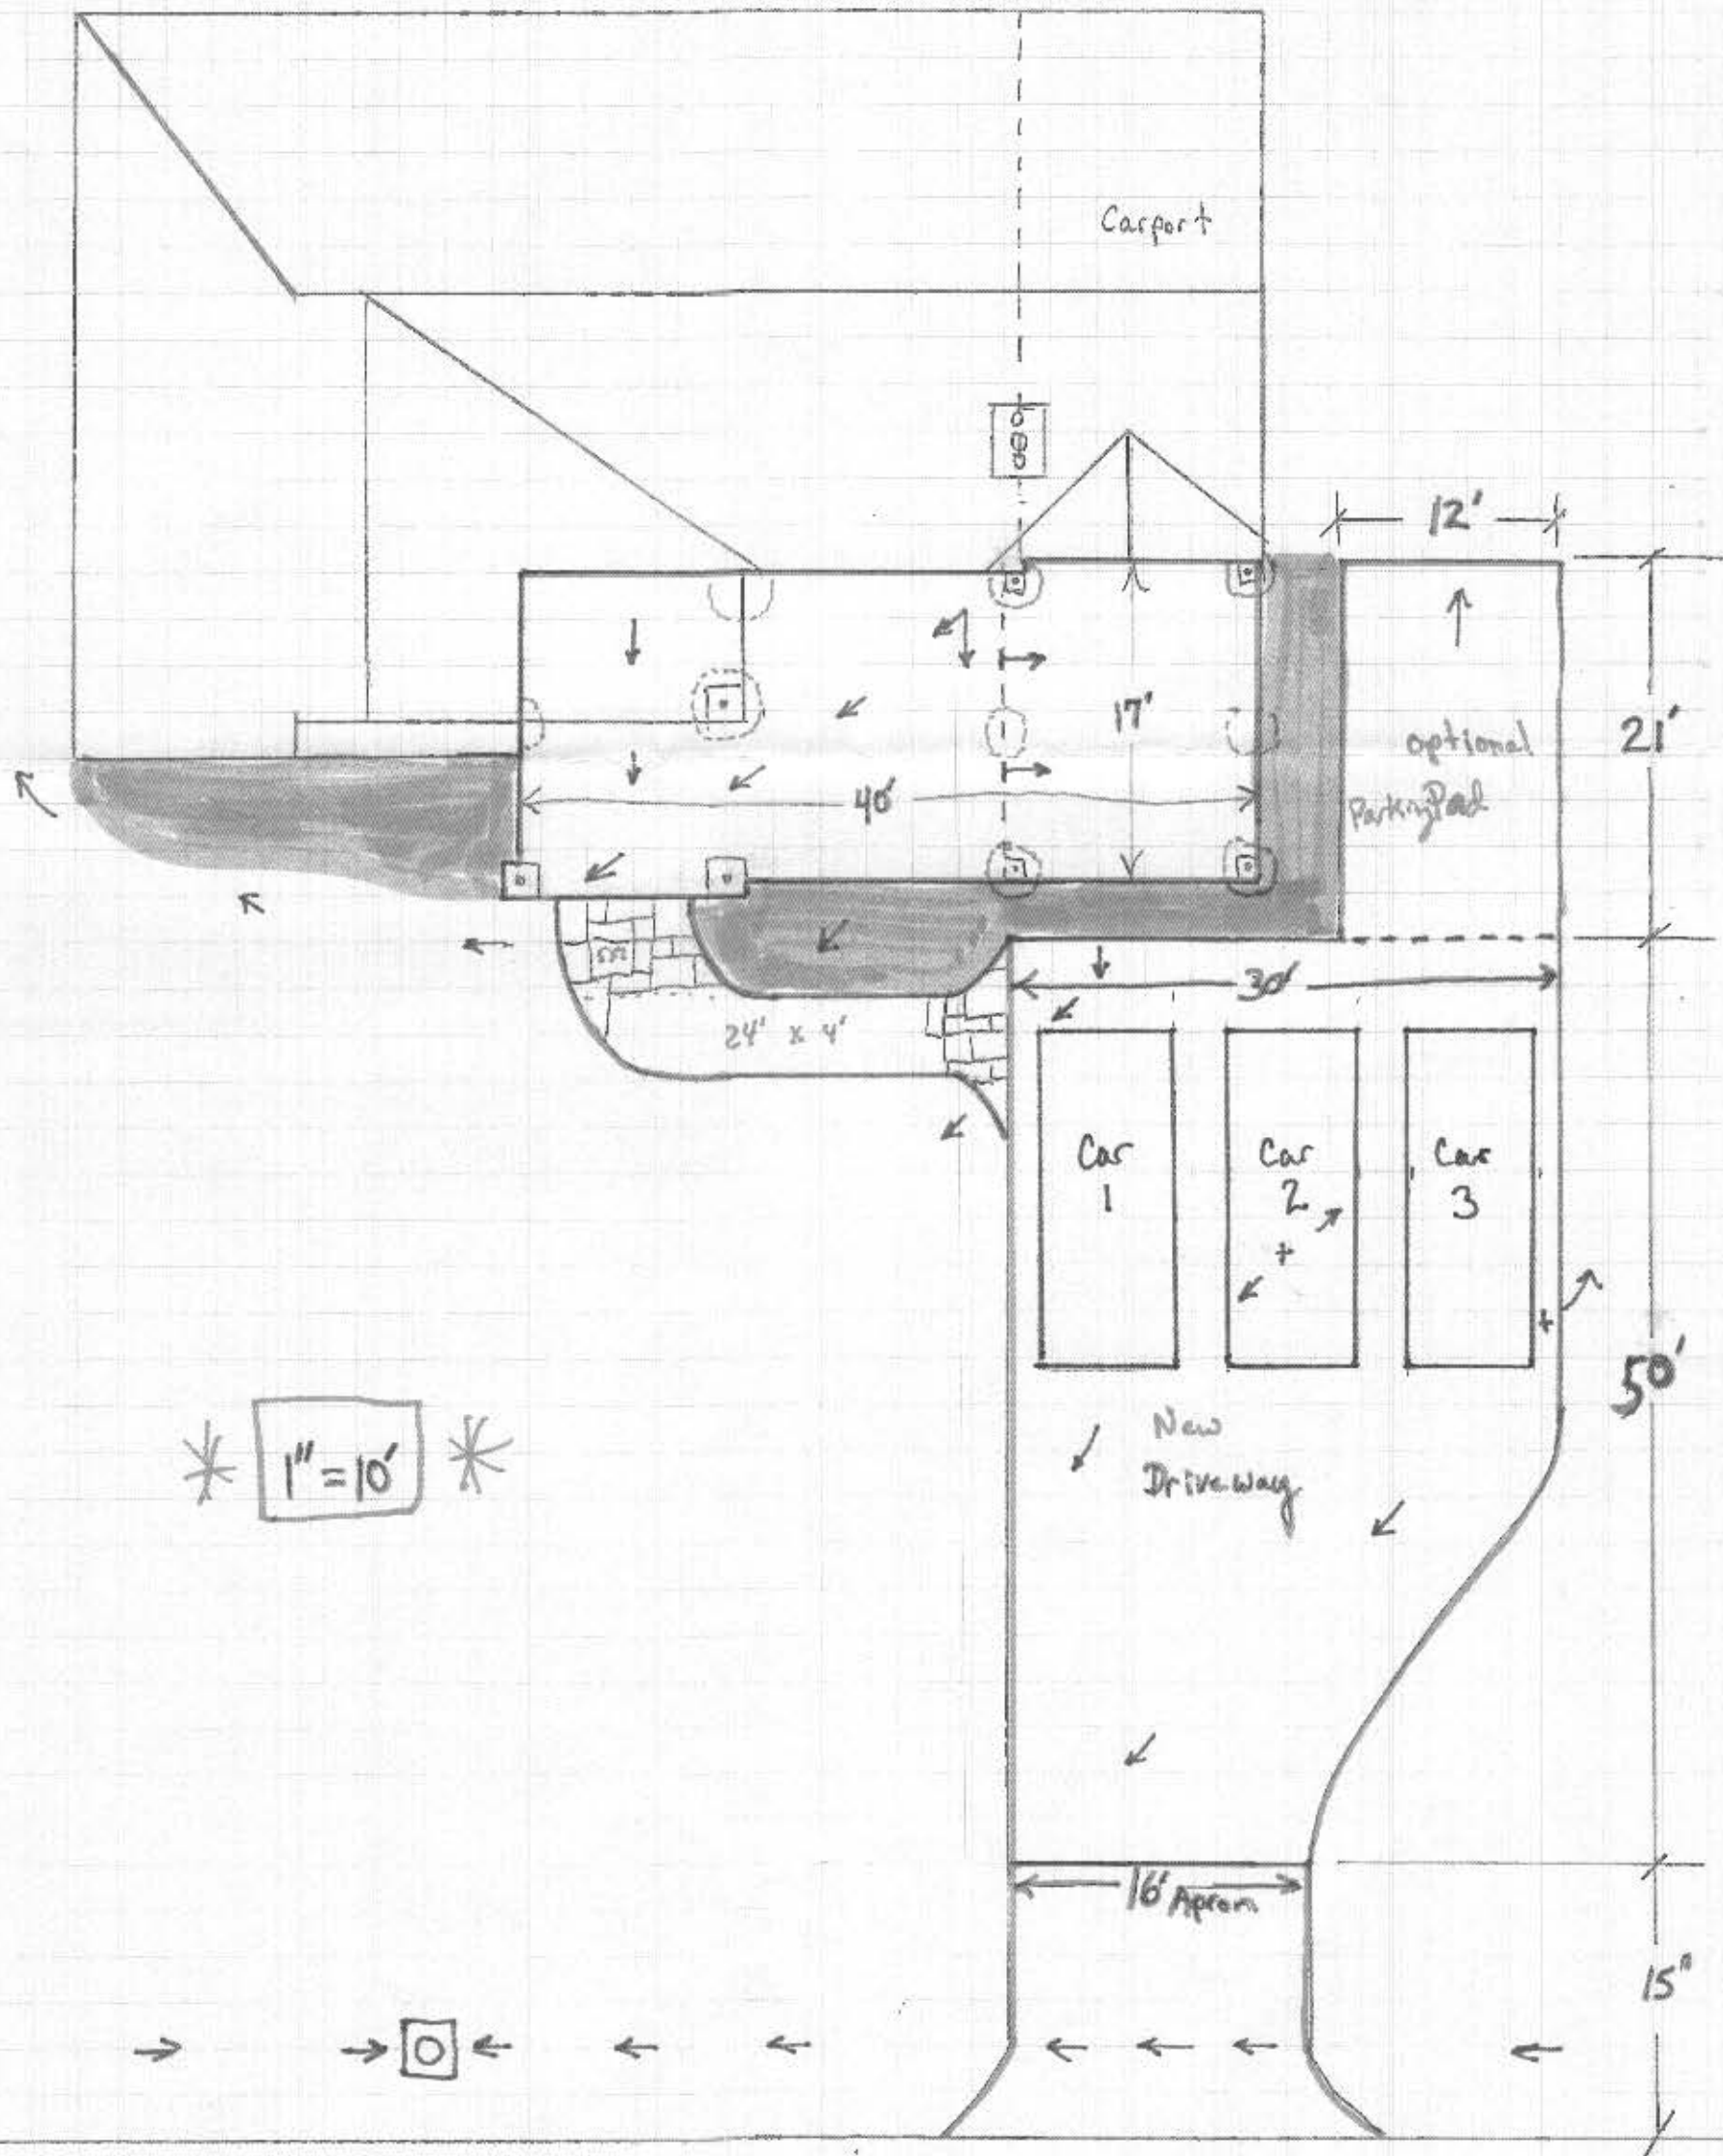

10713 Hunting Lane

