



Fill out in triplicate.  
Make \$15.00 check payable to  
Howard County Health Dept. - Sanitation

Boundary plot must be submitted signed by [unclear]

# APPLICATION

by [unclear]  
Engl. or  
Jard. Sur.

A 14783

SEWAGE DISPOSAL TESTING

P \_\_\_\_\_

## MARYLAND STATE DEPARTMENT OF HEALTH

HOWARD COUNTY Septic tank to be 1000 gallons ELLICOTT CITY

Dry Well at Wells to be 520 square feet DISTRICT Fifth

at Absorbent sidewalk and below the inlet pipe DATE 9-5-69

maximum depth of dry well to be 12 feet. Locate dry well  
192 feet from left side line and 10 feet from edge of woods.

TO: THE COUNTY HEALTH OFFICER  
ELLICOTT CITY, MARYLAND

I, HEREBY, APPLY FOR THE NECESSARY TESTS IN ORDER TO CONSTRUCT (OR RECONSTRUCT) A SEWAGE DISPOSAL SYSTEM.

PROPERTY OWNER Hugh B. Hill, Jr.

ADDRESS Linden Chapel Road, Dayton, Md. PHONE \_\_\_\_\_

PROPERTY LOCATION:

SUBDIVISION \_\_\_\_\_ LOT NO. Six

ROAD AND DESCRIPTION Linden Church Road. South on Route #32 from Route #40  
to left on Linden Church Road.

OCCUPANT \_\_\_\_\_ PHONE \_\_\_\_\_

PERSON TO CONSTRUCT SYSTEM \_\_\_\_\_

ADDRESS \_\_\_\_\_ PHONE \_\_\_\_\_

SIZE OF LOT Five Acres TYPE BLDG. Four NUMBER OF BEDROOMS \_\_\_\_\_

IF NOT SINGLE RESIDENCE DESCRIBE \_\_\_\_\_

SIGNATURE OF APPLICANT Guido Porreca Guido Porreca Maryland  
Greenwood Drive, Highland,  
286-3752

APPROVED BY James T. Wright FOR Dry Well DATE 9/10/69  
(KIND OF SYSTEM)

REJECTED BY \_\_\_\_\_ FOR \_\_\_\_\_ DATE \_\_\_\_\_  
(KIND OF SYSTEM)

HOLD PENDING FURTHER TESTS \_\_\_\_\_ DATE \_\_\_\_\_

REASONS FOR REJECTION OR HOLDING \_\_\_\_\_

# THIS IS NOT A PERMIT





Linden Chapel Road

577'00" E  
25'10"

Rec'd No 32

210'00" S  
518'00" W  
330'00"

72° 41' E  
567'10"

6

Woods

16,000' 83

N 25° 34' W

570'00"

527'7"

PLAT OF SURVEY  
FOR

HUGH B. F.

FIFTH ELECTION DISTRICT OF HANCOCK COUNTY  
CLARKSVILLE, MARYLAND

SCALE 1" = 100 FT

FEBRUARY 18 1895

*Claude M. Skiff*  
Claude M. Skiff, Surveyor

# APPLICATION

A 14783

SEWAGE DISPOSAL TESTING

P \_\_\_\_\_

*Recorded  
9/10/69  
9:30*

MARYLAND STATE DEPARTMENT OF HEALTH

HOWARD COUNTY *Septic tank to be 1000 gallons* ELLICOTT CITY

*Dry Well at Wells to be 520 square feet  
of absorbent sidewall area below the inlet pipe  
maximum depth of Dry Well to be 12 feet. Locate dry well  
192 feet from left side line and 10 feet from edge of woods.*

DISTRICT Fifth

DATE 9-5-69

TO: THE COUNTY HEALTH OFFICER  
ELLICOTT CITY, MARYLAND

I, HEREBY, APPLY FOR THE NECESSARY TESTS IN ORDER TO CONSTRUCT (OR RECONSTRUCT) A SEWAGE DISPOSAL SYSTEM.

PROPERTY OWNER Hugh B. Hill, Jr.

ADDRESS Linden Chapel Road, Layton, Md. PHONE \_\_\_\_\_

PROPERTY LOCATION:

SUBDIVISION \_\_\_\_\_ LOT NO. Six

ROAD AND DESCRIPTION Linden Church Road. South on Route #32 from Route #40  
to left on Linden Church Road.

OCCUPANT \_\_\_\_\_ PHONE \_\_\_\_\_

PERSON TO CONSTRUCT SYSTEM \_\_\_\_\_

ADDRESS \_\_\_\_\_ PHONE \_\_\_\_\_

SIZE OF LOT Five Acres TYPE BLDG. four NUMBER OF BEDROOMS \_\_\_\_\_

IF NOT SINGLE RESIDENCE DESCRIBE \_\_\_\_\_

SIGNATURE OF APPLICANT Guido Porreca *Guido Porreca*  
Guido Porreca Maryland  
Greenwood Drive, Highland  
286-3752


APPROVED BY James T. Wright FOR Dry Well DATE 9/10/69  
(KIND OF SYSTEM)

REJECTED BY \_\_\_\_\_ FOR \_\_\_\_\_ DATE \_\_\_\_\_  
(KIND OF SYSTEM)

HOLD PENDING FURTHER TESTS \_\_\_\_\_ DATE \_\_\_\_\_

REASONS FOR REJECTION OR HOLDING \_\_\_\_\_

# THIS IS NOT A PERMIT

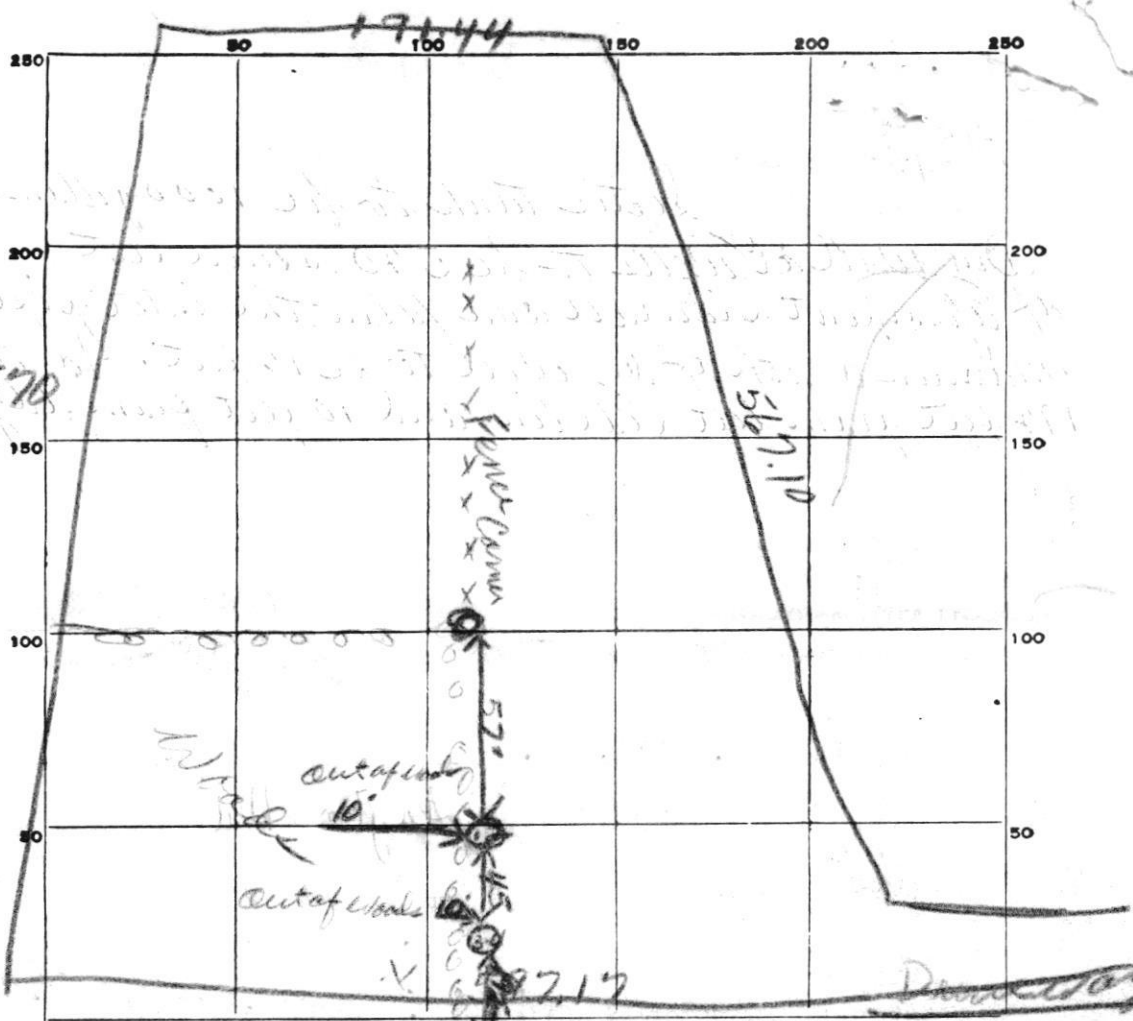

INDICATE NORTH. - NAME ADJOINING ROADWAY AS BASE LINE.

Linden Church Rd

DATE	TEST NO.	DEPTH	PRE-WET		TEST - 1" DROP		TIME
			START	STOP	START	STOP	
9/10/69	1	9'	9 56	10 03	10 03	10 10	7 in
	2	4'	9 59	10 30	10 30	10 30	30 in
	3	9'	10 19	10 25	10 25	10 30	11 in
	4	4'	10 21	10 34	10 34	11 00	30 in

48  
47 70  
13m AD

SOIL AUGER FINDING \_\_\_\_\_

TESTED BY \_\_\_\_\_

REMARKS \_\_\_\_\_