

PROPOSED
KERGER ROAD
AREA ADDITION
TO THE
METROPOLITAN
DISTRICT



ROY F. EMERSON
& FRED W. ADAMS
442/301
102 A.
P. 231

WALTER H. DENNIS
180/491
P. 226

ELIZ. K. DROST & HUSB.
WM. C. KUHN & WIFE
30.00A.
P. 228

CARROLL F. DOYLE
221/86
P. 229

ERNEST WESSEL
307/243
P. 224

JOHN NICOLAI
265/430
P. 223

JOHN H. NICOLAI
182/288
56.58A.
P. 222

OSCAR S. BAKER
250/290
P. 209

RUDOLPH WEHLAND
175/594
11.02A.
P. 208

WM. G. MARTINI
229/132
P. 214

P. 212 213

P. 367

MURRAY SILVERMAN
& MARVIN R. LAMC
443/400
30.90A.
P. 215

W. MILES
2/274
P. 197

G. W. SPENCE
204/485
P. 195

P. 196
P. 198
P. 199
P. 200

P. 194

R.T. CURPHY
2/325
P. 193

P. 192

CO. 285/15

STANLEY ROTH
175/15
P. 202

P. 203
P. 204
P. 206
P. 207
P. 208

103

P. 507
ARTHUR H. COHON
164/223
P. 101

6.94A.
P. 545

JAMES P. LIBERTINI
415/136
26.00A.
P. 521

P. 523

T. J. O'NEILL
382/315
P. 520

P. 497
P. 451

P. 527
P. 524

P. 520

P. 521

P. 518

P. 519

P. 520

P. 521

P. 522

P. 523

P. 524

P. 525

P. 526

P. 527

PORTION OF
TAX MAP NO. 31

DEPT OF ASSESSMENT
CORRECTED BY
11/67

APPLICATION

A 21669

SEWAGE DISPOSAL TESTING

P _____

STATE OF MARYLAND - DEPARTMENT OF HEALTH AND MENTAL HYGIENE

HOWARD COUNTY HEALTH DEPARTMENT
ENVIRONMENTAL HEALTH SERVICES

DISTRICT 1st

P. O. BOX 476, ELLICOTT CITY, MARYLAND 21043
TELEPHONE: 465-5000, EXT. 356

DATE 6-16-75

6/26/75
9:30

10/23/75
1:30

more property (?)

TO: THE COUNTY HEALTH OFFICER
ELLICOTT CITY, MARYLAND

I, HEREBY, APPLY FOR THE NECESSARY TEST IN ORDER TO CONSTRUCT (OR RECONSTRUCT) A SEWAGE DISPOSAL SYSTEM.

PROPERTY OWNER JOHN H. NICOLAI

ADDRESS 5377 KERGER ROAD PHONE 465-8310

PROPERTY LOCATION:

SUBDIVISION _____ LOT NO. _____

ROAD AND DESCRIPTION END OF JAMES AVE. OFF KERGER RD

SIZE OF LOT FARM TYPE BLDG. 2 BED
NUMBER OF BEDROOMS

IF NOT SINGLE RESIDENCE DESCRIBE _____

THE SYSTEM INSTALLED UNDER THIS APPLICATION IS ACCEPTABLE ONLY UNTIL PUBLIC FACILITIES BECOME AVAILABLE.

SIGNATURE OF APPLICANT John H. Nicolai

APPROVED BY _____ FOR _____ DATE _____
(KIND OF SYSTEM)

REJECTED BY Robert Tom FOR any system DATE 10/27/75
(KIND OF SYSTEM)

HOLD PENDING FURTHER TESTS _____ DATE _____

REASONS FOR REJECTION OR HOLDING _____

THIS IS NOT A PERMIT

INDICATE NORTH. - NAME ADJOINING ROADWAY AS BASE LINE

DATE	TEST NO.	DEPTH	PRE-WET		TEST - 1" DROP		TIME
			START	STOP	START	STOP	

REMARKS _____

TYPE OF SOIL _____

TESTED BY _____ ALSO PRESENT: _____

APPLICATION

A 21669

P _____

SEWAGE DISPOSAL TESTING

STATE OF MARYLAND - DEPARTMENT OF HEALTH AND MENTAL HYGIENE

HOWARD COUNTY HEALTH DEPARTMENT
ENVIRONMENTAL HEALTH SERVICES

P. O. BOX 476, ELLICOTT CITY, MARYLAND 21043
TELEPHONE: 465-5000, EXT. 356

DISTRICT 1st

DATE 6-16-75

TO: THE COUNTY HEALTH OFFICER
ELLICOTT CITY, MARYLAND

I, HEREBY, APPLY FOR THE NECESSARY TEST IN ORDER TO CONSTRUCT (OR RECONSTRUCT) A SEWAGE DISPOSAL SYSTEM.

PROPERTY OWNER John H. Nicolai

ADDRESS 5377 KERGER RD, E.C. PHONE 465-8310

PROPERTY LOCATION:

SUBDIVISION _____ LOT NO. _____

ROAD AND DESCRIPTION JAMES AVE OFF KERGER - END OF
JAMES AVE.

SIZE OF LOT FARM TYPE BLDG. 2 BED.
NUMBER OF BEDROOMS

IF NOT SINGLE RESIDENCE DESCRIBE _____

THE SYSTEM INSTALLED UNDER THIS APPLICATION IS ACCEPTABLE ONLY UNTIL PUBLIC FACILITIES BECOME AVAILABLE.

SIGNATURE OF APPLICANT John H. Nicolai


APPROVED BY _____ FOR _____ DATE _____
(KIND OF SYSTEM)

REJECTED BY _____ FOR _____ DATE _____
(KIND OF SYSTEM)

HOLD PENDING FURTHER TESTS _____ DATE _____

REASONS FOR REJECTION OR HOLDING _____

THIS IS NOT A PERMIT

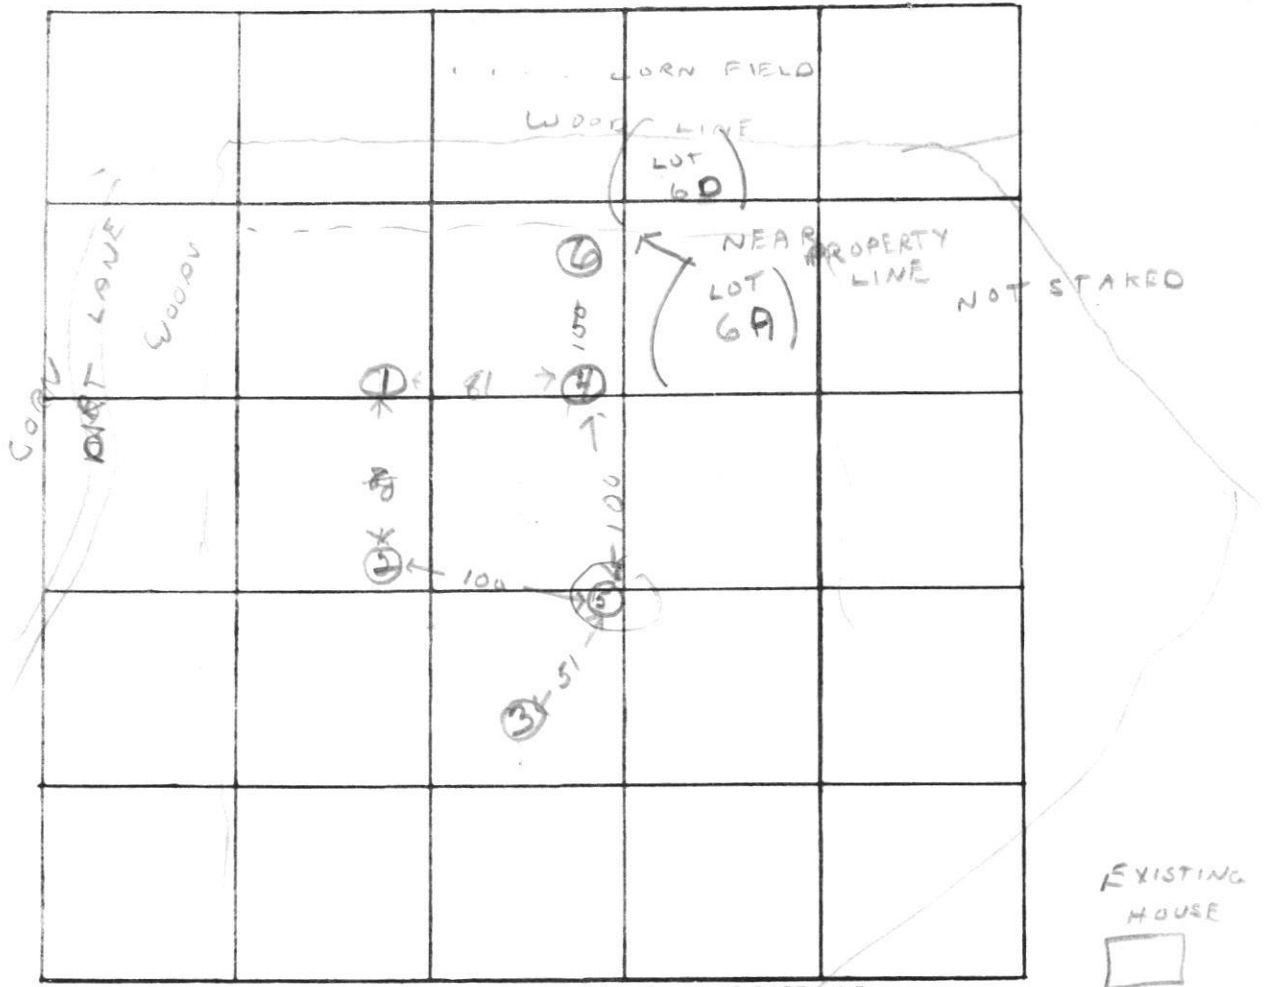

INDICATE NORTH - NAME ADJOINING ROADWAY AS BASE LINE

KEMGER RD

DATE	TEST NO.	DEPTH	PRE-WET		TEST - 1" DROP		TIME
			START	STOP	START	STOP	
10/23/75	1	4 1/2 ft	1 50	1 55	1 55	2 04	9 mi
	1A	9 ft	Water				
	2	4 1/2 ft	1 55	2 07	2 07	2 15	8 mi
	2A	8 ft	Water				
	3	4 1/2	1 59	2 07	2 07	2 32	25 mi
	4	4'	2 05	2 04	2 08	2 14	6 mi
	4A	8 1/2'	Water				
	5	3'	2 10	2 15	2 15	2 32	17 mi
	5A	7 1/4'	Water				
	6	4'	2 19	Overton			

REMARKS

✓ 6A 8' Water Overton
Very Clayist for 3 1/2 ft in 1, 2, 3, 4


TYPE OF SOIL

Appears very clayist but has sandy texture.

TESTED BY

R. Tunc

ALSO PRESENT:

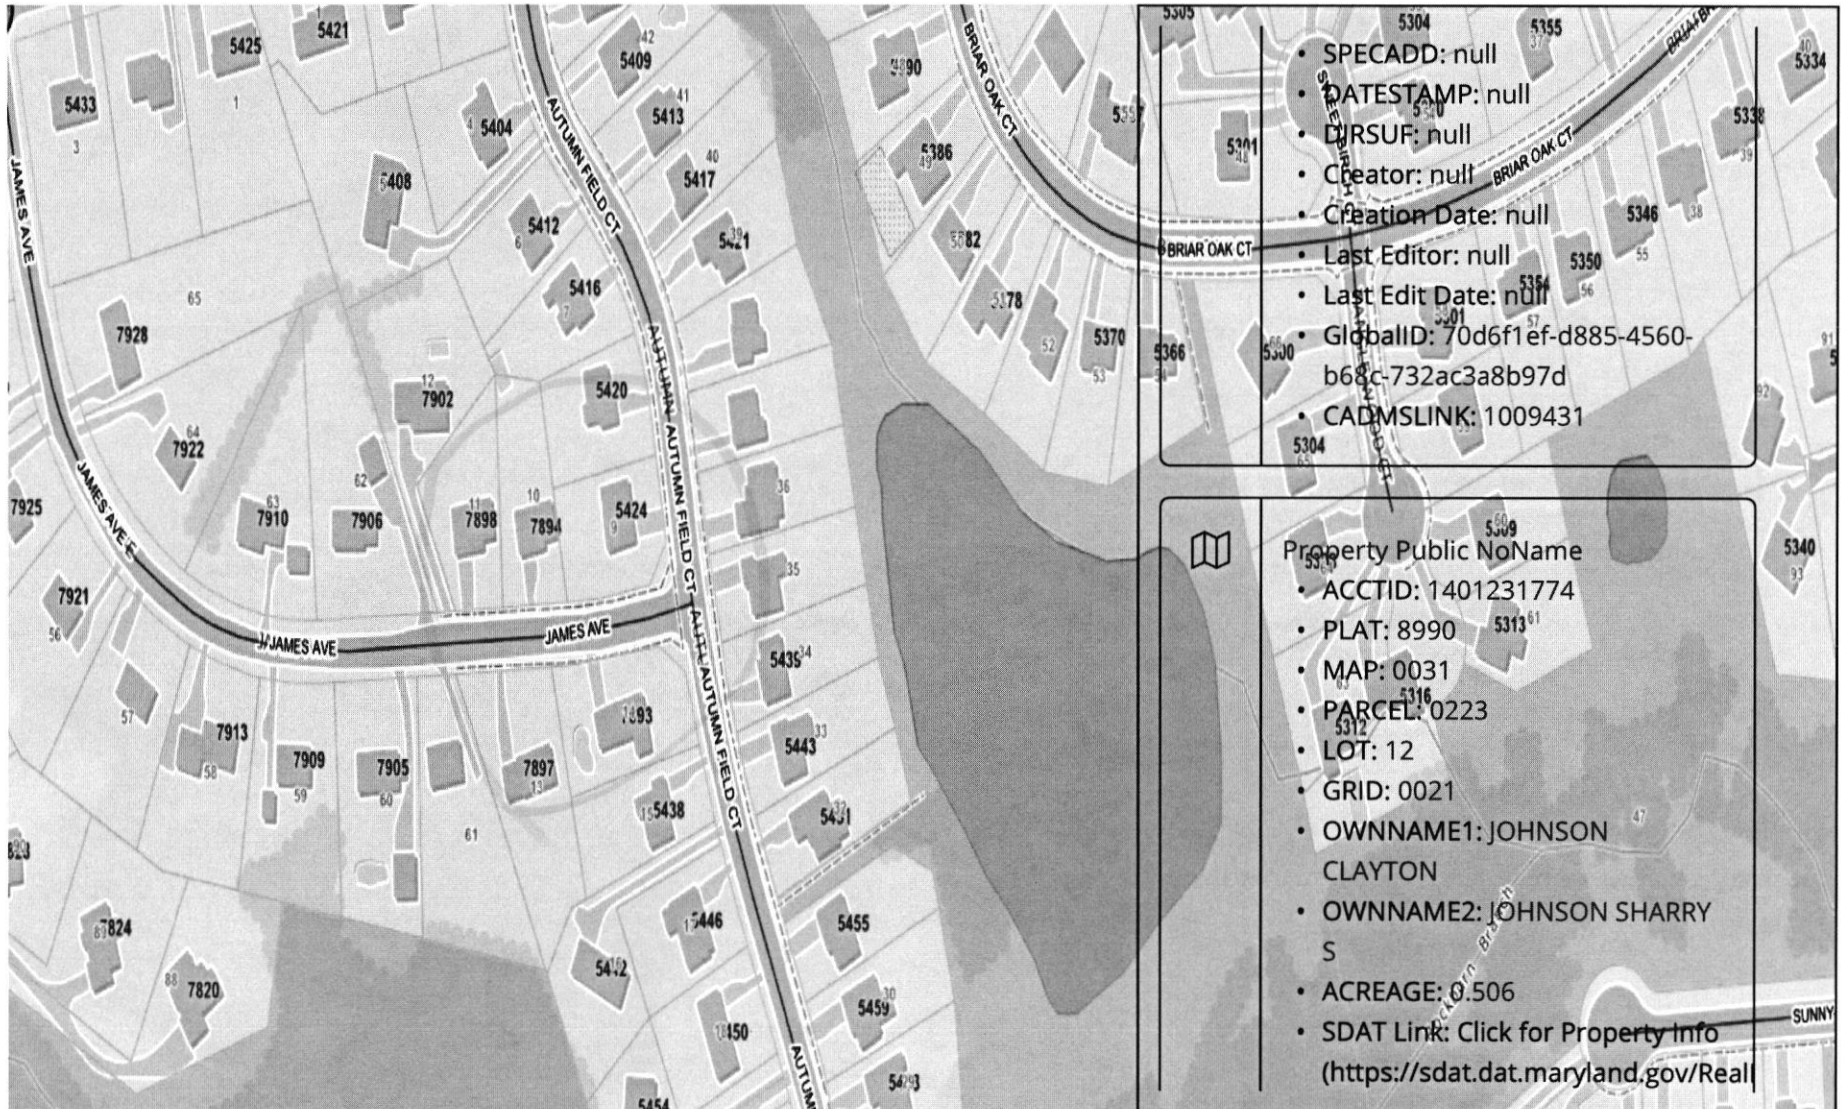

6726 MINK HOLLOW RD

- SPECADD: null
- DATESTAMP: null
- DIRSUF: null
- Creator: null
- Creation Date: null
- Last Editor: null
- Last Edit Date: null
- GlobalID: 70d6f1ef-d885-4560-b68c-732ac3a8b97d
- CADMSLINK: 1009431



Property Public NoName

- ACCTID: 1401231774
- PLAT: 8990
- MAP: 0031
- PARCEL: 0223
- LOT: 12
- GRID: 0021
- OWNNAME1: JOHNSON
CLAYTON
- OWNNAME2: JOHNSON SHARRY
S
- ACREAGE: 0.506
- SDAT Link: Click for Property Info
(<https://sdat.dat.maryland.gov/Real>)