

Record Detail * (This section is required.)

Permit Type	Permit Number	Opened Date
Building/Residential/Alteration/SFD	B22002181	06/01/2022
Description of Work		
SFD/In lower level change powder room into full bath with shower, toilet and vanity, 50 SQ FT*7,-5.22 ELECTRONIC AMENDMENT TO REMOVE SHOWER AND REPLACE WITH A CLOSET, KEEPING THE HALF BATH, A HALF BATH*		

[check spelling](#)

Address * (This section is required.)

Search Reset Clear Get Parcel & Owner

Street #	Street Name	Street Type
7045	LONG VIEW	RD
Unit Type	Unit #	X Coordinate
--Select--		-76.8806
		Y Coordinate
		39.17549
City	State	Zip Code
COLUMBIA	MD	21044
		Primary
		Yes

Parcel * (This section is required.)

Search Reset Clear Get Address & Owner

GIS ID *	Parcel	Parcel Area	Land Value	Improved Value	Exemption Value	Plan Area
850292	253	33018	246000	522800	276800	SOUTHE
Legal Description						
IMPSP/O LOT 6 .758 AR S[]7045 LONG VIEW RD[]RIVERSIDE ESTATE						

[check spelling](#)

Block	Lot	Census Tract	Council Dist	Inspection Dist	Supervisor Dist	Map #	DAP Zone
	6	605102	4				
Plan Area	State Tax Id	Subdivision Name					
	1405361451						
Section	Area	Tax Map					
		41					
Grid	Zoning District	ADC Map					
41-12	R-20	5052-K2					
SDP No.	Final Plan No.	WP File No.					
Record Plat No.	WS Contract No.	FDP No.	Primary				
			Yes				
Owner Occupied	Year Built	Historic District					
<input type="radio"/> Yes <input type="radio"/> No	1974	<input type="radio"/> Yes <input checked="" type="radio"/> No					
Historic District Registry No.	Stat Area	Flood Plain					
	5-16A	<input type="radio"/> Yes <input checked="" type="radio"/> No					
Building No							

Approved.
JL 7/18/22

Owner (This section is not required.)

Search Reset Clear

Name *
LIGGINS GLORIA C

Address Line 1
7045 LONG VIEW RD

Address Line 2

Address Line 3

Mail City
COLUMBIA

Mail State
MD

Mail Zip Code
21044

Phone
410-531-6575

Primary
Yes

E-mail

Cell Number
410-615-1400


Fax Number

Professionals (This section is not required.)

Search Reset Clear

License # *
08050039055

Business Name
PAUL DAVIS RESTORATION OF HOWARD & ANNE ARUNDEL COUNTIES

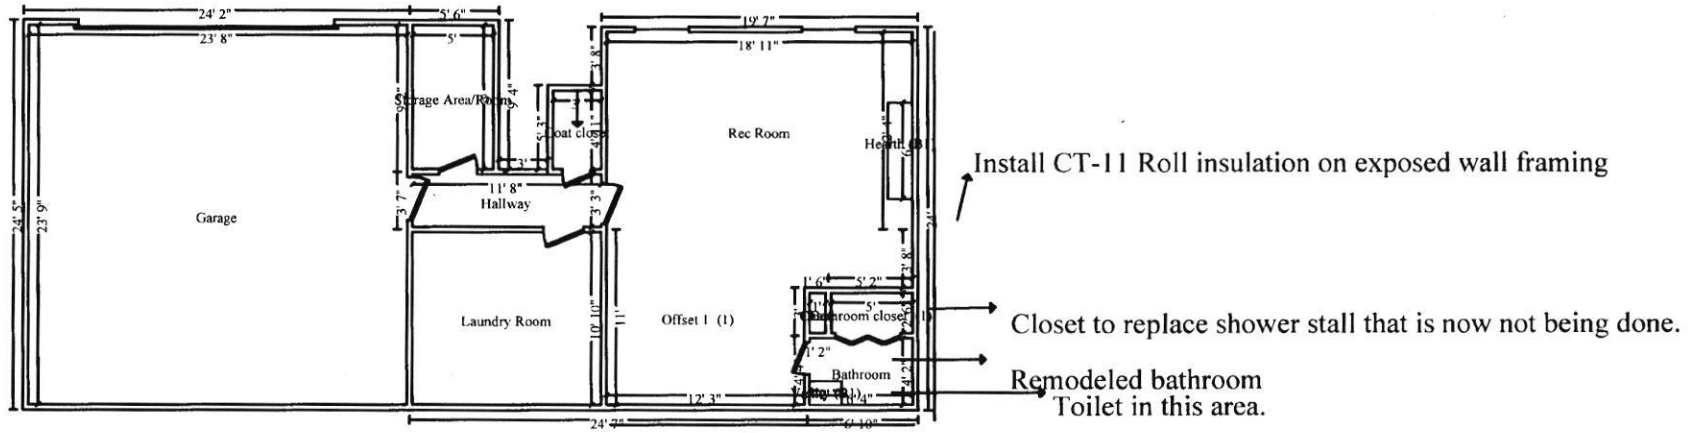

Floor plan for James Liggins
7045 Long View Rd
Columbia, Md. 21044
B22002181

Install CT-11 Roll insulation on exposed wall framing

Approved.

gsl 7/18/22



Lower Level

