

June 14
@ 9:30 am.

APPLICATION

A 31962

SEWAGE DISPOSAL TESTING

P _____

Retest

STATE OF MARYLAND - DEPARTMENT OF HEALTH AND MENTAL HYGIENE

HOWARD COUNTY HEALTH DEPARTMENT
ENVIRONMENTAL HEALTH SERVICES

DISTRICT Third

P. O. BOX 476, ELLICOTT CITY, MARYLAND 21043
TELEPHONE: 465-5000, EXT. 356

DATE June 2, 1982

TO: THE COUNTY HEALTH OFFICER
ELLICOTT CITY, MARYLAND

I, HEREBY, APPLY FOR THE NECESSARY TEST IN ORDER TO CONSTRUCT (OR RECONSTRUCT) A SEWAGE DISPOSAL SYSTEM.

PROPERTY OWNER Charles V. Lewis

ADDRESS 8590 Horseshoe Road PHONE 465-7777

Ellicott City, Maryland

PROPERTY LOCATION:

SUBDIVISION Lewis Property LOT NO. 4

ROAD AND DESCRIPTION North side of Maryland Route 99

SIZE OF LOT _____ TYPE BLDG. _____

NUMBER OF BEDROOMS _____

IF NOT SINGLE RESIDENCE DESCRIBE _____

THE SYSTEM INSTALLED UNDER THIS APPLICATION IS ACCEPTABLE ONLY UNTIL PUBLIC FACILITIES BECOME AVAILABLE.

SIGNATURE OF APPLICANT [Signature]

Agent

APPROVED BY _____ FOR _____ DATE _____
(KIND OF SYSTEM)

REJECTED BY _____ FOR _____ DATE _____
(KIND OF SYSTEM)


HOLD PENDING FURTHER TESTS _____ DATE _____

REASONS FOR REJECTION OR HOLDING _____

THIS IS NOT A PERMIT



Lot # changed
on original
of 7/29

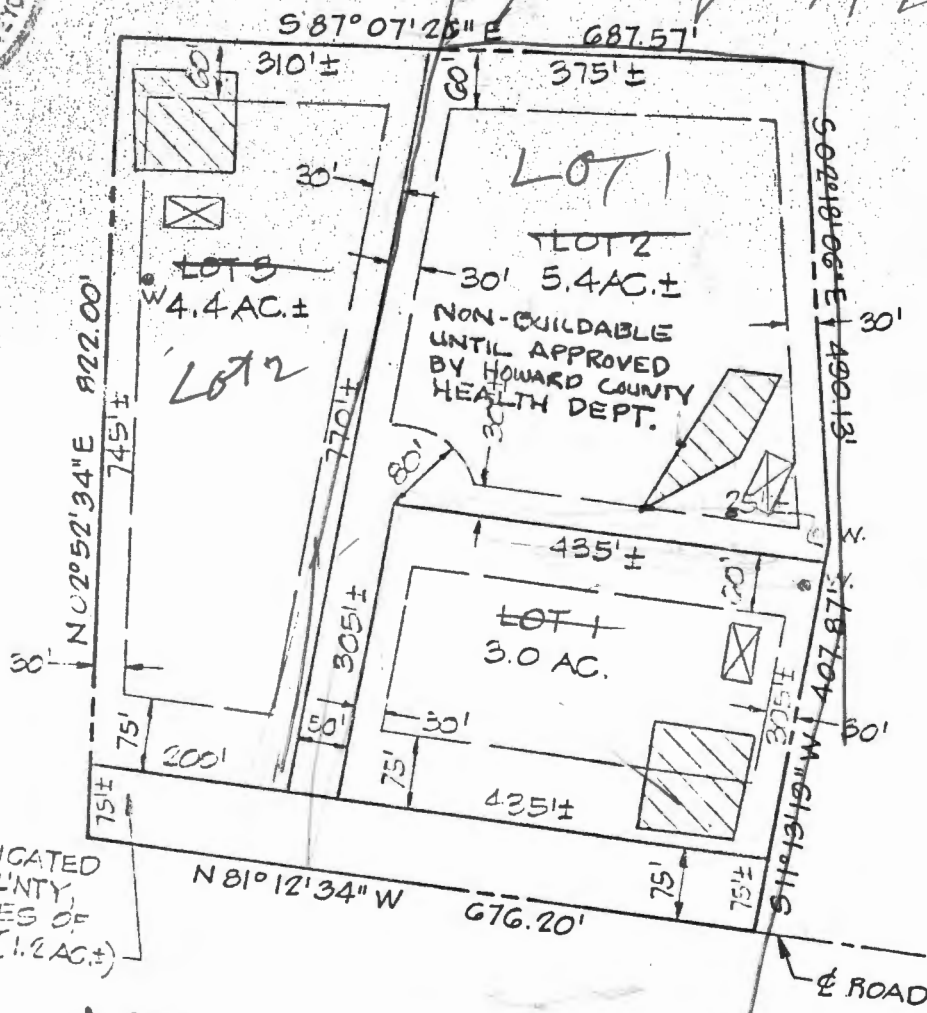

LAND TO BE DEDICATED
TO HOWARD COUNTY,
MD. FOR PURPOSES OF
A PUBLIC ROAD (1.2 AC ±)

MD. RTE. 99

NOTE: PERCOLATION TEST
WELLS OWN HEREON
HAVE BEEN FIELD LOCATED.

THE LOTS SHOWN HEREON COMPLY
WITH THE MINIMUM OWNERSHIP WIDTH
AND LOT AREAS AS REQUIRED BY THE
MARYLAND STATE DEPARTMENT OF
HEALTH AND MENTAL HYGIENE.

APPROVED: FOR PRIVATE WATER AND
PRIVATE SEWAGE SYSTEMS.
HOWARD COUNTY HEALTH DEPARTMENT

James P. Jones 10-25-78
COUNTY HEALTH OFFICER DATE

GENERAL NOTES

1. TOTAL NO. OF LOTS : 3
2. TOTAL AREA OF LOTS : 12.4 AC ±
3. TOTAL AREA OF ROAD DEDICATION : 1.2 AC ±
4. TOTAL AREA OF SITE : 13.99 AC ±
5. TAX MAP: 10 PARCEL: 254

TITLE PERCOLATION TEST PLAT			
PROJECT MARRIOTTVILLE ESTATES - LOTS 1, 2, AND 3			
LOCATION 3RD ELECTION DISTRICT		HOWARD COUNTY, MD.	
DATE: SEPT. 1978	DESIGN BY:	DRAWN BY: J.J.B.	CHECKED BY: J.A.B.
SCALE: 1" = 200'	JOB NO.: 7848	DRAWING NO.: 1 OF 1	

boender associates

engineers
surveyors
planners

APPLICATION

Retest

SEWAGE DISPOSAL TESTING

STATE OF MARYLAND - DEPARTMENT OF HEALTH AND MENTAL HYGIENE

A _____

P _____

HOWARD COUNTY HEALTH DEPARTMENT
ENVIRONMENTAL HEALTH SERVICES

P. O. BOX 476 ELLICOTT CITY, MARYLAND 21043
TELEPHONE: 992-2330

DISTRICT 3rd

DATE 6/1/82

TO: THE COUNTY HEALTH OFFICER
ELLICOTT CITY, MARYLAND

I, HEREBY, APPLY FOR THE NECESSARY TEST IN ORDER TO CONSTRUCT (OR RECONSTRUCT) A SEWAGE DISPOSAL SYSTEM.

PROPERTY OWNER Charles V. Lewis

ADDRESS 8590 Horseshoe Rd PHONE 465-7777

PROPERTY LOCATION:
SUBDIVISION Lewis Property LOT NO. 4

ROAD AND DESCRIPTION North side of Maryland Rt. 99

SIZE OF LOT _____ TYPE BLDG. _____
(NUMBER OF BEDROOMS)

THE SYSTEM INSTALLED UNDER THIS APPLICATION IS ACCEPTABLE ONLY UNTIL PUBLIC FACILITIES BECOME AVAILABLE. I FULLY UNDERSTAND THE FEE CONNECTED WITH THE FILING OF THIS PERC TEST APPLICATION IS NON-REFUNDABLE UNDER ANY CIRCUMSTANCES. I ALSO AGREE TO COMPLY WITH ALL M.O.S.H.A. REQUIREMENTS IN TESTING THIS LOT.

(SIGNATURE OF APPLICANT)

APPROVED BY _____ FOR _____ DATE _____



REJECTED BY RH & CW FOR ALL DATE 6/1/82

HOLD PENDING FURTHER TESTS _____ DATE _____

REASONS FOR REJECTION OR HOLDING 6/1/82 UNDERGROUND WATER ON HIGH GROUND? RH & CW

THIS IS NOT A PERMIT

① SOIL PROFILE

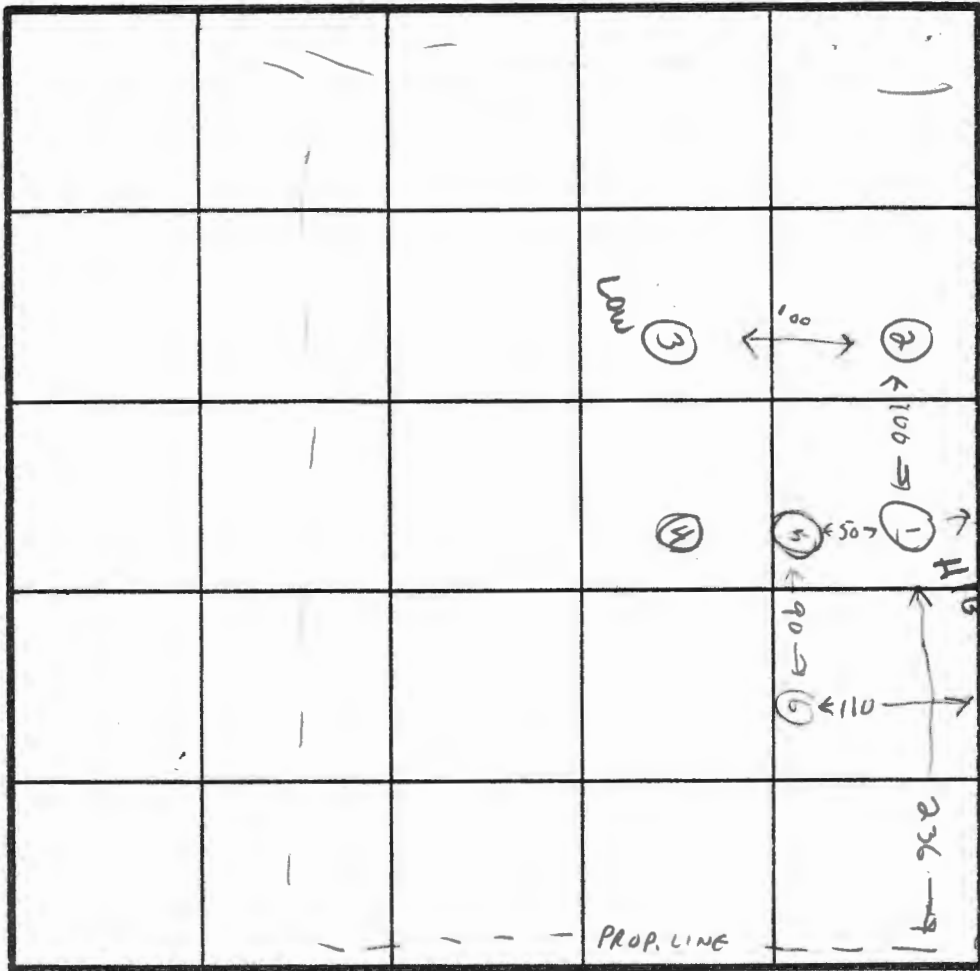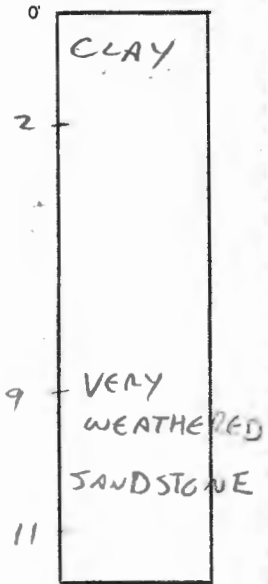

SEE PLAN

(44' HOLE 1 TO FENCE-LOT LINE)

HIGHEST ELEV

① - HIGHEST
⑤ - LOWEST
③ - LOWEST



②④⑥ = MED M

INDICATE NORTH - NAME ADJOINING ROADWAY AS BASE LINE.

TO ROUTE 99

BOTTOM

DATE	TEST NO.	DEPTH	PRE-WET		TEST - 1" DROP		TIME	
			START	STOP	START	STOP		
6-21-72	A	4"	10:09:10	10:10:10	10:10:30	10:11:40	1 1/2 min	
	1 B	VISUAL SAND TO 11'						
	2	11" WATER AT 10' - ABANDONED						
	3	11" WATER AT 8' - ABANDONED						
	4	6" WATER AT 5 1/2' - ABANDONED						
	5	4"	10:49:00	10:50:30	10:50:30	10:55:30	5 min	
	6	9" WATER AT 8' - ABANDONED						

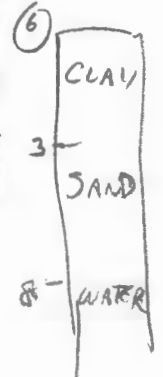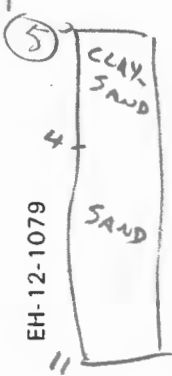

REMARKS WATER IN ALL BUT 2 HIGHEST HOLES - NO ROOM FOR SYSTEM

TYPE OF SOIL SAND

TESTED BY CW & RH

ED MORTZ
BOB NORTON
ALSO PRESENT
TONY HAYES

EH-12-1079

MARIOTT'S VILLO
ESTATES
on D P KLIEN PROP

9/18/79 - OK FOR Health
Officer to sign Final Plat R/H

9/19/79 DM took Final
Plat

HOWARD COUNTY OFFICE OF PLANNING AND ZONING
 DIVISION OF LAND DEVELOPMENT
 COUNTY OFFICE BUILDING
 3450 COURT HOUSE DRIVE
 ELLICOTT CITY, MARYLAND 21043

DATE: 3-23-79

P & Z File No. F-79-157

Agencies

Office of Planning and Zoning

- Director, Department of Public Works
- Bureau of Engineering
- Bureau of Inspections and Permits
- Fire Administrator
- Police Department
- State Highway Administration
- Division of Environmental Health
- Howard County Public School System
- Recreation and Parks
- Soil Conservation Service
- County Assessment

- Director
- Chief, Division of Land Development
- Transportation Planning
- File
- Division of Comprehensive Planning
- Division of Zoning
- Planning Board Members

RE: Klein Prop - Par. A-4C

FOR PLAN REVIEW MEETING OF _____
 (Date) (Time) (Place)

ENCLOSED FOR YOUR: Signature Approval Review & Comments Files

THE ENCLOSED: Original Copy

	<u>No. of Sheets</u>		<u>No. of Sheets</u>
<input type="checkbox"/> Preliminary Plan	_____	<input type="checkbox"/> Final Road and/or Storm Drainage Plan	_____
<input type="checkbox"/> Preliminary Road Profile	_____	<input type="checkbox"/> Final Storm Drainage Computations	_____
<input type="checkbox"/> Preliminary Drainage Study and/or Computations	_____	<input type="checkbox"/> Site Development Plan	_____
<input type="checkbox"/> Final Development Criteria	_____	<input type="checkbox"/> Sketch Plan	_____
<input type="checkbox"/> Final Development Plan	_____		_____
<input checked="" type="checkbox"/> Final Plat	_____		_____

WAS: Received Tentatively Approved Recorded
 Received & Revised Approved On 3-23-79

COMMENTS: Done 4-17-79

Check box and return to Office of Planning and Zoning if plan is approved with no comments.

"The Commercial & Residential Renovation Experts"

Cavalier Construction Co.

CONSULTING - CONTRACTING
TONY HAYES

112 MALLOW HILL RD.
BALTIMORE, MD. 21229

PH. 644-1256

APPLICATION

Retest

SEWAGE DISPOSAL TESTING

STATE OF MARYLAND - DEPARTMENT OF HEALTH AND MENTAL HYGIENE

A _____

P _____

HOWARD COUNTY HEALTH DEPARTMENT
ENVIRONMENTAL HEALTH SERVICES

P. O. BOX 476 ELLICOTT CITY, MARYLAND 21043
TELEPHONE: 992-2330

DISTRICT 3rd

DATE 6/1/82

TO: THE COUNTY HEALTH OFFICER
ELLICOTT CITY, MARYLAND

I, HEREBY, APPLY FOR THE NECESSARY TEST IN ORDER TO CONSTRUCT (OR RECONSTRUCT) A SEWAGE DISPOSAL SYSTEM.

PROPERTY OWNER Charles V. Lewis

ADDRESS 8590 Horsehoe Rd PHONE 465-7777

PROPERTY LOCATION:

SUBDIVISION Lewis Property LOT NO. 4

ROAD AND DESCRIPTION North side of Maryland Rt. 95

SIZE OF LOT _____ TYPE BLDG. _____ (NUMBER OF BEDROOMS)

THE SYSTEM INSTALLED UNDER THIS APPLICATION IS ACCEPTABLE ONLY UNTIL PUBLIC FACILITIES BECOME AVAILABLE. I FULLY UNDERSTAND THE FEE CONNECTED WITH THE FILING OF THIS PERC TEST APPLICATION IS NON-REFUNDABLE UNDER ANY CIRCUMSTANCES. I ALSO AGREE TO COMPLY WITH ALL M.O.S.H.A. REQUIREMENTS IN TESTING THIS LOT.

(SIGNATURE OF APPLICANT)

APPROVED BY _____ FOR _____ DATE _____



REJECTED BY RH & CW FOR ALL DATE 6/1/82

HOLD PENDING FURTHER TESTS _____ DATE _____

REASONS FOR REJECTION OR HOLDING 6/1/82 UNDERGROUND WATER ON HIGH GROUND? RH & CW

THIS IS NOT A PERMIT

① SOIL PROFILE

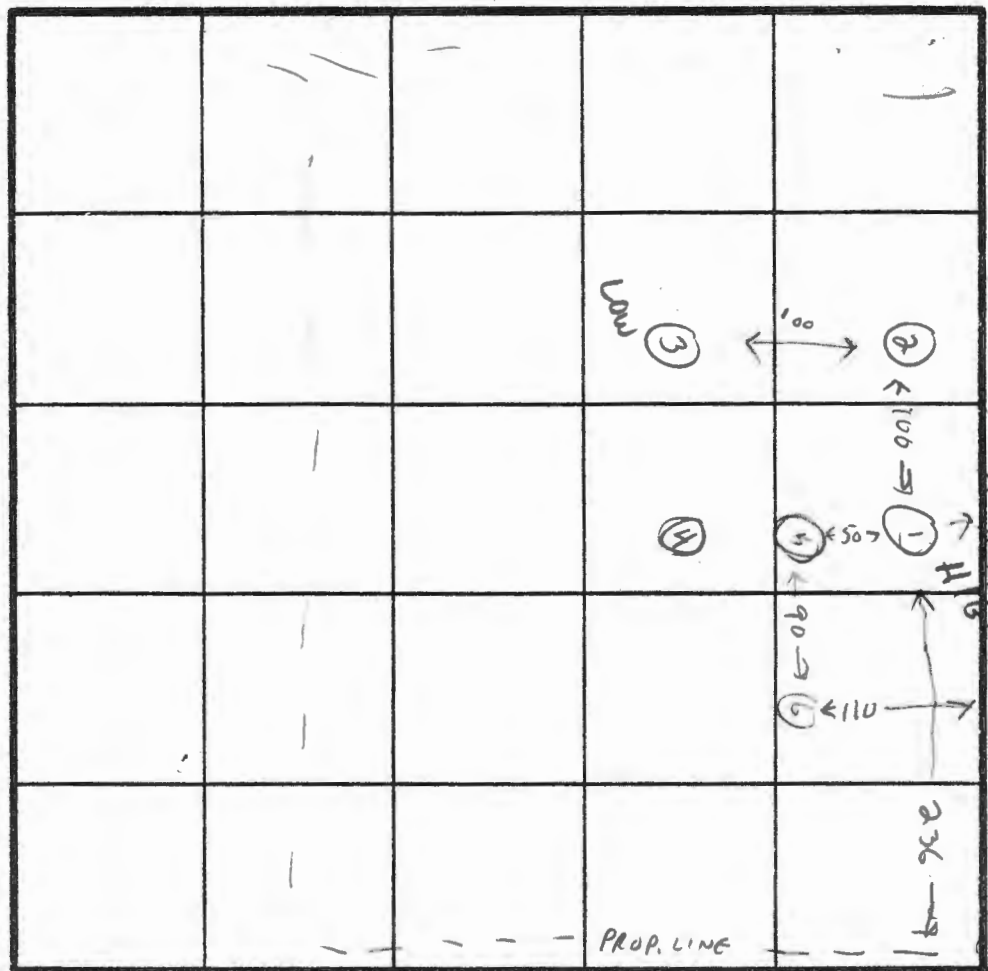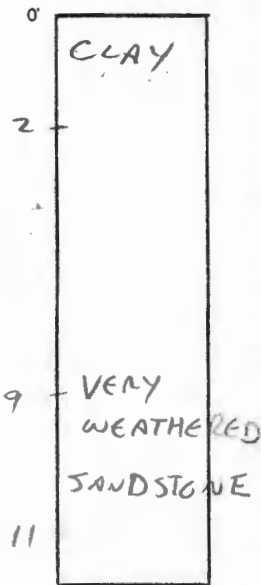

SEE PLAT




(44' HOLE 1 TO FENCE-LOT LINE)

H - ELEV

① HIGHEST HIGH LINES

②③④ = M-L-D M

INDICATE NORTH - NAME ADJOINING ROADWAY AS BASE LINE. TO ROUTE 99

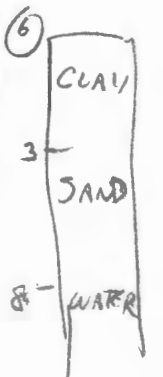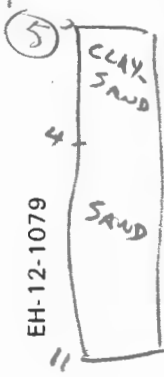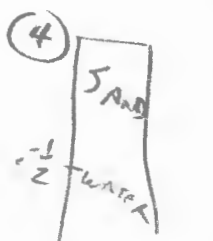

DATE	TEST NO.	DEPTH	PRE-WET		TEST - 1" DROP		TIME	
			START	STOP	START	STOP		
6-21-79	A	4'	10:09:10	10:10:10	10:10:30	10:11:40	1 1/2 min	
	B	VISUAL SAND TO 11'						
	2	11' WATER AT 10' - ABANDONED						
	3	11' WATER AT 8' - ABANDONED						
	4	10' WATER AT 5 1/2' - ABANDONED						
	5	4'	10:49:00	10:50:30	10:50:30	10:55:30	5 min	
	6	9' WATER AT 8' - ABANDONED						

REMARKS WATER IN ALL BUT 2 HIGHEST HOLES - NO ROOM FOR SYSTEM

TYPE OF SOIL SAND

TESTED BY CWB RH

ED MORITZ
BOB NORTON
ALSO PRESENT

TONY HAYES

EH-12-1079