

# APPLICATION

17952

A ~~17951~~

P \_\_\_\_\_

## SEWAGE DISPOSAL TESTING

STATE OF MARYLAND - DEPARTMENT OF HEALTH AND MENTAL HYGIENE

HOWARD COUNTY HEALTH DEPARTMENT  
ENVIRONMENTAL HEALTH SERVICES

P. O. BOX 476, ELLICOTT CITY, MARYLAND 21043  
TELEPHONE: 465-5000, EXT. 356

DISTRICT 4th

DATE 2/20/73

TO: THE COUNTY HEALTH OFFICER  
ELLICOTT CITY, MARYLAND

I, HEREBY, APPLY FOR THE NECESSARY TEST IN ORDER TO CONSTRUCT (OR RECONSTRUCT) A SEWAGE DISPOSAL SYSTEM.

PROPERTY OWNER Edwin Warfield, III  
ADDRESS Oakdale Farm, Woodbine, Md. PHONE Any questions call Louise Adams, 531-5458

PROPERTY LOCATION:

SUBDIVISION \_\_\_\_\_ LOT NO. 33

ROAD AND DESCRIPTION Jennings Chapel Road - Use Daisy Rd. to Jennings Chapel Rd. - right on Jennings Chapel - 1 1/2 miles in on right

SIZE OF LOT 5 acres TYPE BLDG. Respiratory only  
NUMBER OF BEDROOMS 3 or 4 bedrooms

IF NOT SINGLE RESIDENCE DESCRIBE \_\_\_\_\_

THE SYSTEM INSTALLED UNDER THIS APPLICATION IS ACCEPTABLE ONLY UNTIL PUBLIC FACILITIES BECOME AVAILABLE.

SIGNATURE OF APPLICANT /s/ Louise H. Adams

APPROVED BY \_\_\_\_\_ FOR \_\_\_\_\_ DATE \_\_\_\_\_  
(KIND OF SYSTEM)


REJECTED BY \_\_\_\_\_ FOR \_\_\_\_\_ DATE \_\_\_\_\_  
(KIND OF SYSTEM)

HOLD PENDING FURTHER TESTS \_\_\_\_\_ DATE \_\_\_\_\_

REASONS FOR REJECTION OR HOLDING \_\_\_\_\_

# THIS IS NOT A PERMIT

213.84'

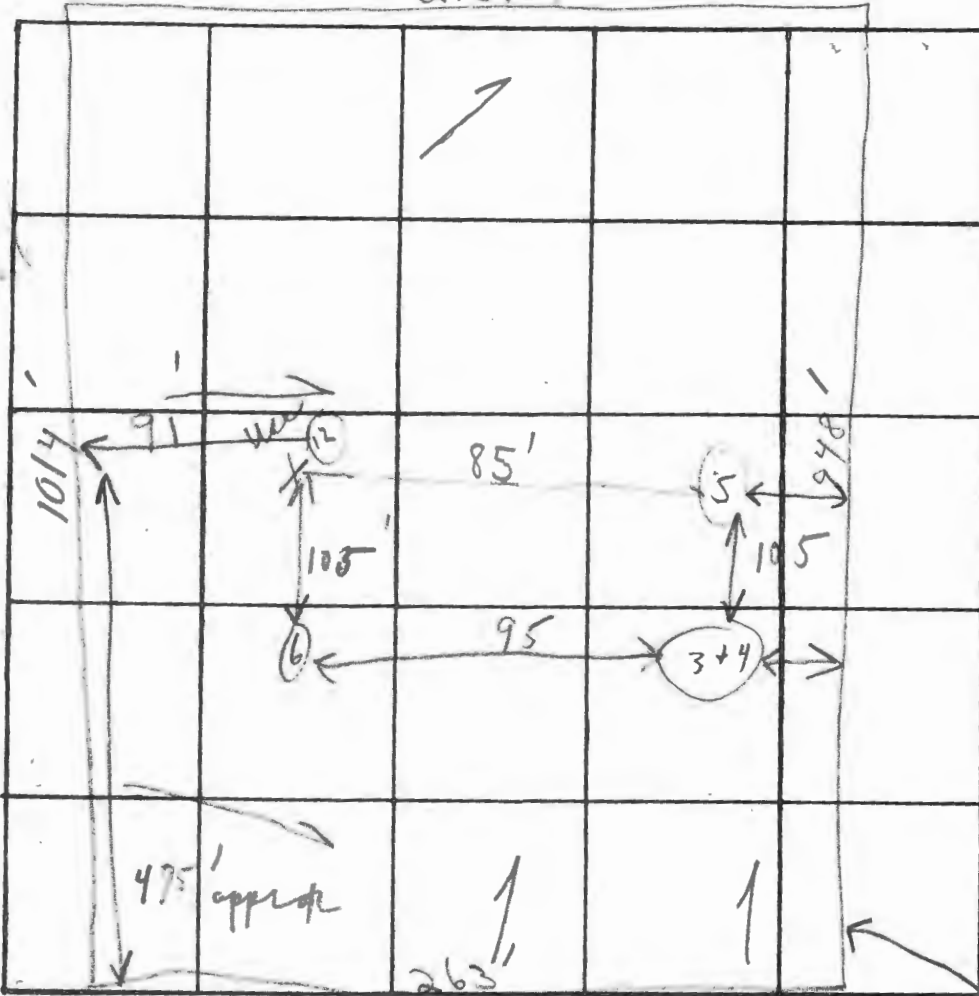

INDICATE NORTH. - NAME ADJOINING ROADWAY AS BASE LINE.

Jennings Street Rd

DATE	TEST NO.	DEPTH	PRE-WET		TEST - 1" DROP		TIME
			START	STOP	START	STOP	
2/22/73	1	5 1/2'	9:53	9:55	9:55	9:58	3 min
	2	11 1/2'	9:52	10:03	10:03	10:20	17 min
	3	6'	10:09	10:17	10:17	10:42	25 min
	4	12 1/2'	10:23	10:28	10:28	10:40	12 min
	5	11'	Similar to 1 + 2		4:57		20 min
	6	11'	Similar to 1 + 2				

REMARKS

Hold for plot (Plot furnished by future owner on site)

TYPE OF SOIL

(Hold for House plan)

TESTED BY

R. Stricker

ALSO PRESENT:

Ray } House can go  
+ J. Furch } in front.

Net 33 -

Exploratory only

2/22/73 A.M.  
9:30

4-11-73