



Building Permit Application

Howard County Maryland
 Department of Inspections, Licenses and Permits
 3430 Court House Drive
 Permits: 410-313-2455
 www.howardcountymd.gov

Date Received: _____

Permit No. B17003203

Building Address: 16008 Holly Terrace Ct
 City: Mt Airy State: MD Zip Code: 21777
 Suite/Apt. # _____ SDP/WP/BA #: _____
 Census Tract: _____ Subdivision: Bayard Hollow
 Section: _____ Area: _____ Lot: 12
 Tax Map: 2001 Parcel: 0084 Grid: 0006
 Zoning: _____ Map Coordinates: _____ Lot Size: 1.18ac

Existing Use: Residence
 Proposed Use: Residence
 Estimated Construction Cost: \$ 12,000.00
 Description of Work: Install deck 28 x 31
gazebo on rear yard on
4" concrete slab.
 Occupant/Tenant Name: Timothy Harold
 Was tenant space previously occupied? Yes No
 Contact Name: Timothy Harold
 Address: 16008 Holly Terrace Ct
 City: Mt Airy State: MD Zip Code: 21777
 Phone: 410-707-1817 Fax: _____
 Email: timharold@gmail.com

Property Owner's Name: Timothy Harold
 Address: 16008 Holly Terrace Ct
 City: Mt Airy State: MD Zip Code: 21777
 Phone: 410-707-1817 Fax: _____
 Email: timharold@gmail.com
Applicant's Name & Mailing Address, (If other than stated herein)
 Applicant's Name: _____
 Address: _____
 City: _____ State: _____ Zip Code: _____
 Phone: _____ Fax: _____
 Email: _____

Contractor Company: _____
 Contact Person: _____
 Address: _____
 City: _____ State: _____ Zip Code: _____
 License No.: _____
 Phone: _____ Fax: _____
 Email: _____

Engineer/Architect Company: _____
 Responsible Design Prof.: _____
 Address: _____
 City: _____ State: _____ Zip Code: _____
 Phone: _____ Fax: _____
 Email: _____

Commercial Building Characteristics	Residential Building Characteristics
Height:	<input checked="" type="checkbox"/> SF Dwelling <input type="checkbox"/> SF Townhouse
No. of stories:	Depth Width
Gross area, sq. ft./floor:	1 st floor:
	2 nd floor:
Area of construction (sq. ft.):	Basement:
	<input type="checkbox"/> Finished Basement
Use group:	<input type="checkbox"/> Unfinished Basement
	<input type="checkbox"/> Crawl Space
Construction type:	<input checked="" type="checkbox"/> Slab on Grade
<input type="checkbox"/> Reinforced Concrete	No. of Bedrooms:
<input type="checkbox"/> Structural Steel	Multi-family Dwelling
<input type="checkbox"/> Masonry	No. of efficiency units:
<input checked="" type="checkbox"/> Wood Frame	No. of 1 BR units:
<input type="checkbox"/> State Certified Modular	No. of 2 BR units:
	No. of 3 BR units:
	Other Structure:
	Dimensions: <u>28 x 31</u>
<input checked="" type="checkbox"/> Roadside Tree Project Permit	Footings:
<input type="checkbox"/> Yes <input type="checkbox"/> No	Roof:
Roadside Tree Project Permit #	<input type="checkbox"/> State Certified Modular
	<input type="checkbox"/> Manufactured Home

Utilities	
Electric:	<input checked="" type="checkbox"/> Yes <input type="checkbox"/> No
Gas:	<input type="checkbox"/> Yes <input type="checkbox"/> No
Water Supply	
<input type="checkbox"/> Public	
<input checked="" type="checkbox"/> Private	
Sewage Disposal	
<input type="checkbox"/> Public	
<input checked="" type="checkbox"/> Private	
Heating System	
<input checked="" type="checkbox"/> Electric <input type="checkbox"/> Oil	
<input type="checkbox"/> Natural Gas <input checked="" type="checkbox"/> Propane Gas	
<input type="checkbox"/> Other:	
Sprinkler System:	
<input type="checkbox"/> Yes <input checked="" type="checkbox"/> No	
Grading Permit Number:	
Building Shell Permit Number:	

THE UNDERSIGNED HEREBY CERTIFIES AND AGREES AS FOLLOWS: (1) THAT HE/SHE IS AUTHORIZED TO MAKE THIS APPLICATION; (2) THAT THE INFORMATION IS CORRECT; (3) THAT HE/SHE WILL COMPLY WITH ALL REGULATIONS OF HOWARD COUNTY WHICH ARE APPLICABLE THERETO; (4) THAT HE/SHE WILL PERFORM NO WORK ON THE ABOVE REFERENCED PROPERTY NOT SPECIFICALLY DESCRIBED IN THIS APPLICATION; (5) THAT HE/SHE GRANTS COUNTY OFFICIALS THE RIGHT TO ENTER ONTO THIS PROPERTY FOR THE PURPOSE OF INSPECTING THE WORK PERMITTED AND POSTING NOTICES.

Applicant's Signature: Timothy Harold
 Email Address: timharold@gmail.com
 Title/Company: Owner

Print Name: Timothy Harold
 Date: 8-27-17

Checks Payable to: DIRECTOR OF FINANCE OF HOWARD COUNTY

PLEASE WRITE NEATLY & LEGIBLY
-FOR OFFICE USE ONLY-

AGENCY	DATE	SIGNATURE OF APPROVAL
State Highways		
Building Officials		
PSZA (Zoning)		
PSZA (Engineering)		
Health	<u>9/22/17</u>	<u>[Signature]</u>

Is Sediment Control approval required for issuance? Yes No
 CONTINGENCY CONSTRUCTION START

DPZ SETBACK INFORMATION
Front:
Rear:
Side:
Side St.:
All minimum setbacks met? <input type="checkbox"/> Yes <input type="checkbox"/> No
Is Entrance Permit Required? <input type="checkbox"/> Yes <input type="checkbox"/> No
Historic District? <input type="checkbox"/> Yes <input type="checkbox"/> No
Lot Coverage for New Town Zone:
SDP/Red-line approval date:

Filing Fee	\$
Permit Fee	\$
Tech Fee	\$
Excise Tax	\$
PSFS	\$
Guaranty Fund	\$
Add'l per Fee	\$
Total Fees	\$
Sub- Total Paid	\$
Balance Due	\$
Check	#


Distribution of Copies: White: Building Officials Green: PSZA,Zoning Yellow: PSZA,Engineering Pink: Health Gold: SHA

Property known as: **LOT 12**

THIS PLAT CAN NOT BE USED TO ESTABLISH PROPERTY LINES OR CORNERS.

ROYAL HOLLOW
LOTS 1-14 AND PRESERVATION PARCEL A & B
PLAT 12305
4th ELECTION DISTRICT
HOWARD COUNTY
MARYLAND

Note:
28' x 32'
detached
garage on
4" concrete
pad.
No
foundation.

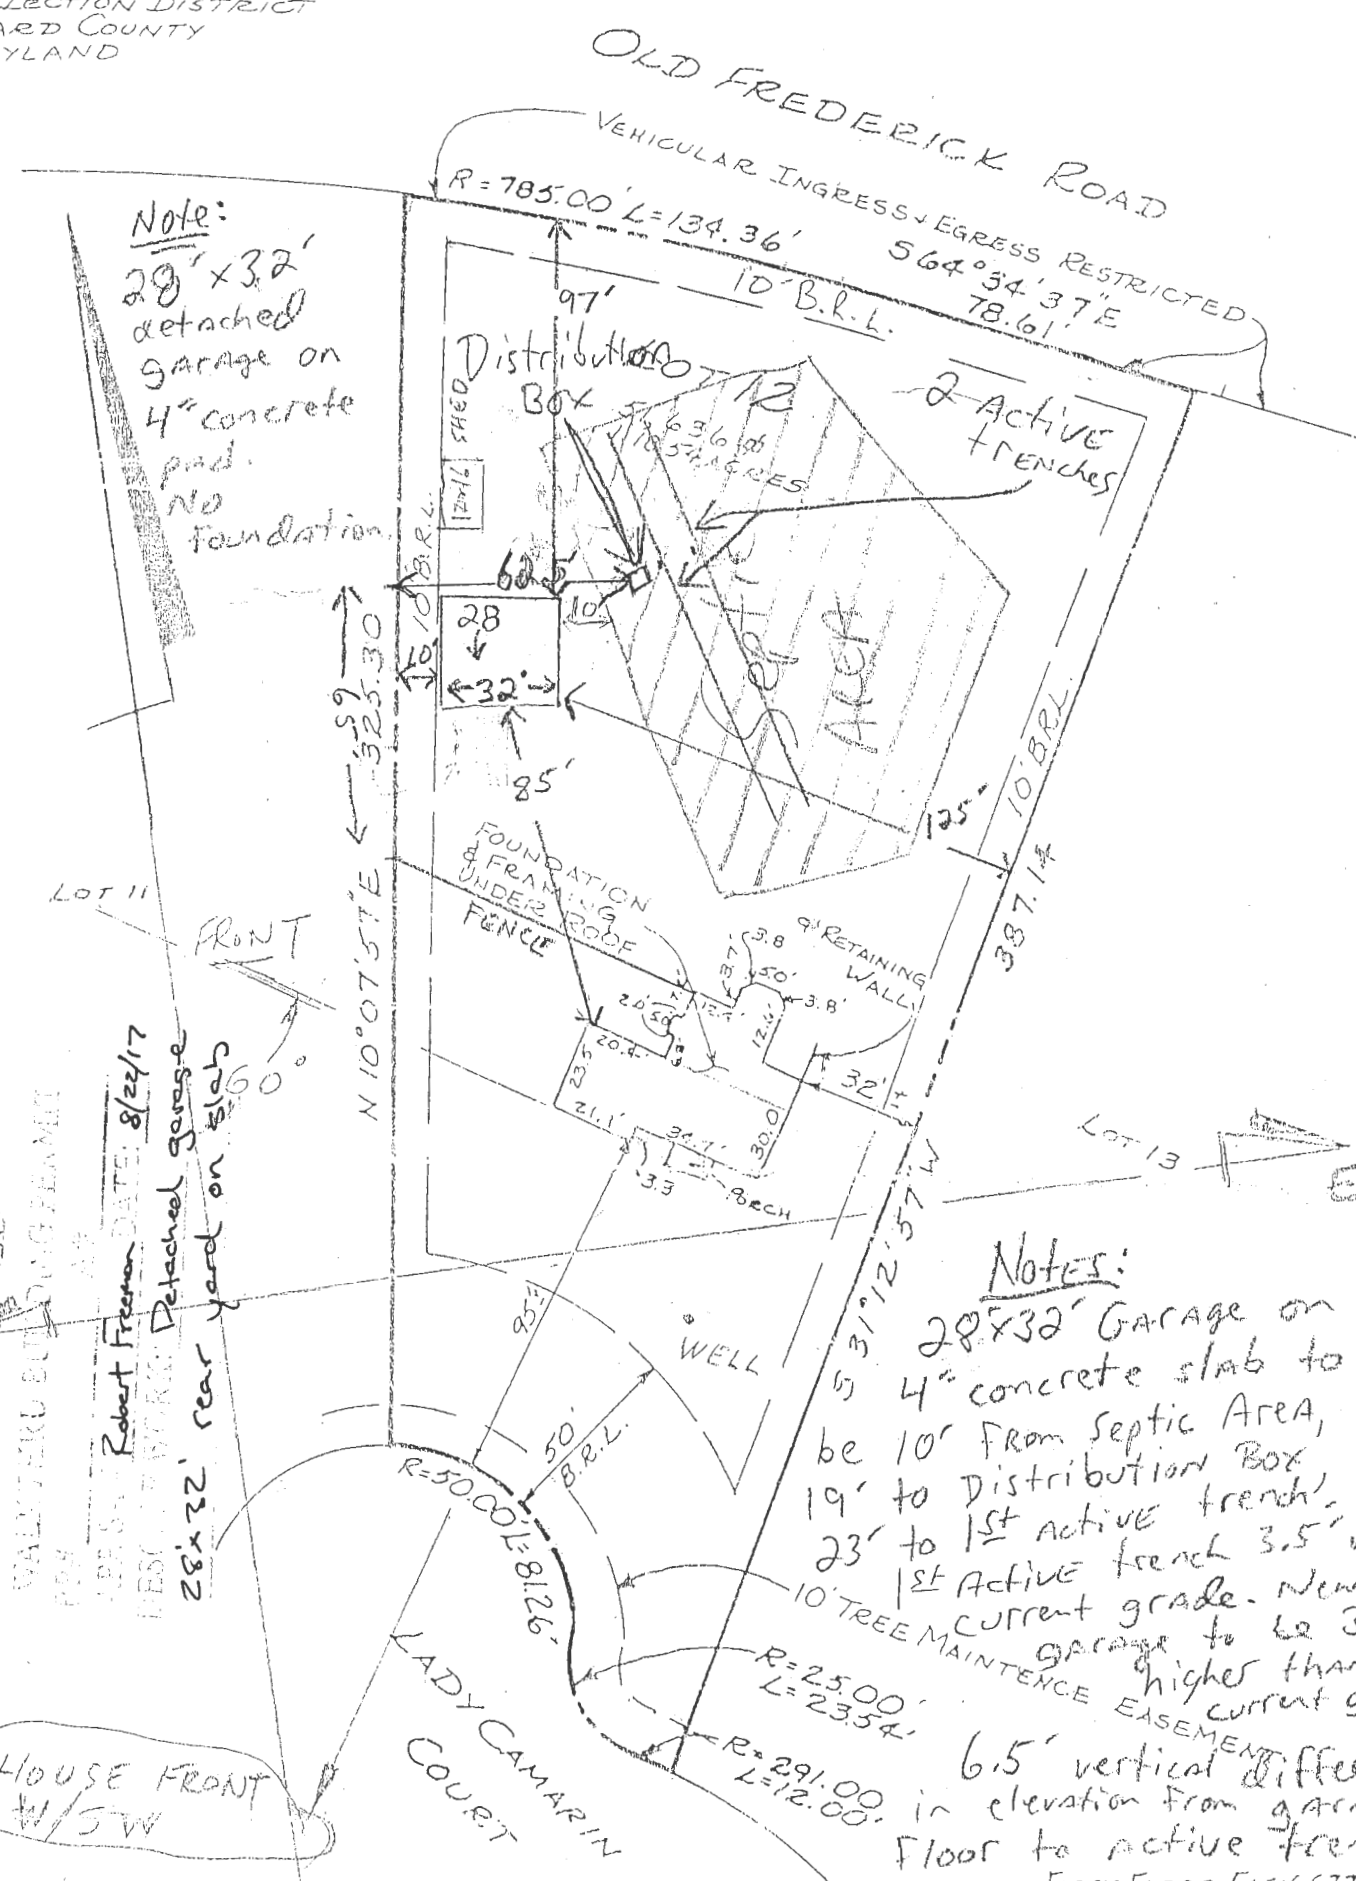

Notes:
 28' x 32' Garage on
 4" concrete slab to
 be 10' from septic area,
 19' to Distribution Box,
 23' to 1st Active trench,
 1st Active trench 3.5' under
 current grade. New
 garage to be 3'
 higher than
 current grid.
 6.5' vertical difference
 in elevation from garage
 floor to active trench.
 FIRST FLOOR ELEV. 677.95'

LOCATION SURVEY PLAT
SUBJECT PROPERTY NOT LOCATED IN A FLOOD PLAIN AREA UNLESS OTHERWISE NOTED


CERTIFICATION	SEAL	SCALE: 1" = 50' DATE: 9-10-97
This is to certify that I have surveyed the property known as: <u>Lot 12</u> <u>LADY CAMARIN COURT</u> for the purpose of locating the im- provements thereon, and the improvements are located as shown.		LDE Inc. 9250 Rumsey Road Suite 106 Columbia, Maryland 21045 (Balt.) 410-715-1070 (Wash.) 301-596-3424 (FAX) 410-715-9540






Harold
16008 Lady Camarin Cf.
Mt. Airy, MD 21771

August 7, 2017

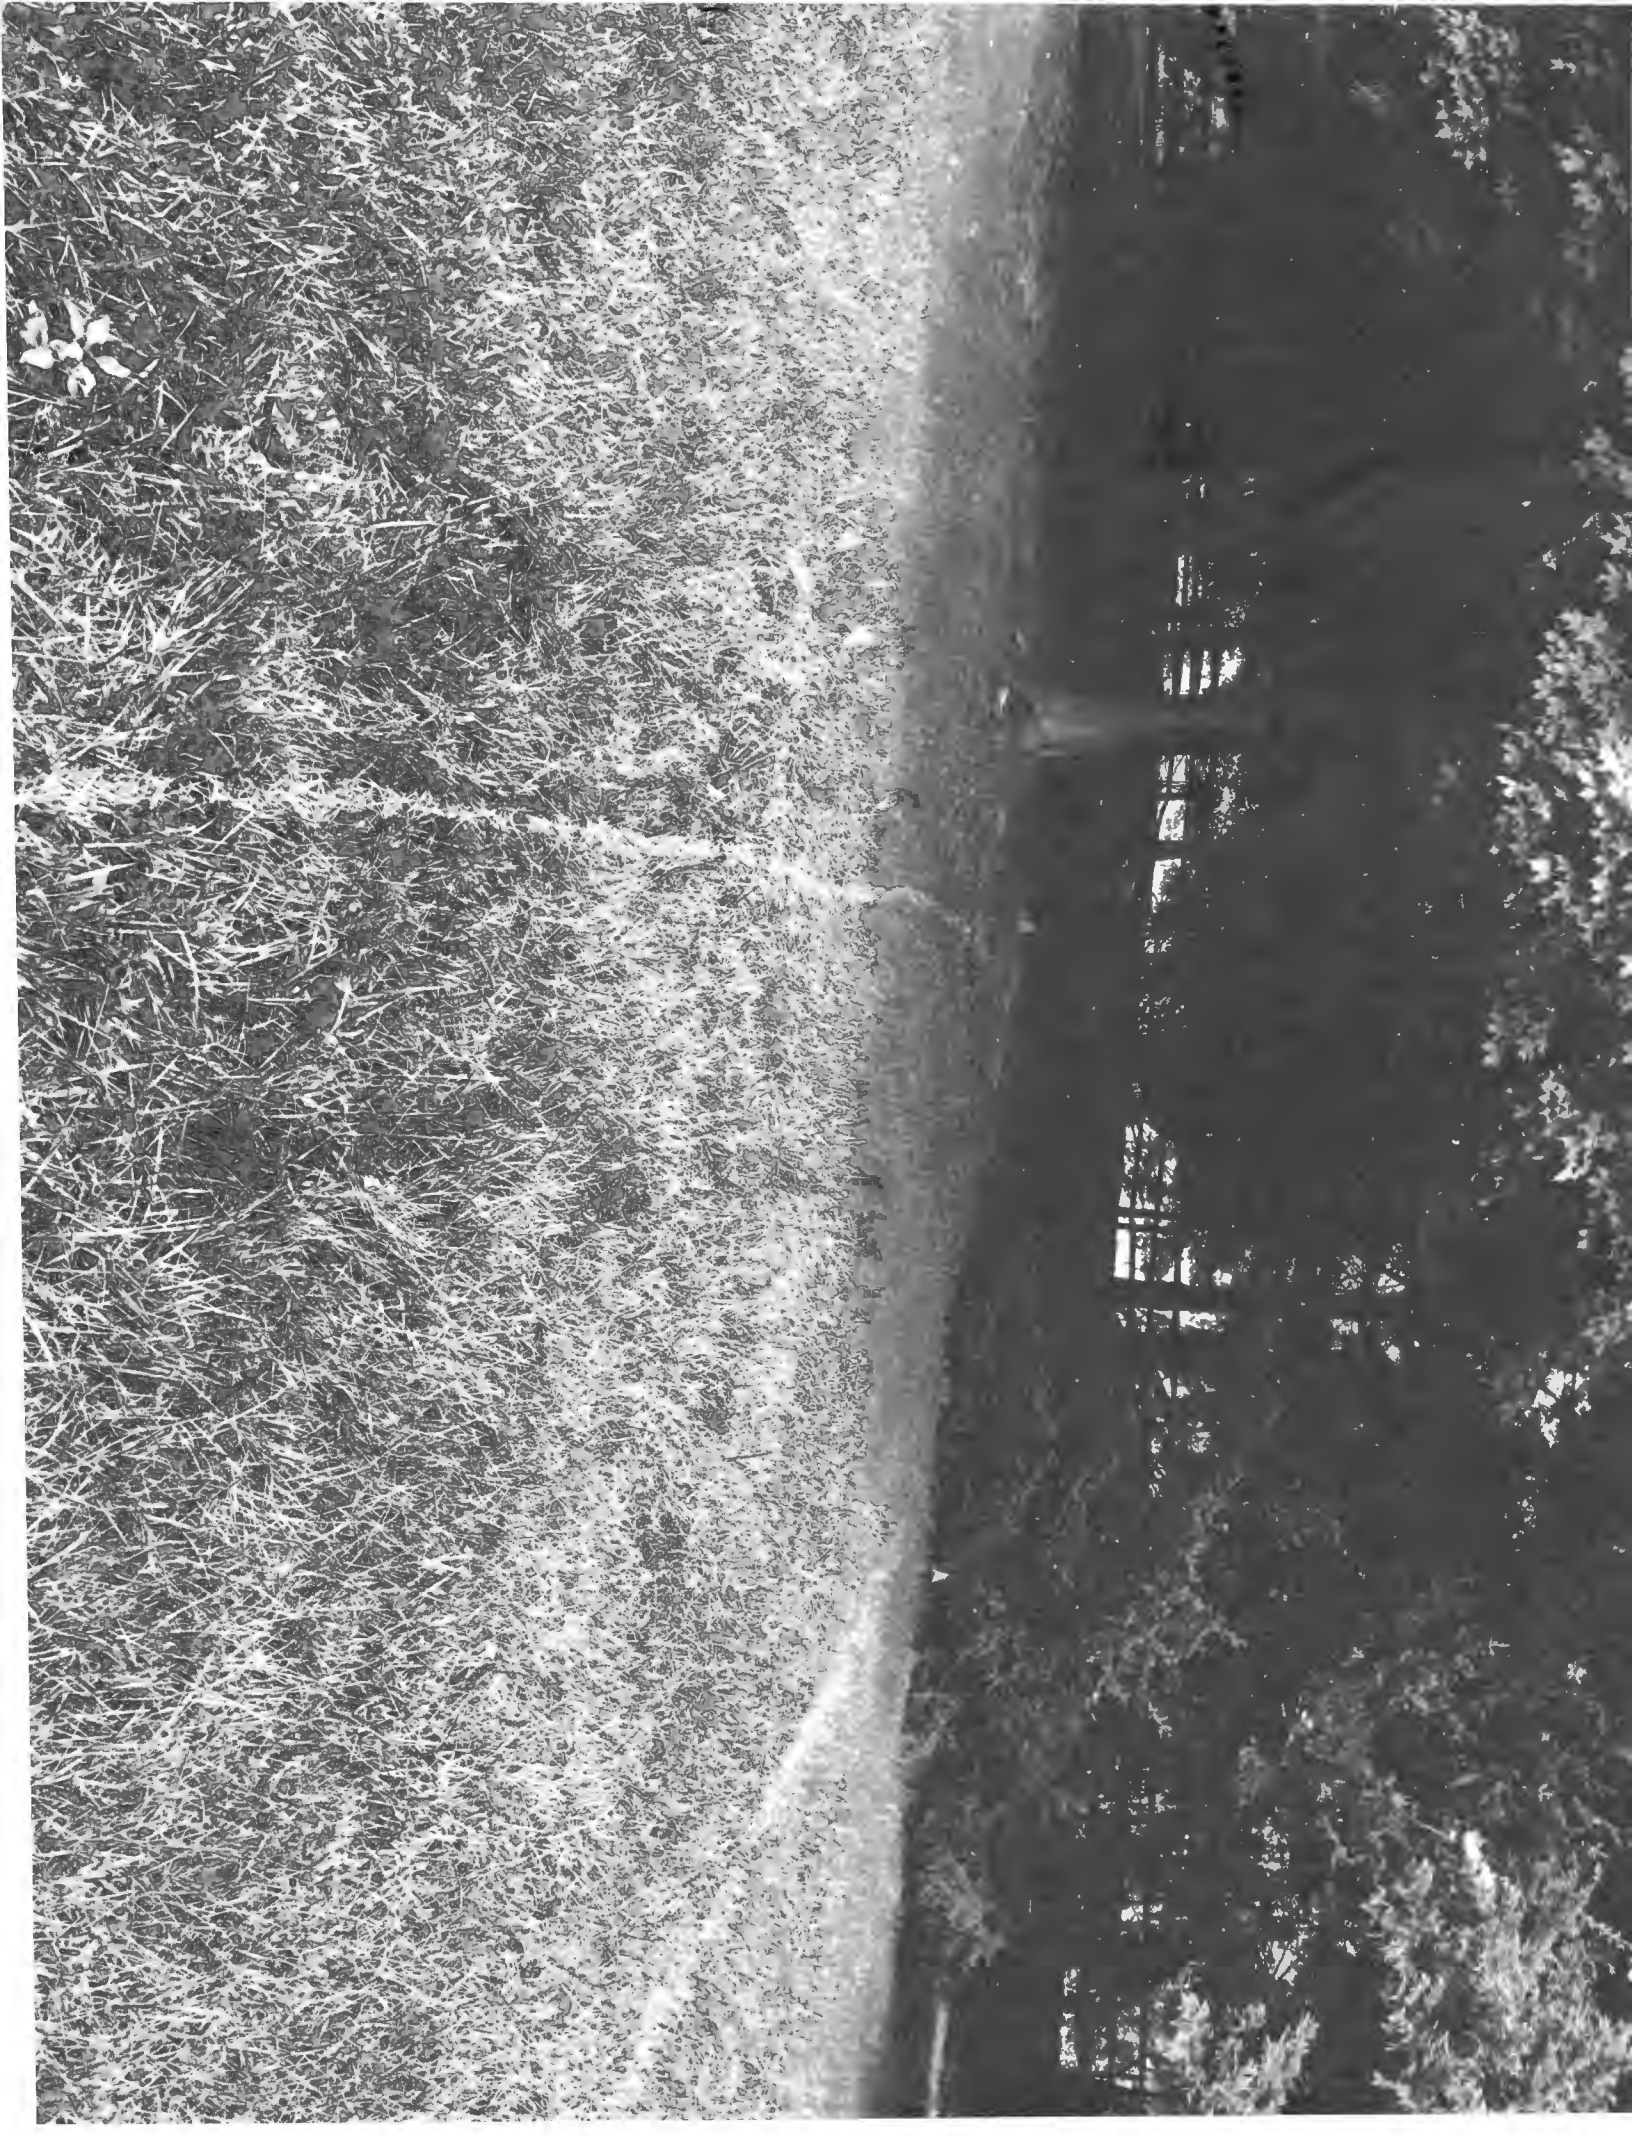

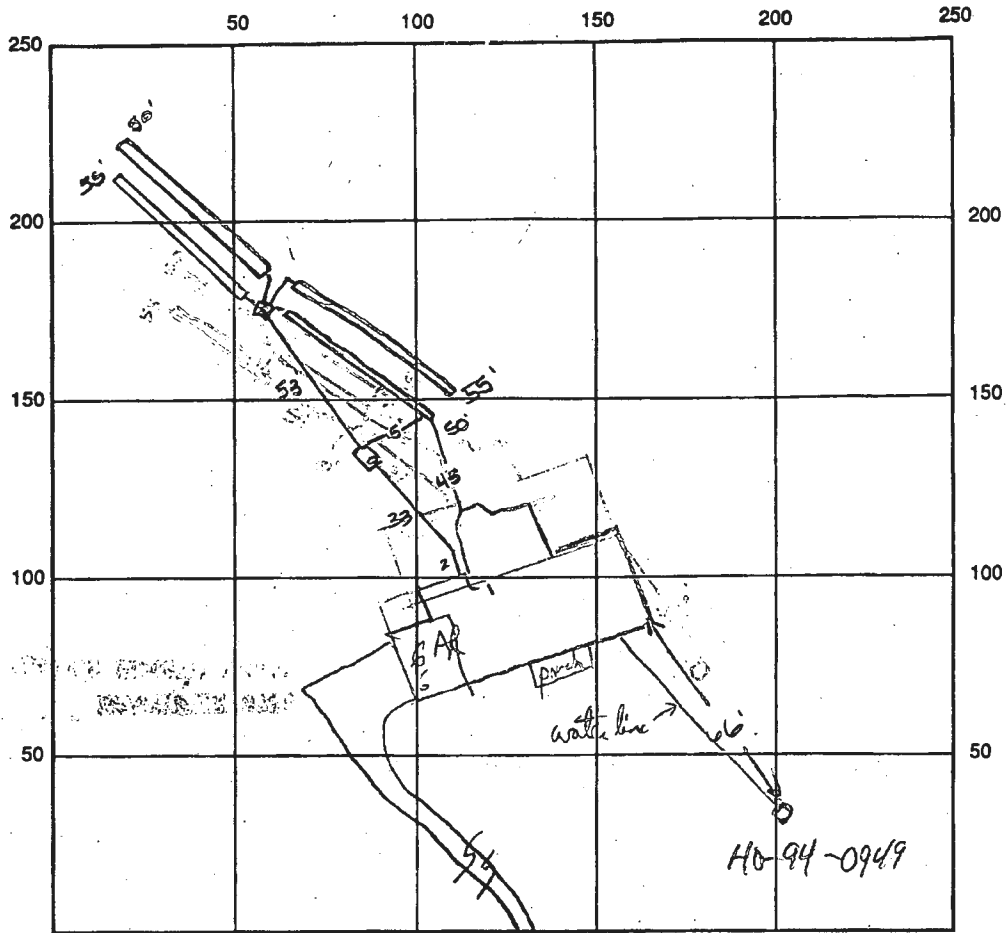

INDICATE NORTH - NAME ADJOINING ROADWAY AS BASE LINE

LADY CAMERON CT.

SEPTIC TANK LEVEL OK 1250 gal CLEANOUTS OK (ST only)

DISTRIBUTION BOX LEVEL OK baffle 15 in

DRAIN FIELD/TITLE DEPTH 7.5 FT. TRENCH WIDTH 2.0 FT. INLET DEPTH 3.5 FT.

EFFECTIVE GRAVEL DEPTH 4 FT. TOTAL LENGTH 210 FT.

NUMBER OF TRENCHES 4 ONE SIDEWALL/BOTTOM AREA 840 SQ. FT.

DRYWALL INSIDE DIAMETER _____ FT. EFFECTIVE DEPTH BELOW INLET _____ FT.

ABSORBENT AREA _____ SQ. FT.

REMARKS: 9/30/97 OK to stone all trenches ALMA Haze connection already done.
10/1/97 OK to Core next system RFP

WPF - Curtis Chamberland said they already saw well line connection - already covered RFP 10/1/97

DATE SYSTEM APPROVED 10/1/97 INSPECTOR RFP